


Out-Jan. 1. 1927

Sec Sheet 110

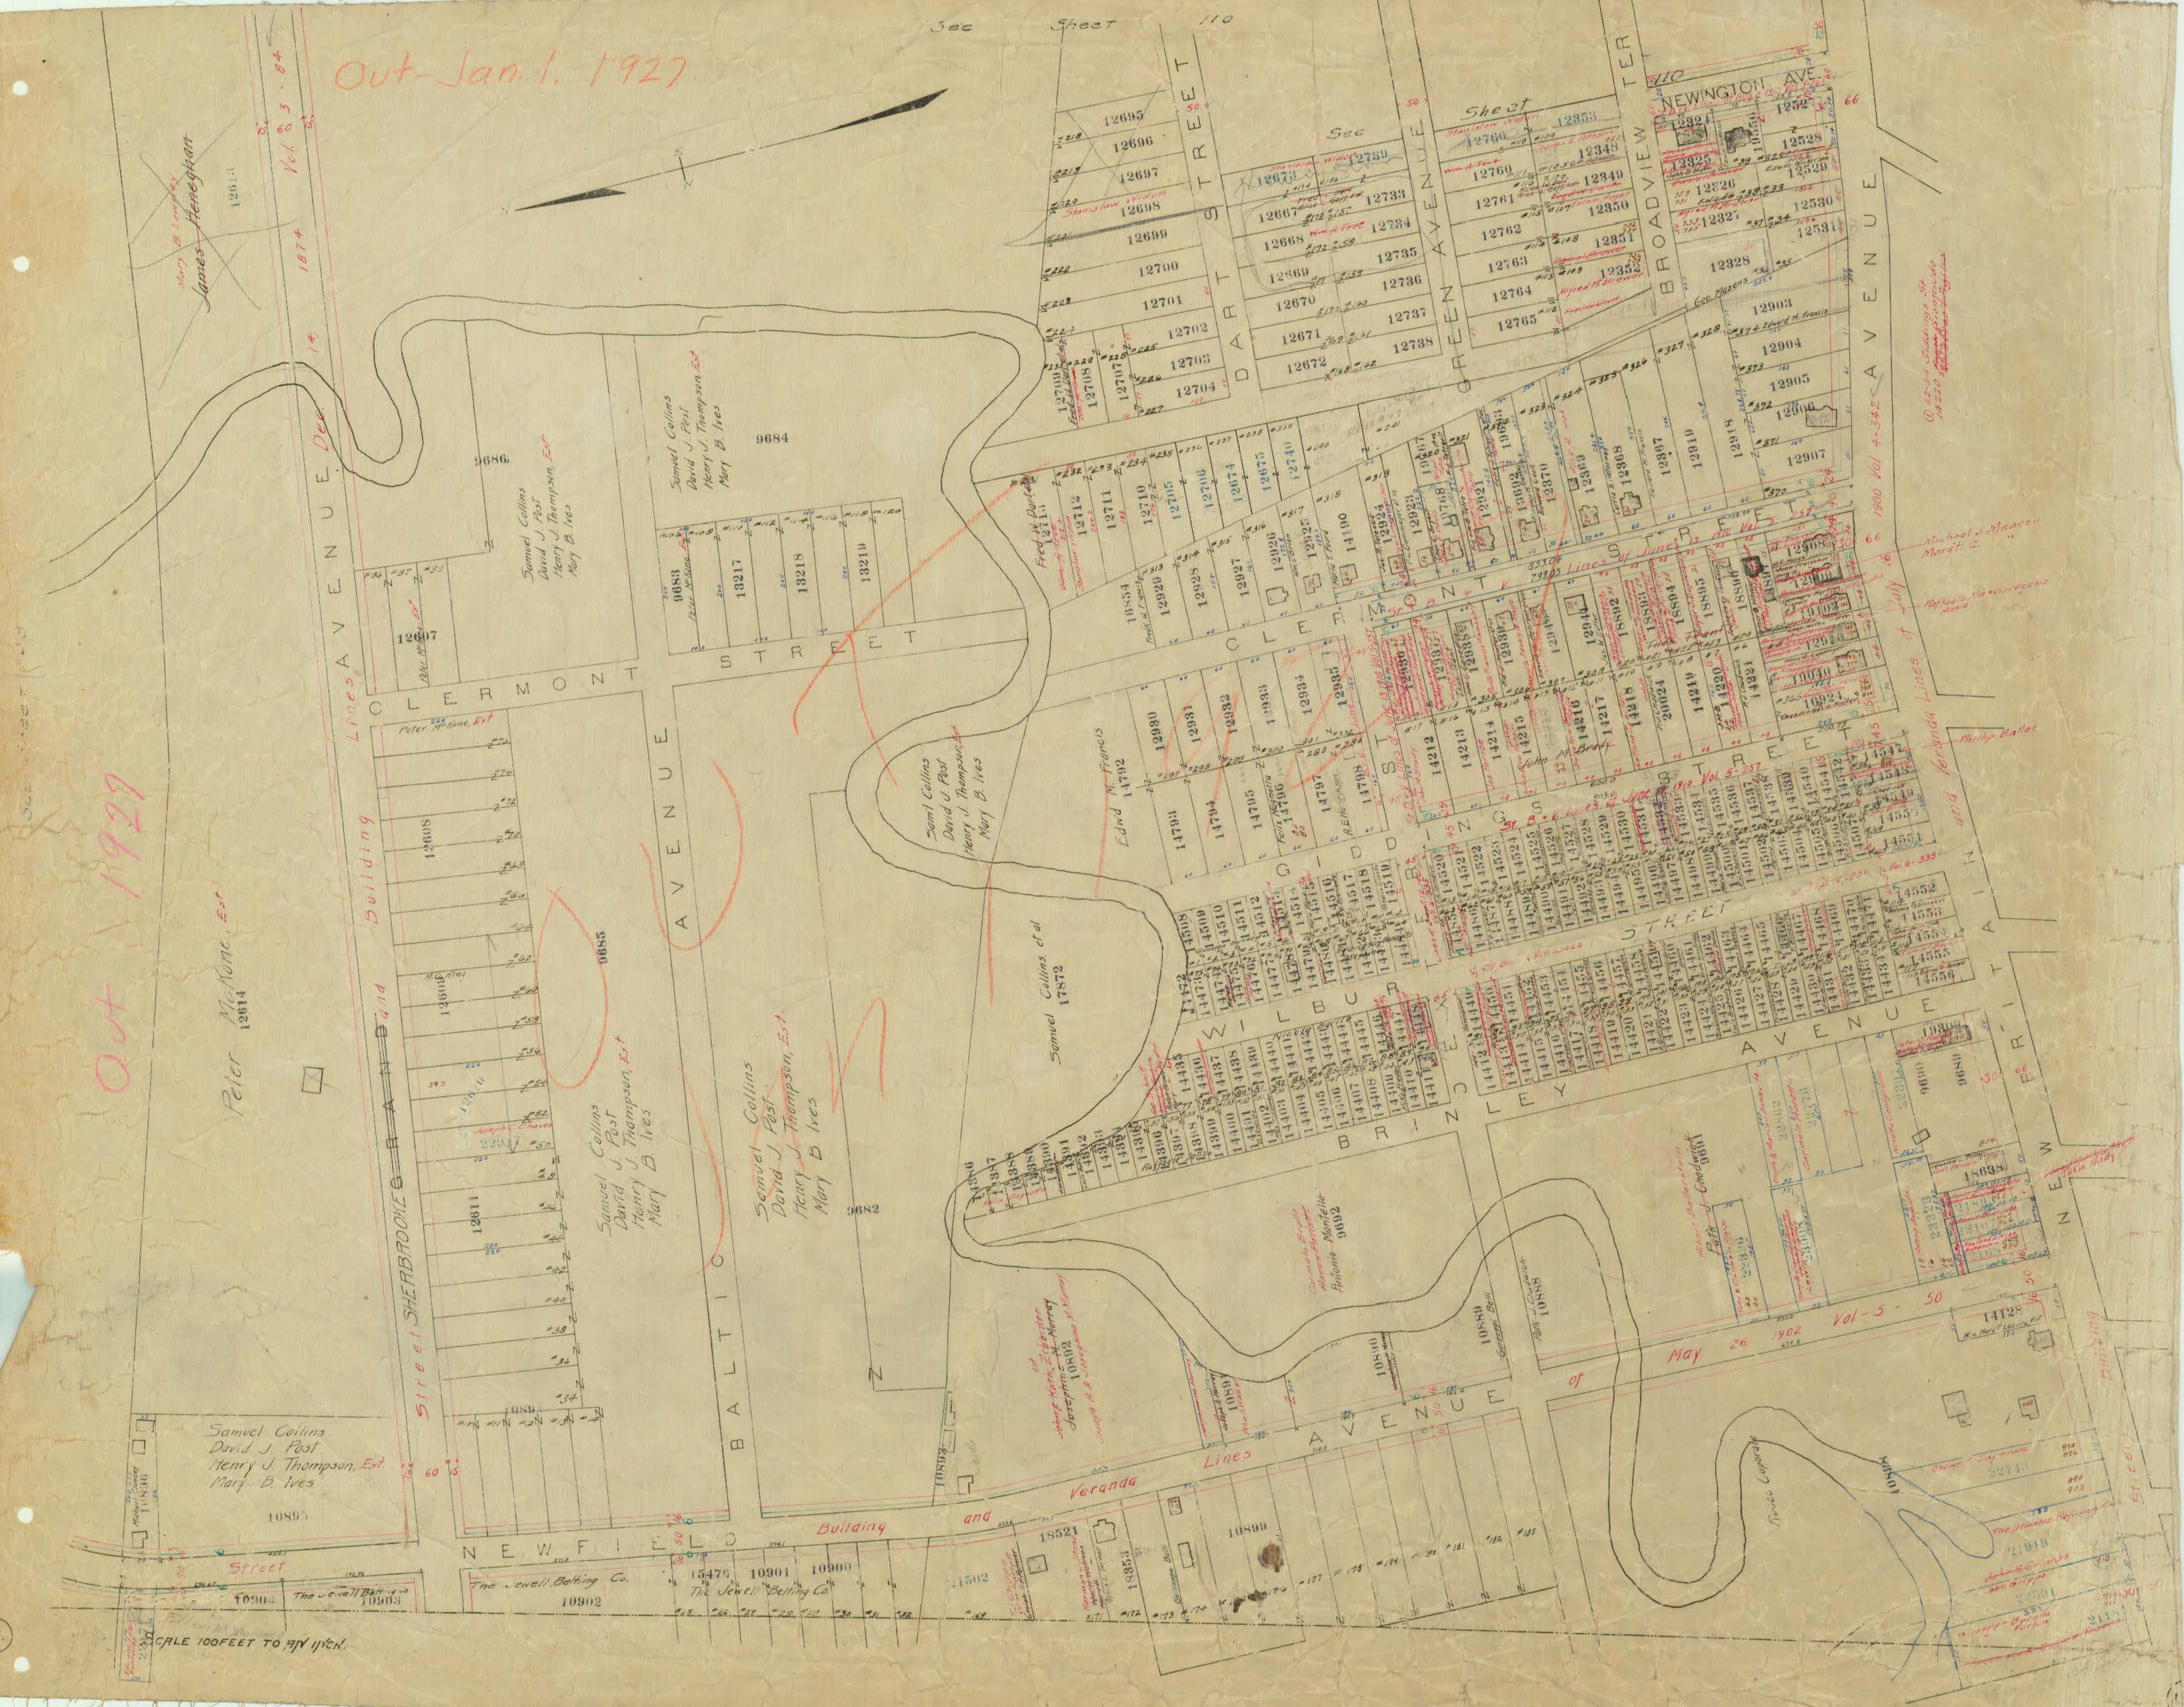

Mary B. Ives  
James Heneghan

12614

Samuel Collins  
David J. Post  
Henry J. Thompson, Est.  
Mary B. Ives

Samuel Collins  
David J. Post  
Henry J. Thompson, Est.  
Mary B. Ives

Samuel Collins  
David J. Post  
Henry J. Thompson, Est.  
Mary B. Ives

Samuel Collins  
David J. Post  
Henry J. Thompson, Est.  
Mary B. Ives

Samuel Collins  
David J. Post  
Henry J. Thompson, Est.  
Mary B. Ives

John J. Post  
Joseph B. Thompson  
10892

Samuel Collins  
David J. Post  
Henry J. Thompson, Est.  
Mary B. Ives

Samuel Collins  
David J. Post  
Henry J. Thompson, Est.  
Mary B. Ives

