


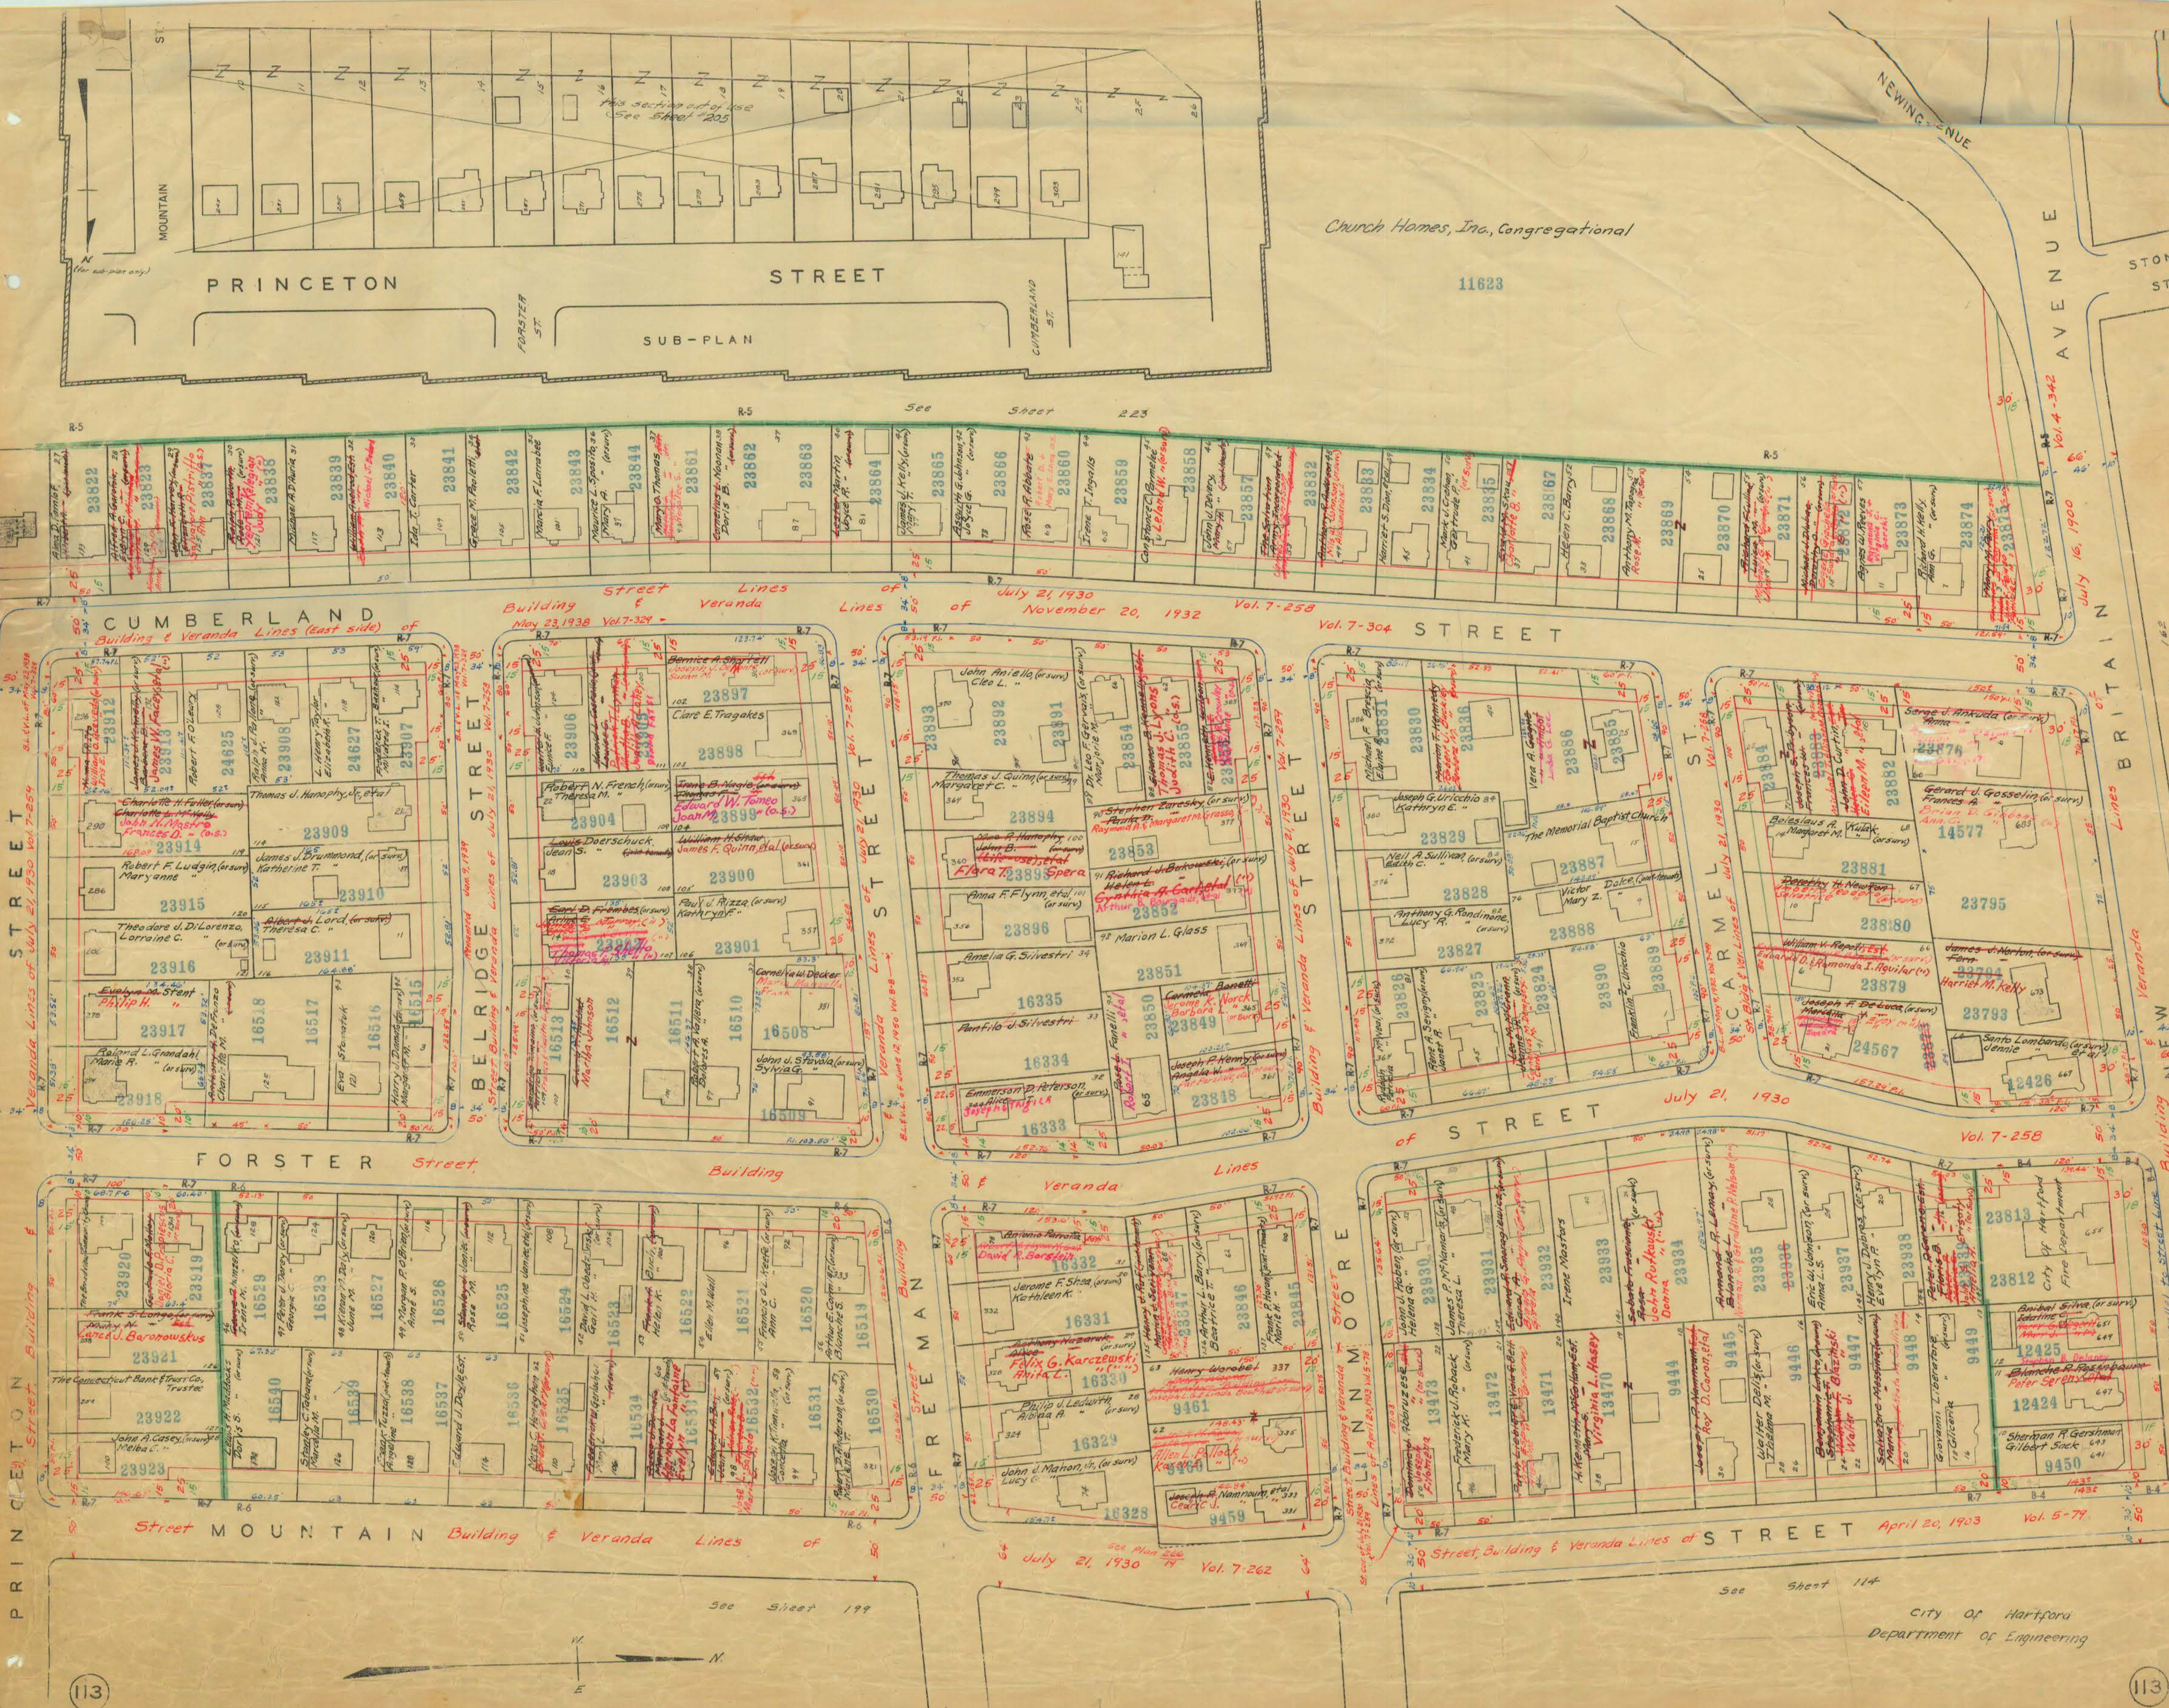

PRINCETON

STREET

SUB-PLAN

Church Homes, Inc., Congregational

11623

STONE ST.

NEWING AVENUE

Vol. 4-342

July 16, 1900

Vol. 7-258

July 21, 1930

Vol. 7-259

November 20, 1932

Vol. 7-304

July 21, 1930

Vol. 7-258

July 21, 1930

Vol. 7-259

July 21, 1930

Vol. 7-258

July 21, 1930

Vol. 7-259

CITY OF HARTFORD
Department of Engineering