


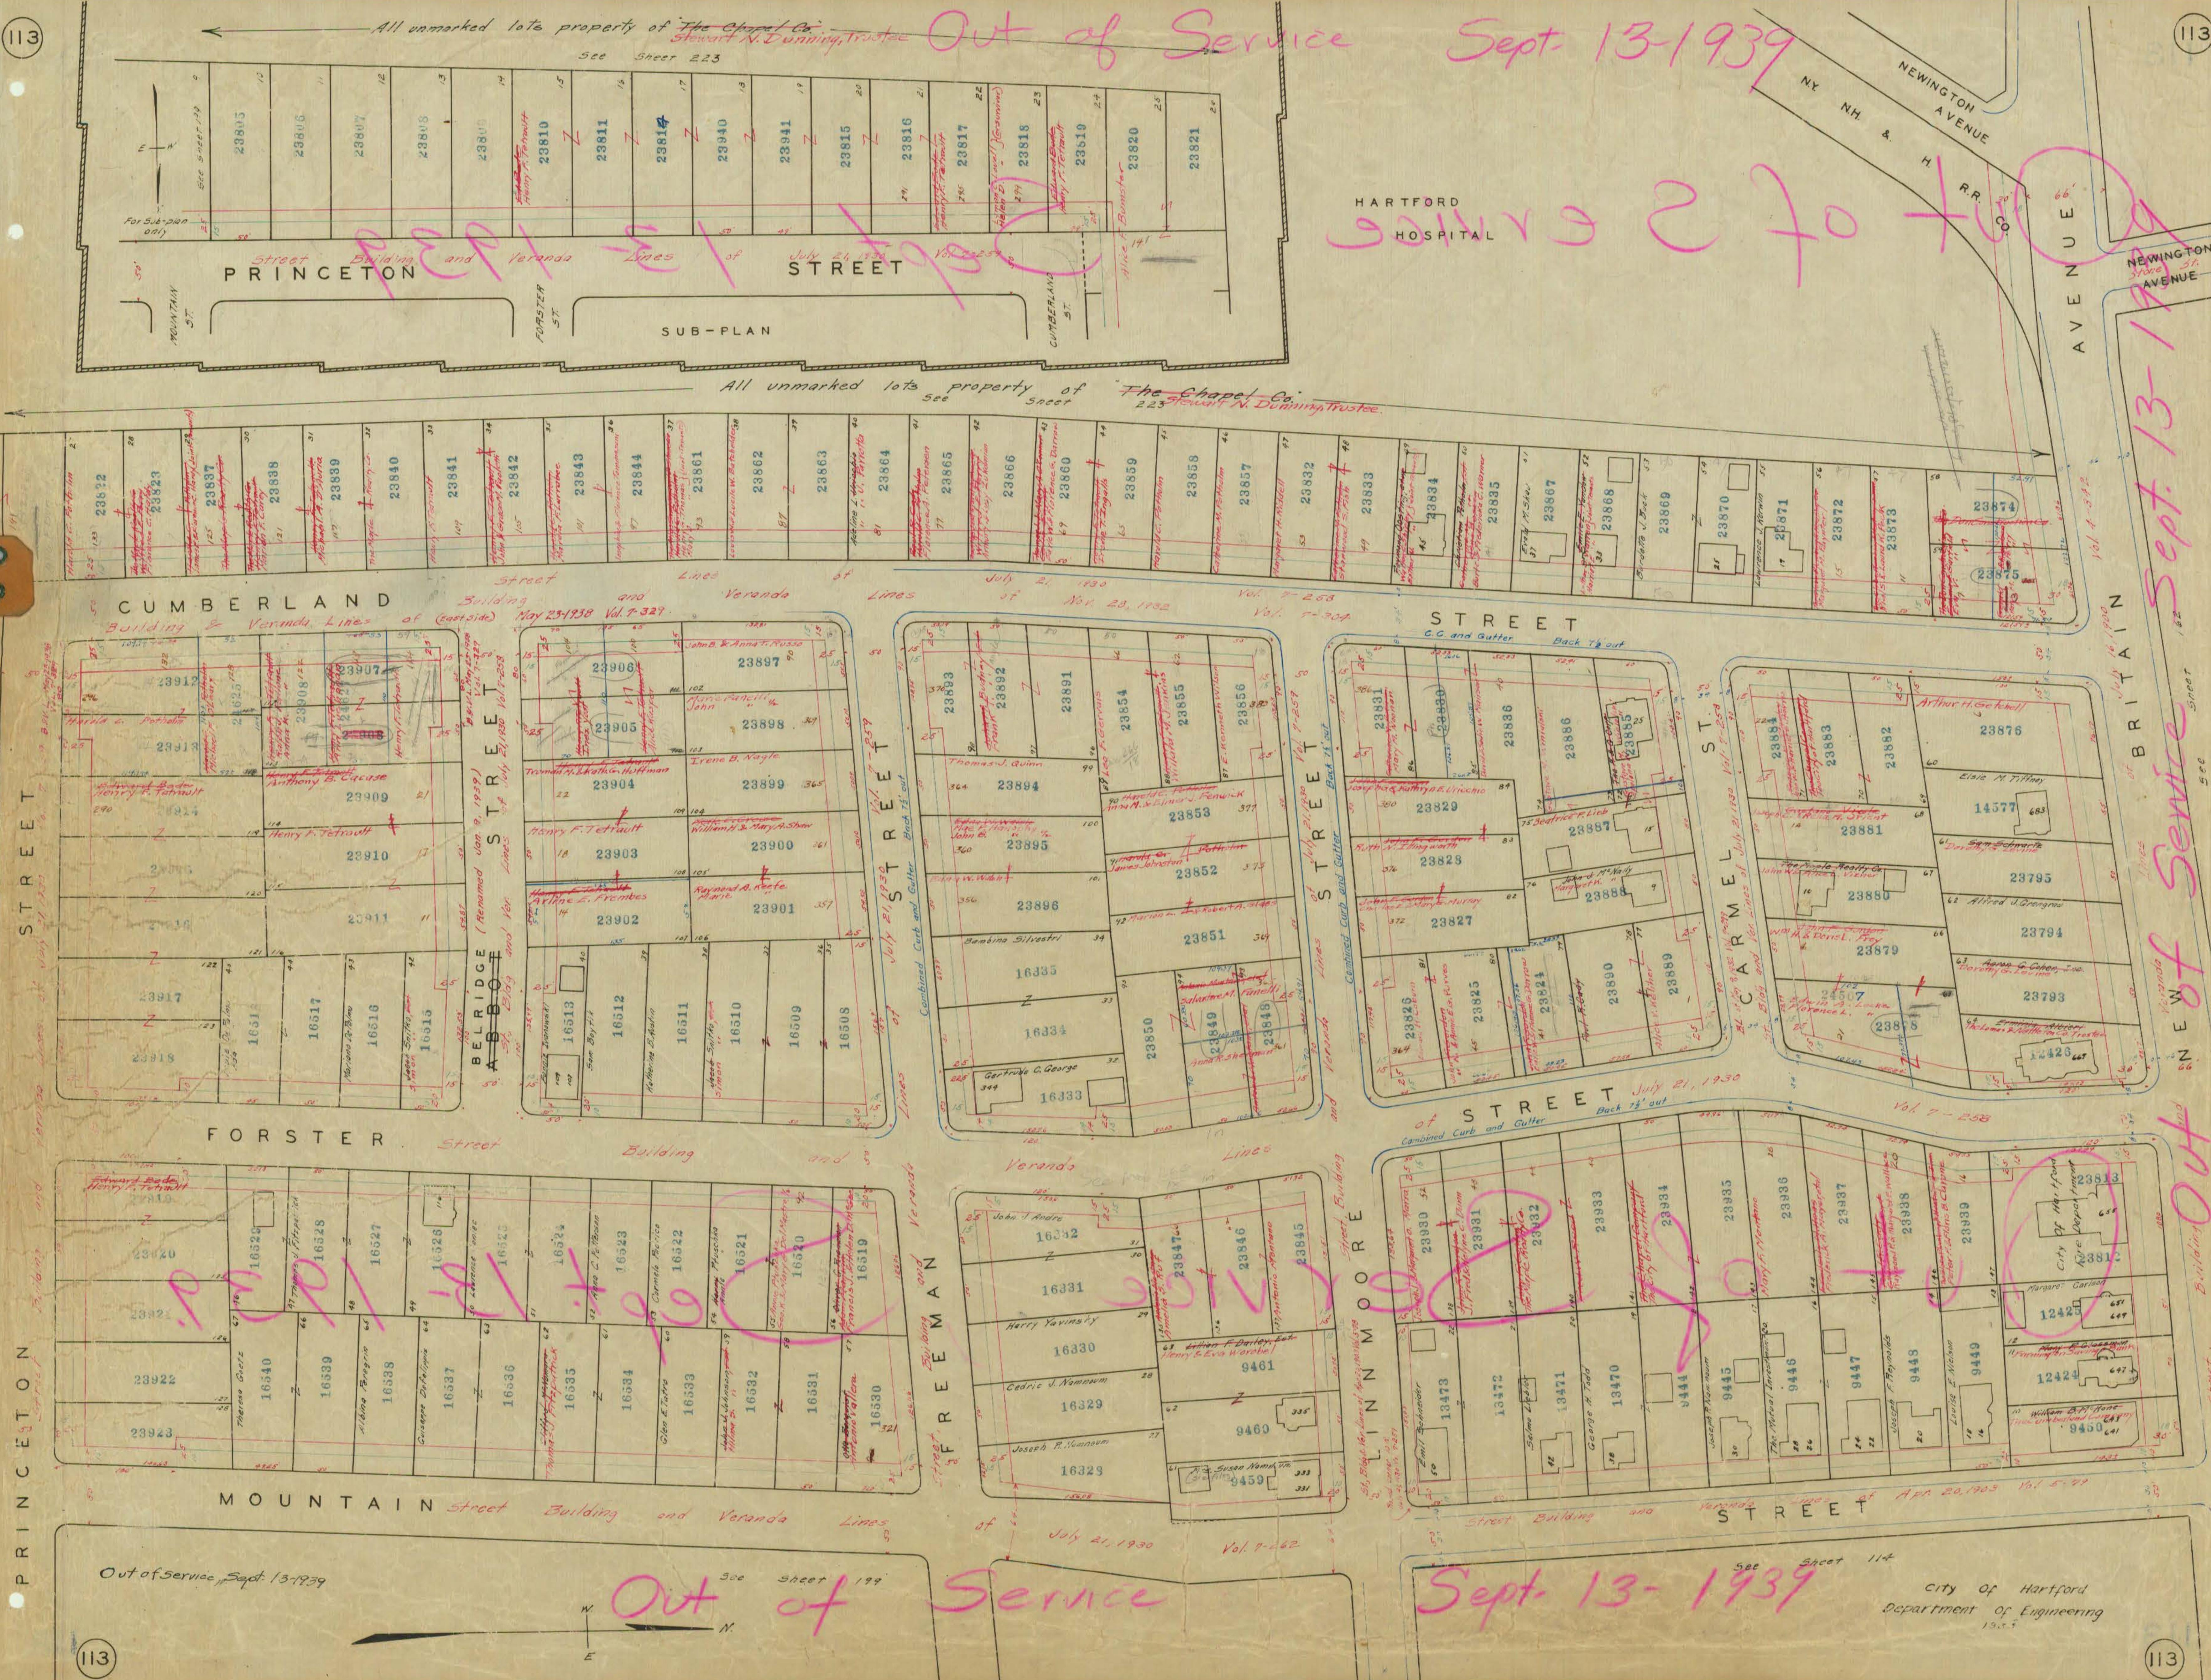

See Sub-plan on this sheet

See Sub-plan on this sheet

Out of Service Sept. 13-1939

Out of Service

Sept. 13-1939

City of Hartford
Department of Engineering
1935