

See Sheet 162









See Sheet 161

NEW BRITAIN AVE.

WHITE STREET

STREET

Vol. 4-325

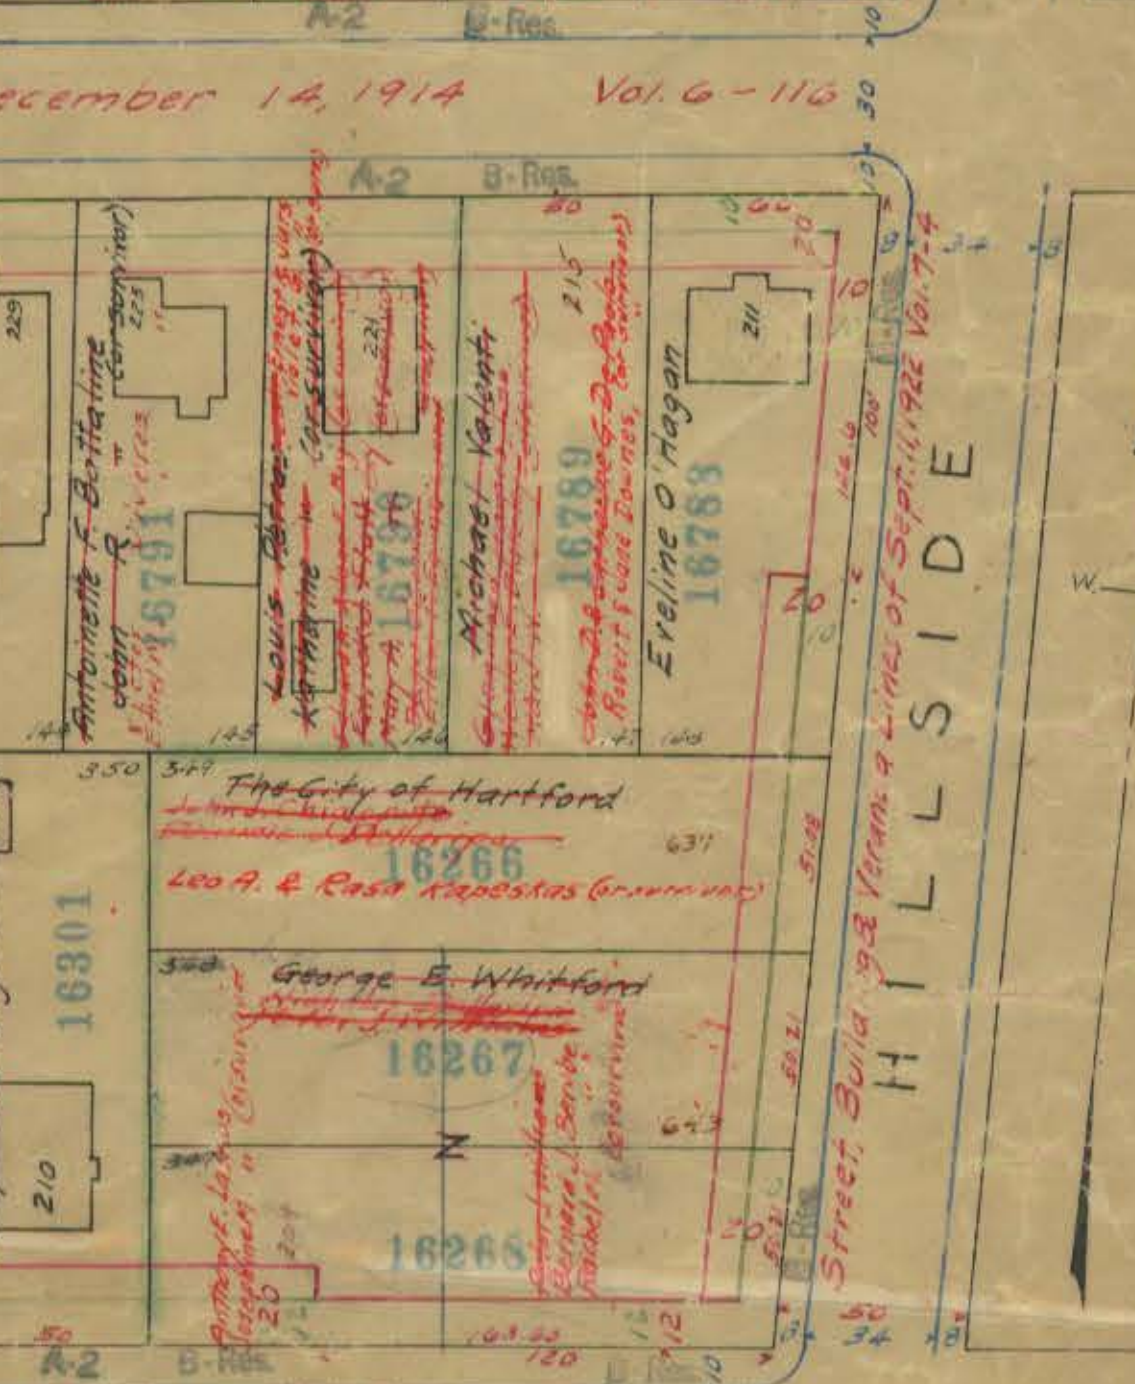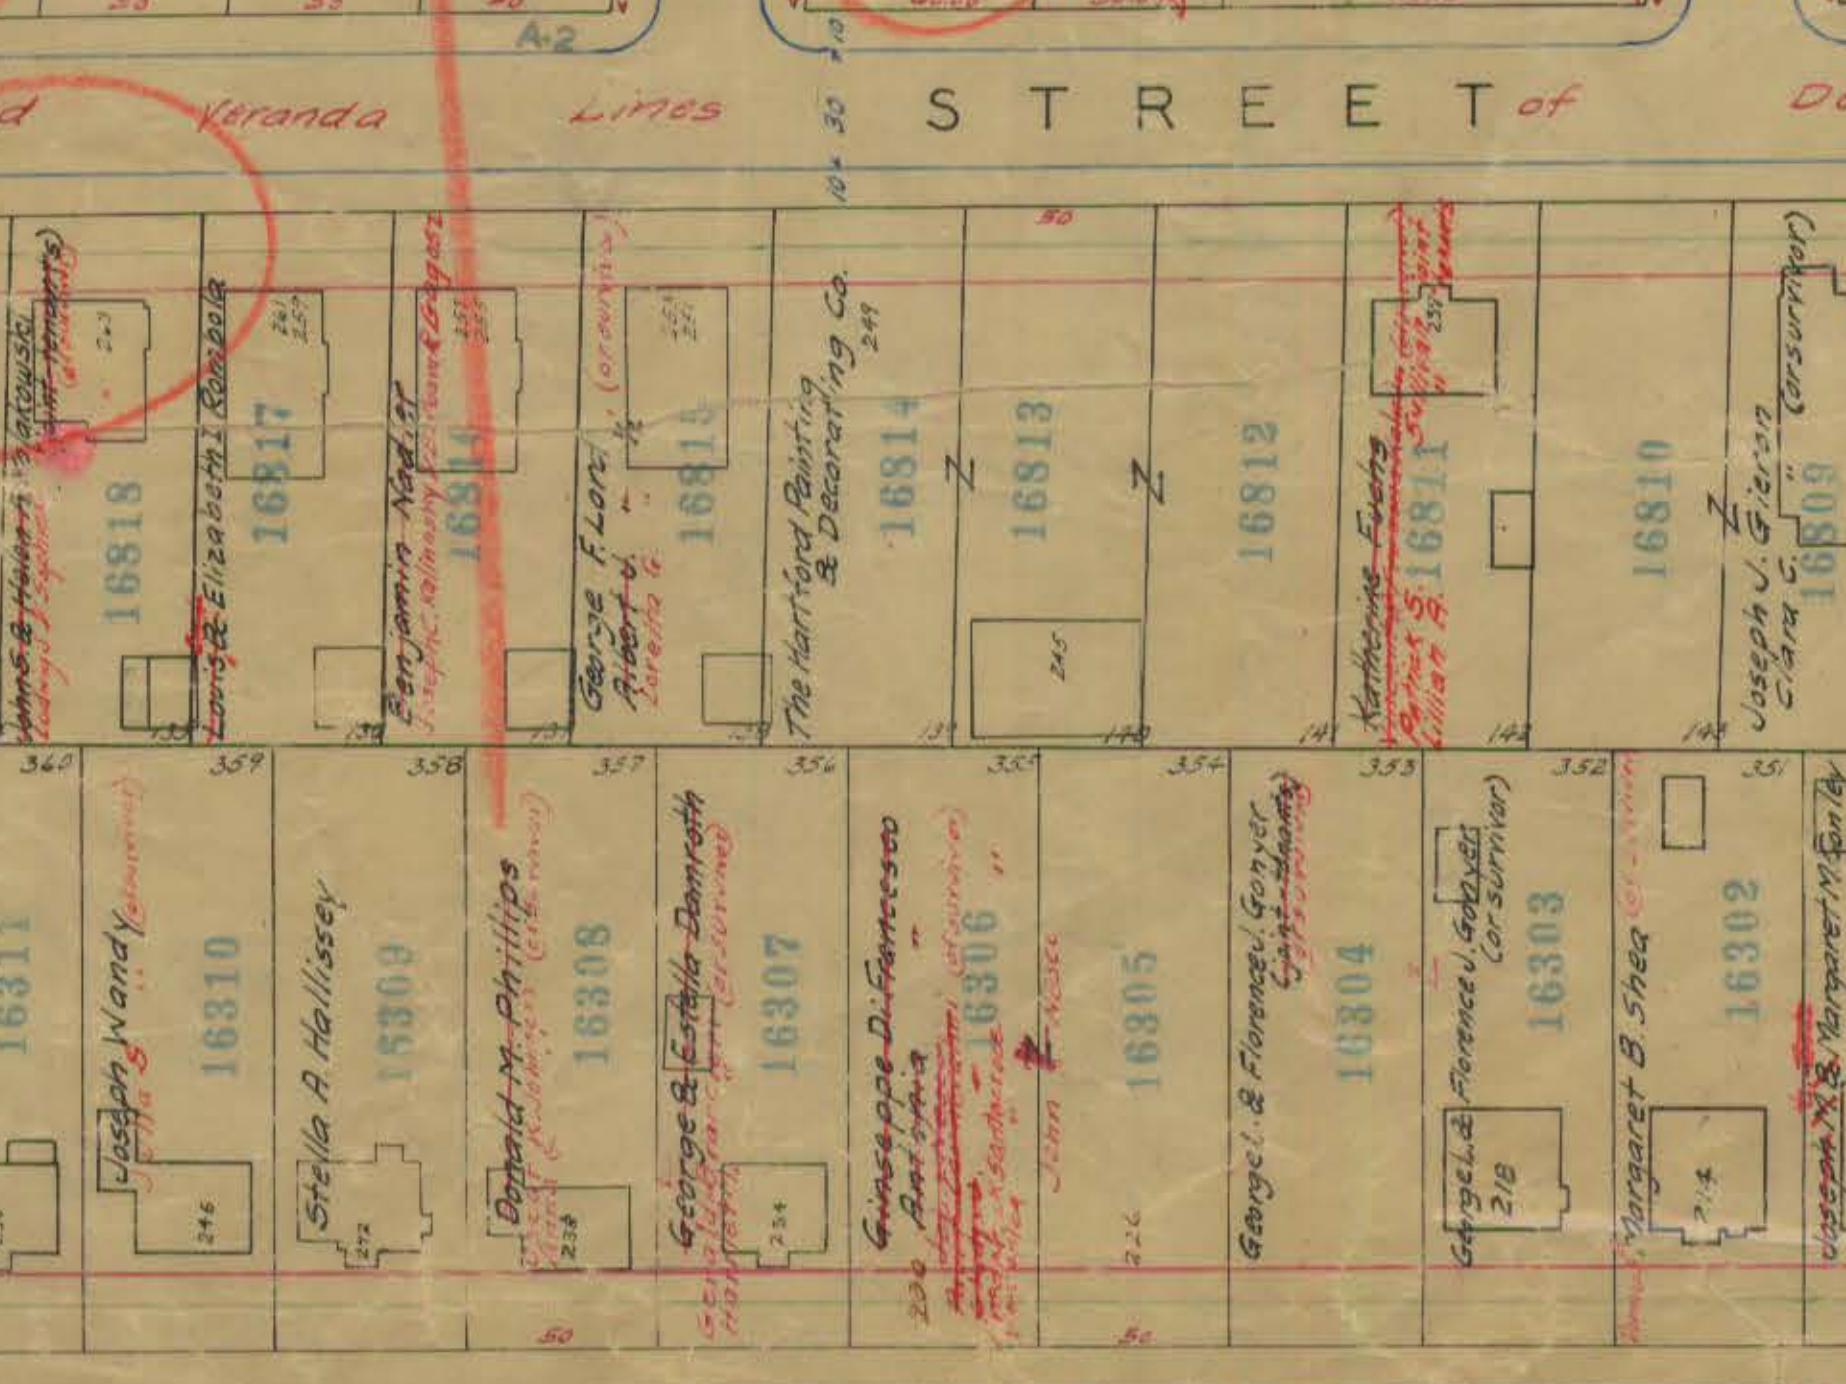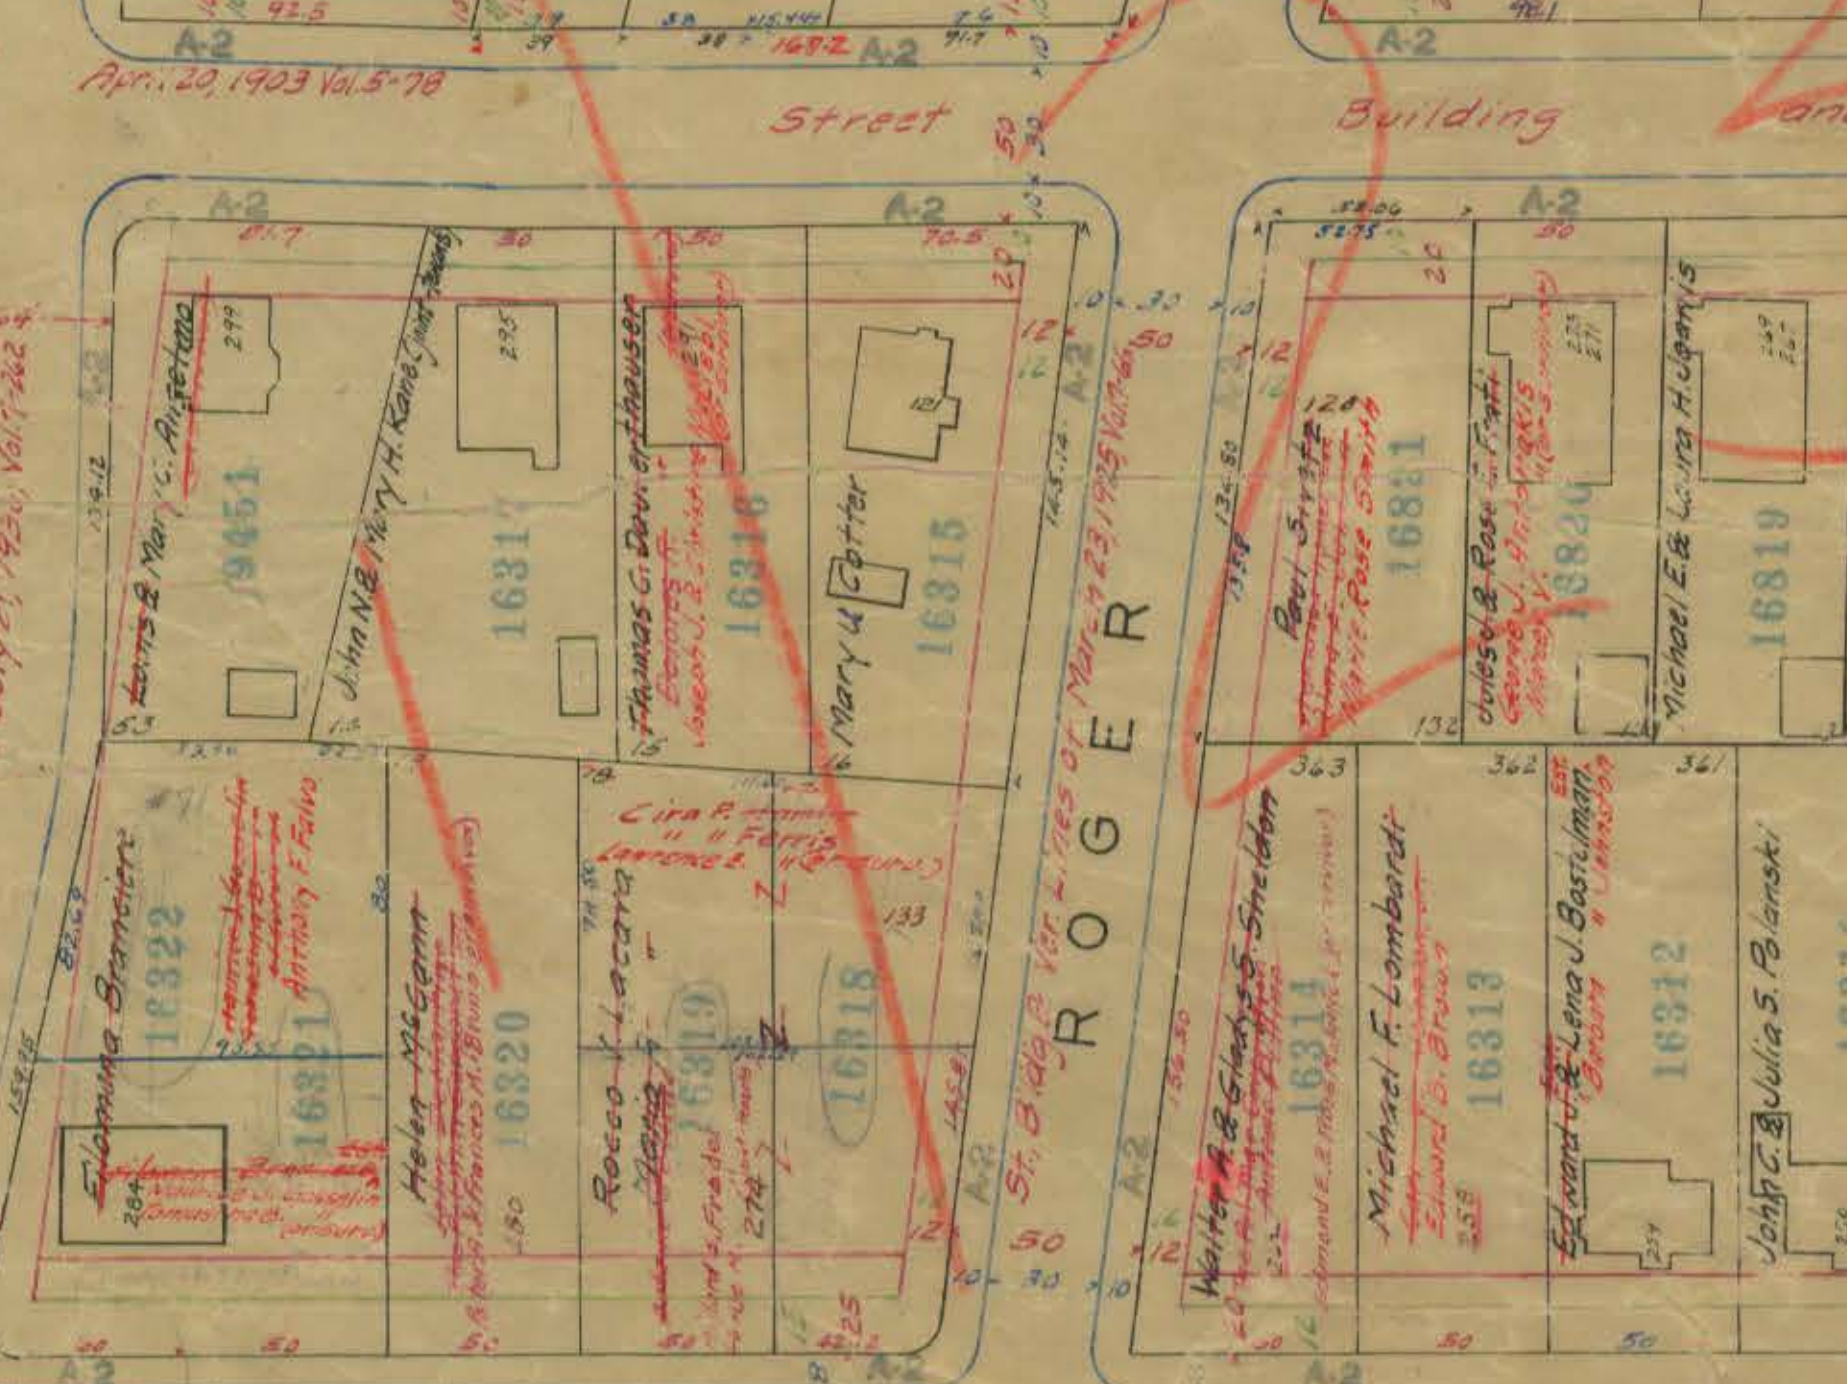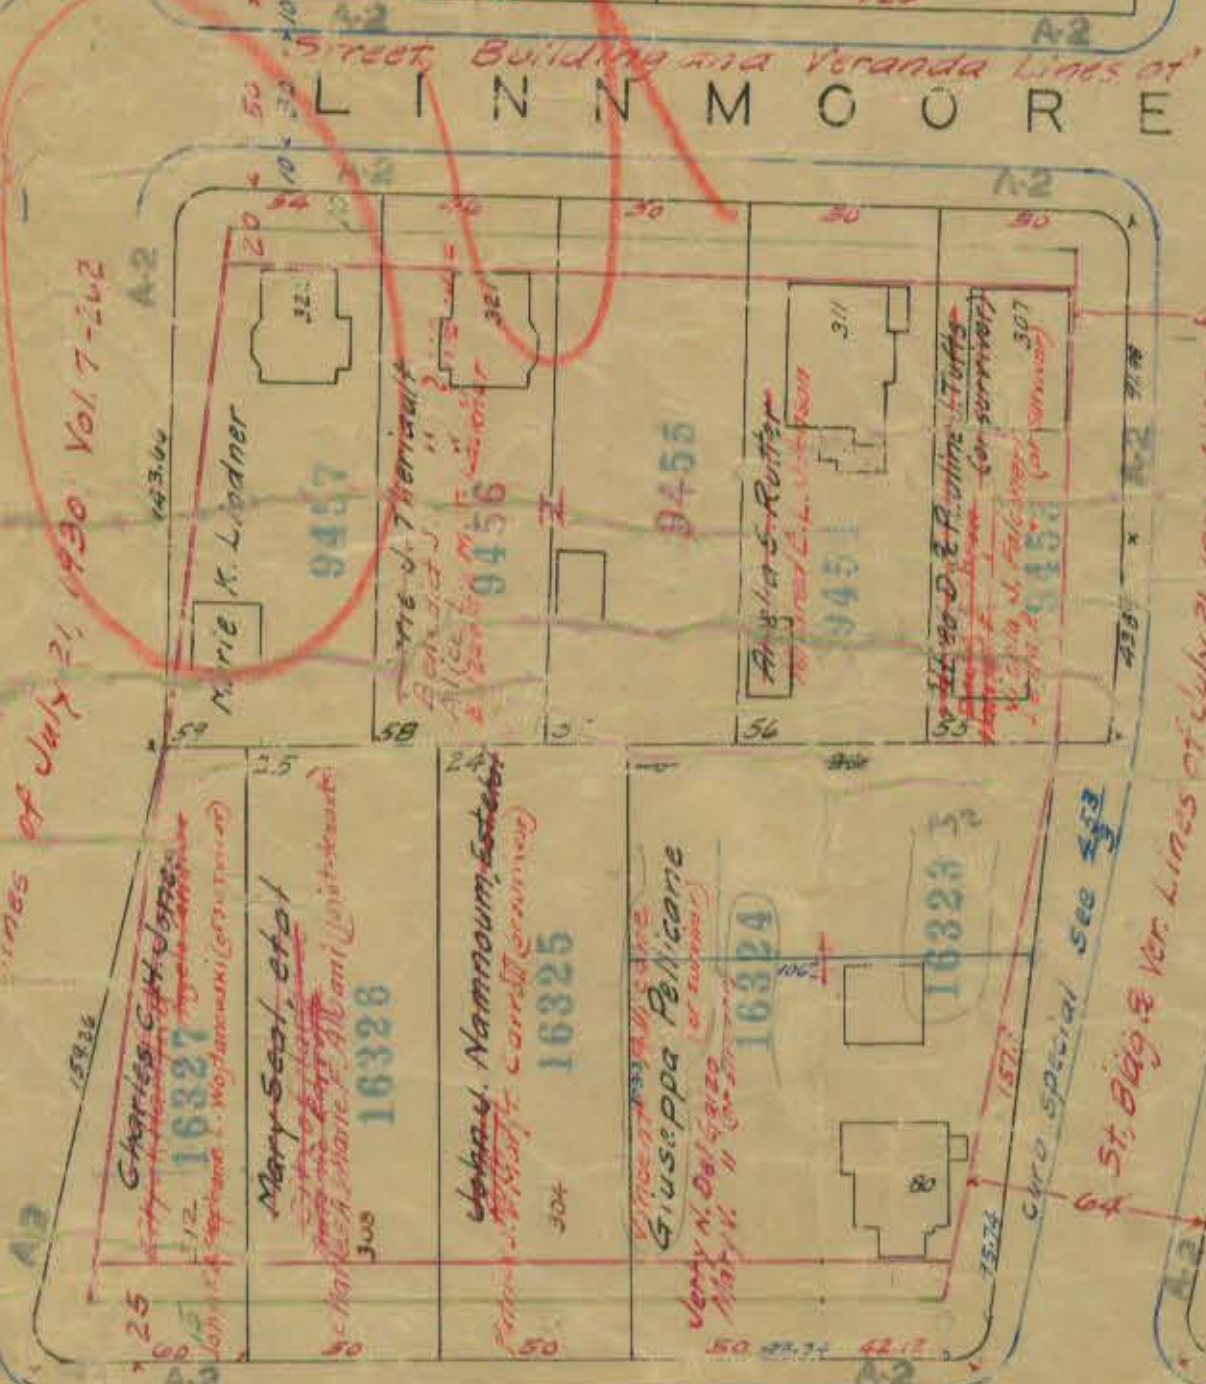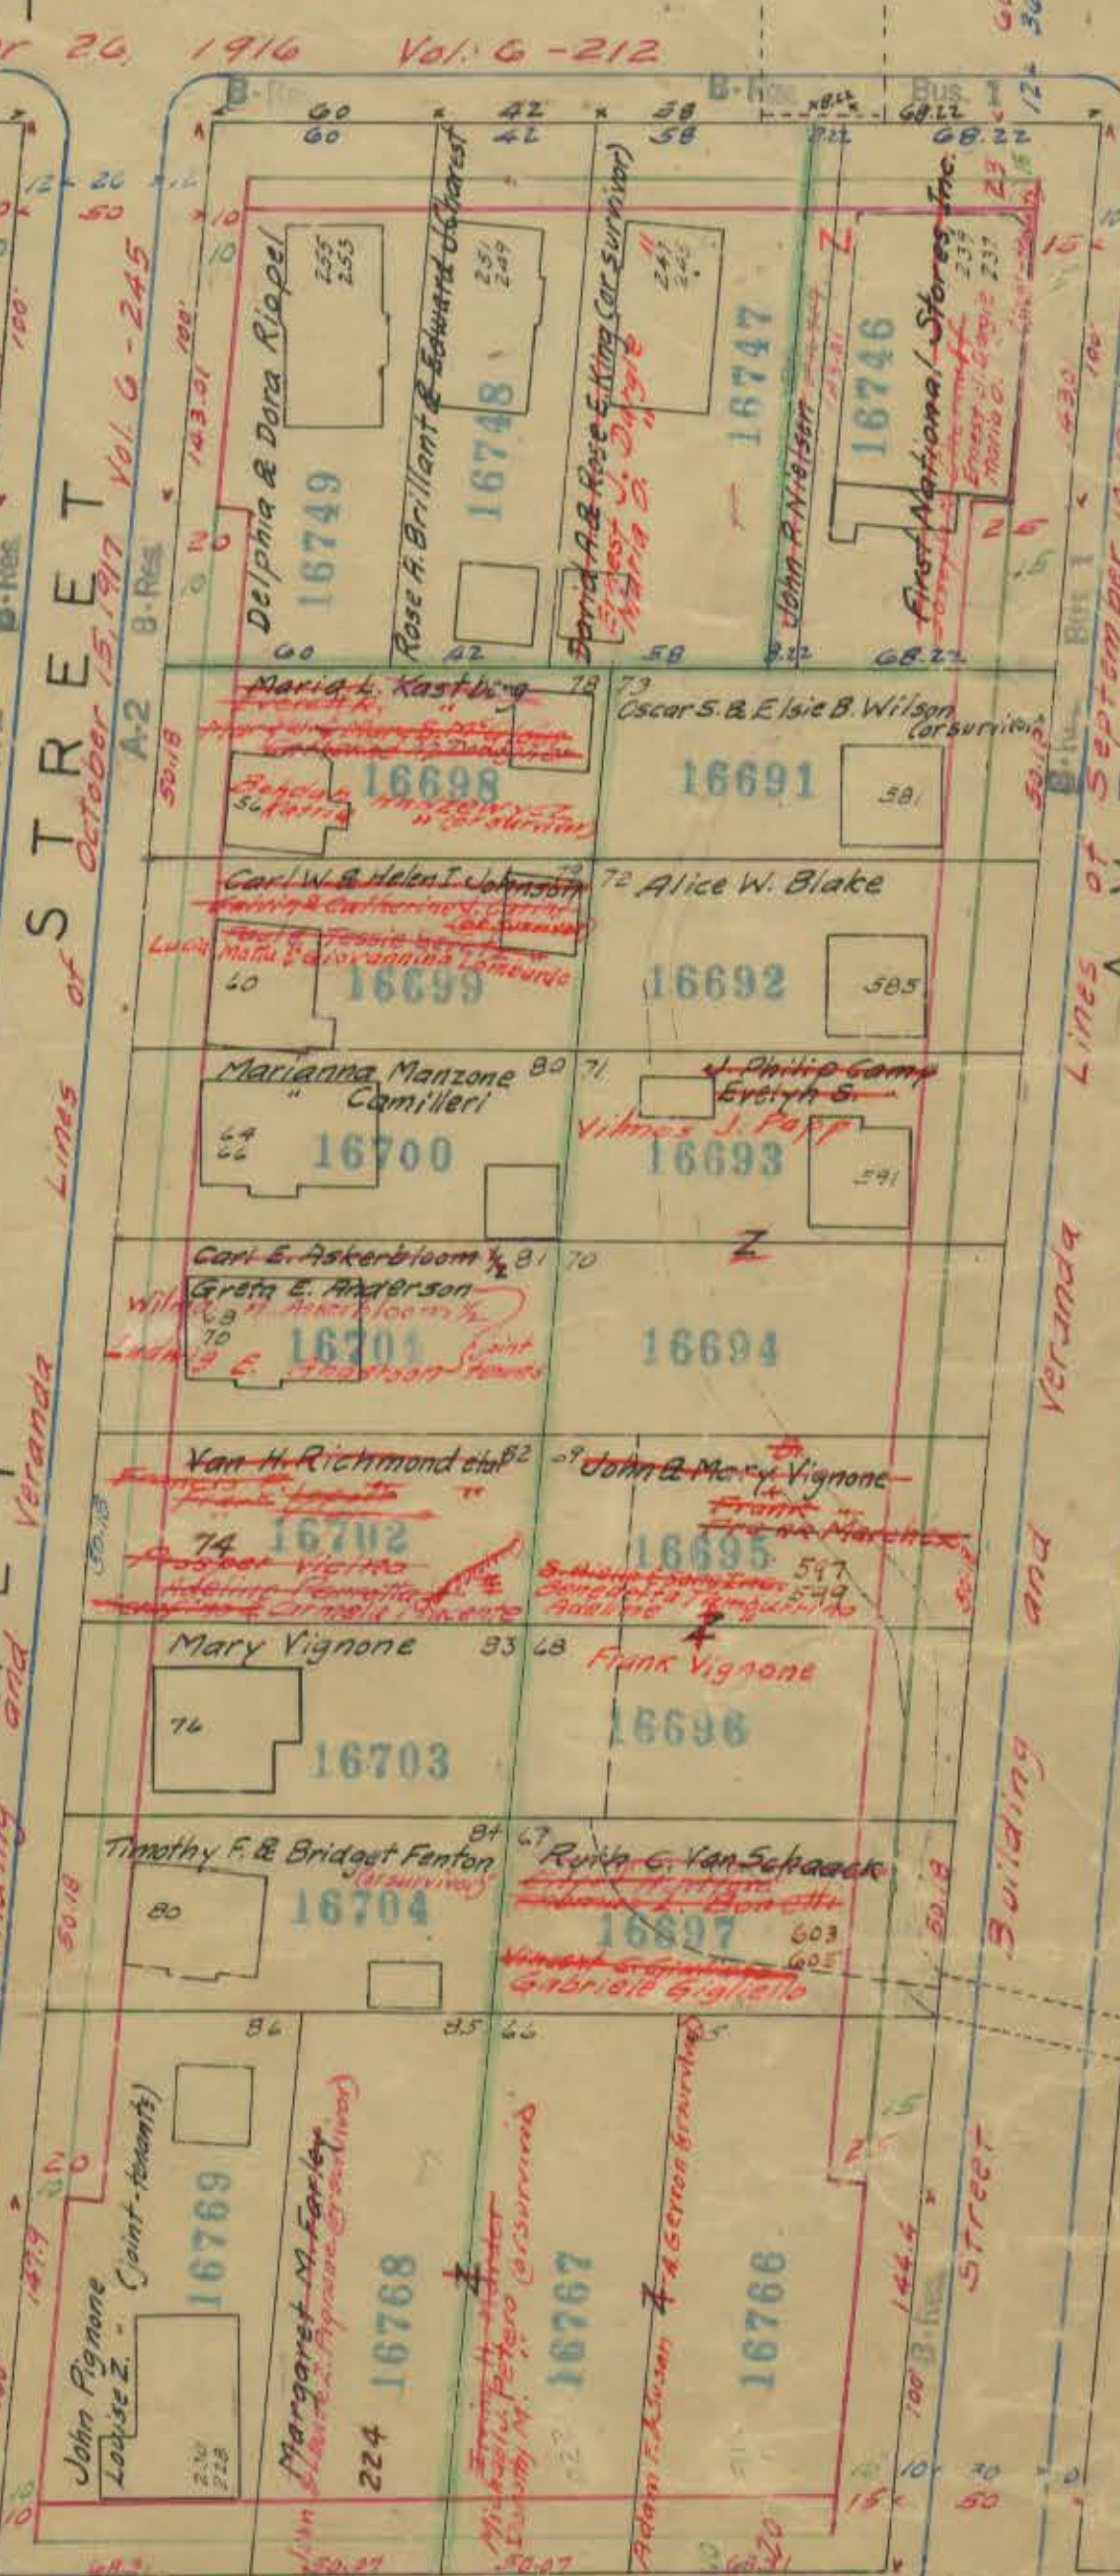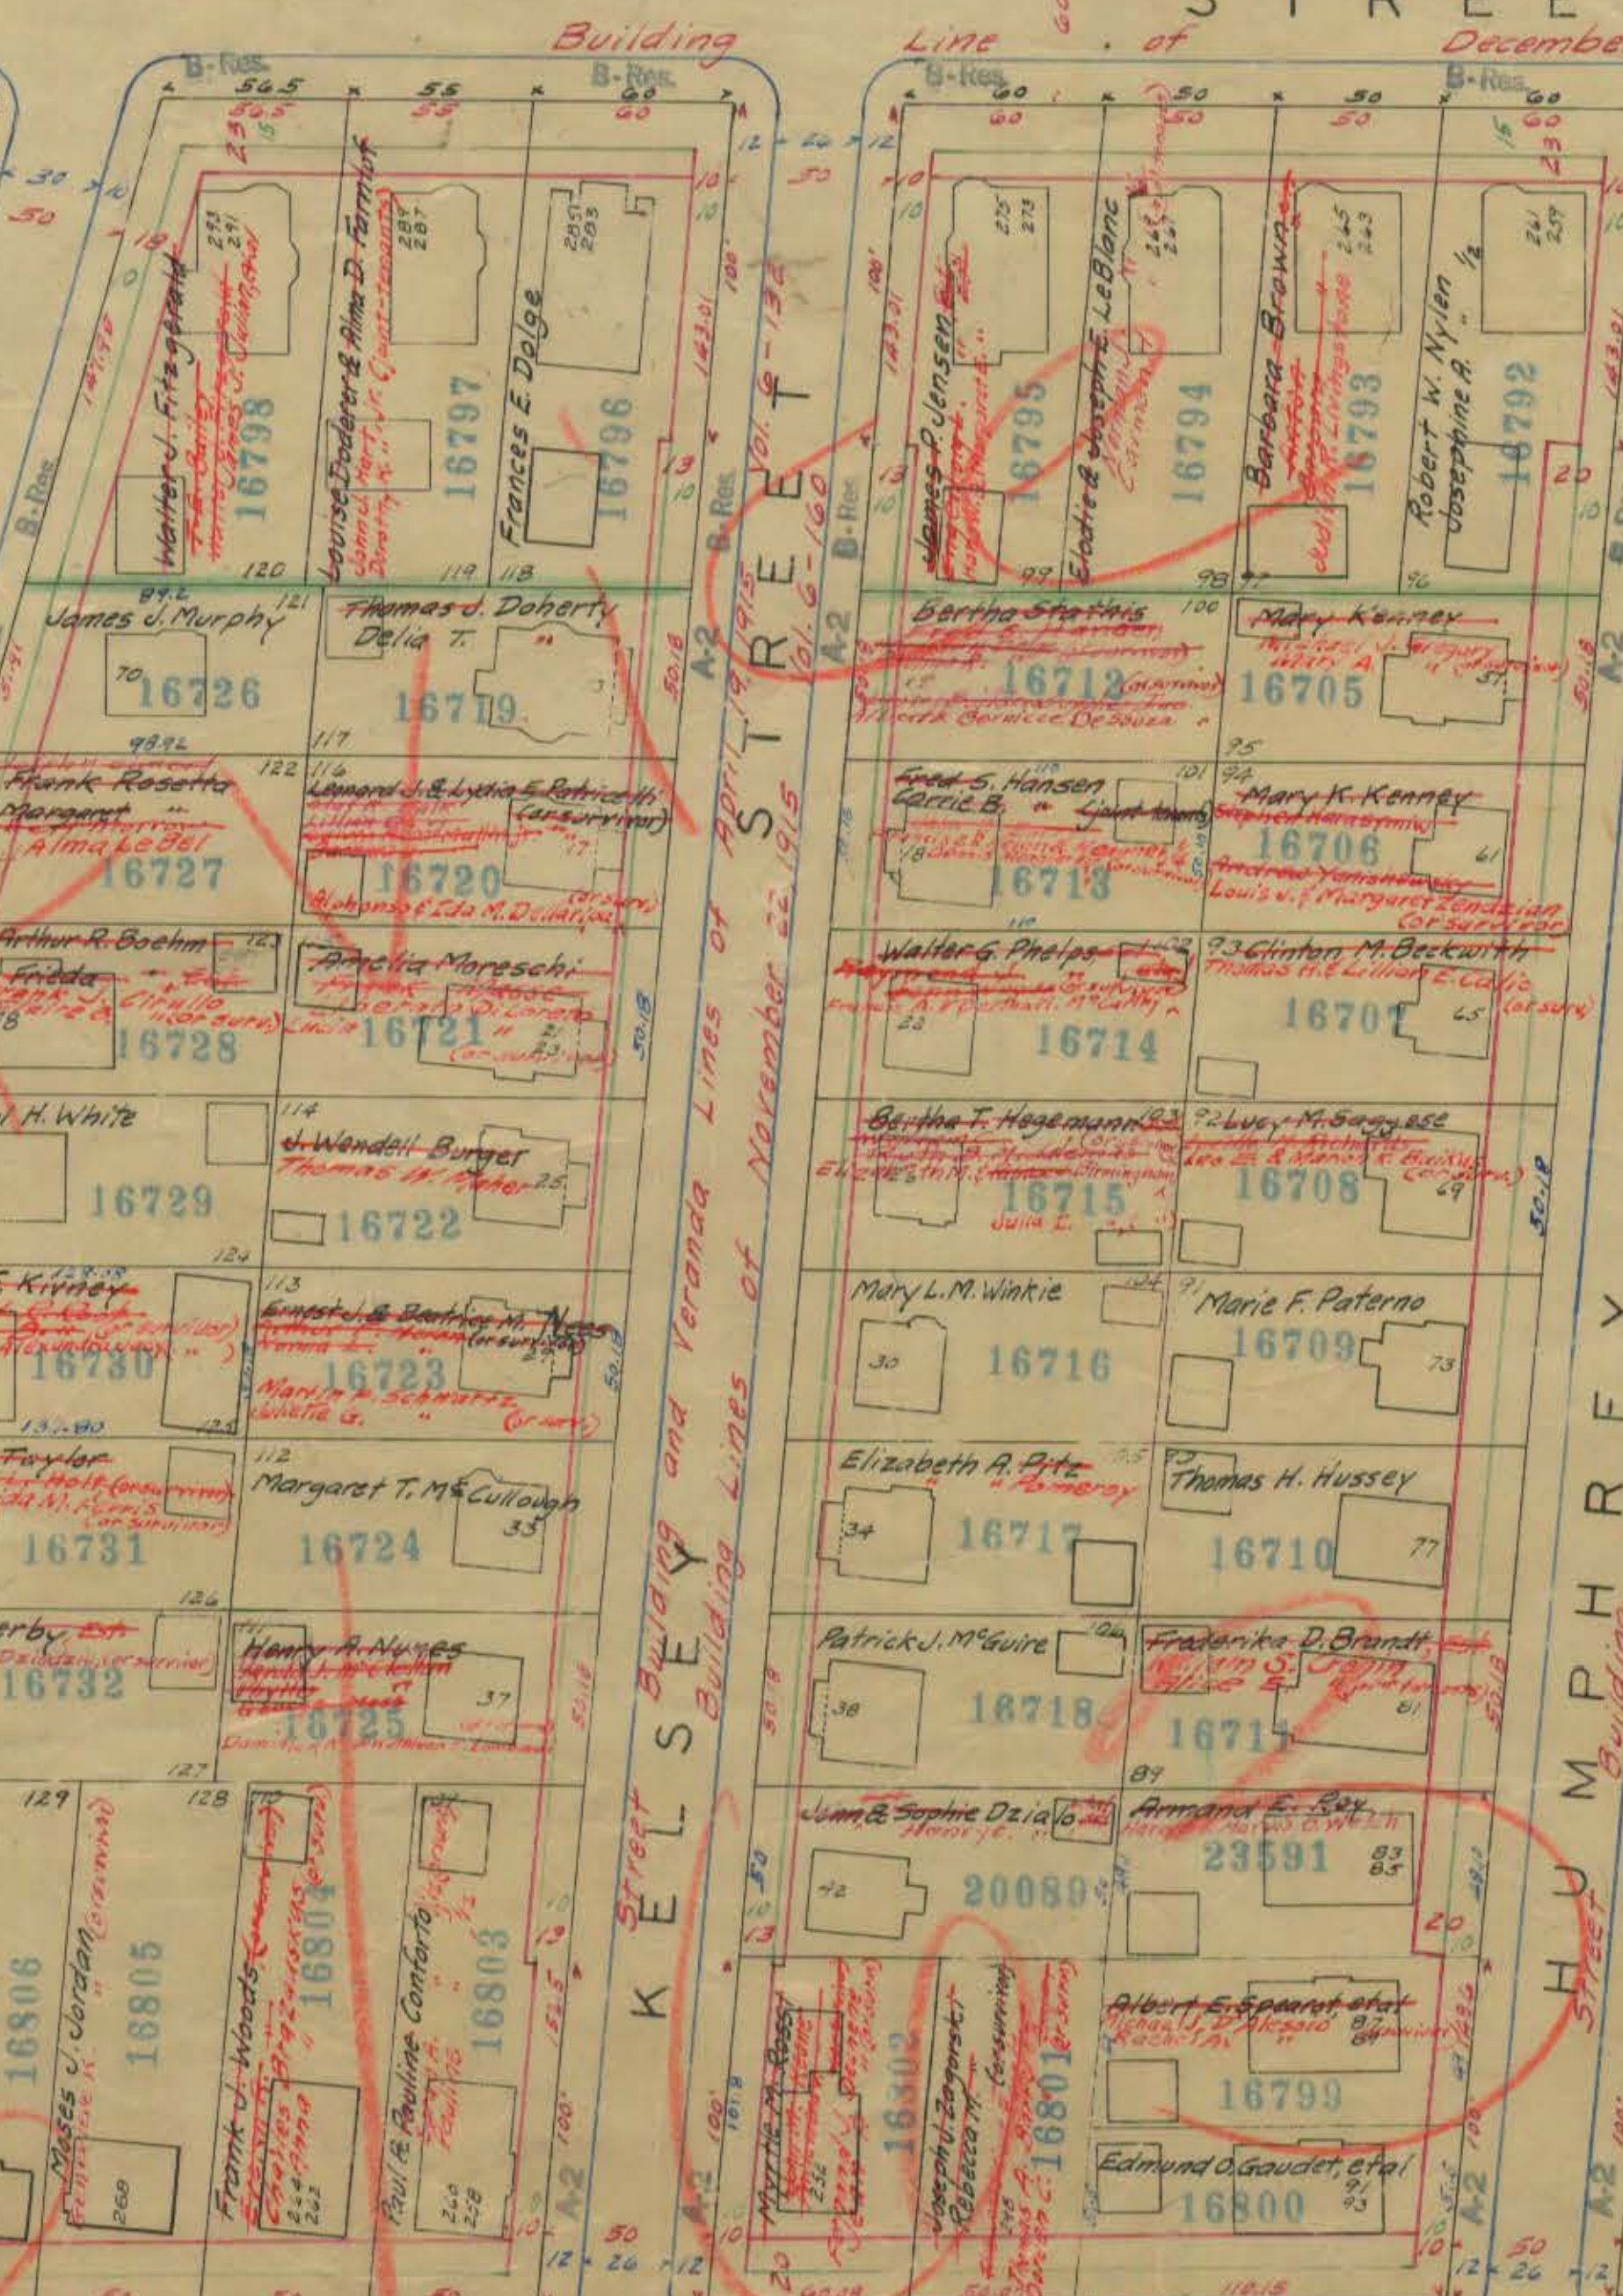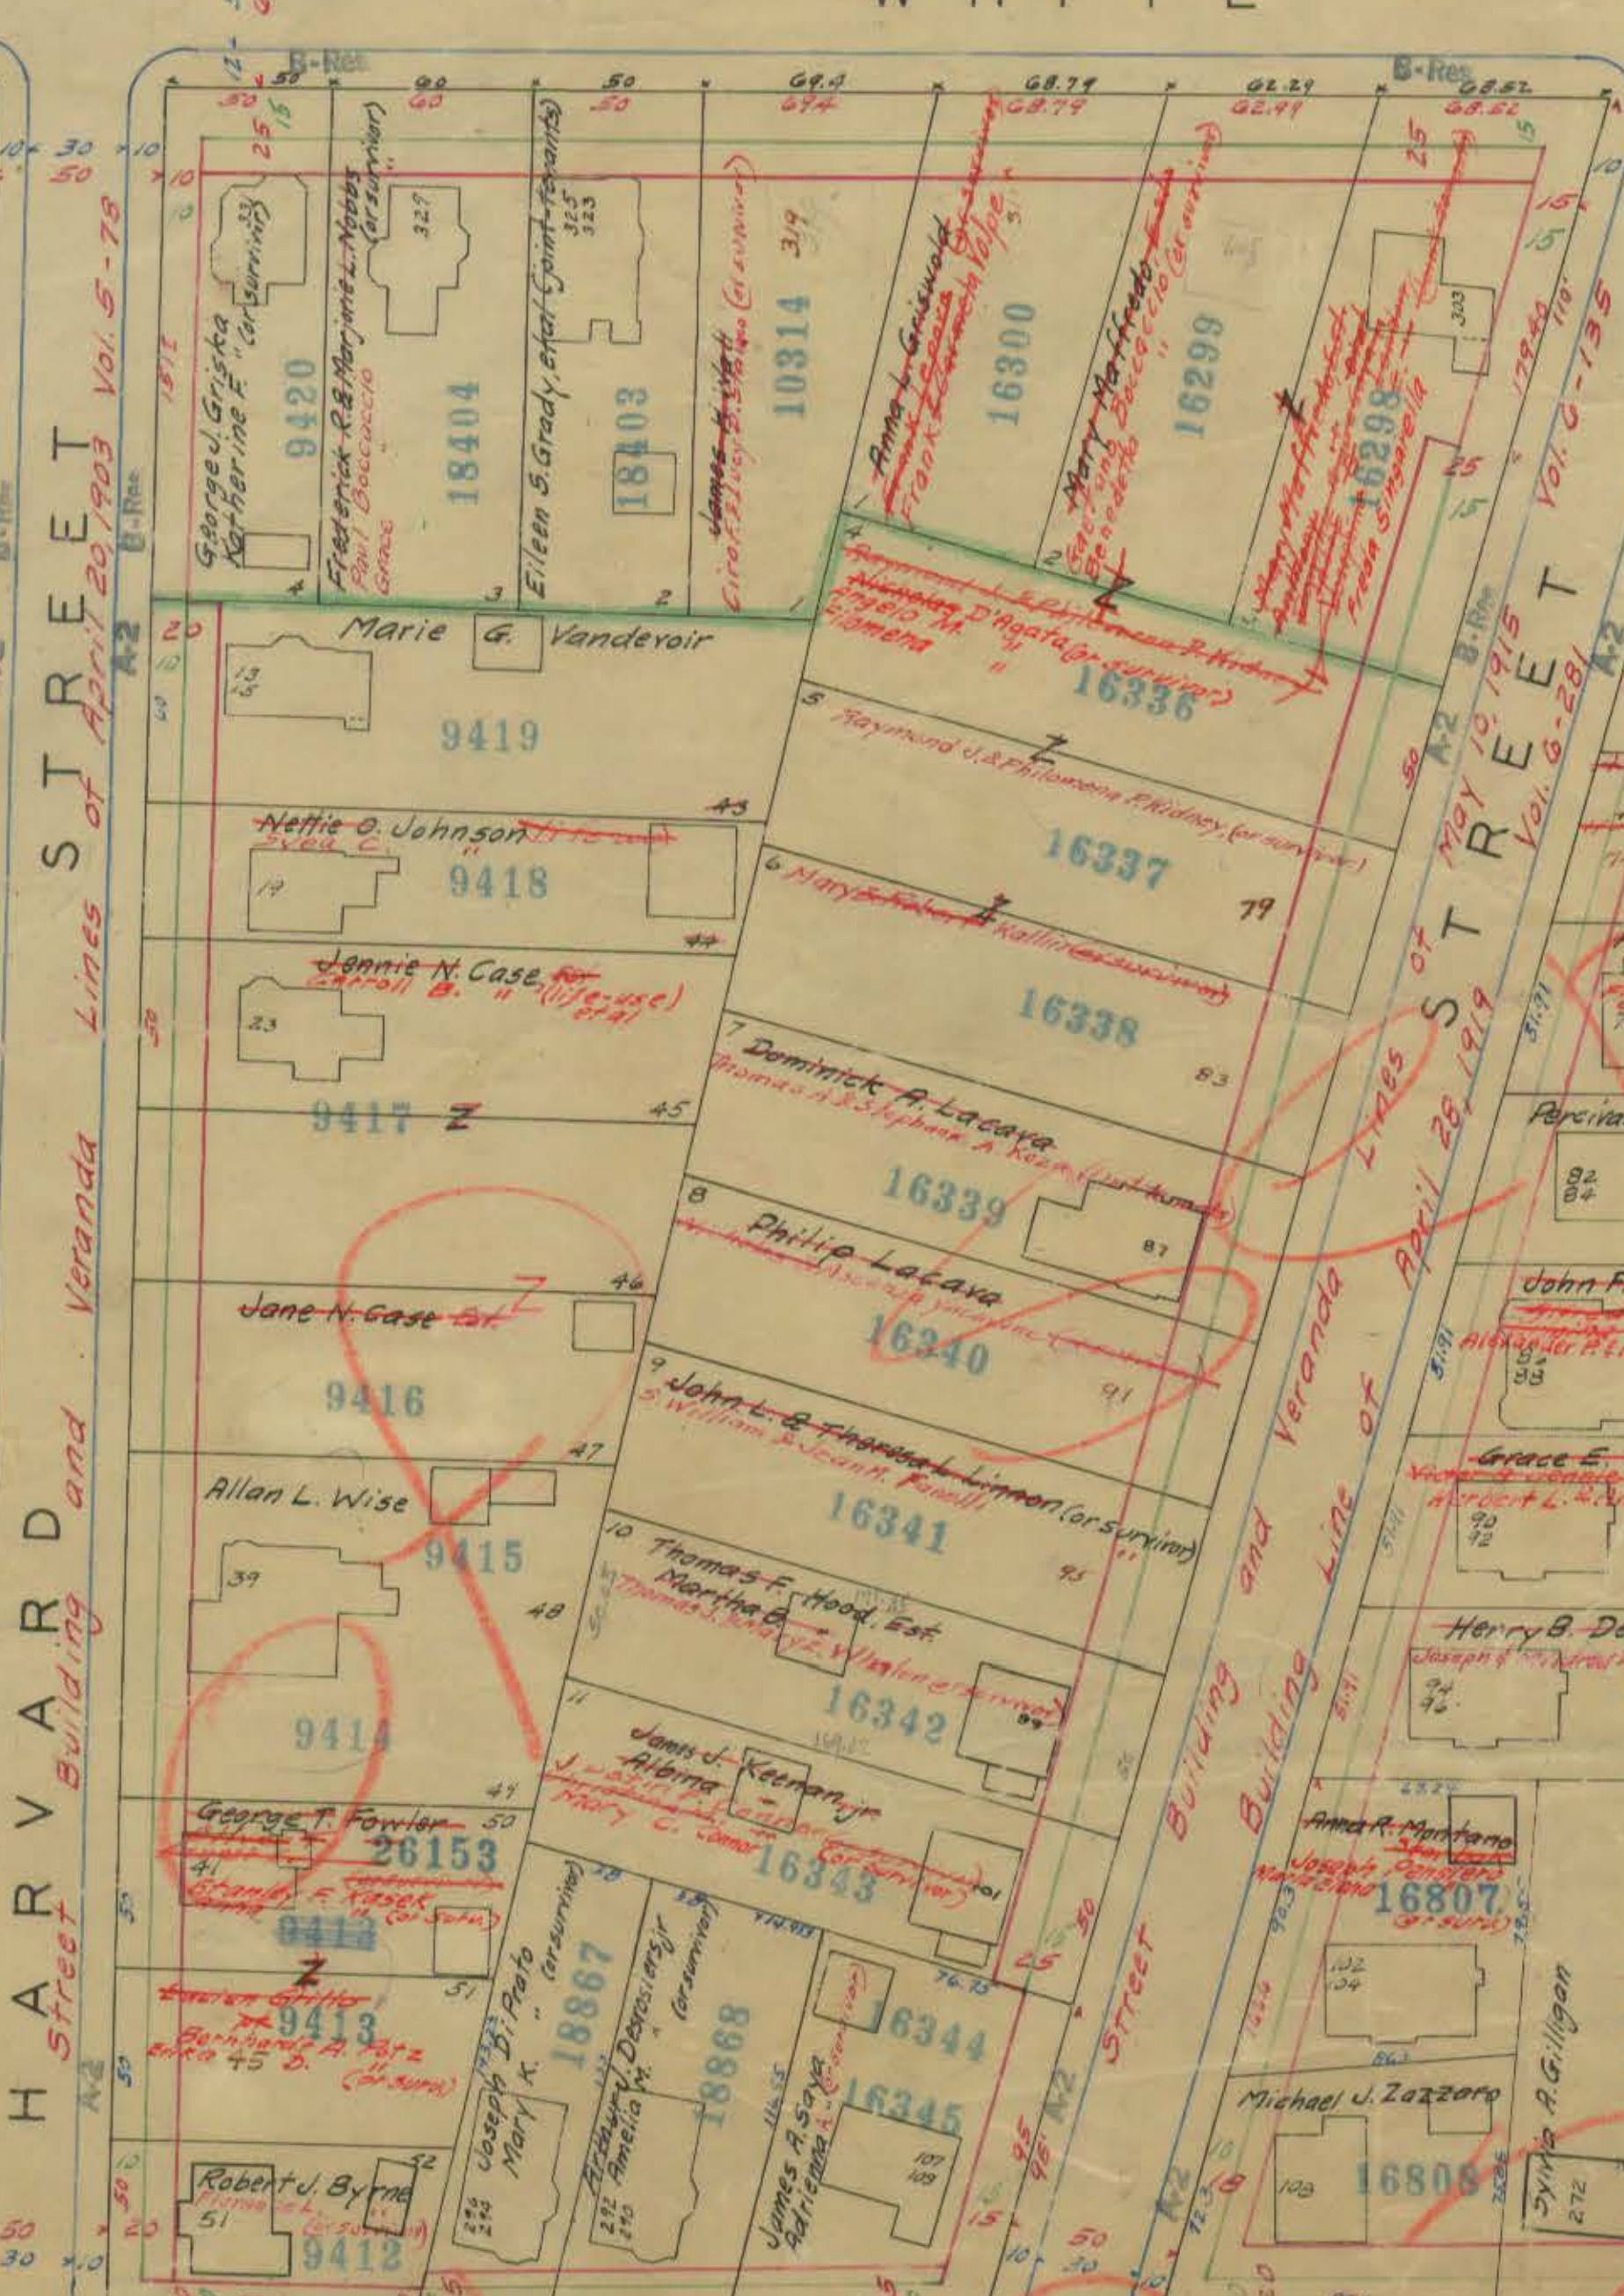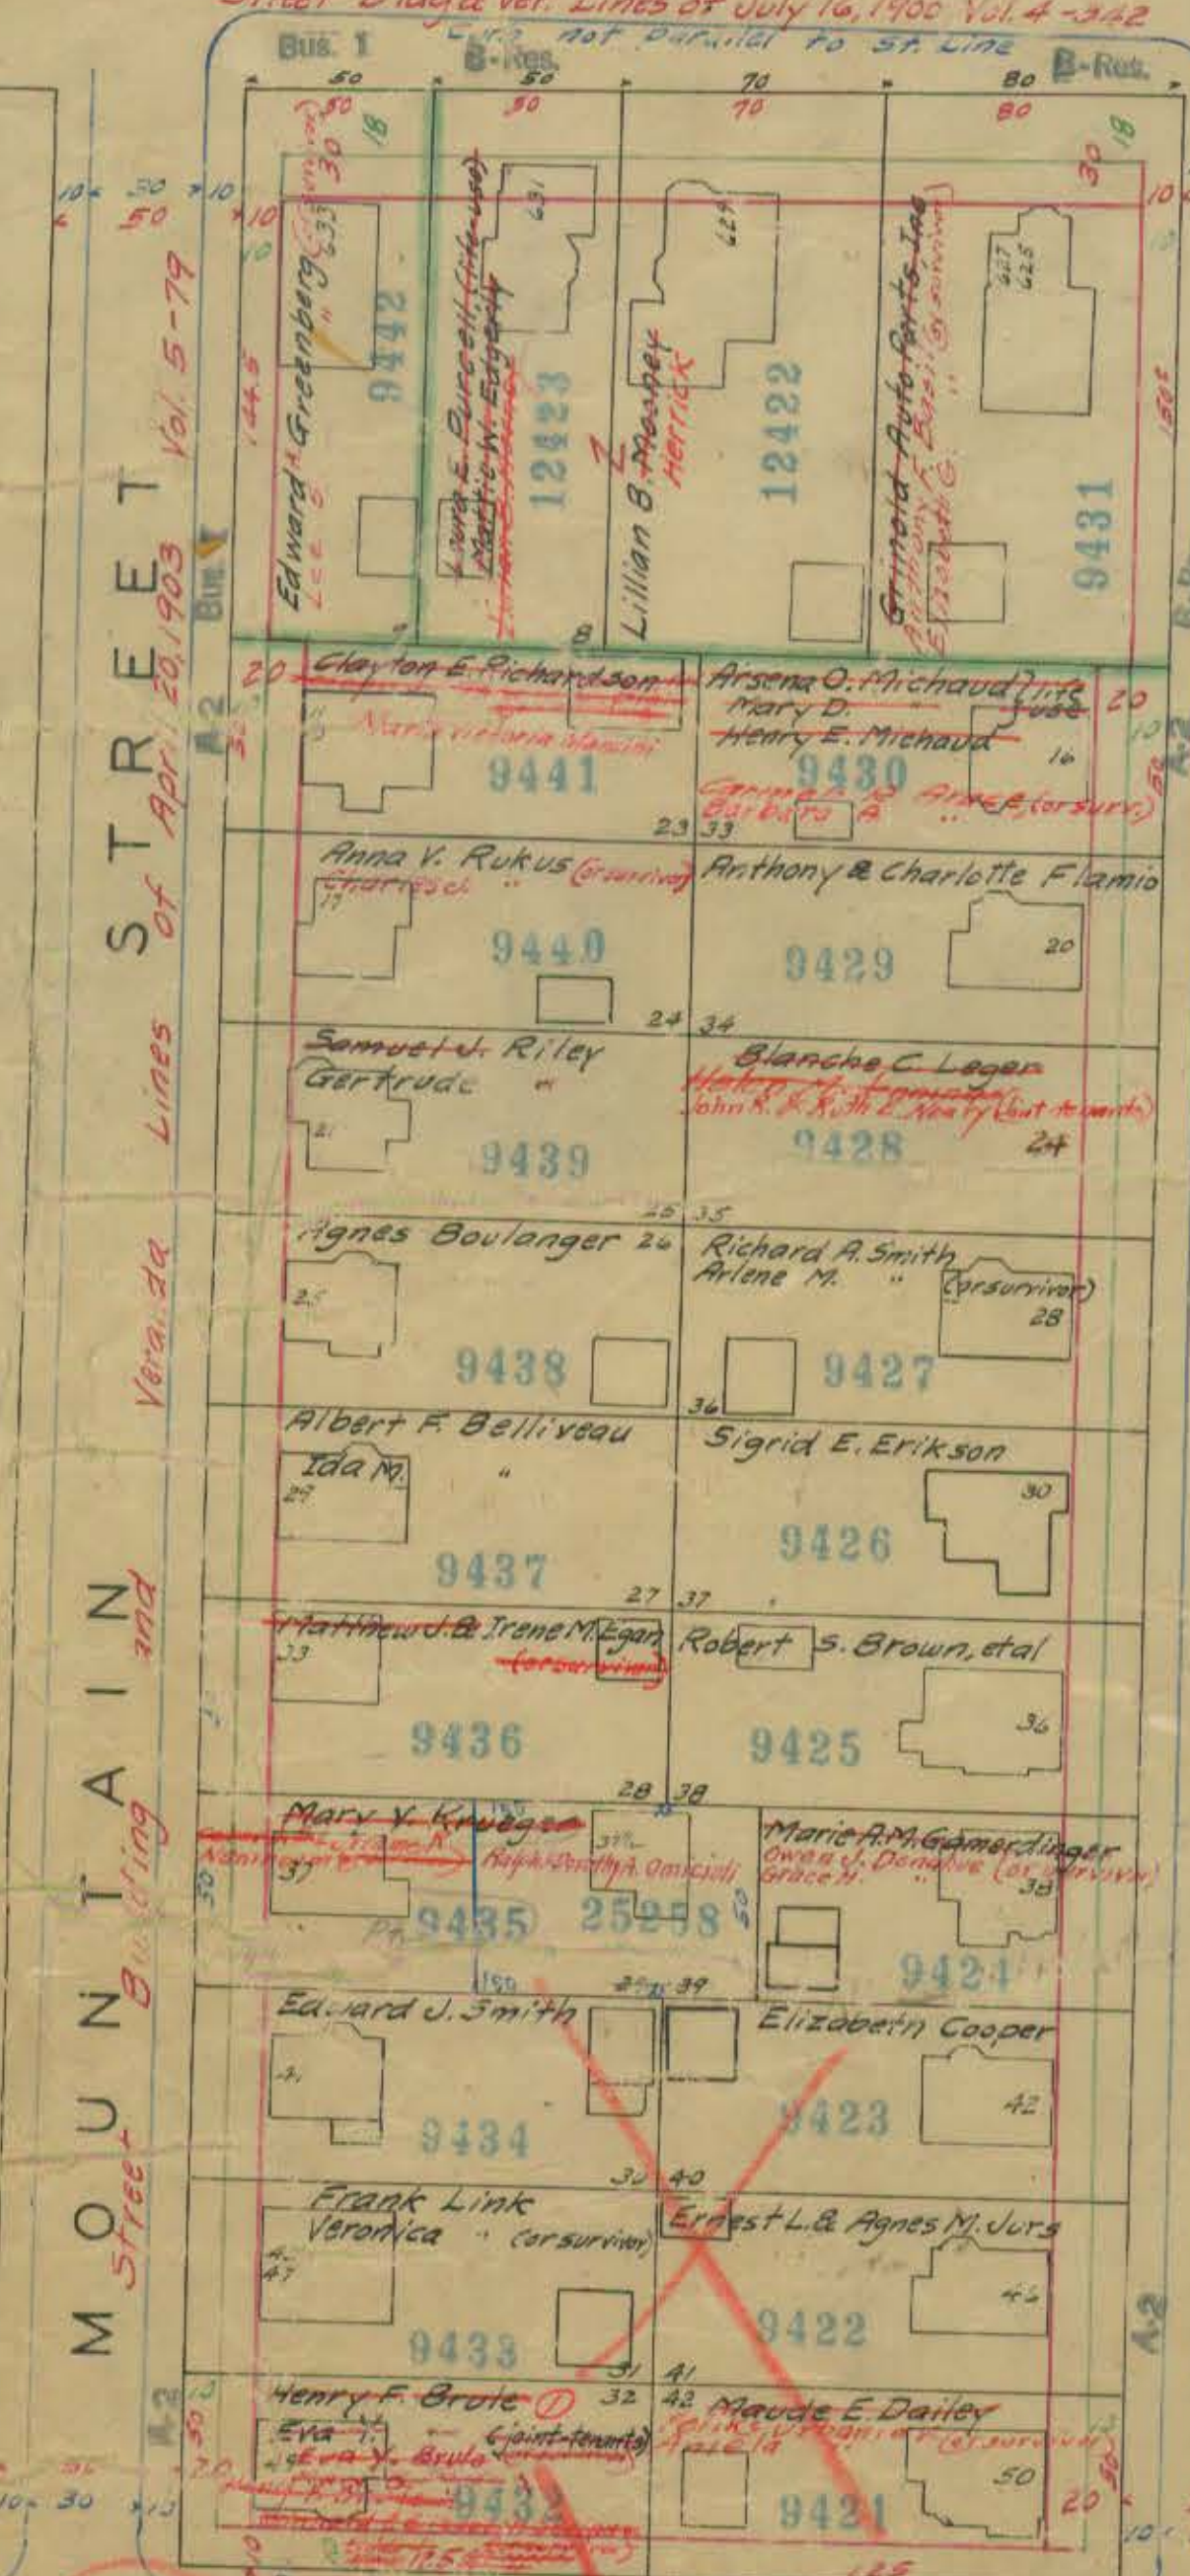

STREET

STREET

STREET

Vol. 7-65

See Sheet 199

See Sheet 199

CITY OF HARTFORD
Department of Engineering