

See Sheet 162

See Sheet 161

NEW BRITAIN AVE.

Street Building and Veranda Lines of July 16, 1900 Vol 4-342

WHITE STREET

Veranda

Building








Lines

of

STREET

Nov. 27, 1894

Vol. 4-325

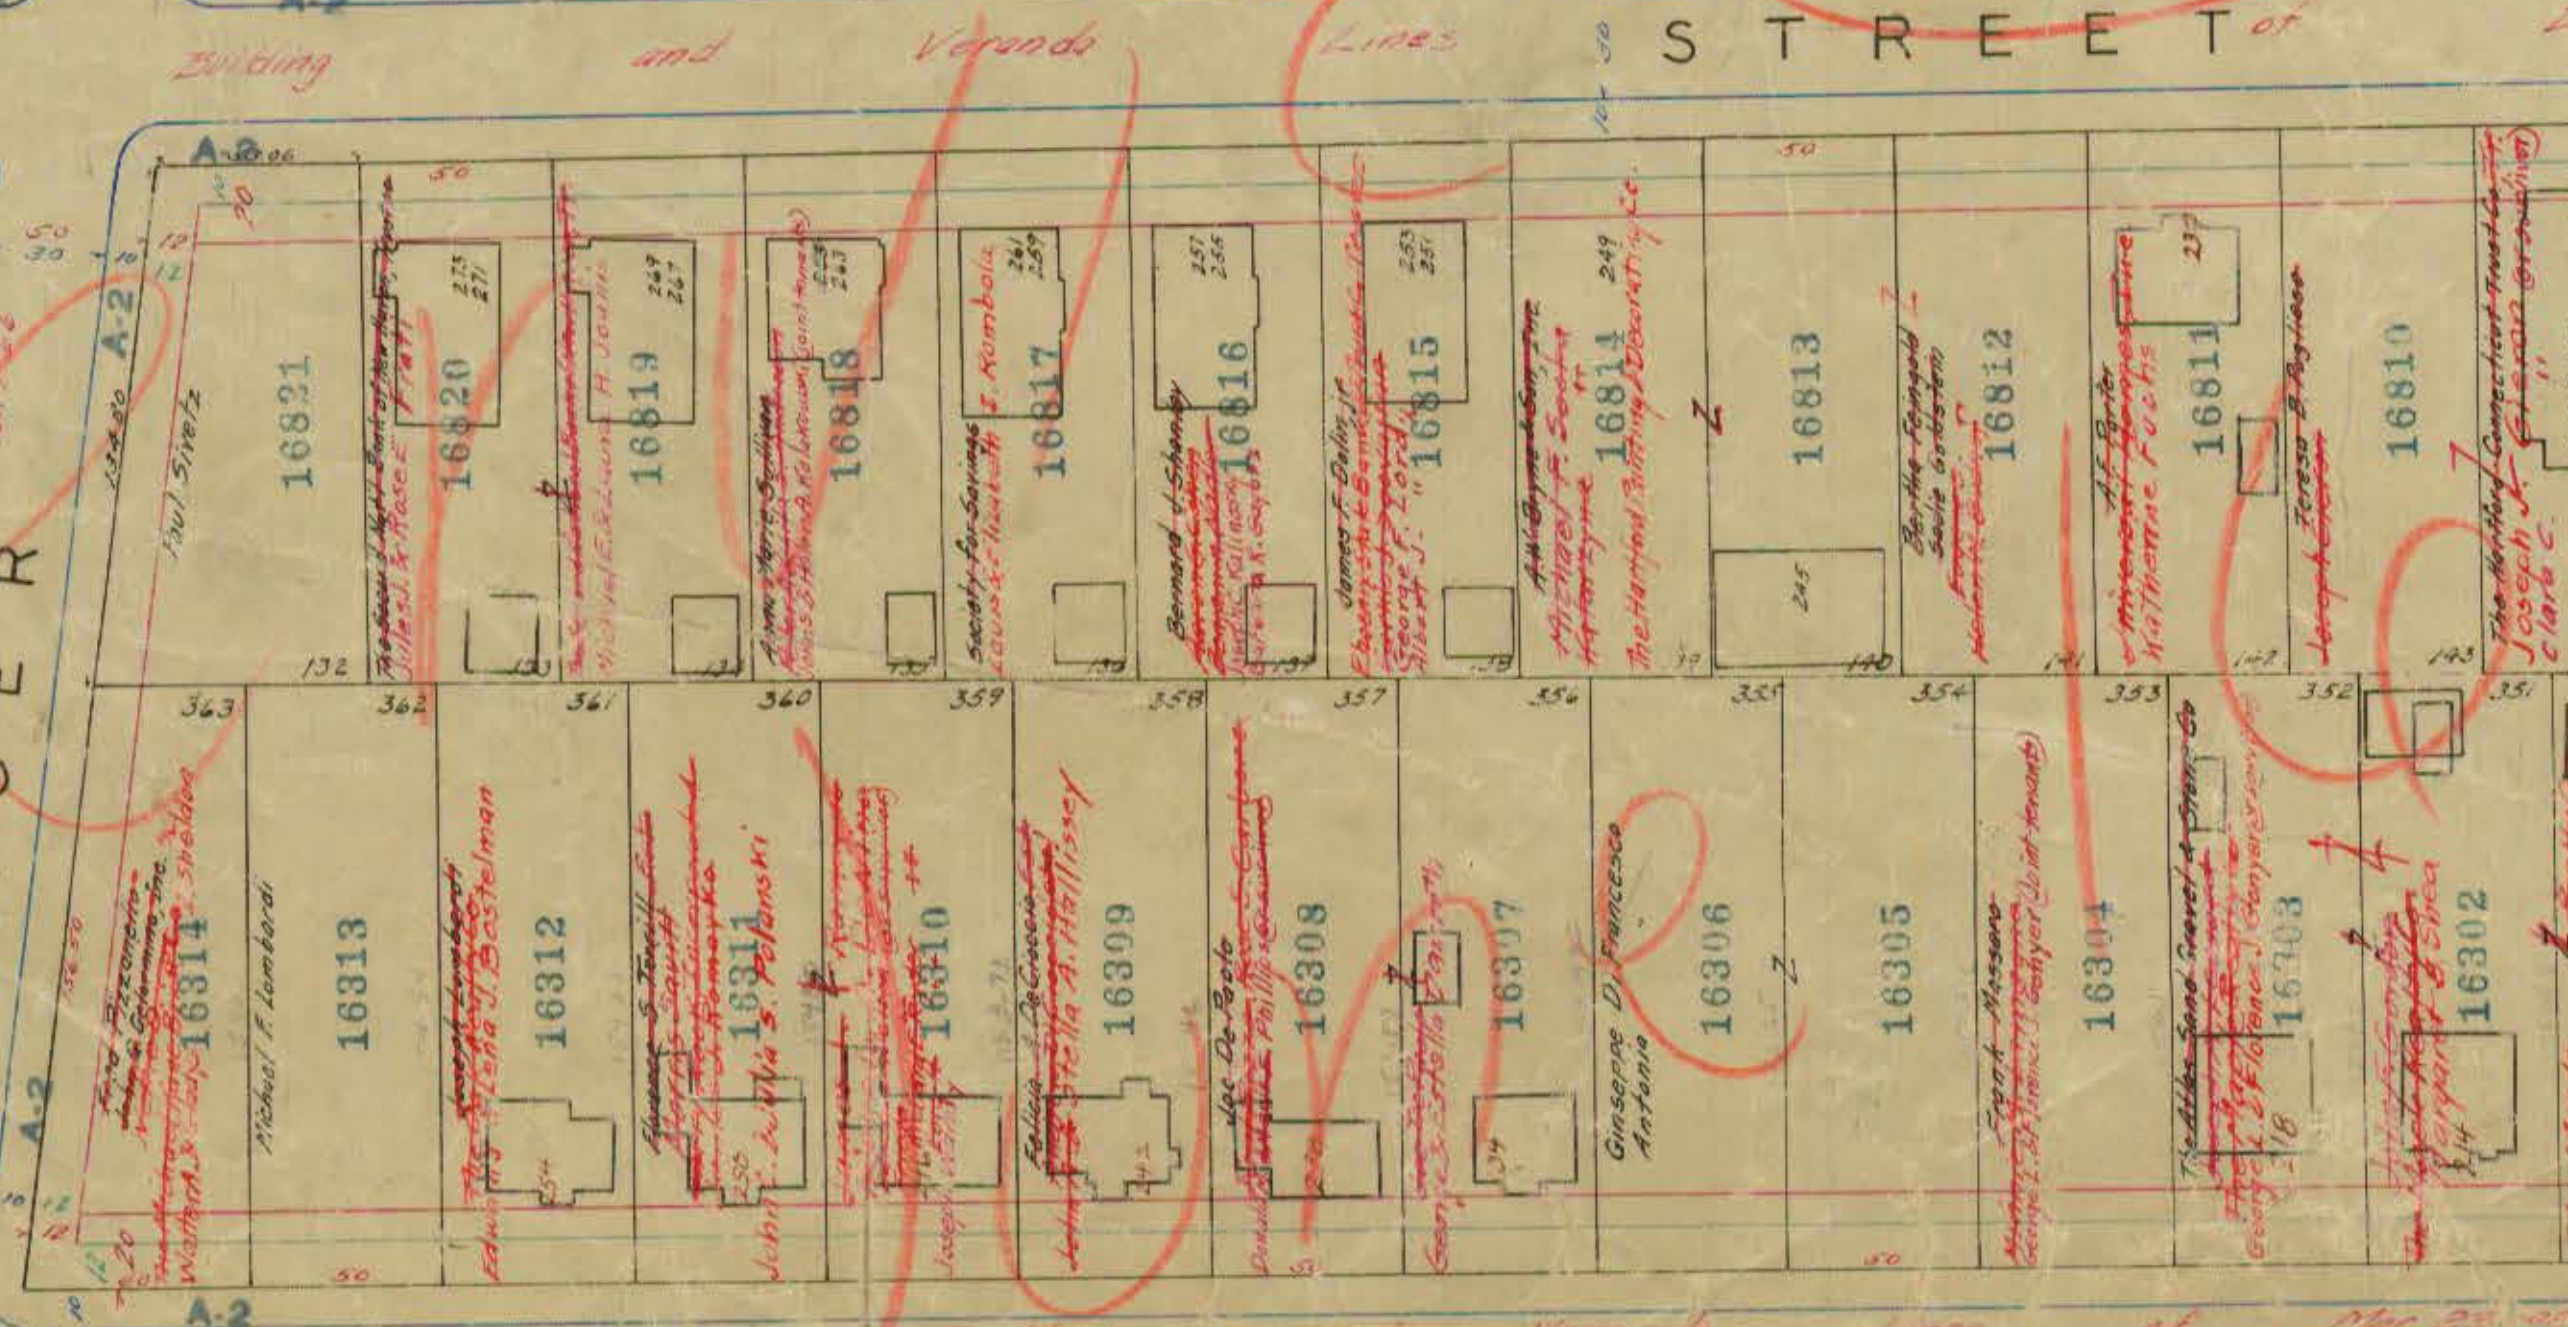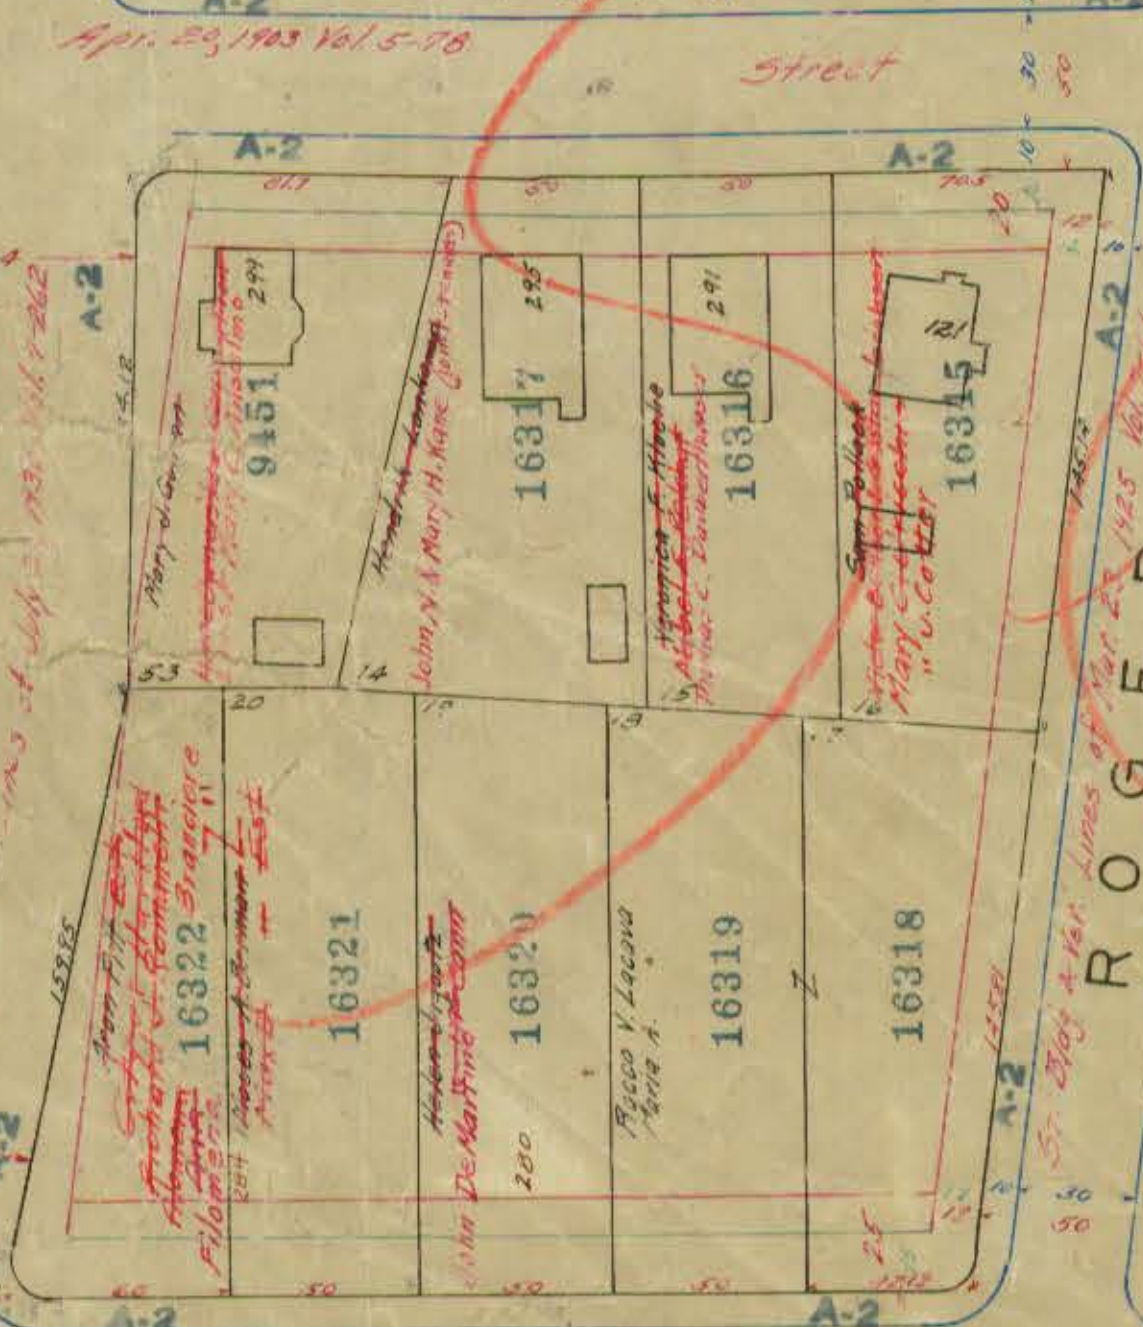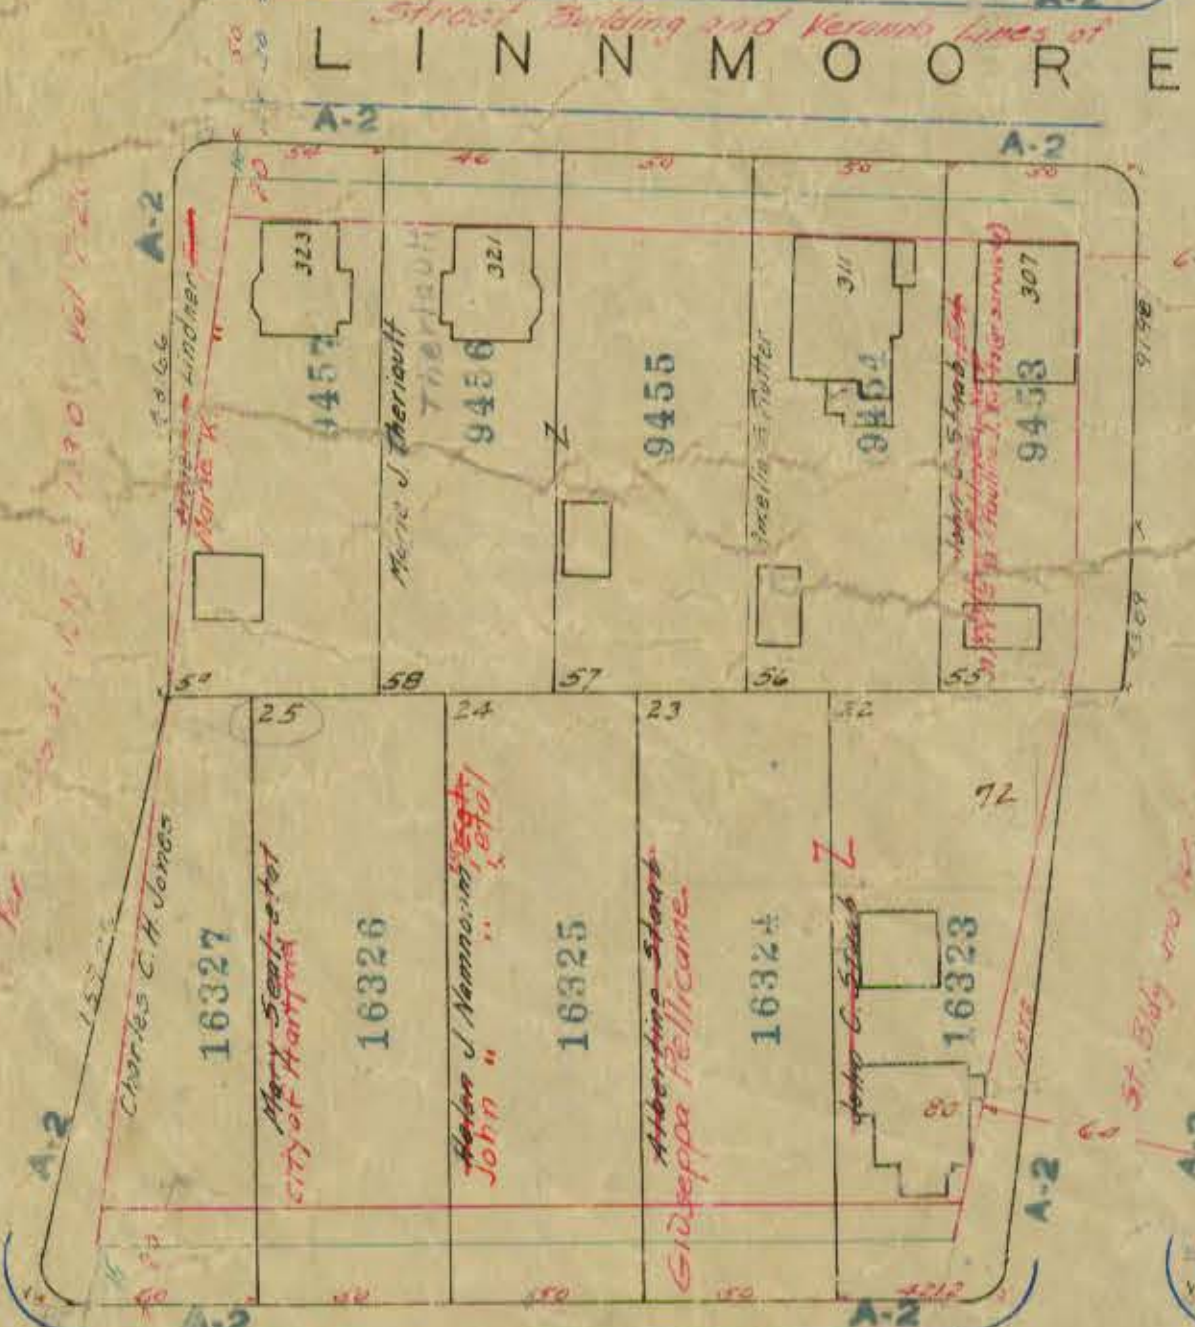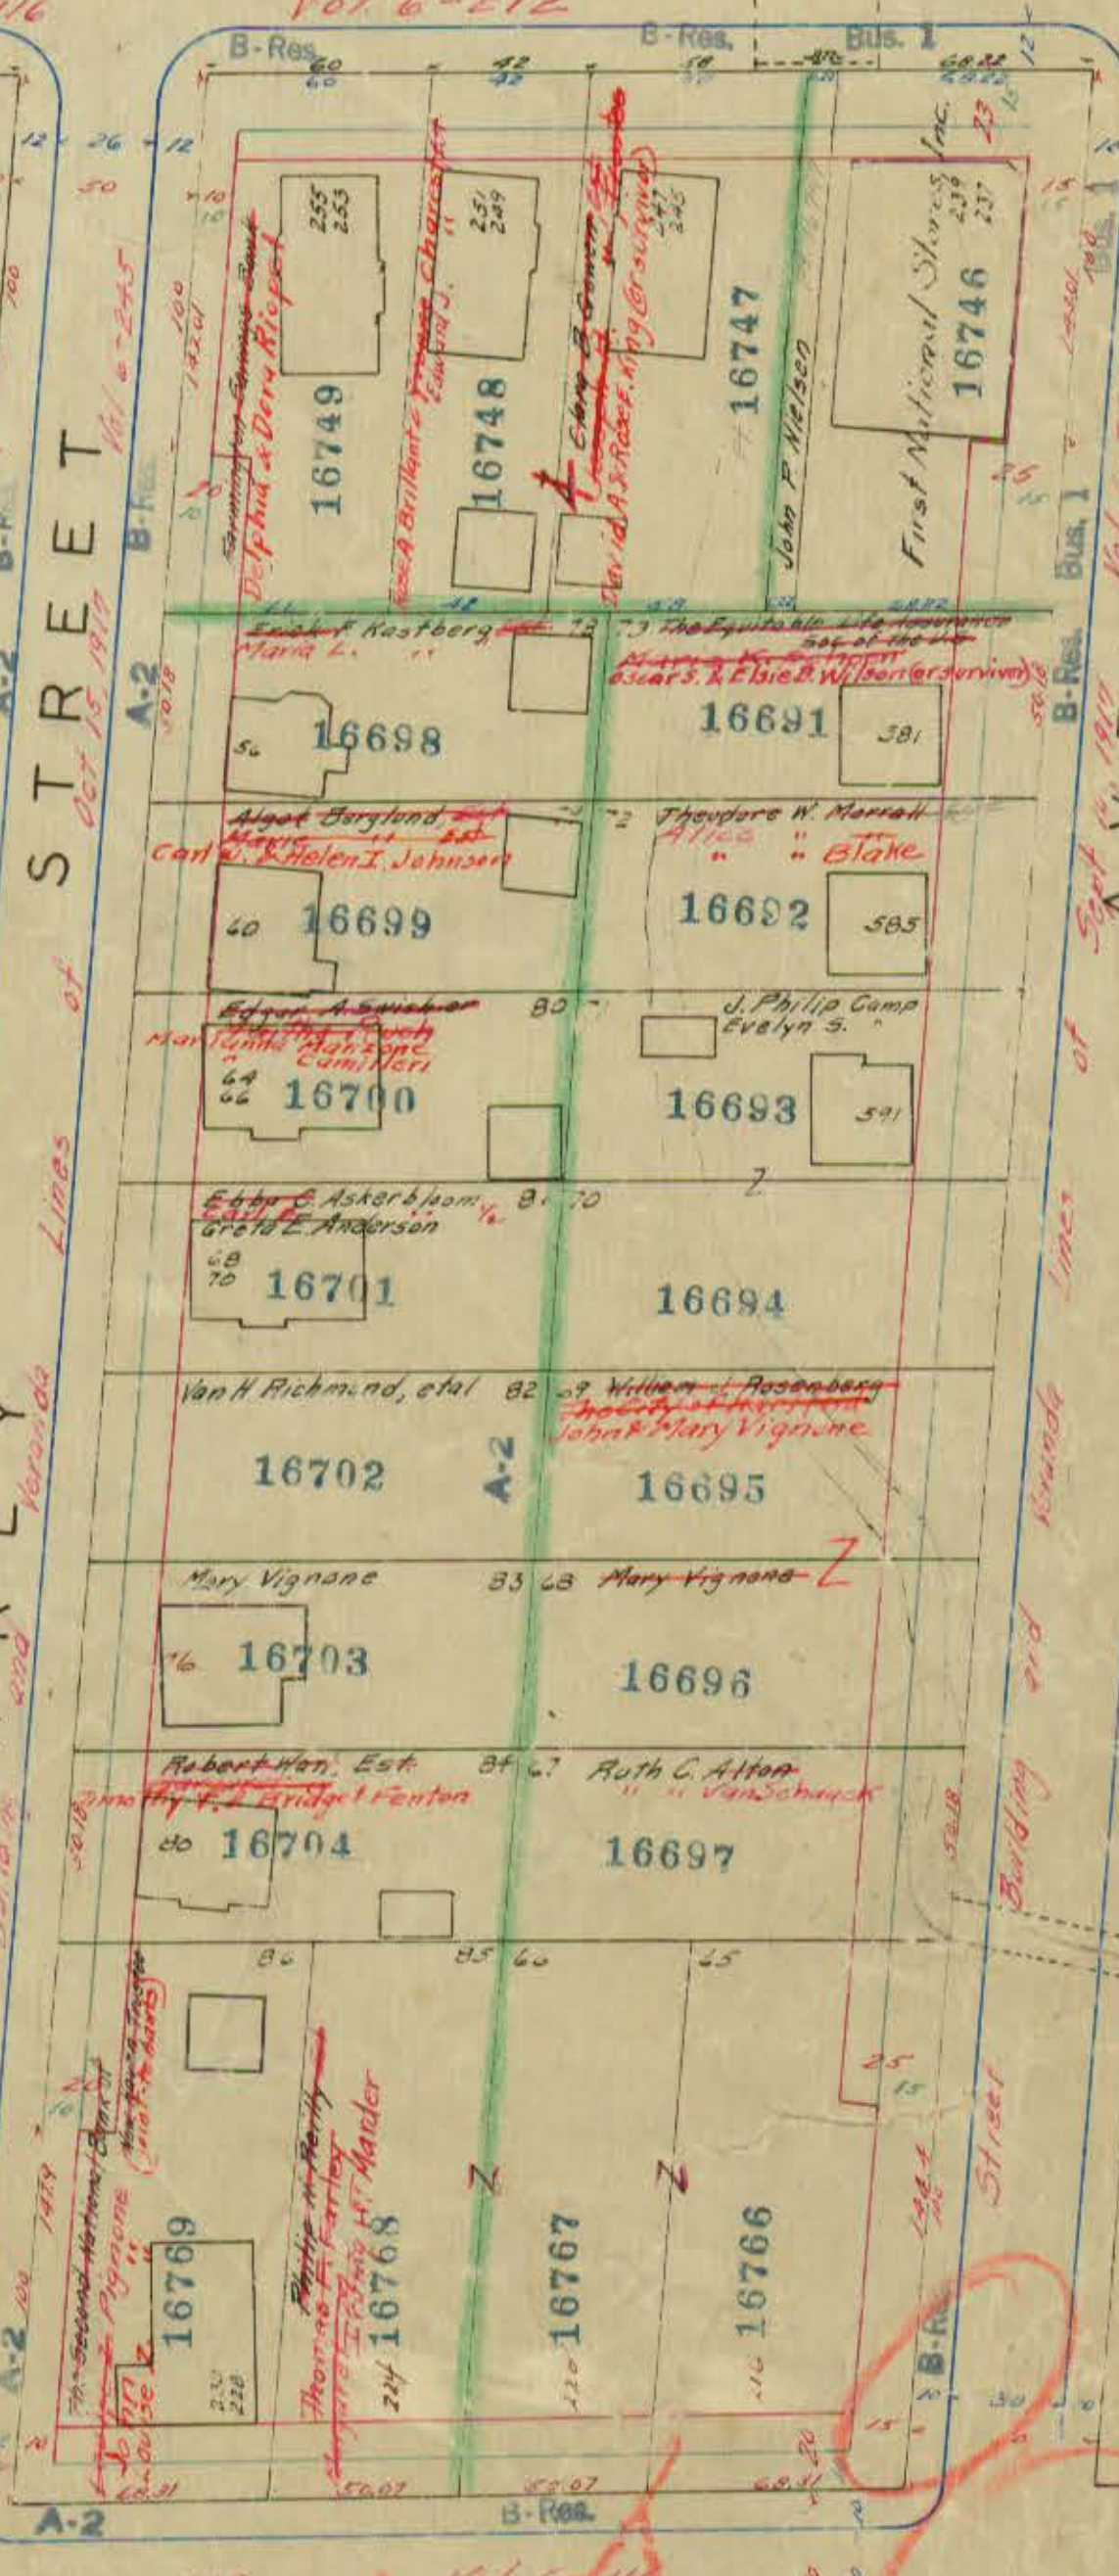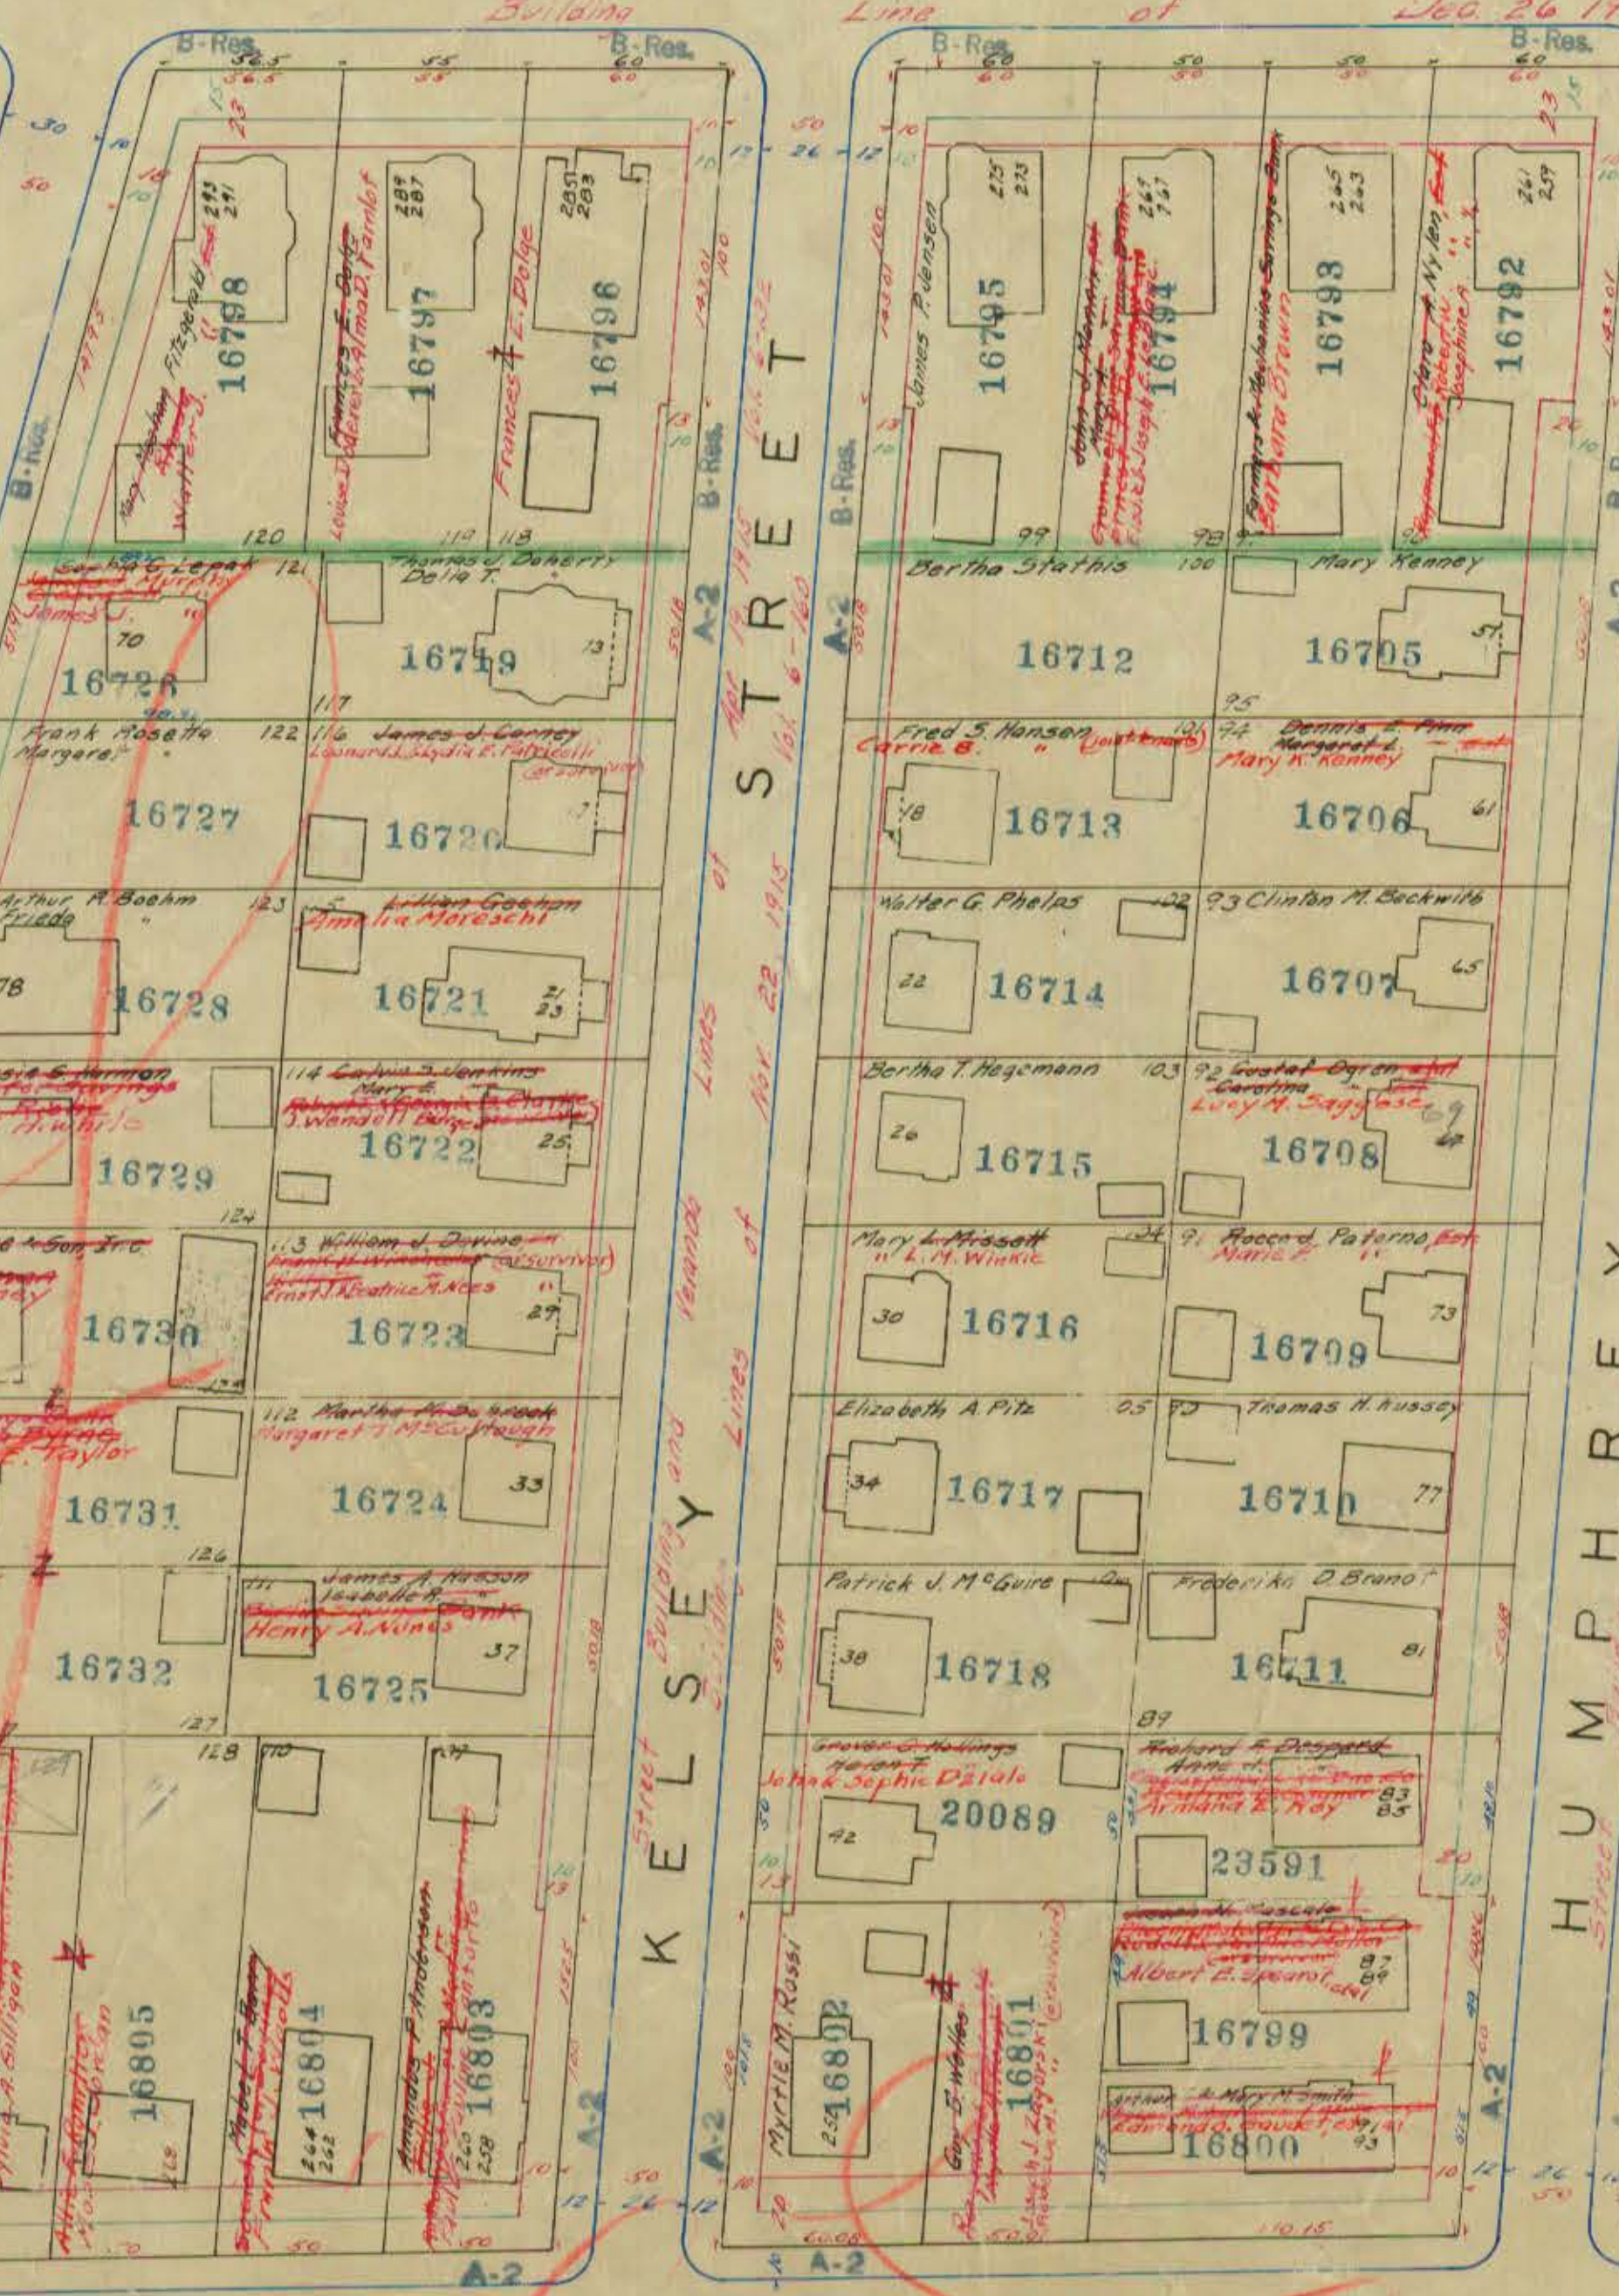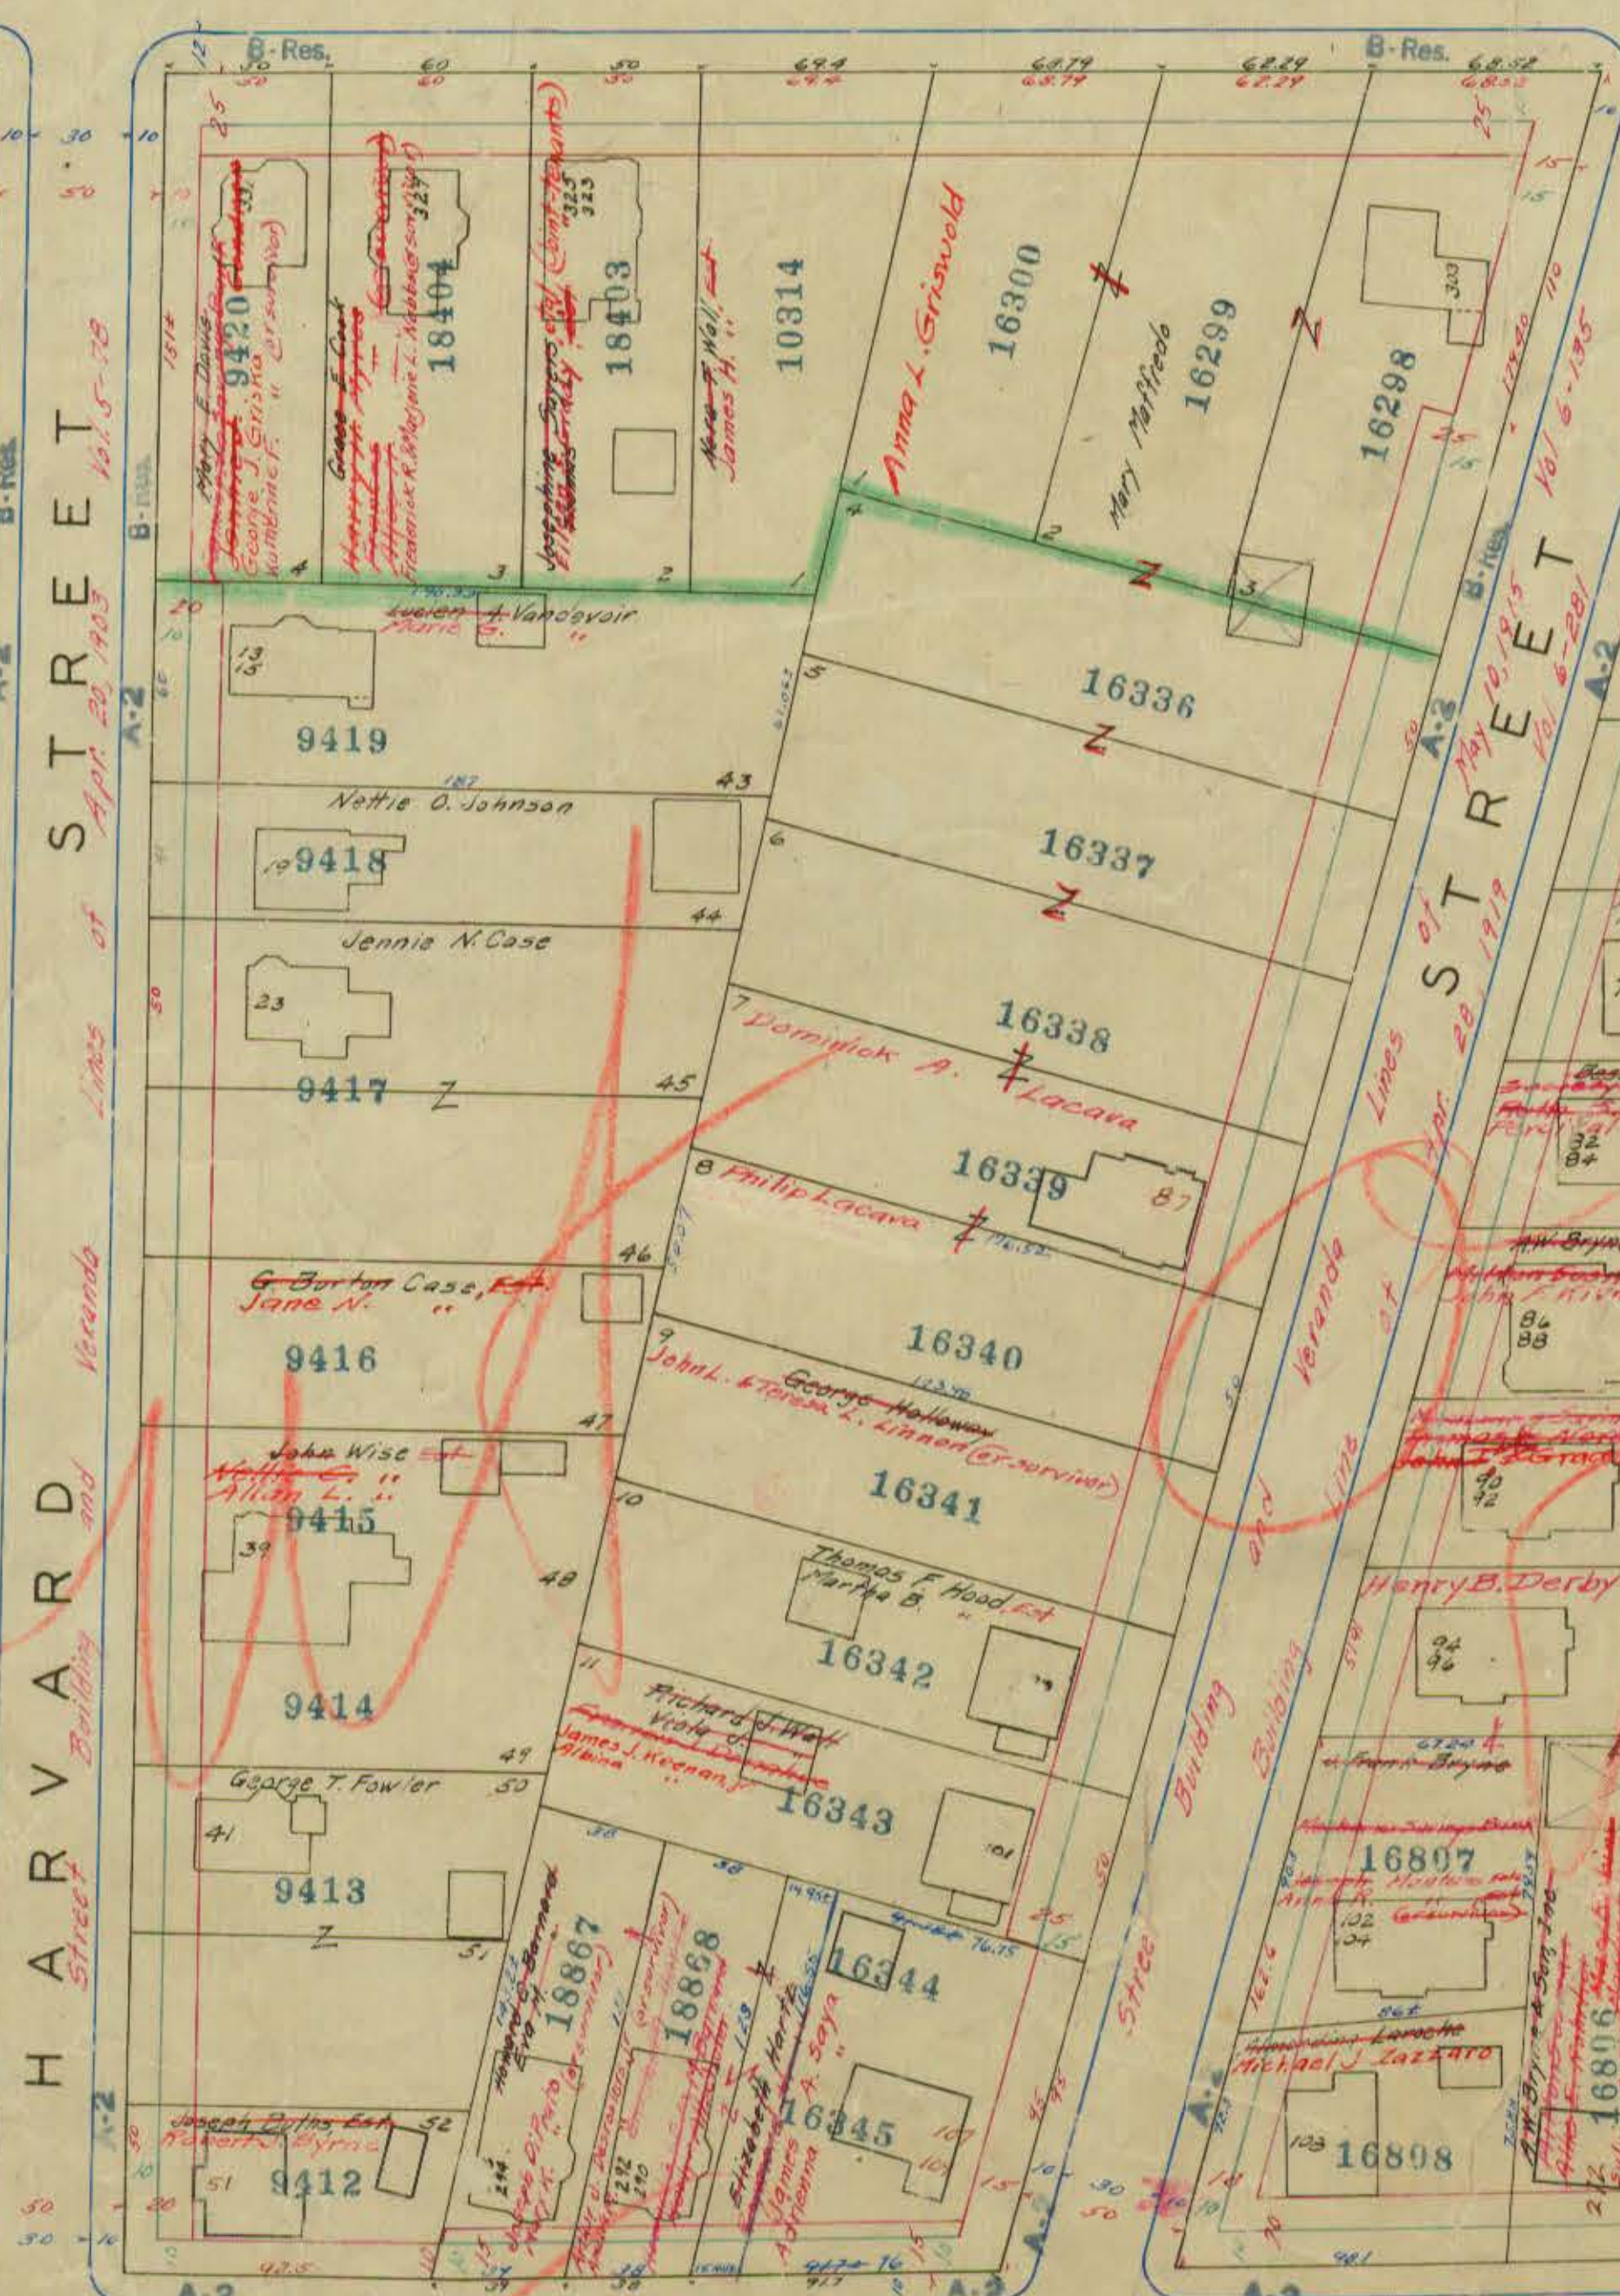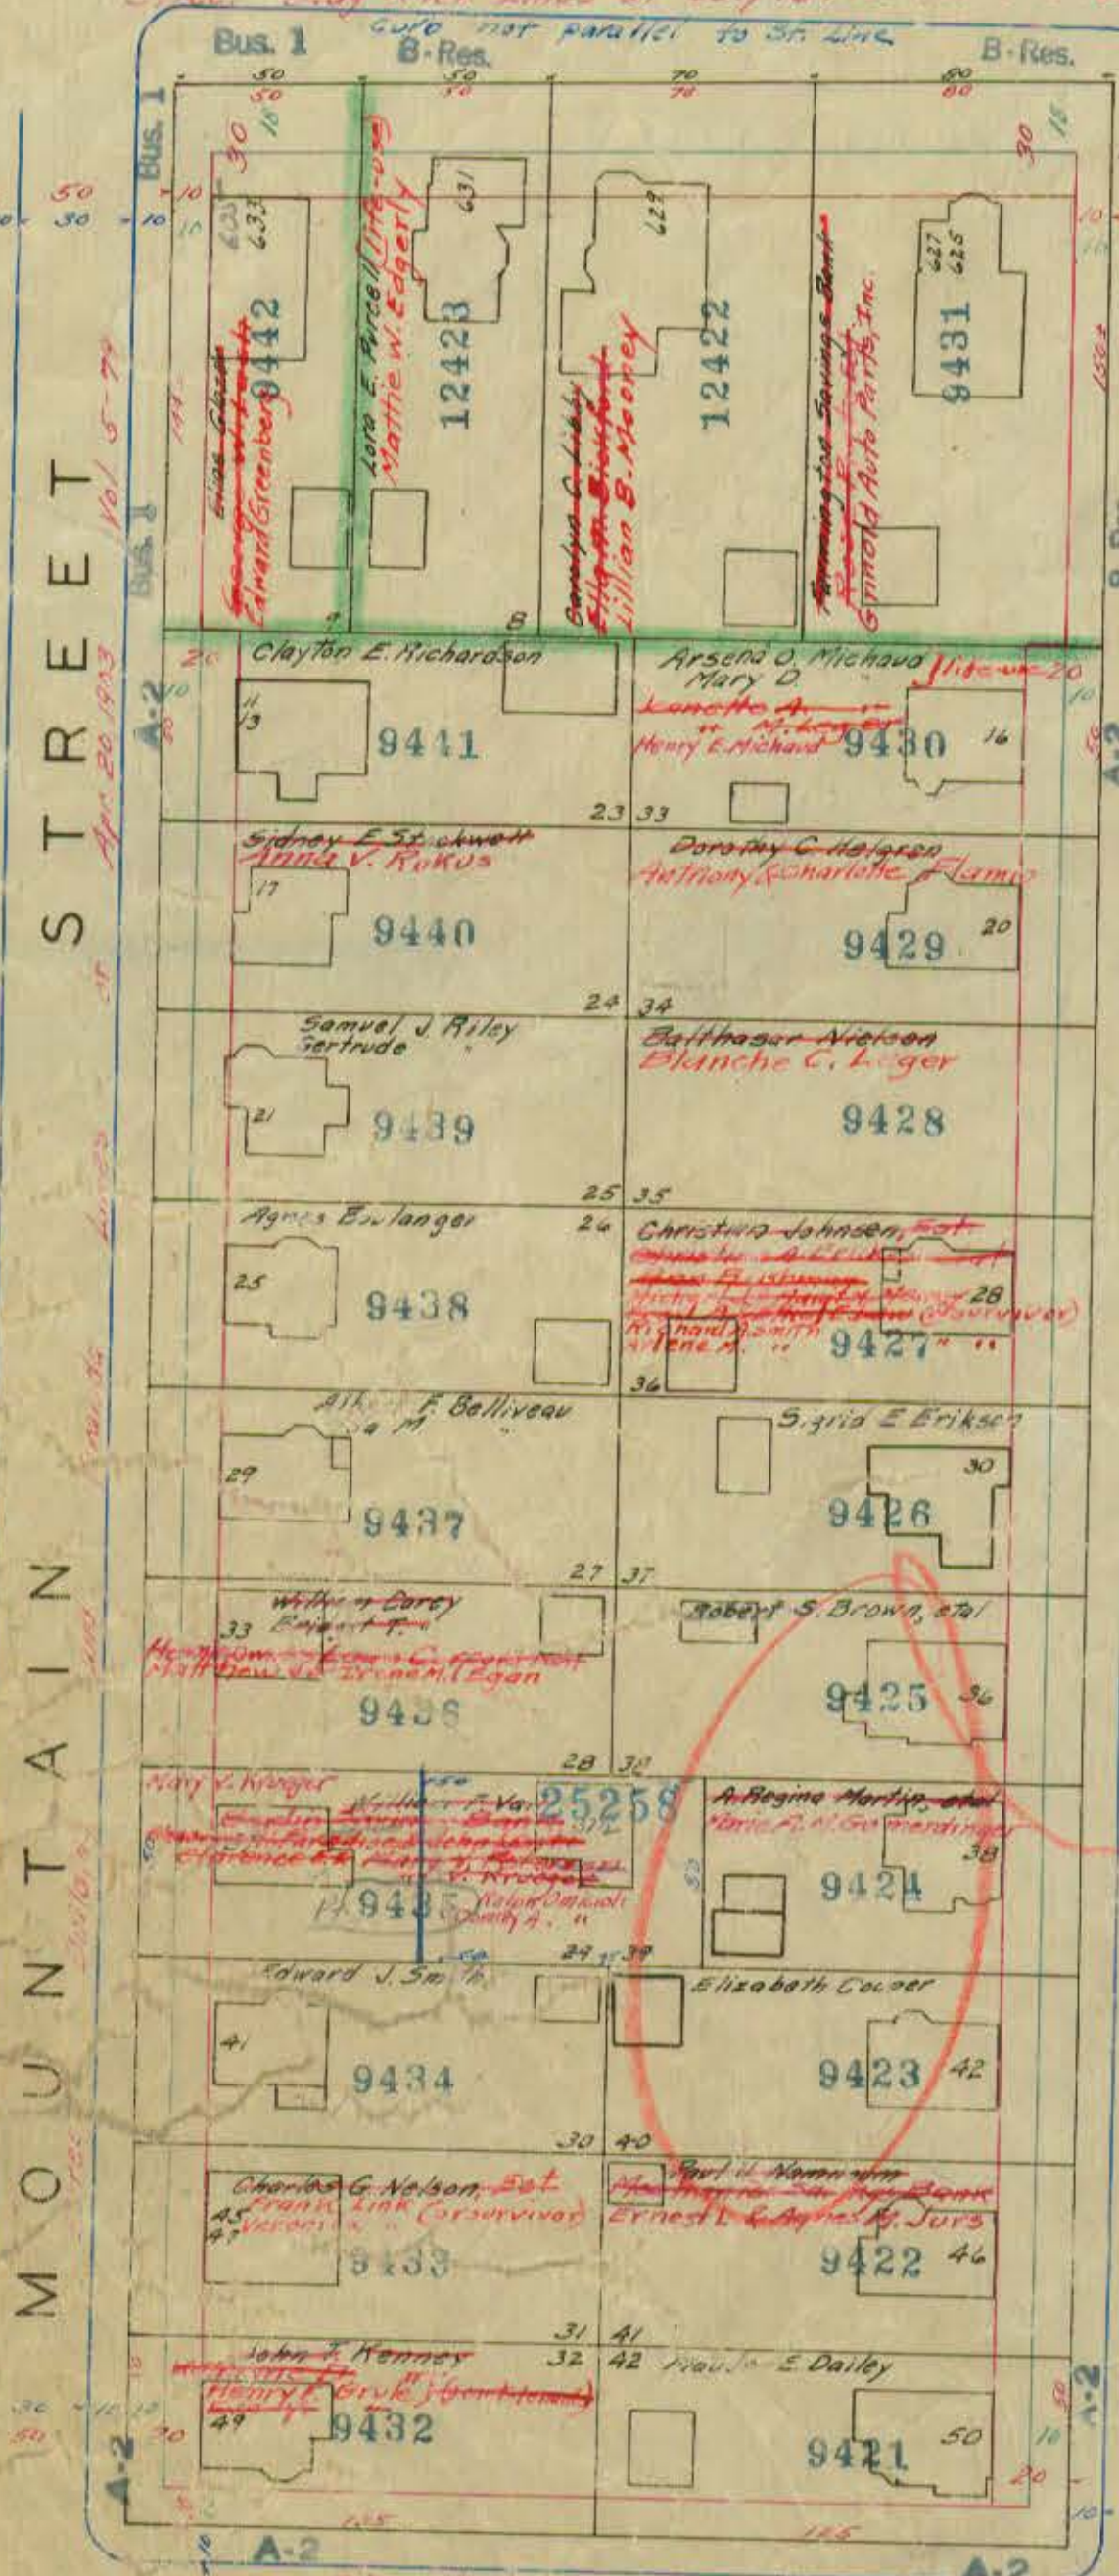

See Sheet

199

See Sheet 199