

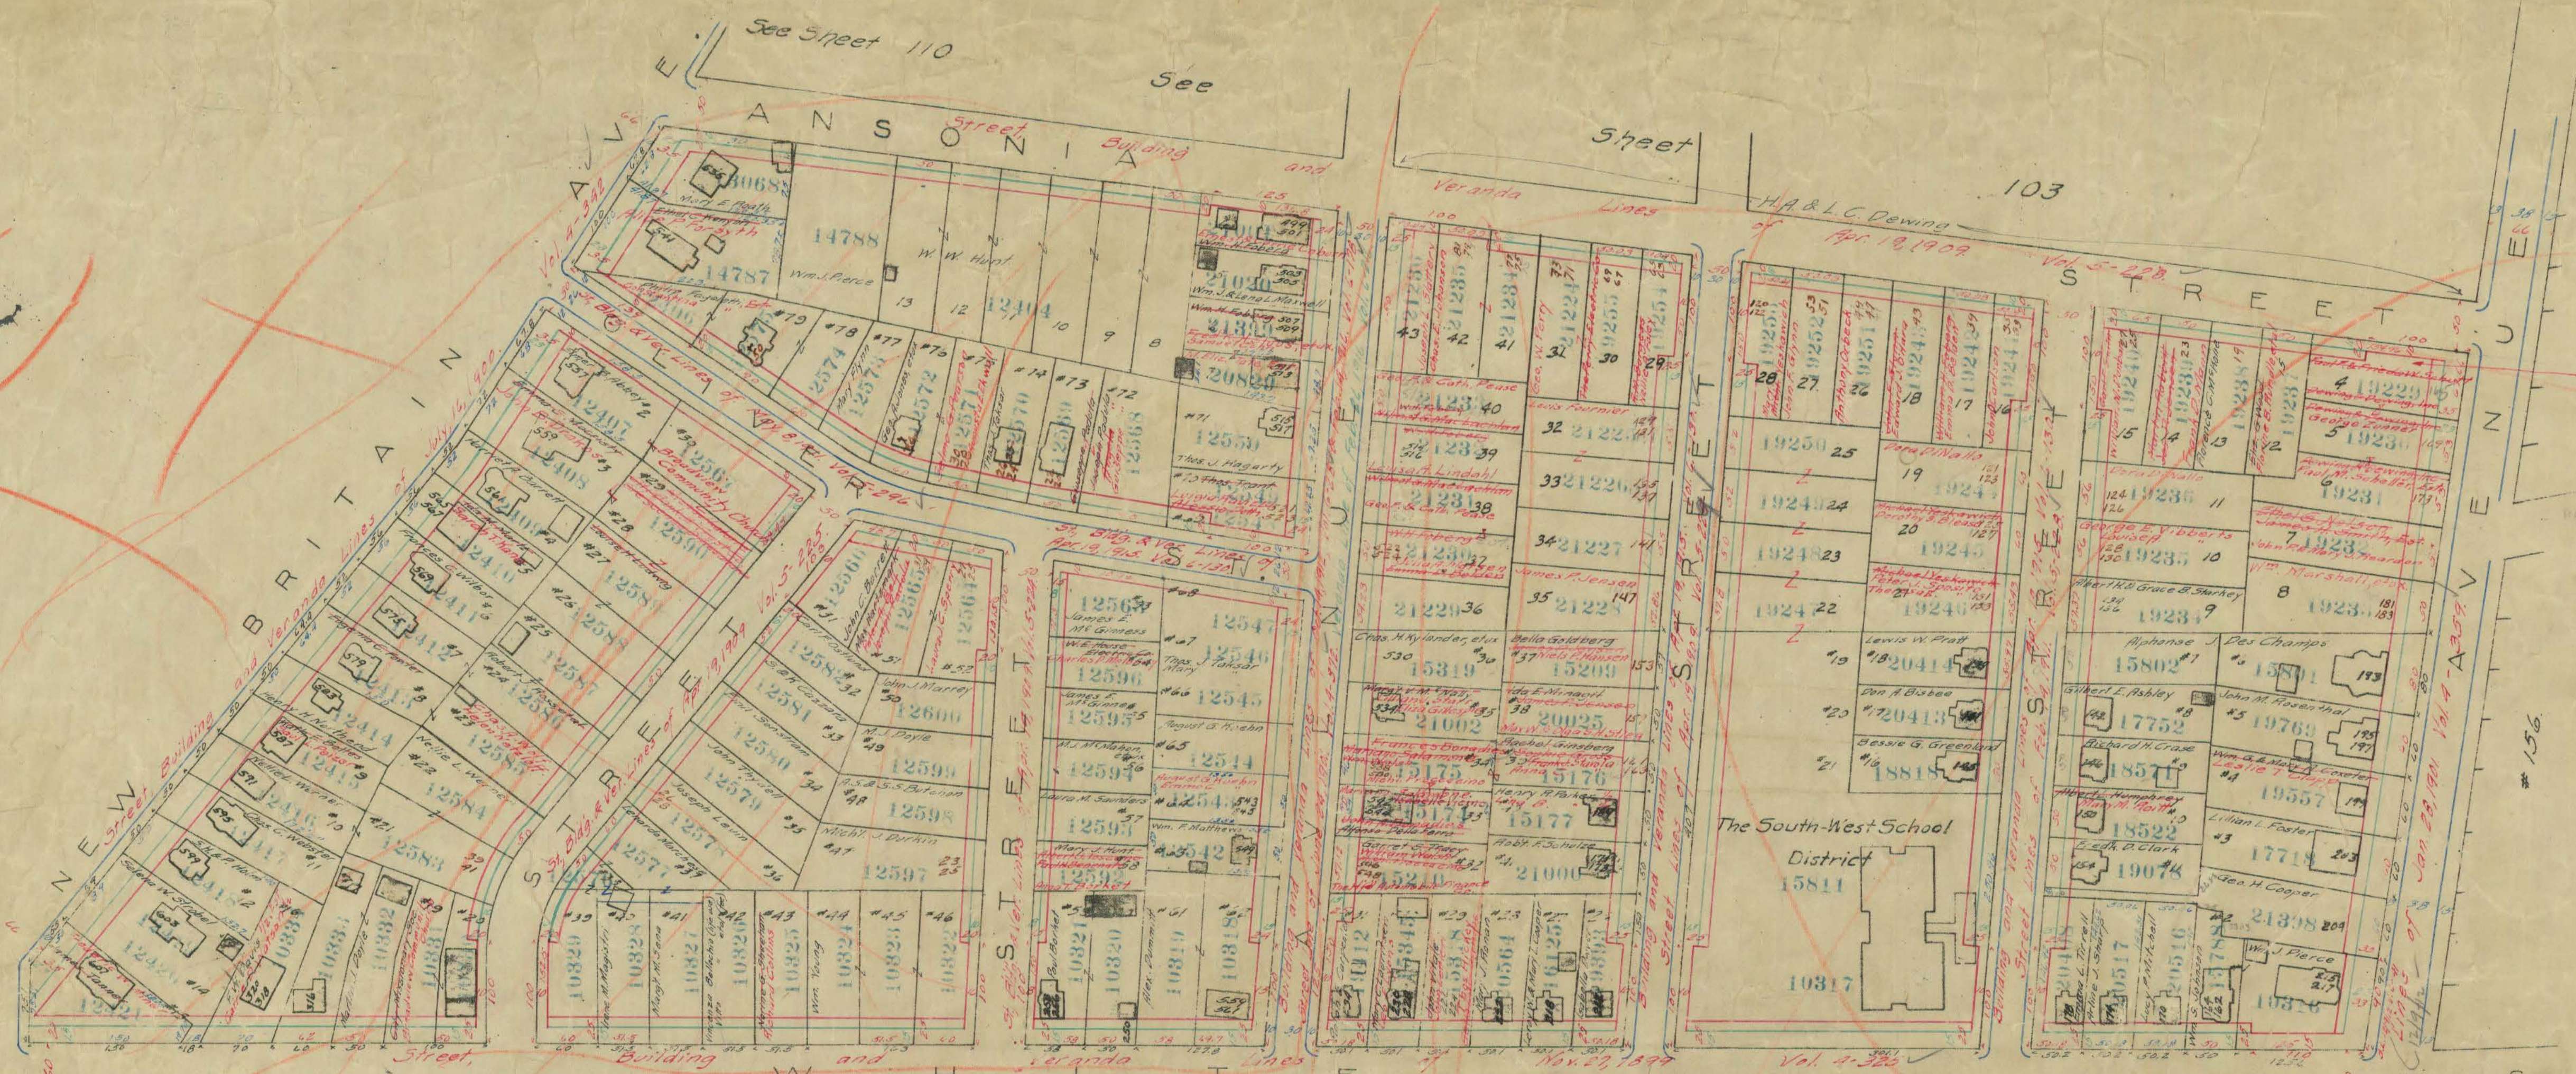


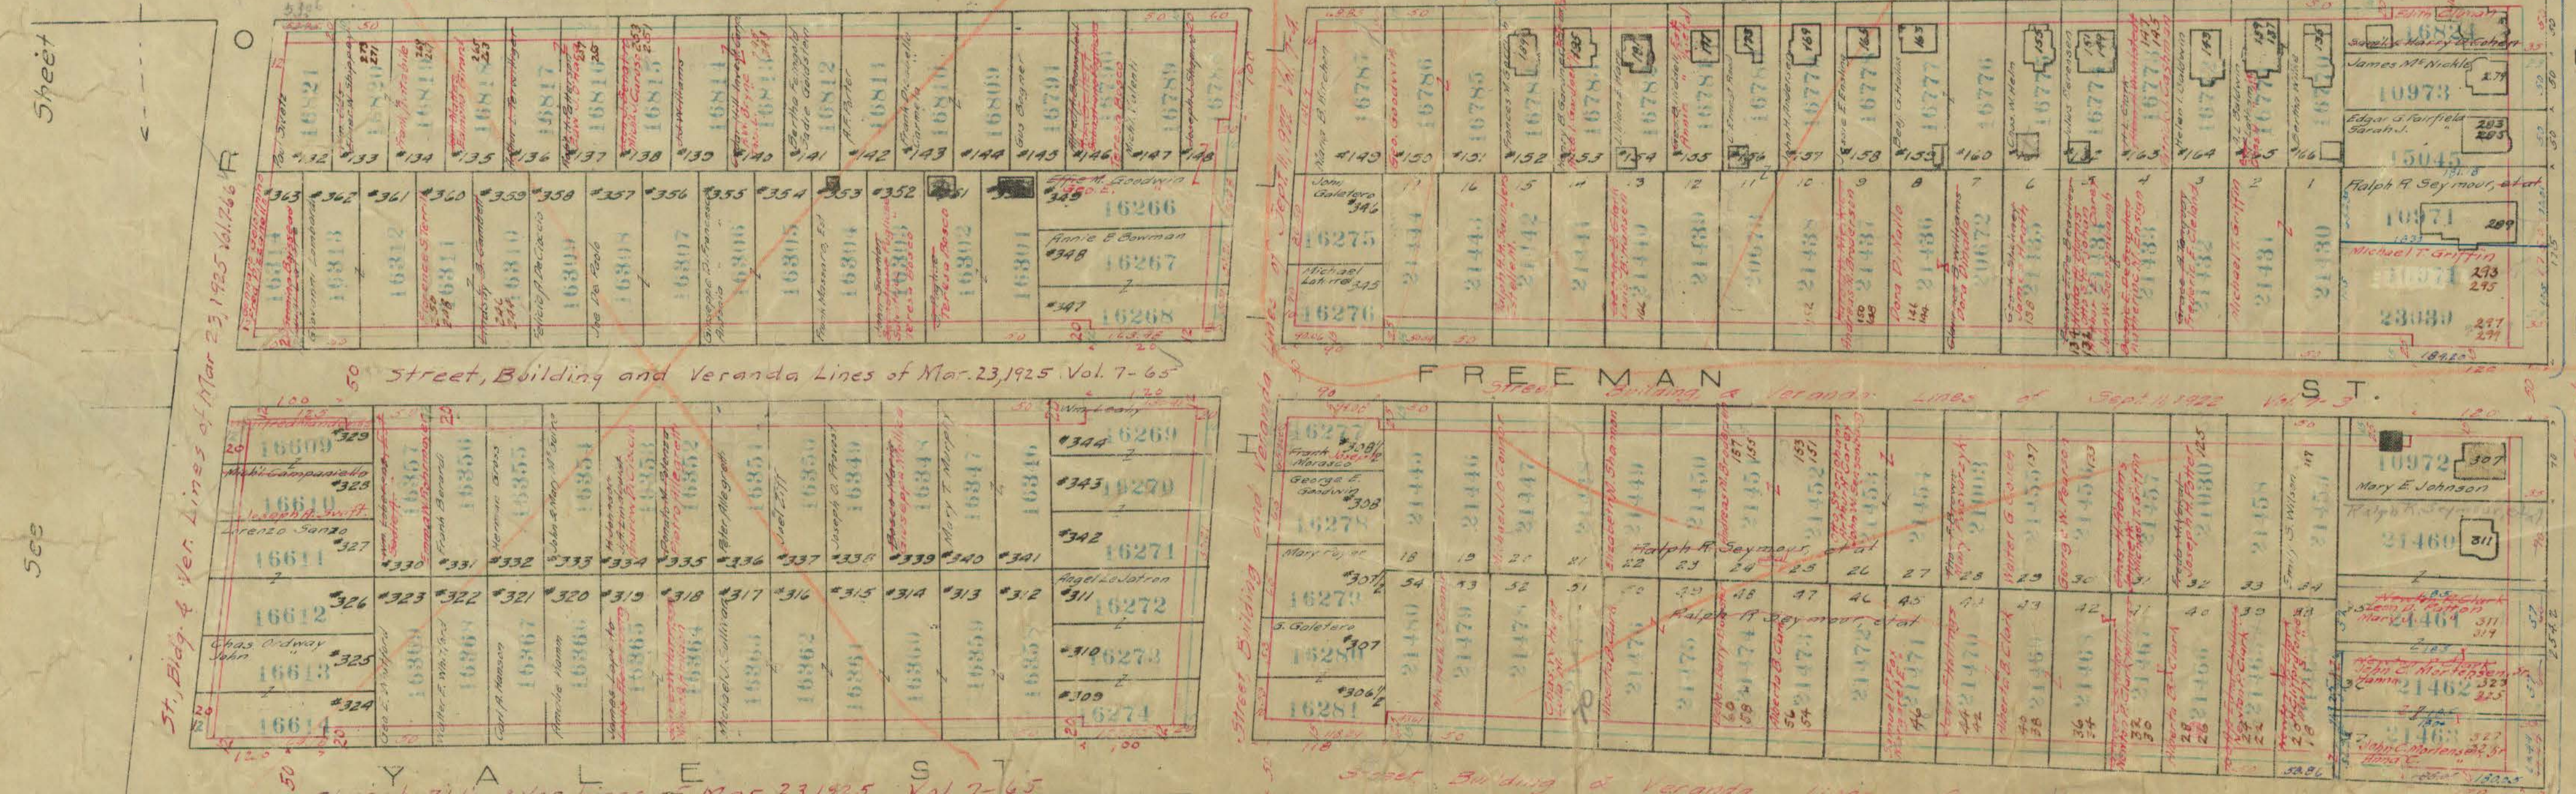

32 Halsey St.
26089 Grover C. Hallings
Helen T.

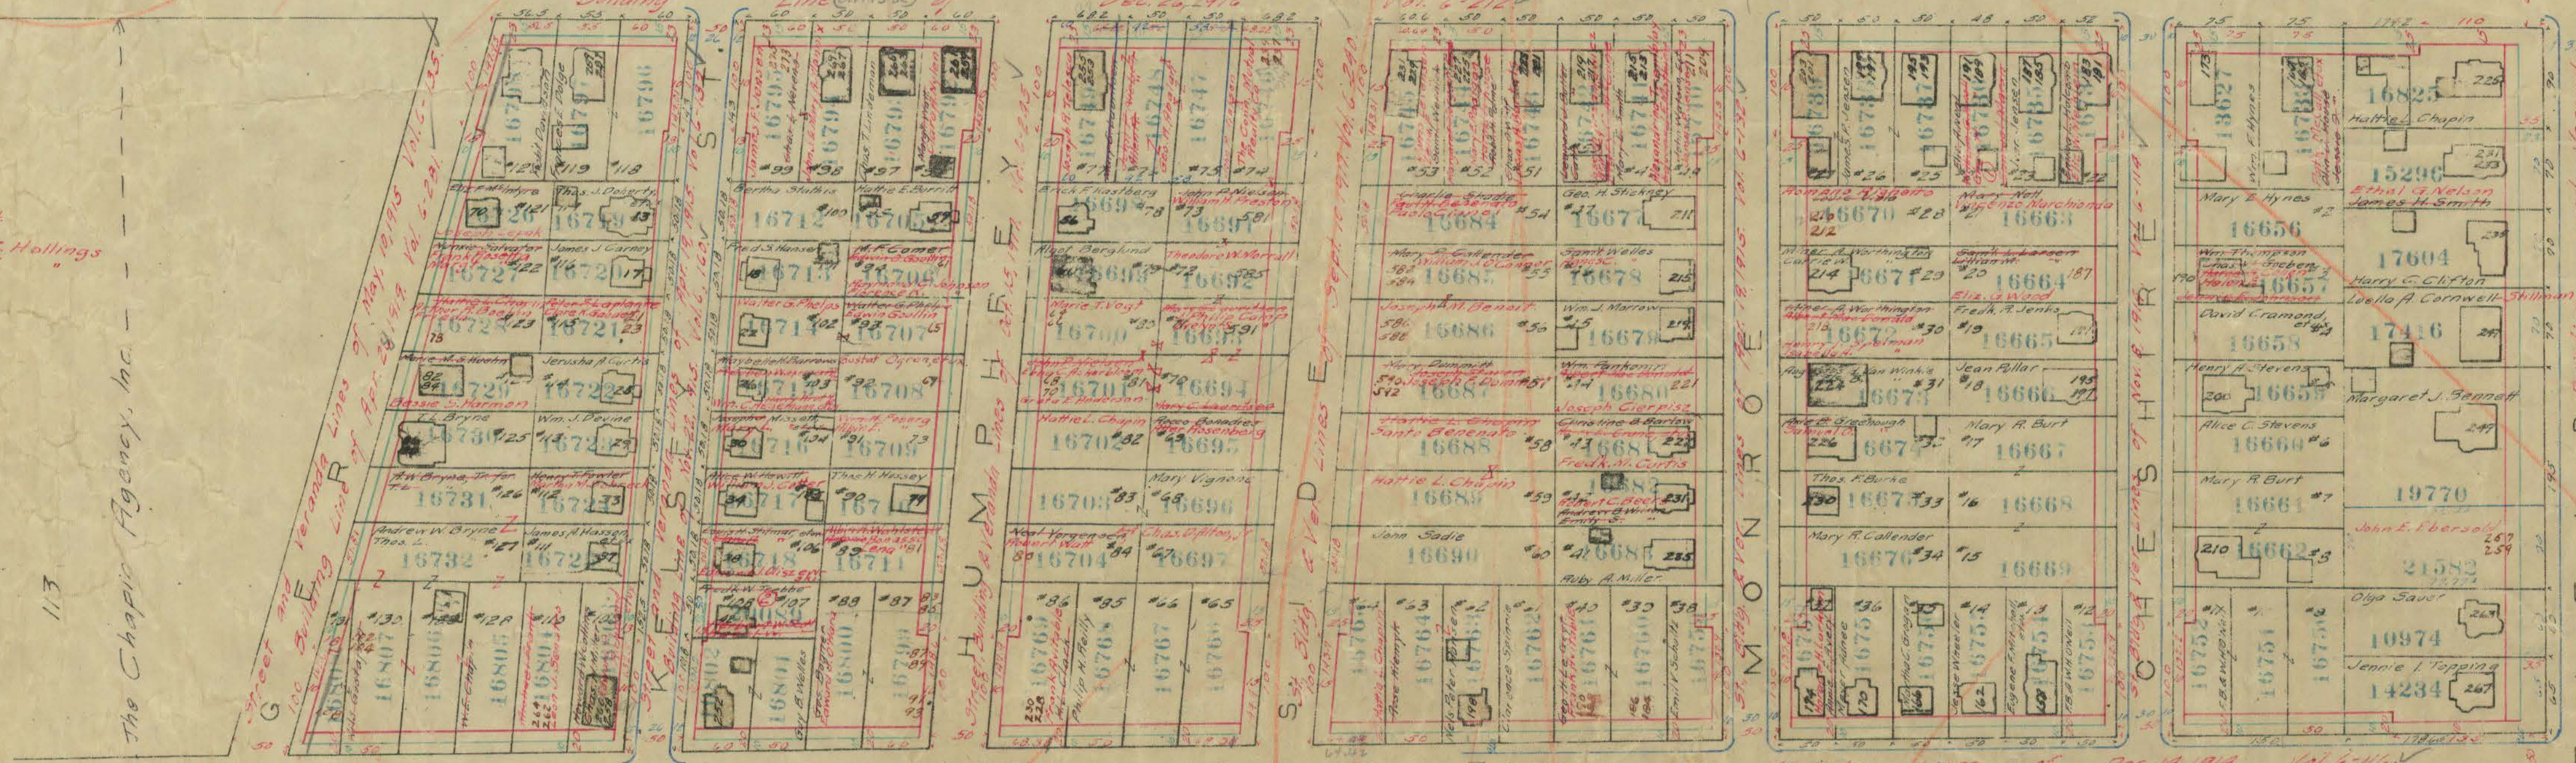

Charles F. Graham
Gertrude

See Sheet #134

See

Sheet

#136

See

Sheet

113

See

Sheet

115