


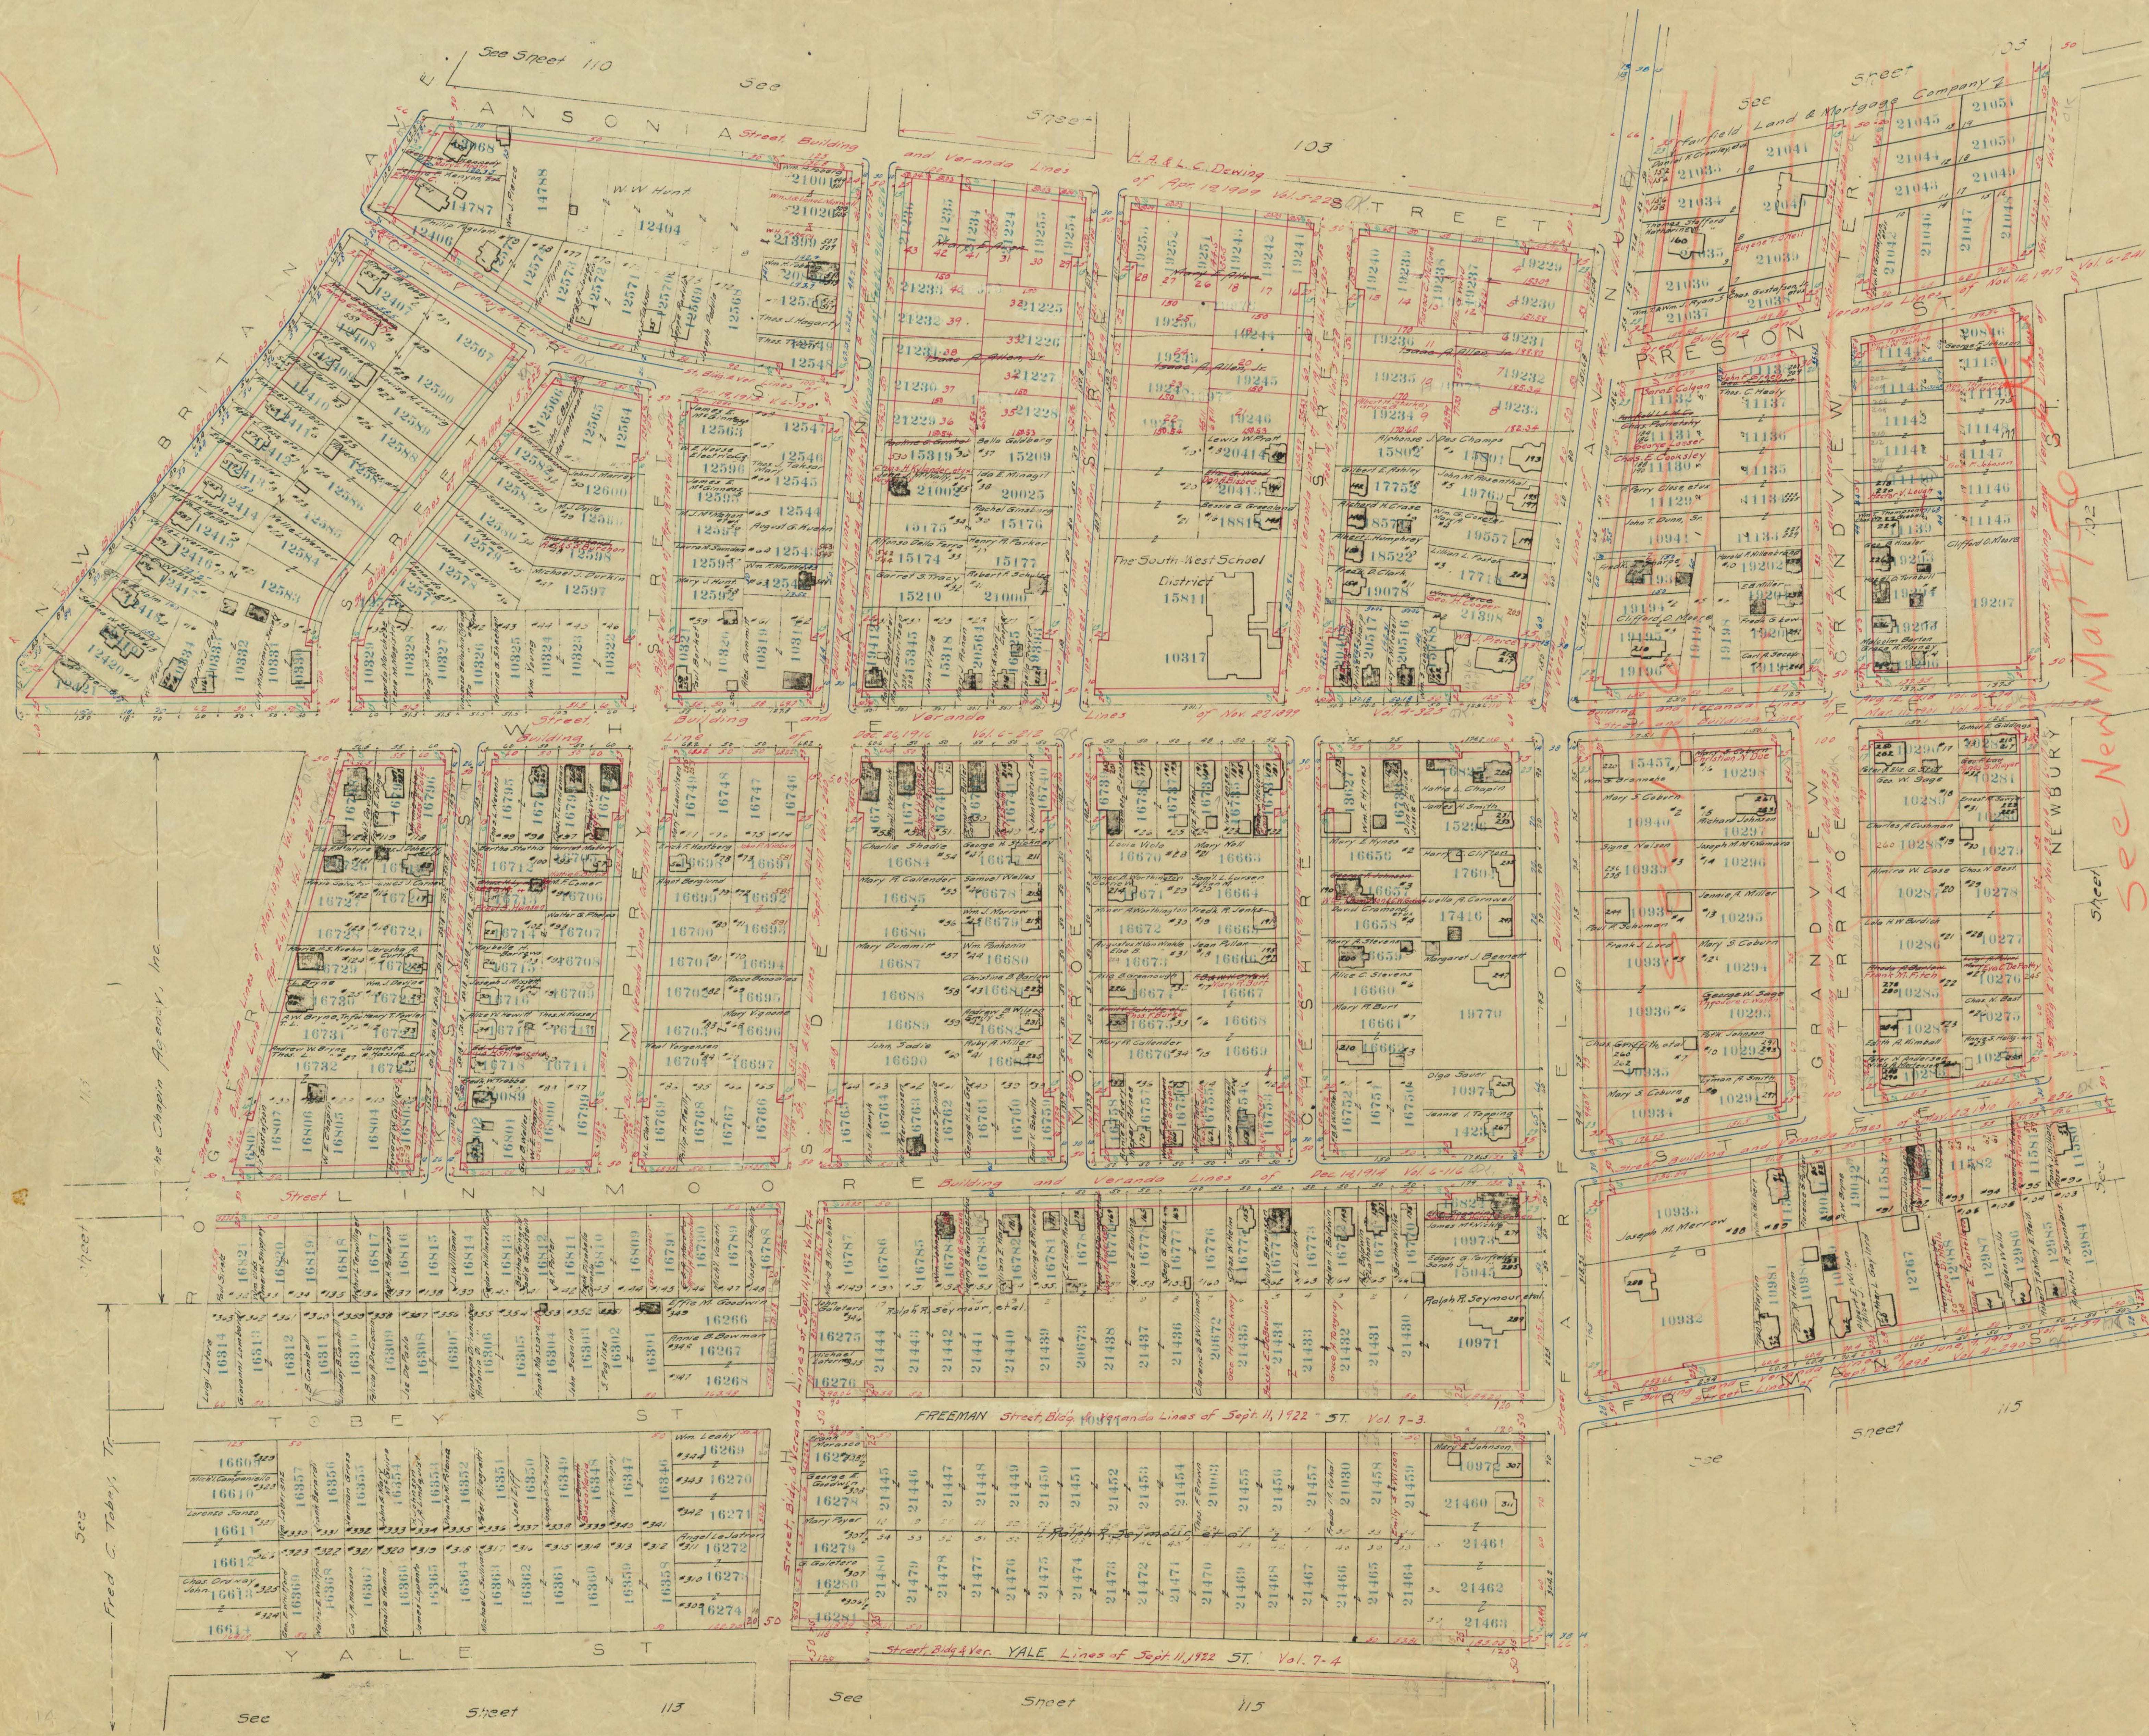

See New Map 110
Sheet

See
Fred C. Tobey, Jr.

See

Sheet

113

See

Sheet

115