



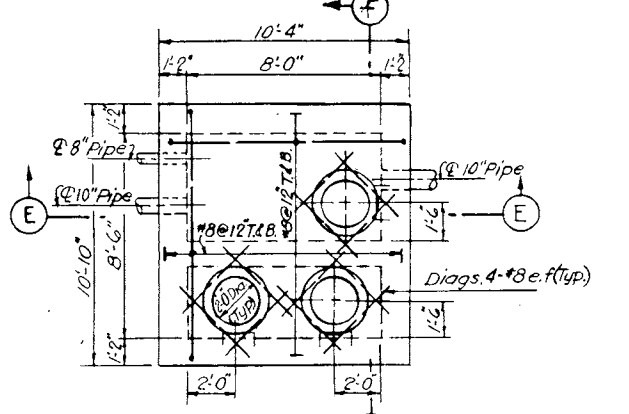


SCALE $\frac{1}{4}" = 1' - 0"$

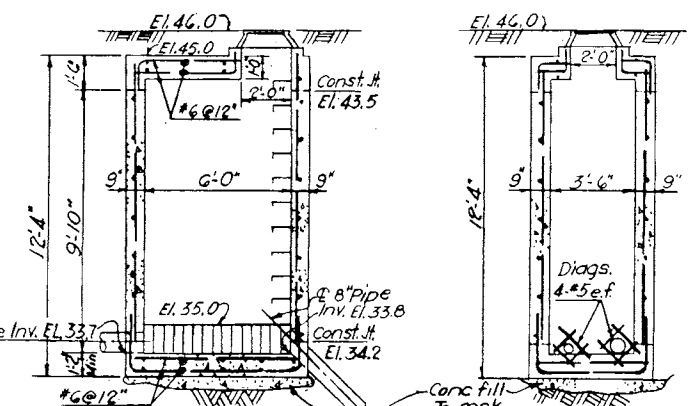


SECTION C-C

△SIPHON STA. 16+65 INLET

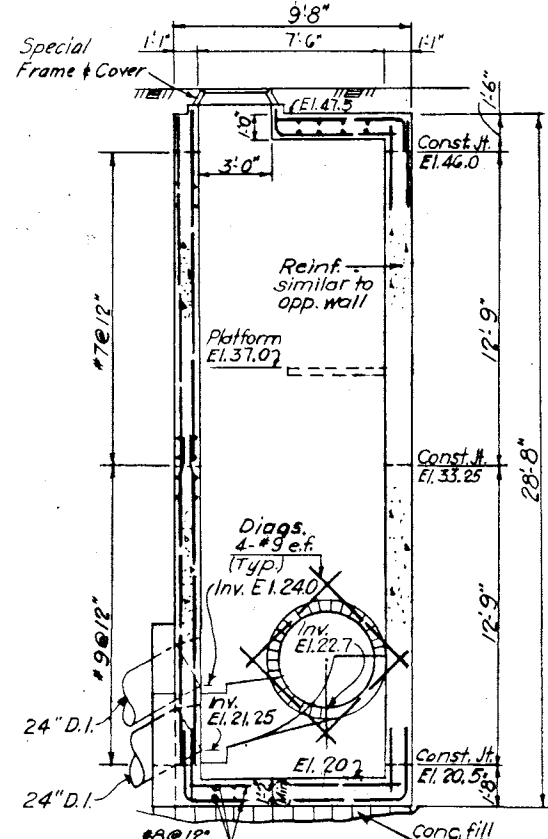


△ SIPHON STA. 9+30 INLET

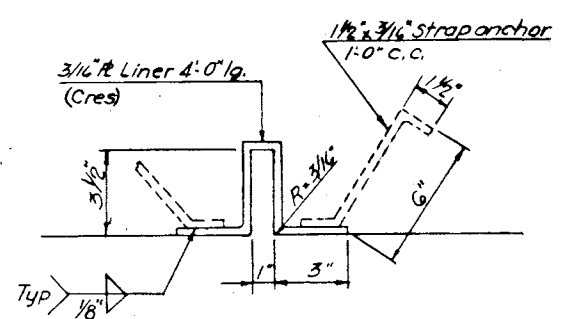




BAFFLE PLATE
N.T.S.

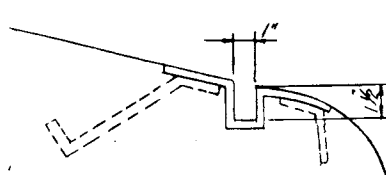

DETAIL "H"
SCALE 3" = 1'-0"

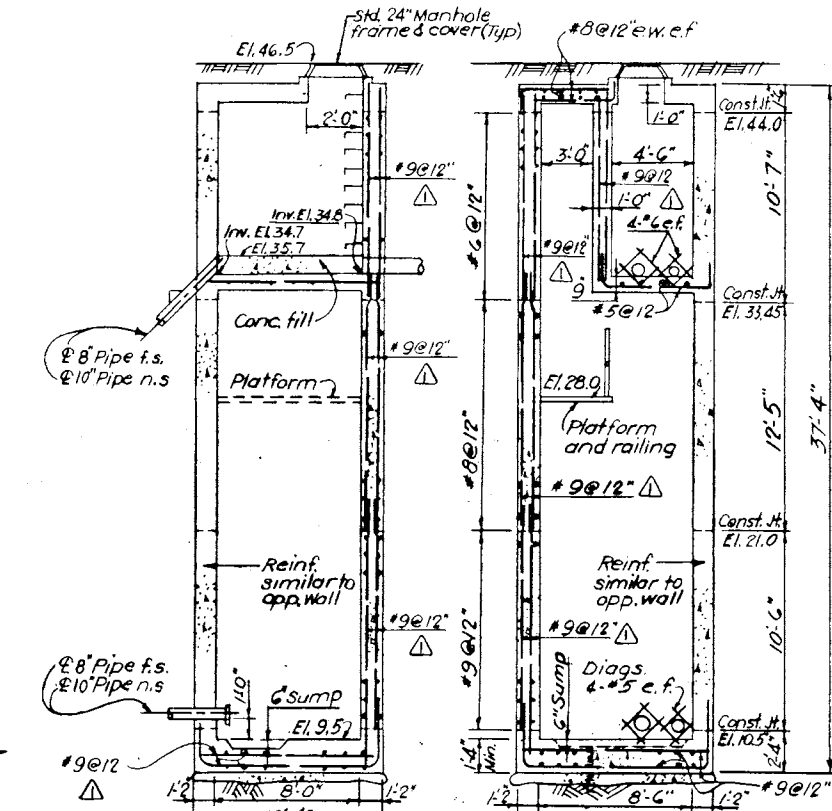

SECTION F-F
SCALE 3/16" = 1'-0"

- NOTES:
1. For 3'0" Opening in roof slab use standard 36" M.H. Frame & cover.
 2. For 2'0" Opening in roof slab use standard 24" M.H. Frame & Cover.
 3. All baffle & dimensions to be verified by field measurements prior to fabrication.
 4. For notes and ladder rung details see Sh. 123.

As First Drawing

Control No. 33 76C 0098

[illegible]