



See Sheet 106

See Sheet 107

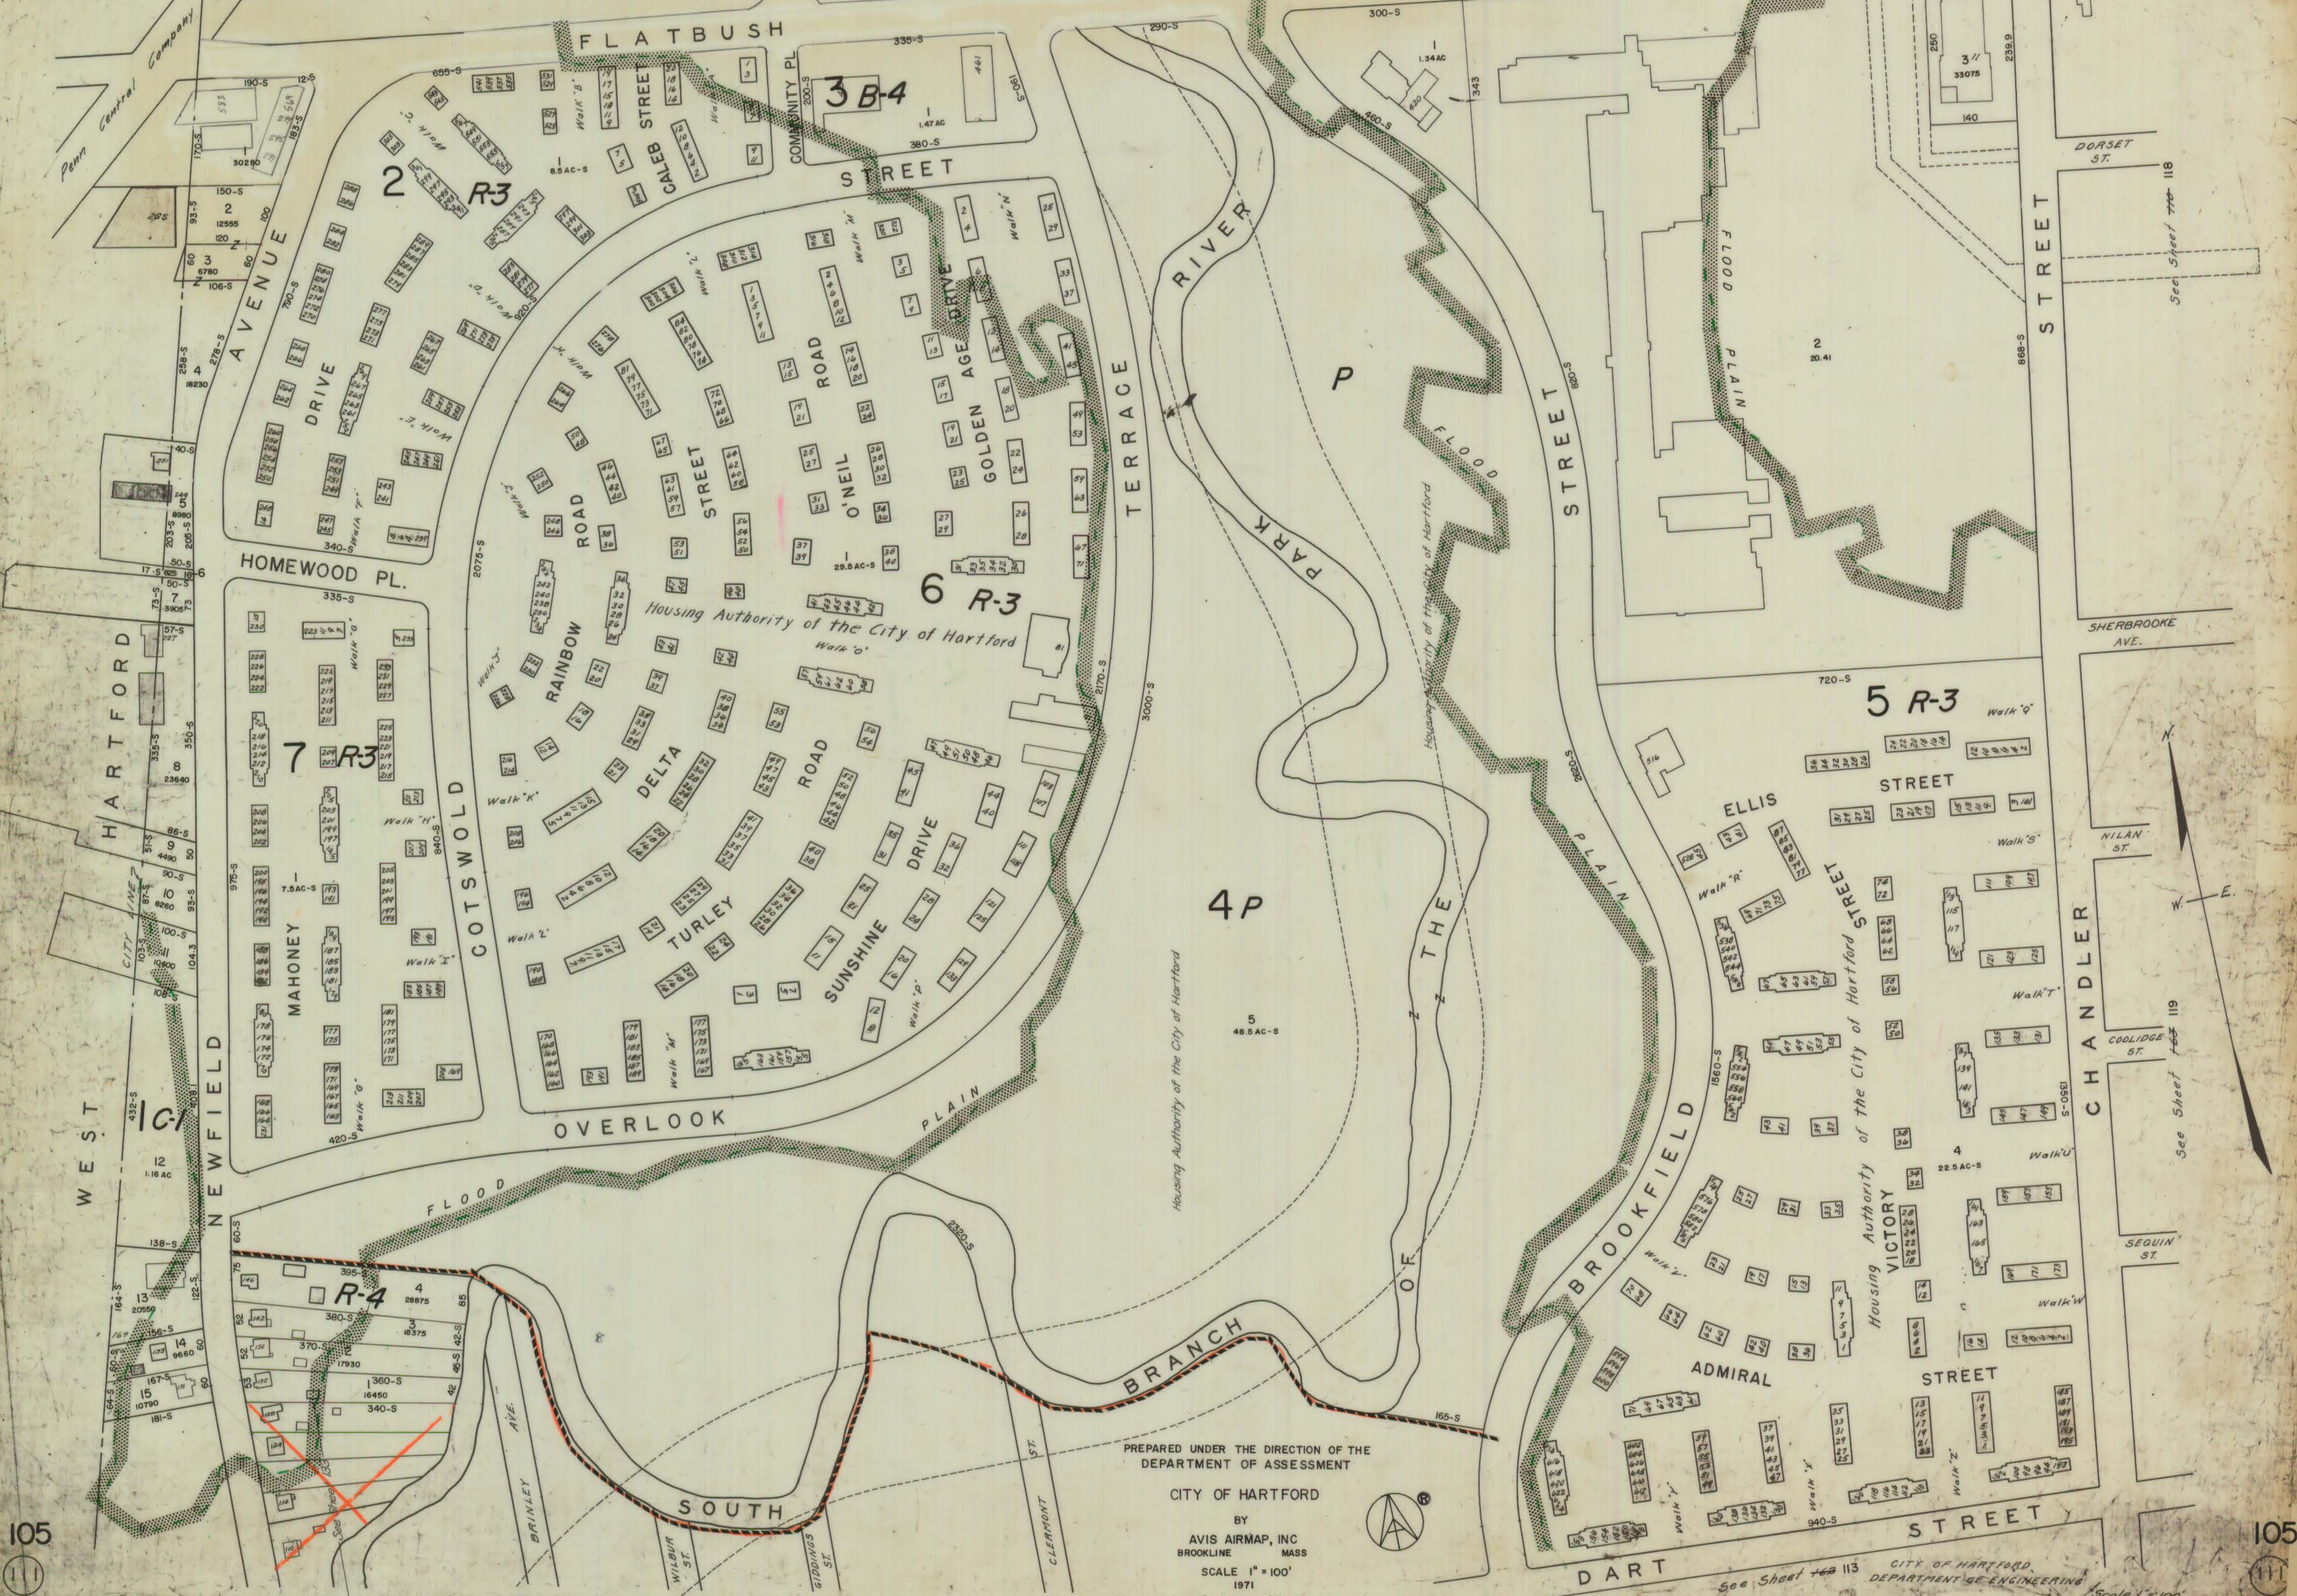

PREPARED UNDER THE DIRECTION OF THE
DEPARTMENT OF ASSESSMENT

CITY OF HARTFORD

BY
AVIS AIRMAP, INC
BROOKLINE MASS

SCALE 1" = 100'
1971

See Sheet 108

See Sheet 113

CITY OF HARTFORD
DEPARTMENT OF ENGINEERING

Scale 1" = 100'

See Sheet 104