

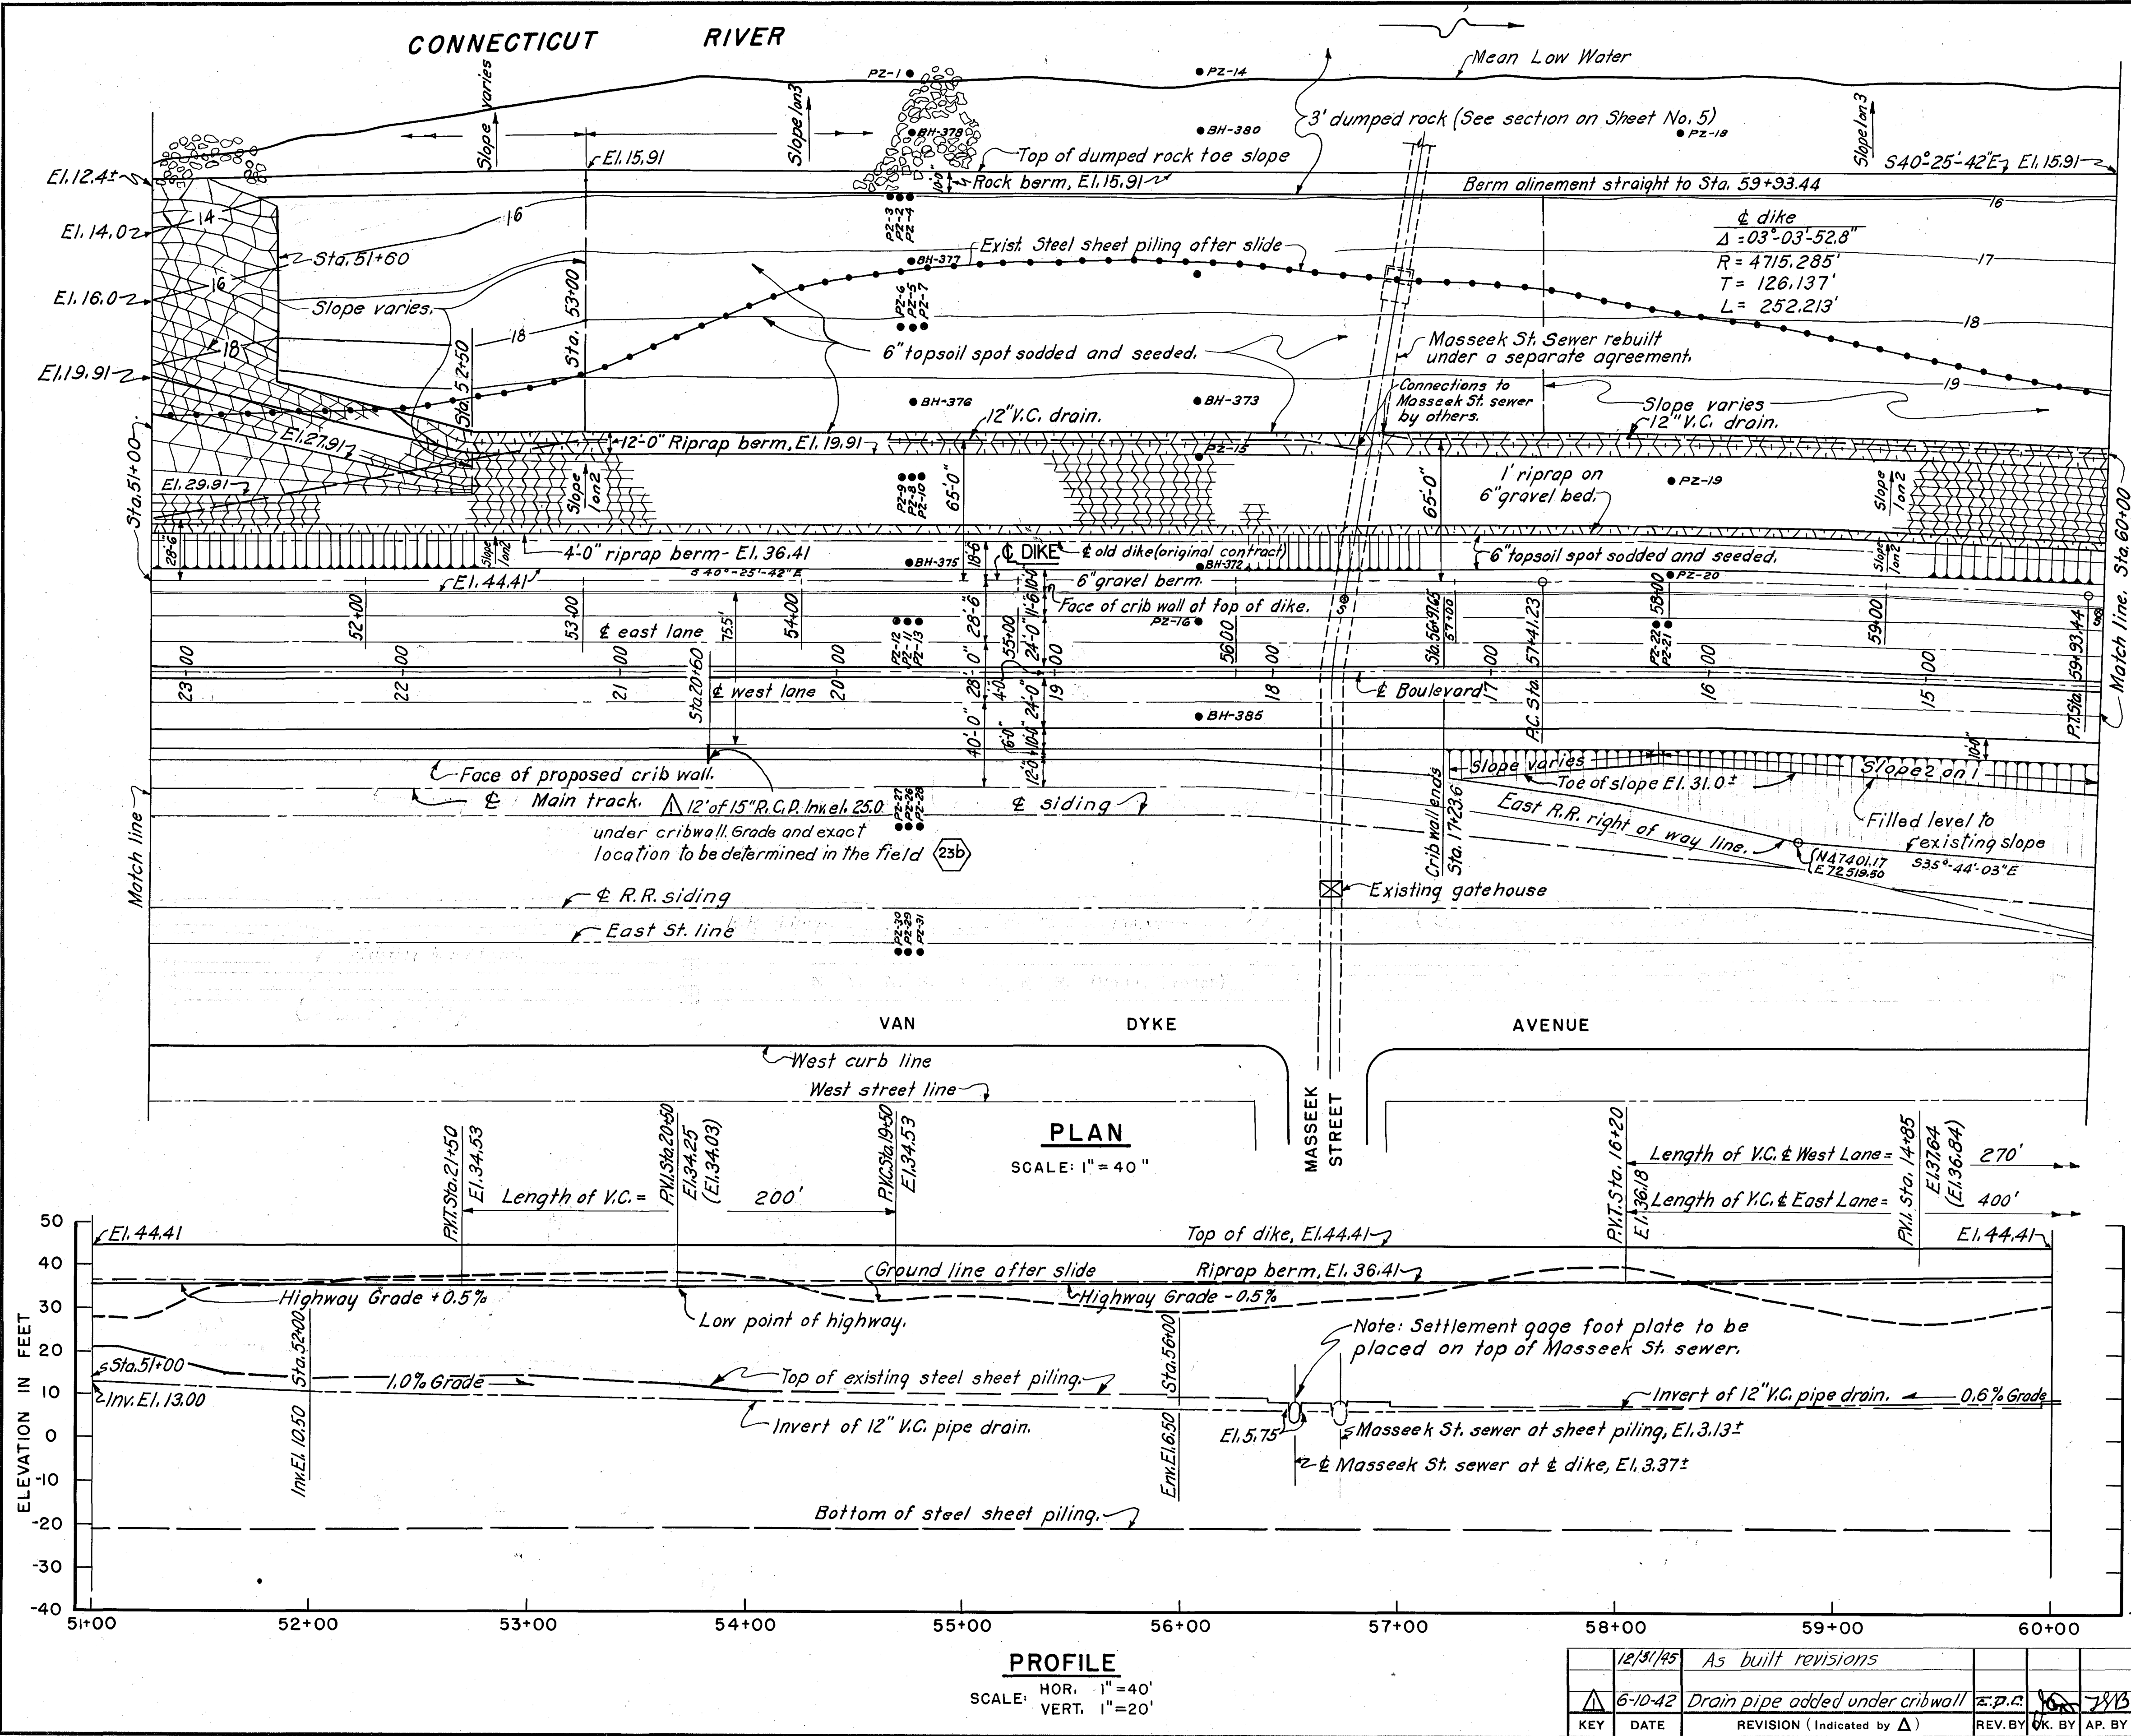


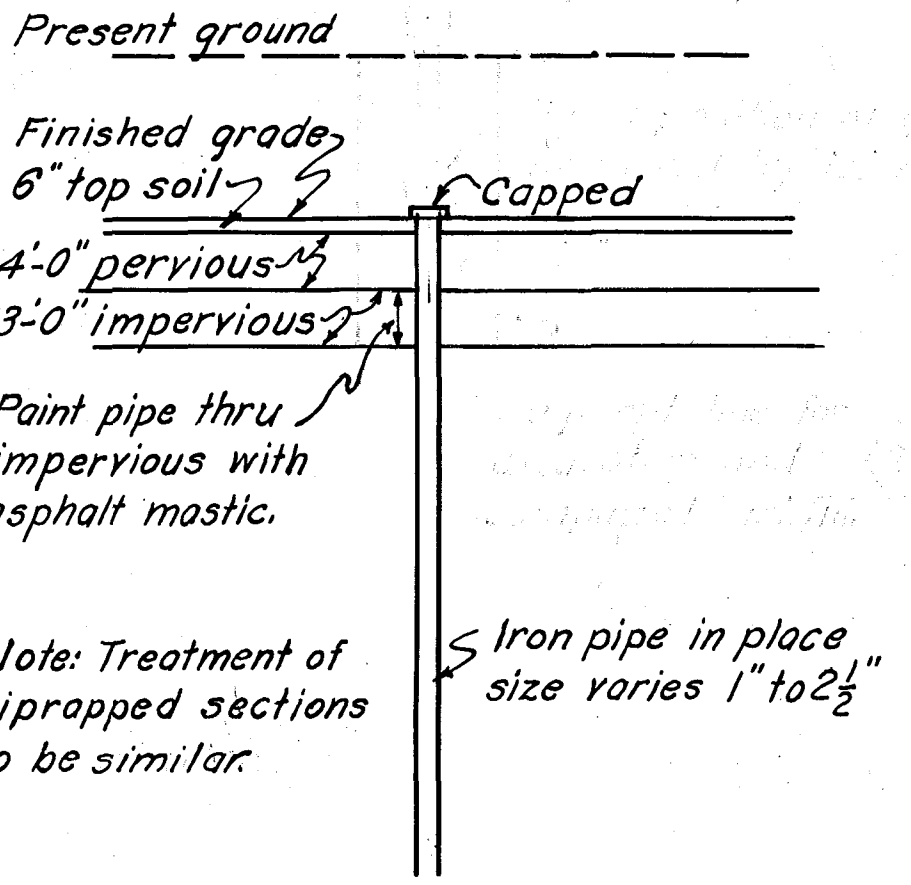

STATION COORDINATES		
STATION	NORTHINGS	EASTINGS
P.C. Sta. 57+41.23	N 47568.11	E 72537.27
P.T. Sta. 59+93.44	N 47371.84	E 72695.62

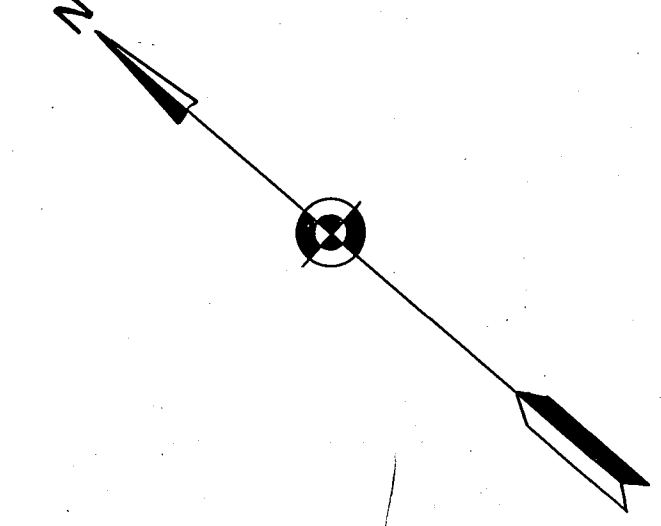

TYPICAL TREATMENT AT EXISTING PIEZOMETERS

NOT TO SCALE

NOTES:
For general notes see Sheet No. 2.
All elevations refer to Mean Sea Level Datum.
• (PZ) or • (BH) location of piezometers installed by the United States to be protected during operations. Necessary work around piezometers to be paid for under Item No. 21.
§ Settlement gage.

CONNECTICUT RIVER FLOOD CONTROL
HARTFORD DIKE
SUPPLEMENTAL AGREEMENT
RECONSTRUCTION AT SLIDE STA. 44+45.68 TO STA. 65.00
PLAN AND PROFILE NO. 2

CONNECTICUT RIVER
IN 7 SHEETS
SCALE: 1 IN. = 40 FT.
SHEET NO. 3

U.S. ENGINEER OFFICE, PROVIDENCE, R.I., MARCH 1942

DESIGNED: J. C. HANCOCK
CHECKED: E. D. S.
ASSOC. ENGINEER

APPROVED: J. C. HANCOCK
CHIEF, ENGINEERING DIV.
APPROVED: J. A. O. - D.W.G.
TRACED: B. J. P.
FILE NO. CT-4-3057