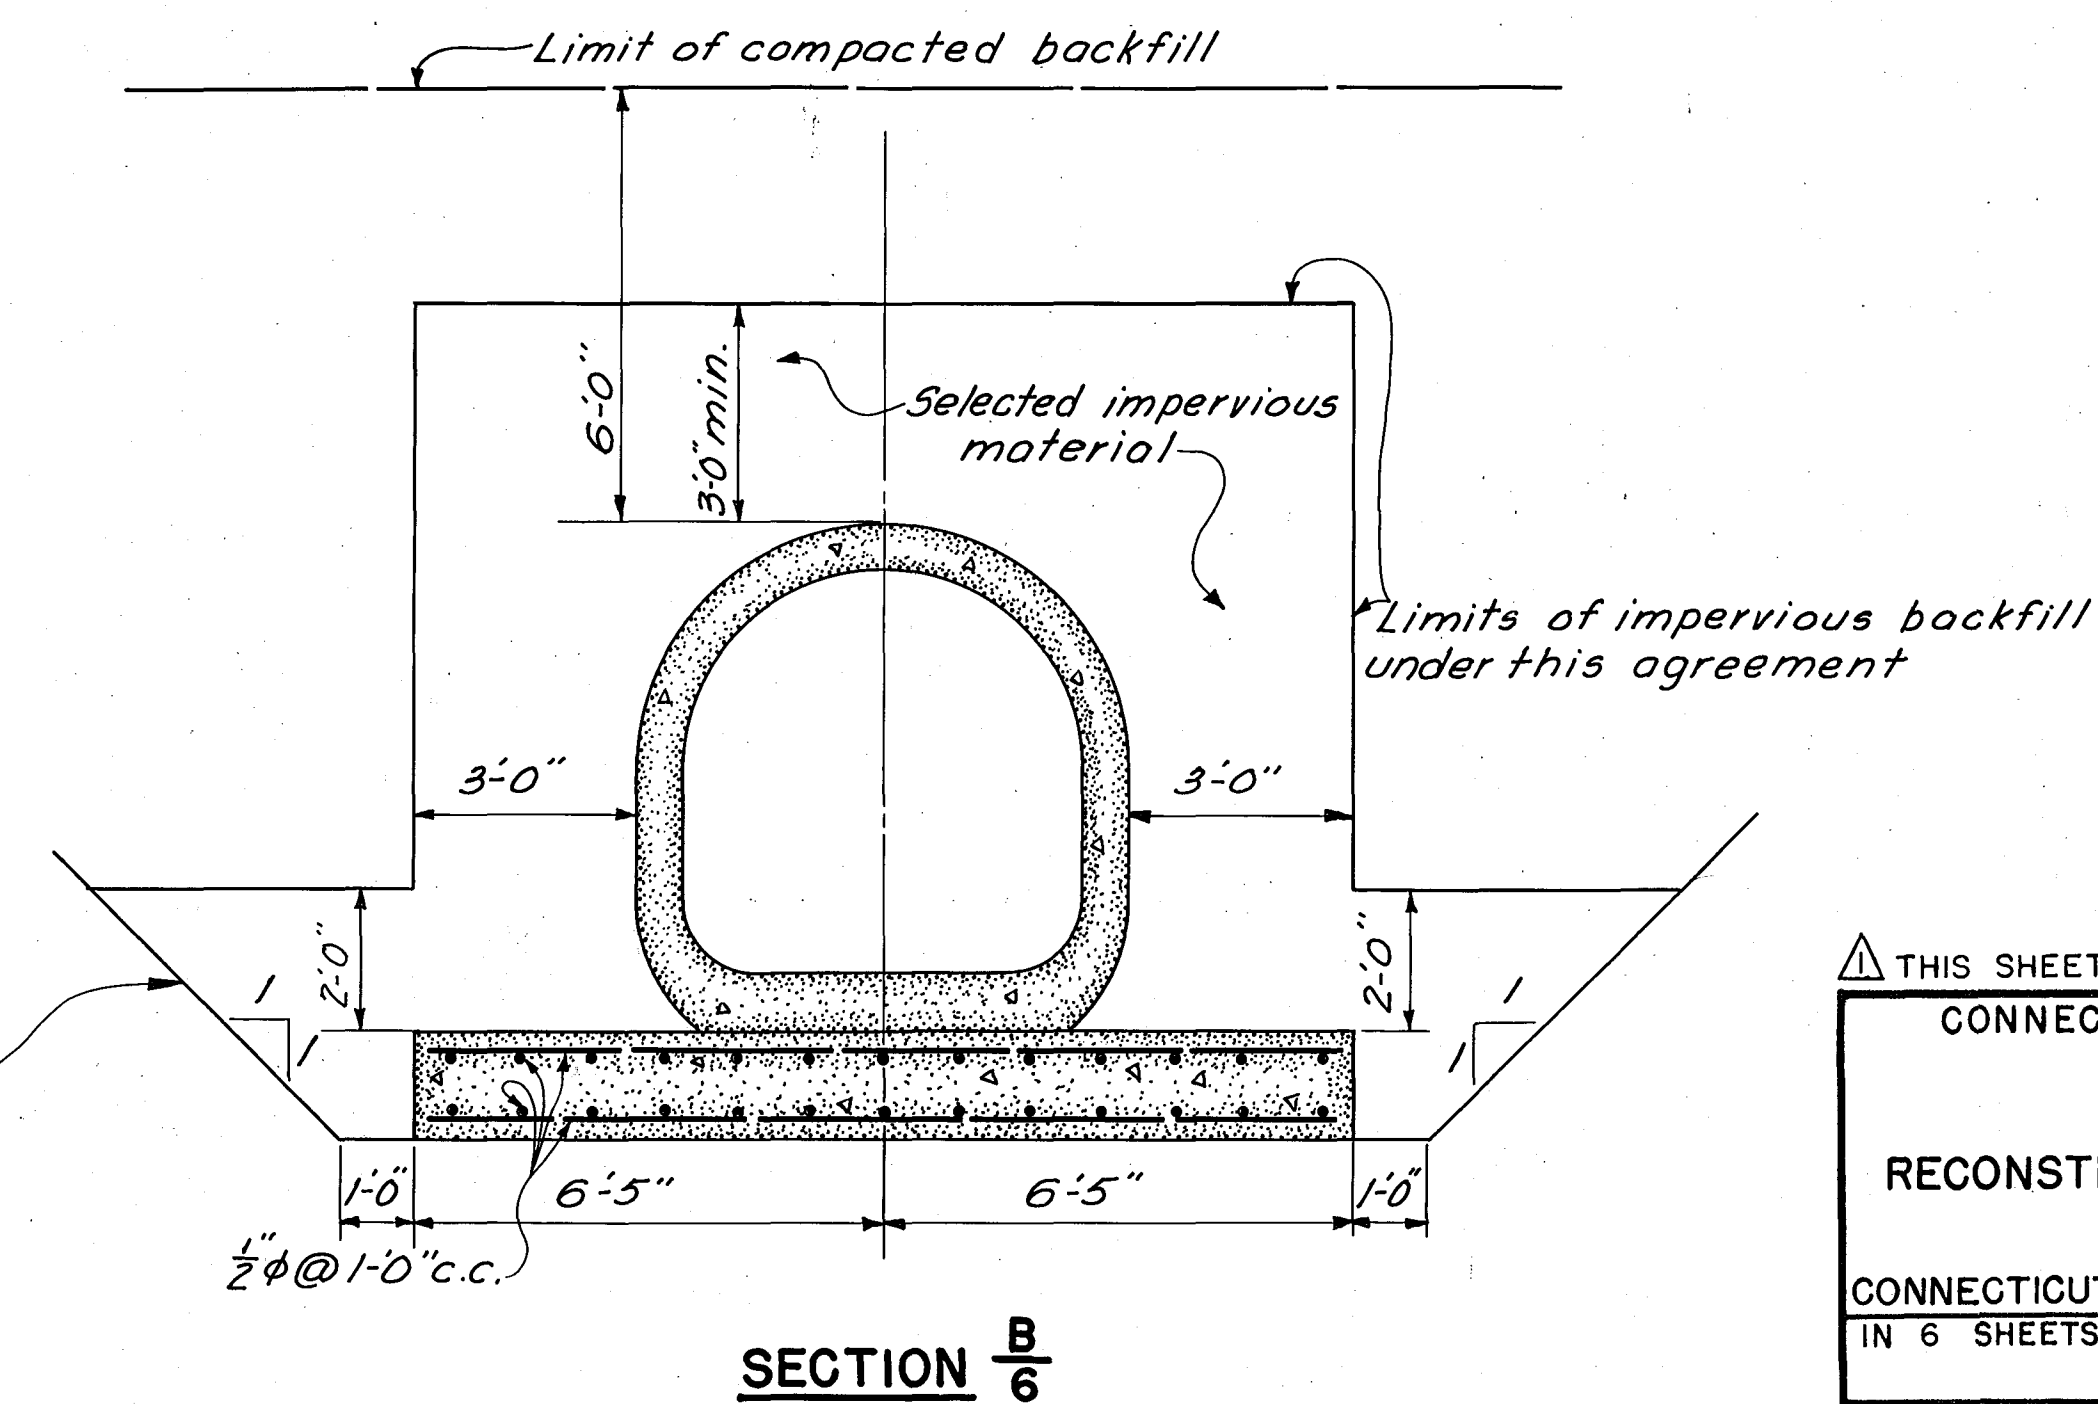
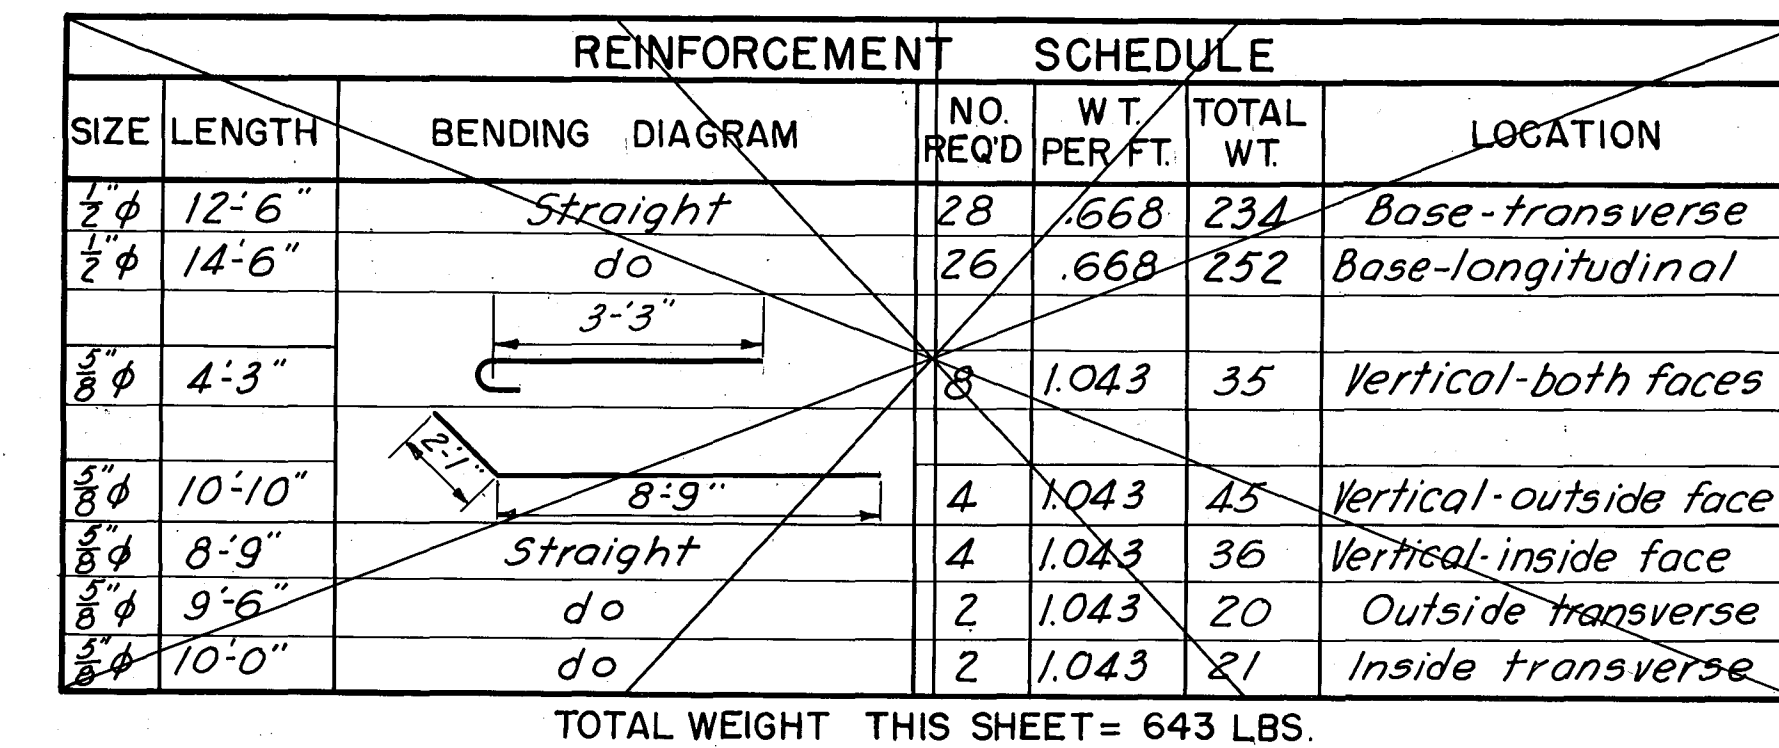


[illegible]

THIS SHEET ADDED TO SET

CONNECTICUT RIVER FLOOD CONTROL
HARTFORD DIKE
 SUPPLEMENTAL AGREEMENT
 RECONSTRUCTION OF MASSEK ST. SEWER
 SEEP RING DETAILS

CONNECTICUT RIVER CONNECTICUT
 IN 6 SHEETS SCALE: 3/8 IN. = 1 FT. SHEET NO. 6

4' 0 4'

U.S. ENGINEER OFFICE, PROVIDENCE, R.I., FEB. 1942

SUBMITTED: *J. C. Singall* APPROVED & RECOMMENDED: *J. S. Burns* DESIGNED: *G. H. Brinkley*
 SENIOR ENGINEER PRINCIPAL ENGINEER LT. COL., CORPS OF ENGINEERS
 CHIEF, DESIGN SECTION CHIEF, ENGINEERING DIV. DISTRICT ENGINEER

DESIGN: *P. C. Henscoble* DRAWN: D.W.C. TRACED: A.J.H. CHECKED: *E. E. C.* FILE NO. CT-4-3130
 ASSOC. ENGINEER