


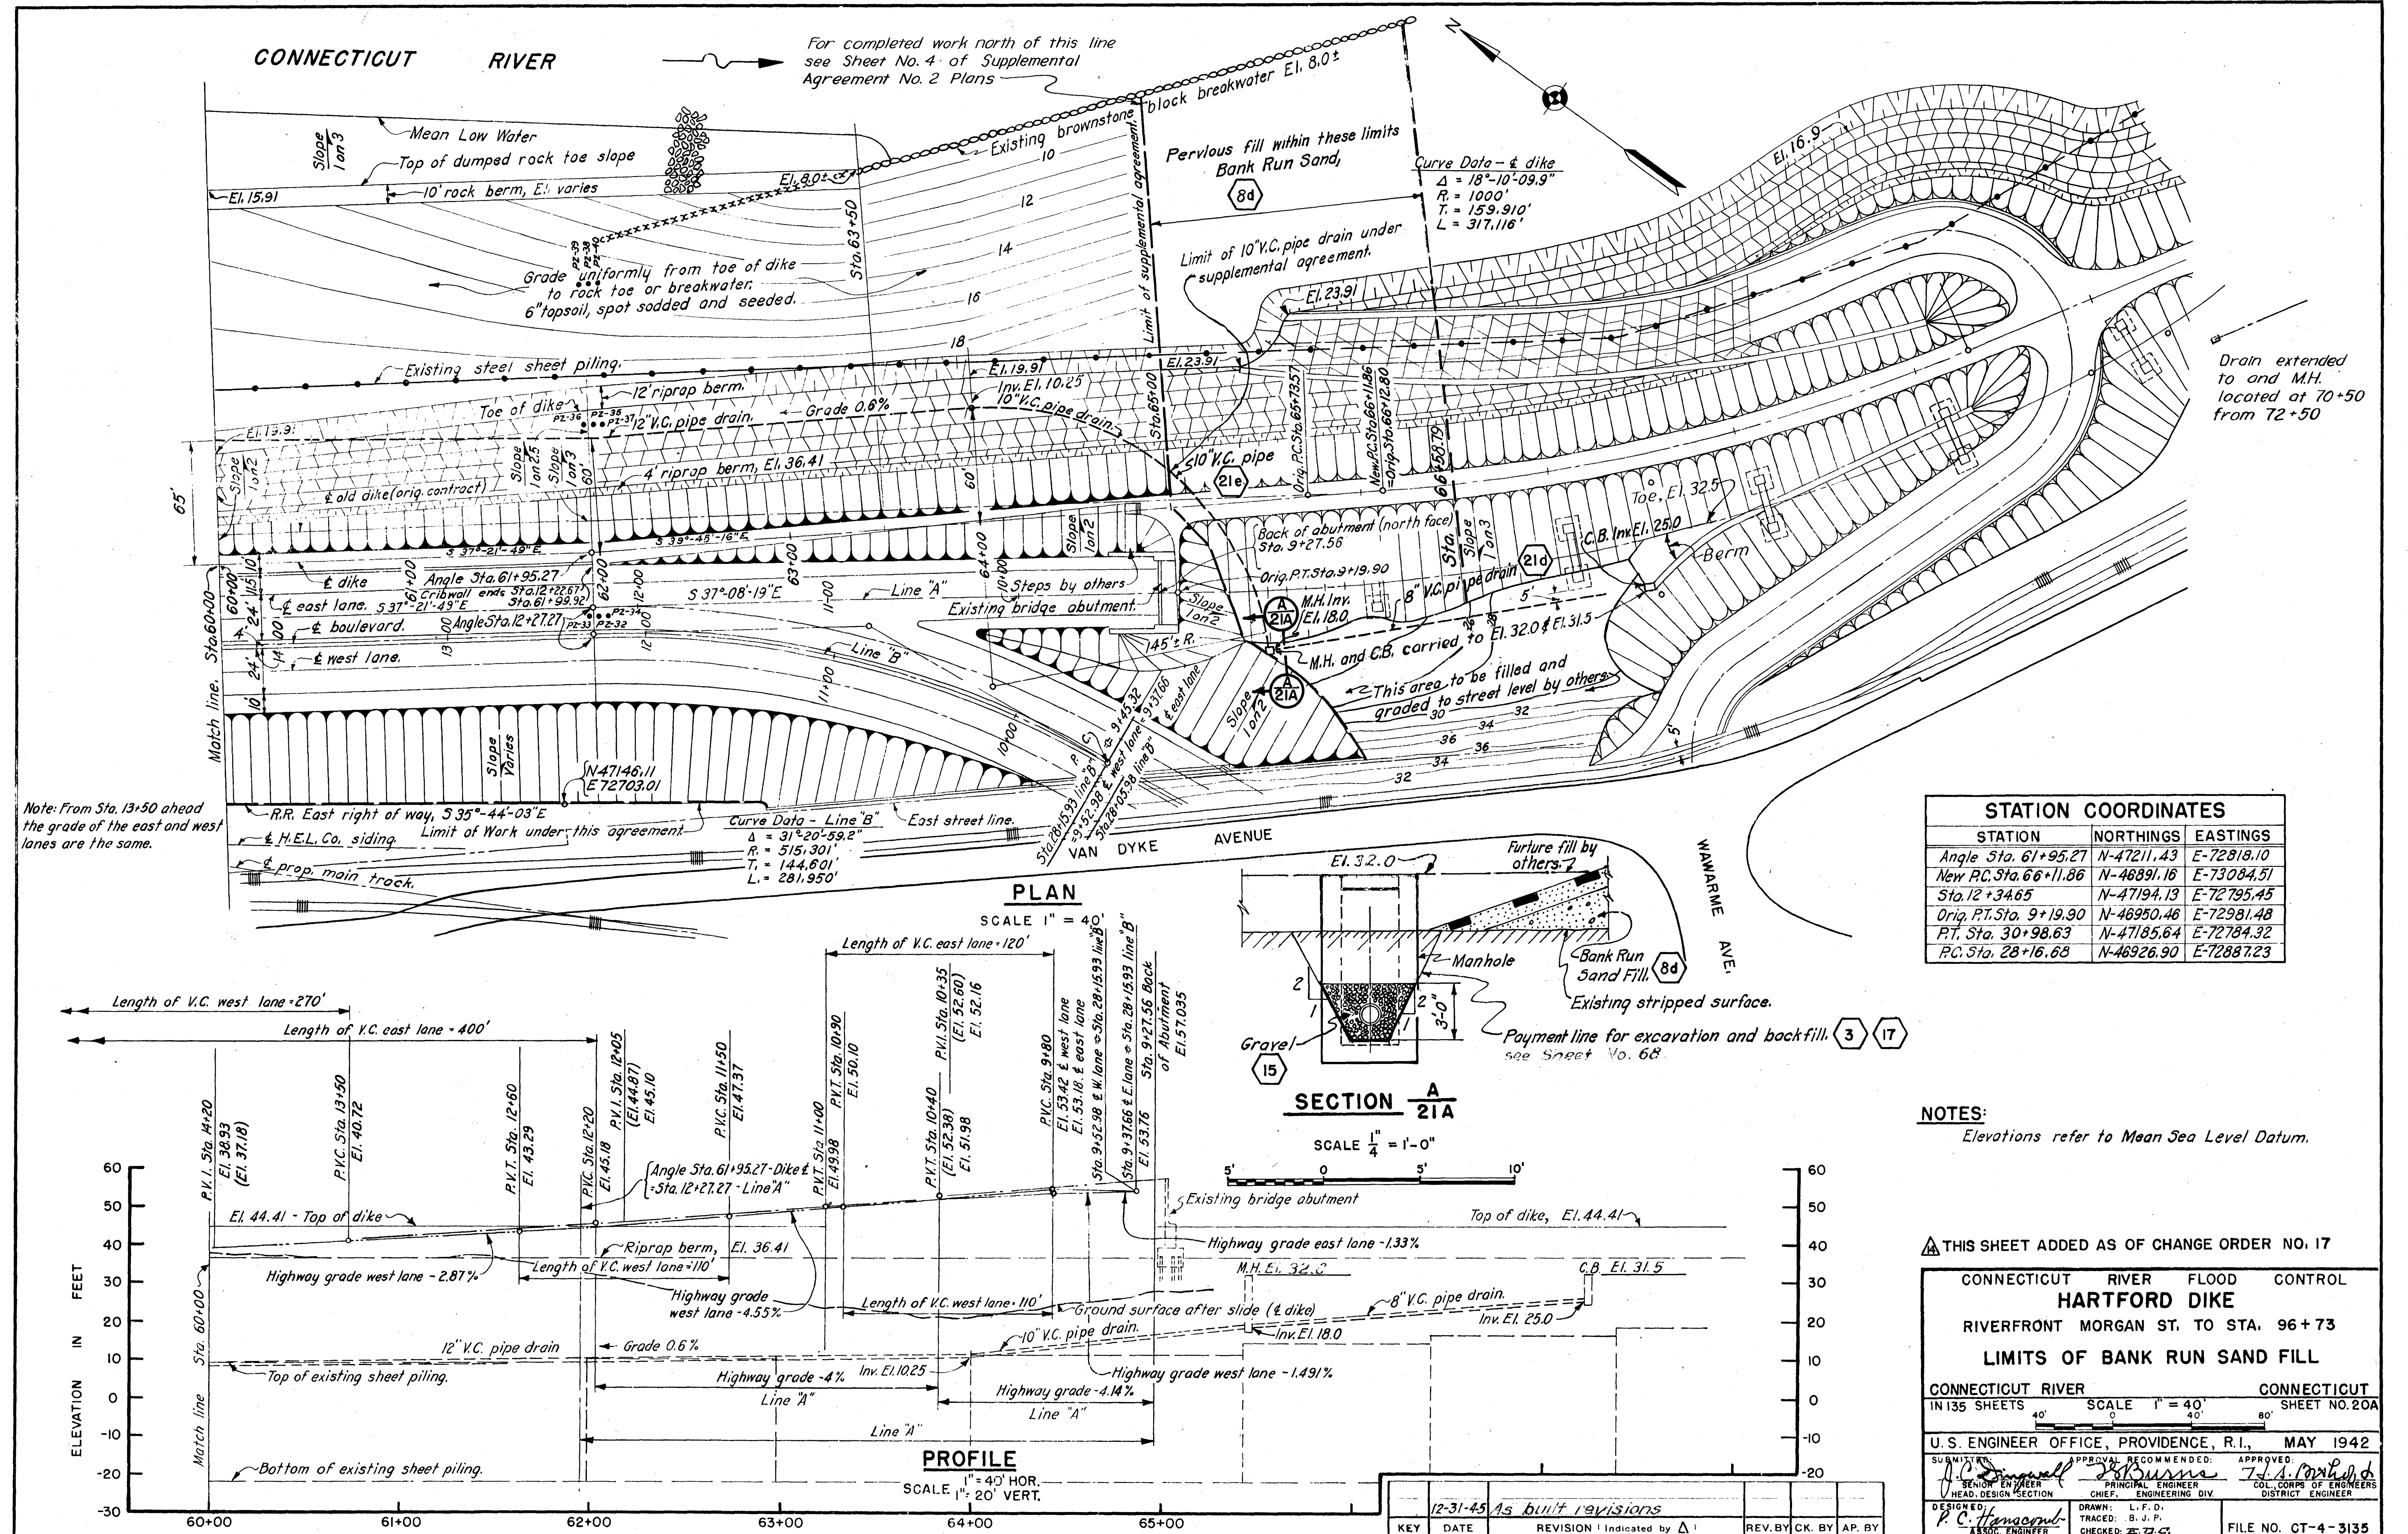

File 11-14-3