



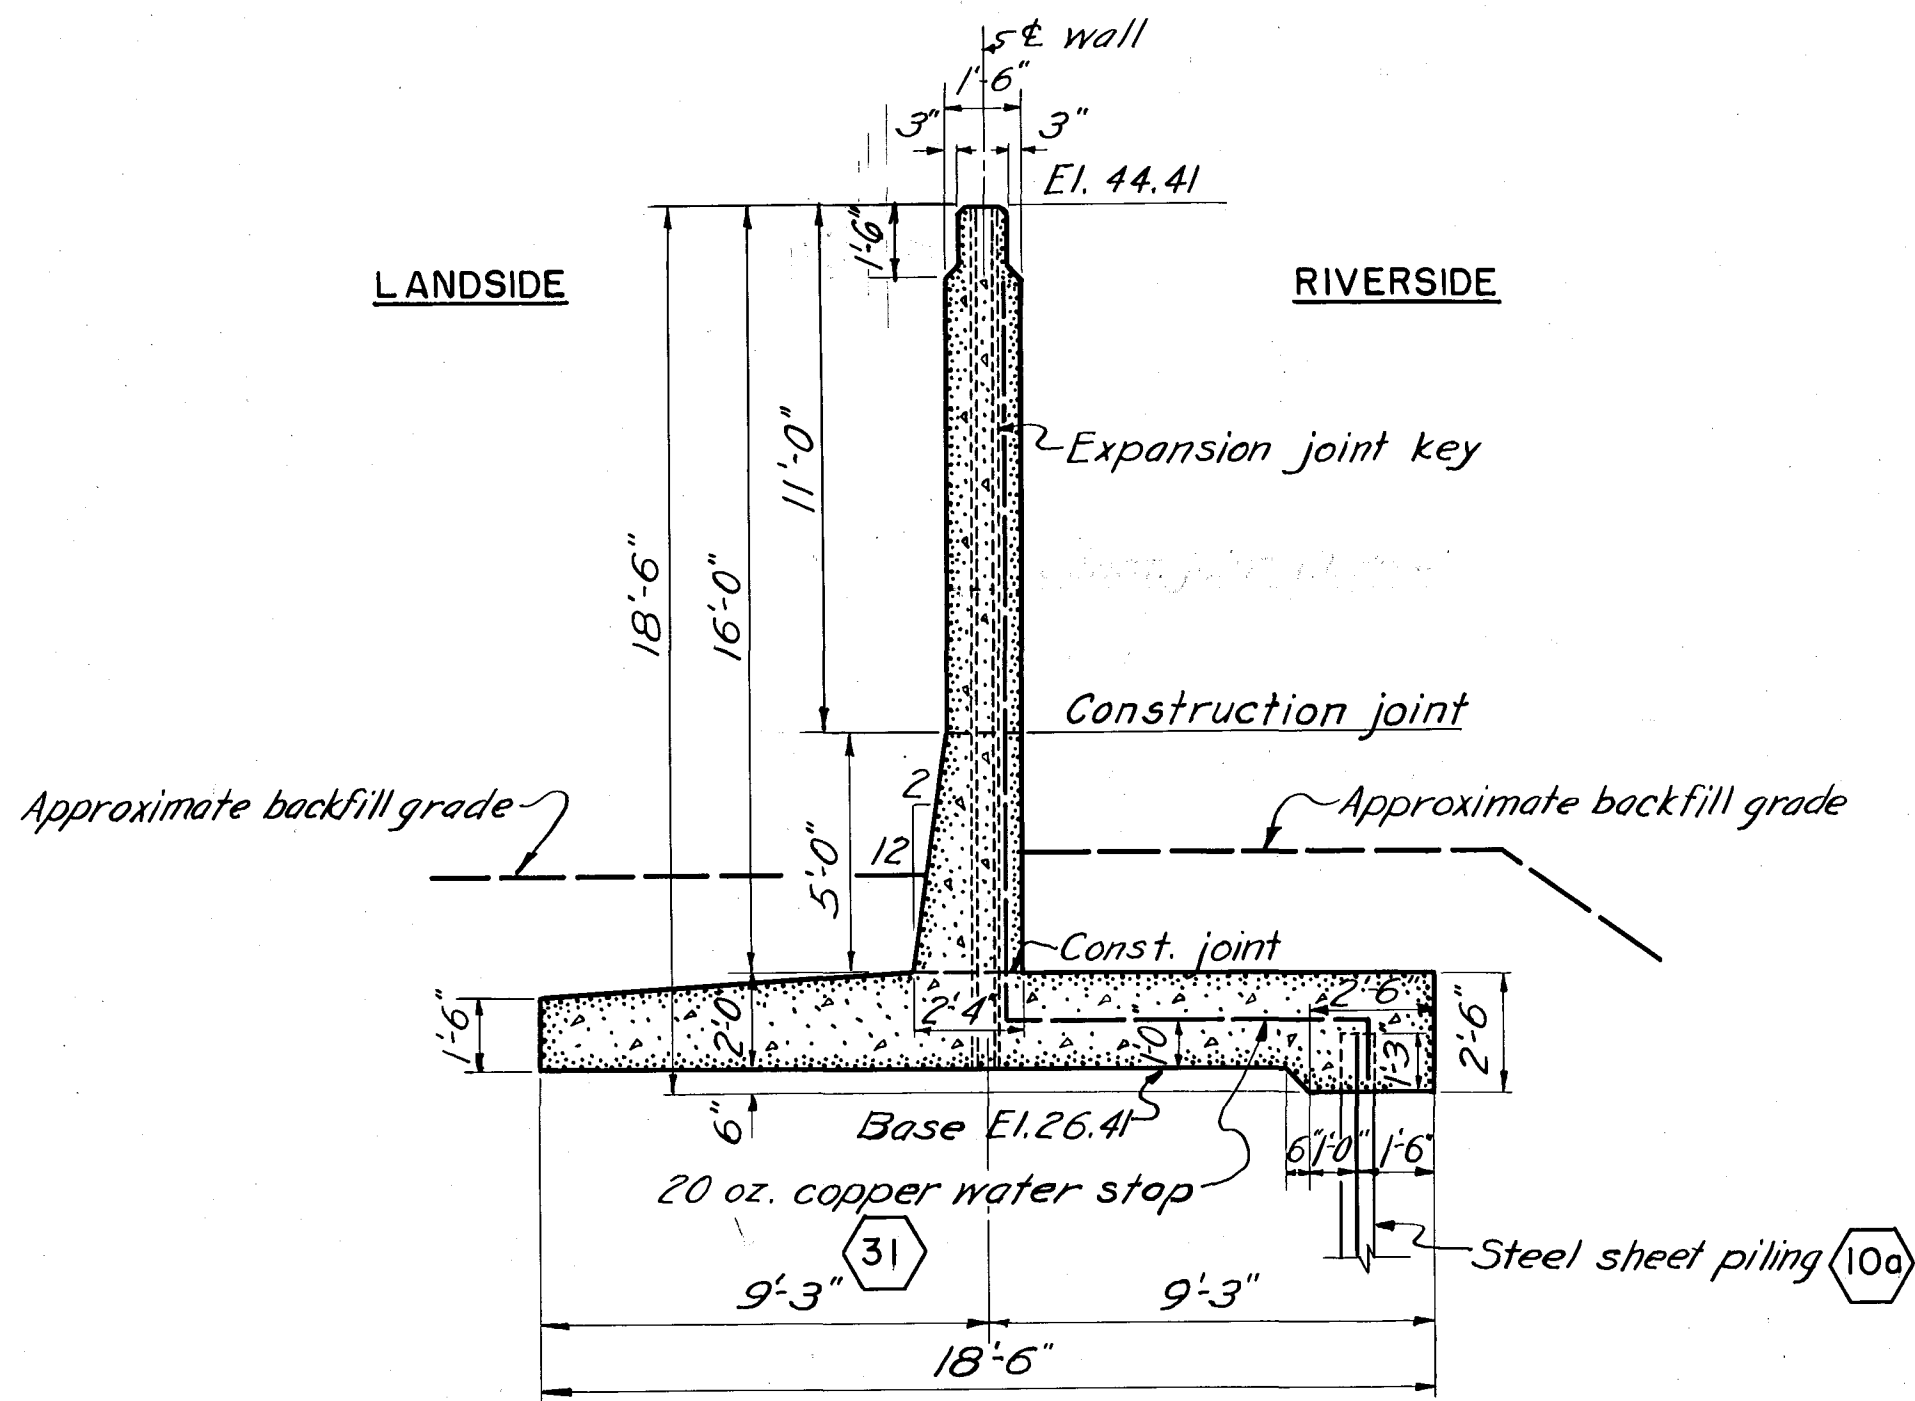

16'-0" WALL SECTION

STA. 80+10 TO STA. 85+17.5
FOR WALL FROM STA. 85+17.5 TO STA. 85+30, SEE SHEETS NO. 60 & 64

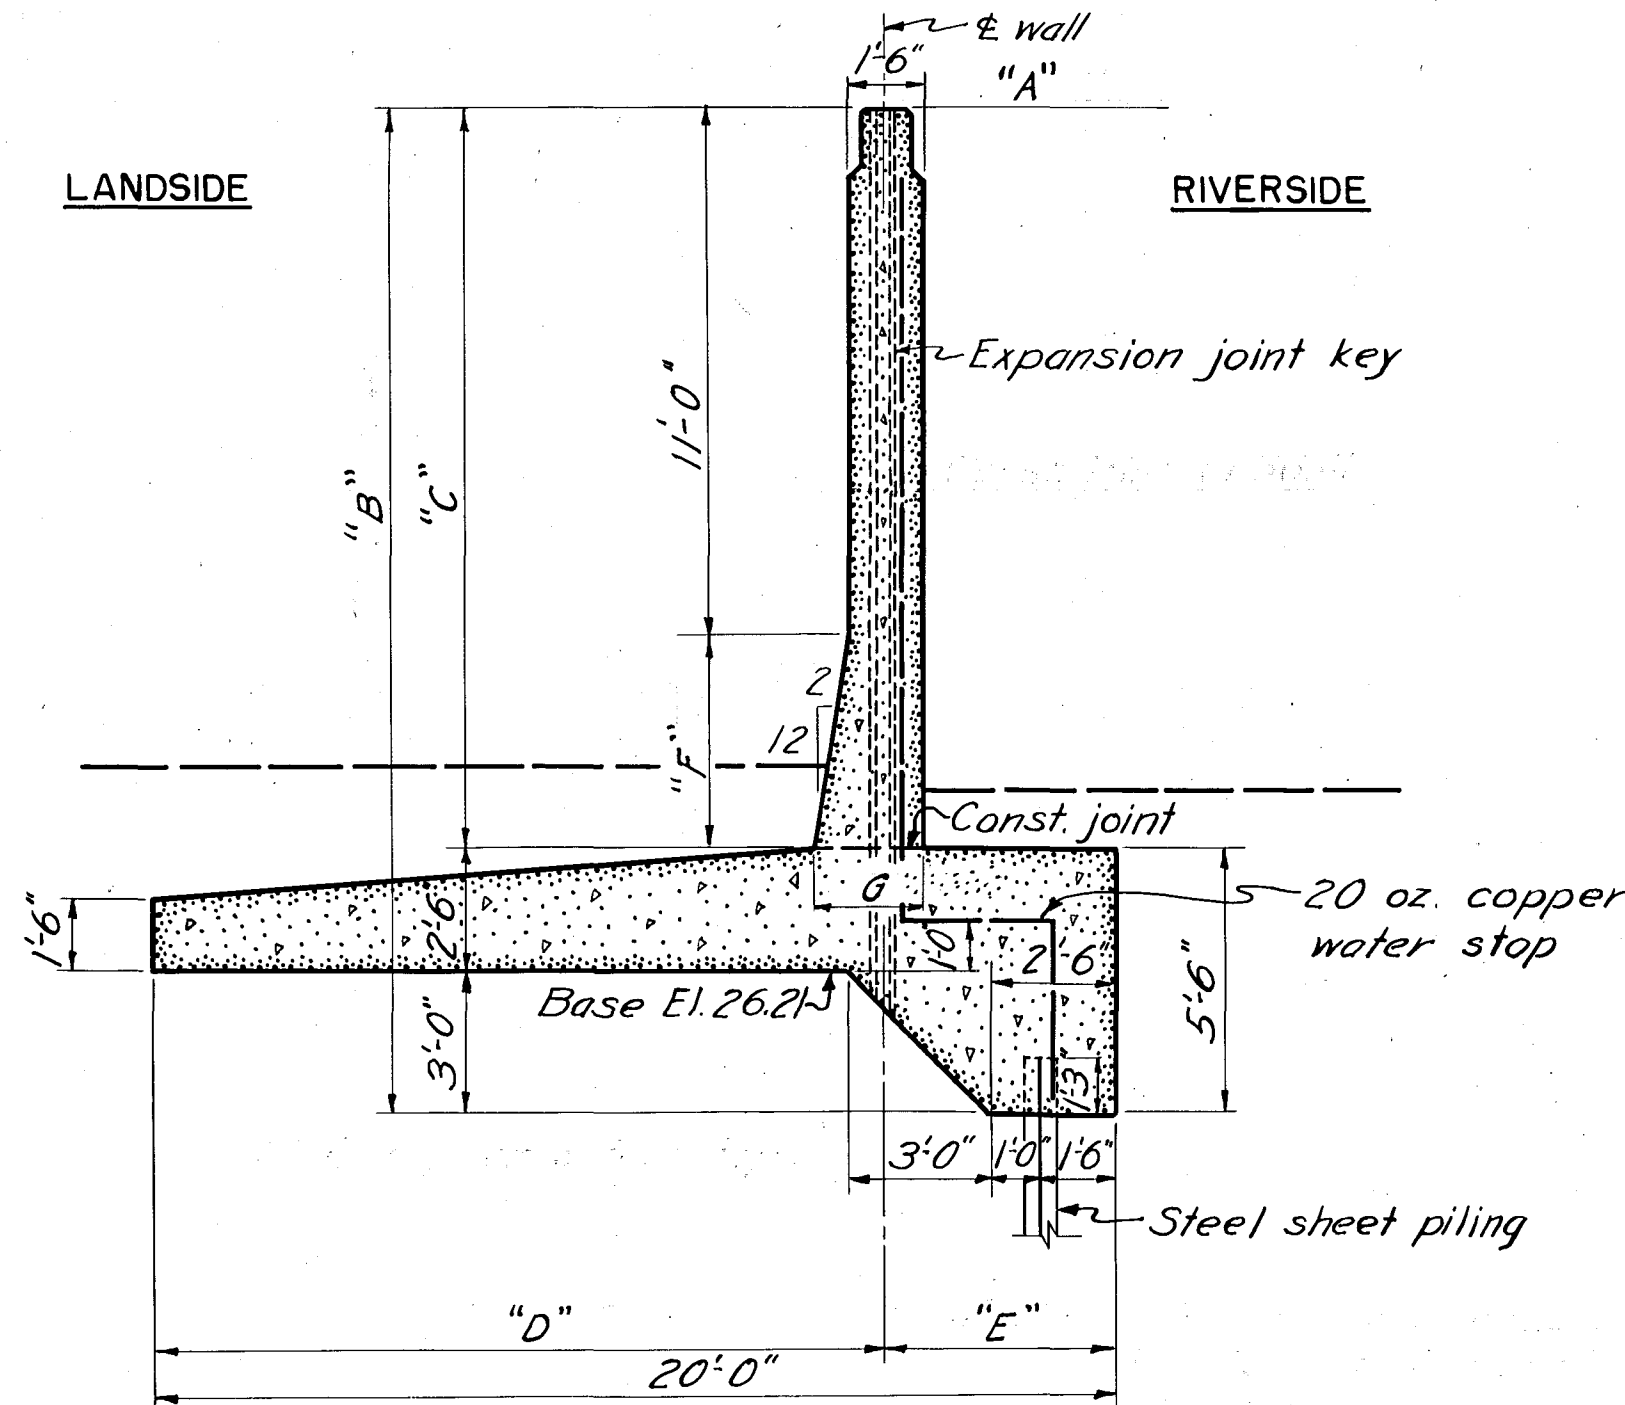


15'-6" WALL SECTION

STA. 85+30 TO STA. 87+98.86

SEE TABLE

From 87+76.43 to 87+38.86 the overall base width is 25'-0" (Indorsement of 8/27/40).

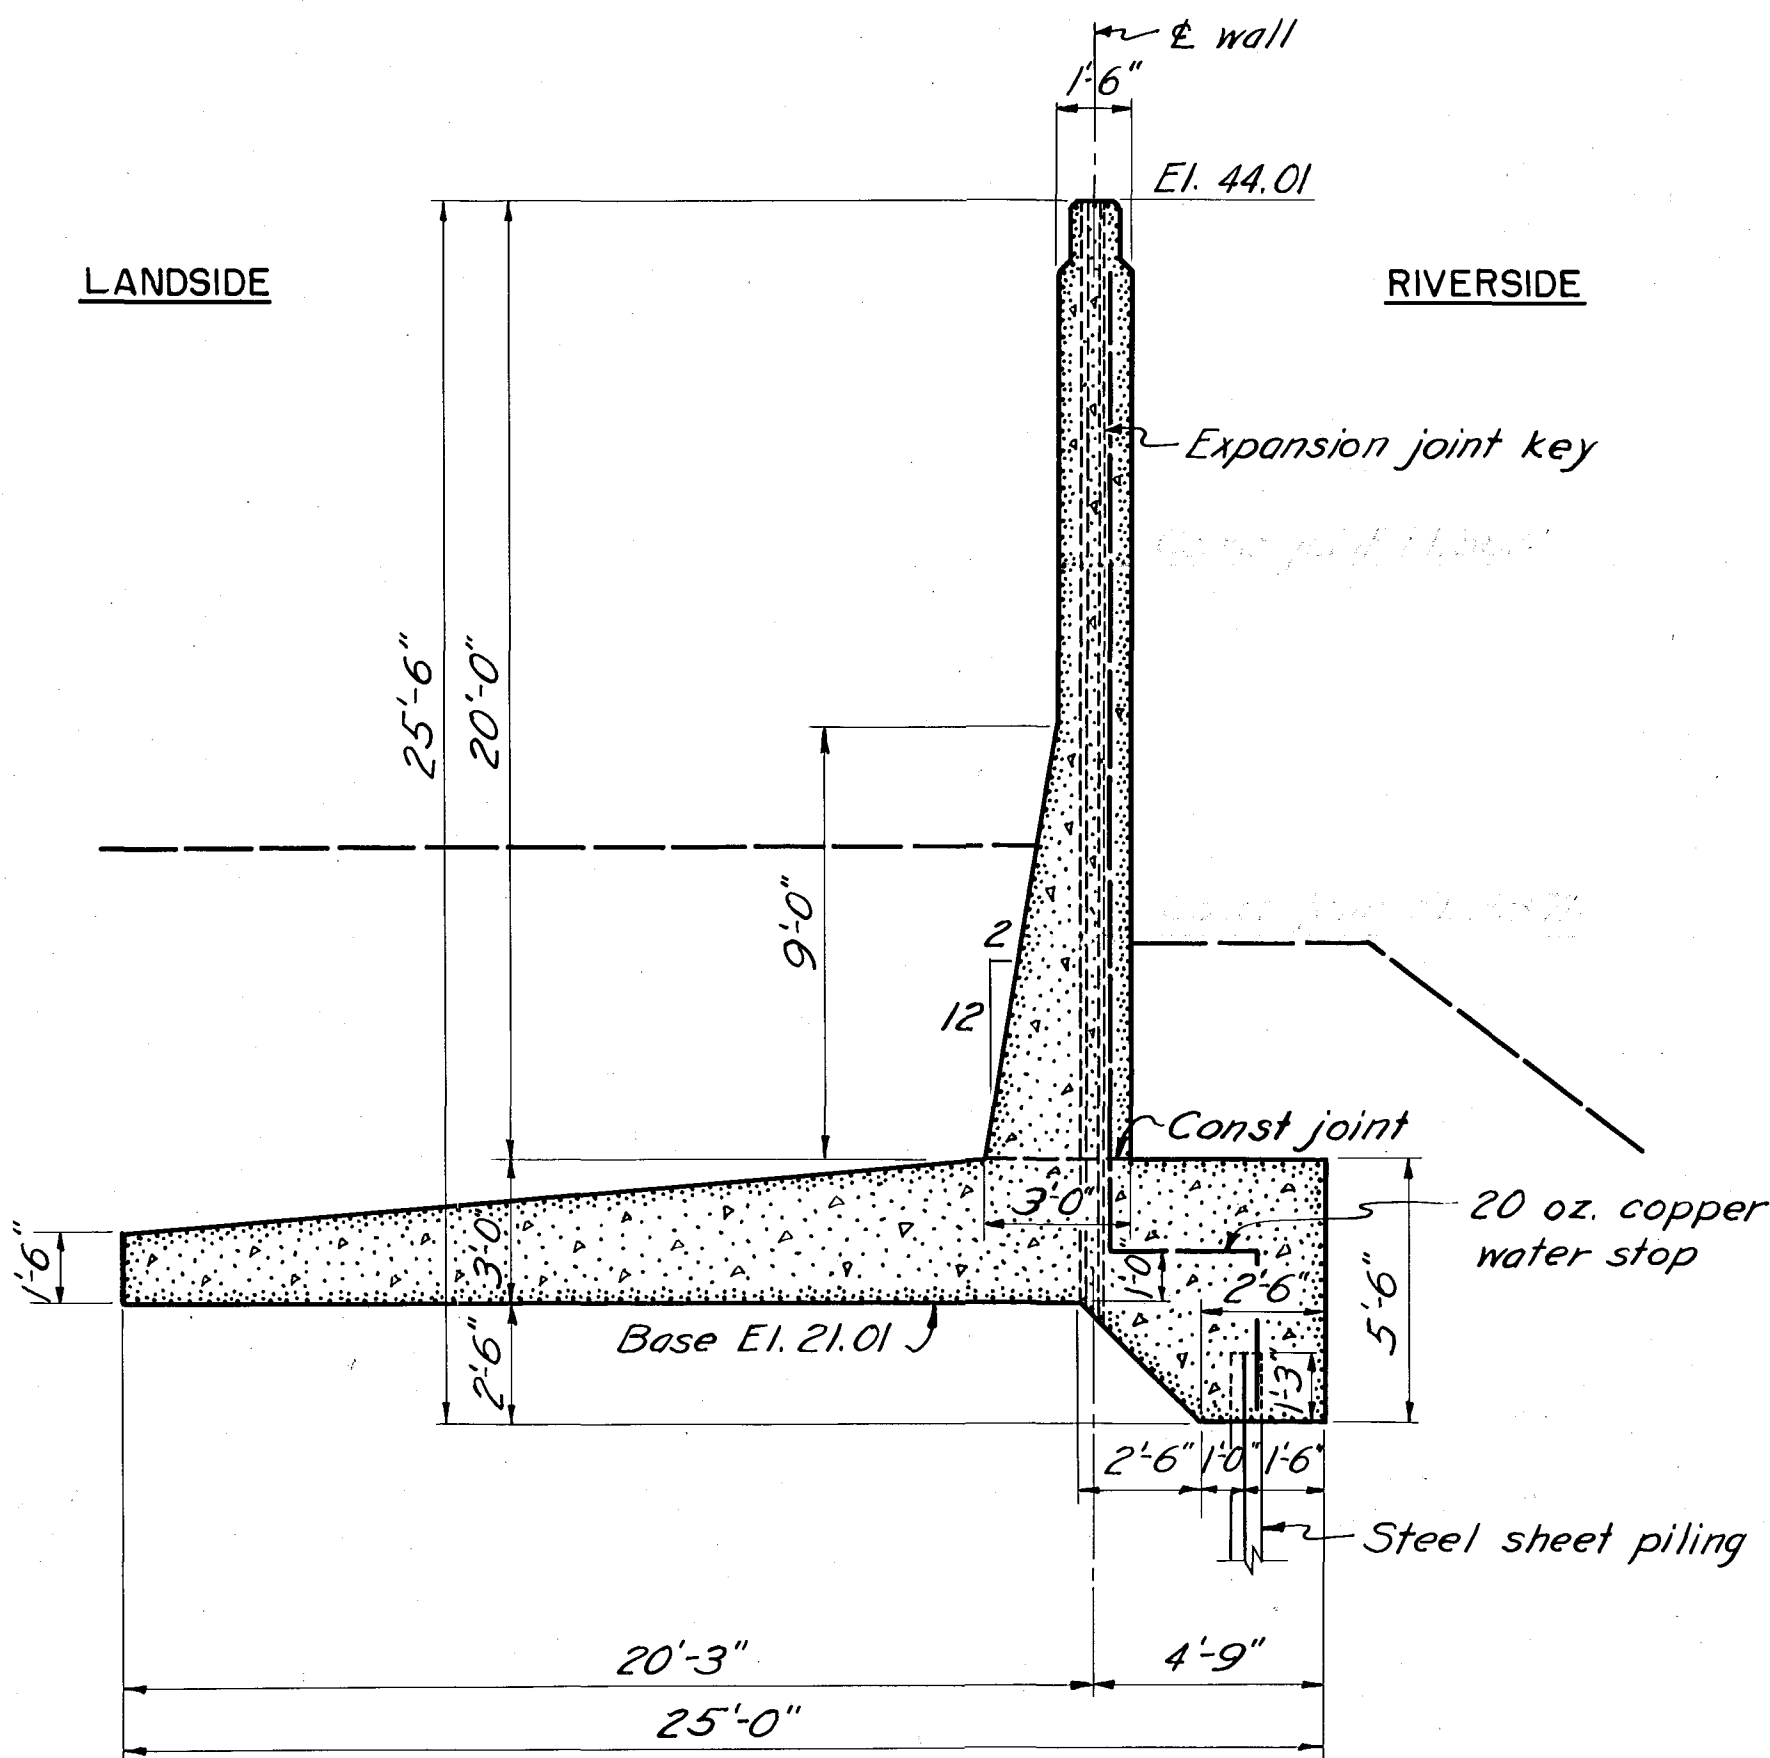


20'-0" WALL SECTION

STA. 87+98.86 TO STA. 88+38.86


TABLE FOR 15'-6" WALL

STA. TO STA.	"A"	"B"	"C"	"D"	"E"	"F"	"G"	REFERENCE
85+30 to Stop log	El. 44.41	21'-2 1/2"	15'-8 1/2"	Varies	Varies	4'-8 1/2"	2'-3 1/2"	Sheet No. 60
Stop log (Sta. 85+39.0)								Sheet No. 64
Stop log to Sta. 86+02.49	El. 44.21	21'-0"	15'-6"	Varies	Varies	4'-6"	2'-3"	Sheet No. 60
86+02.49 to 87+39.93	El. 44.21	21'-0"	15'-6"	15'-3"	4'-9"	4'-6"	2'-3"	
87+39.93 to 87+76.43 (Stop log)								Sheet No. 65
87+76.43 to 87+98.86	El. 44.01	20'-9 1/2"	15'-3 1/2"	20'-3"	4'-9"	4'-3 1/2"	2'-2 1/2"	

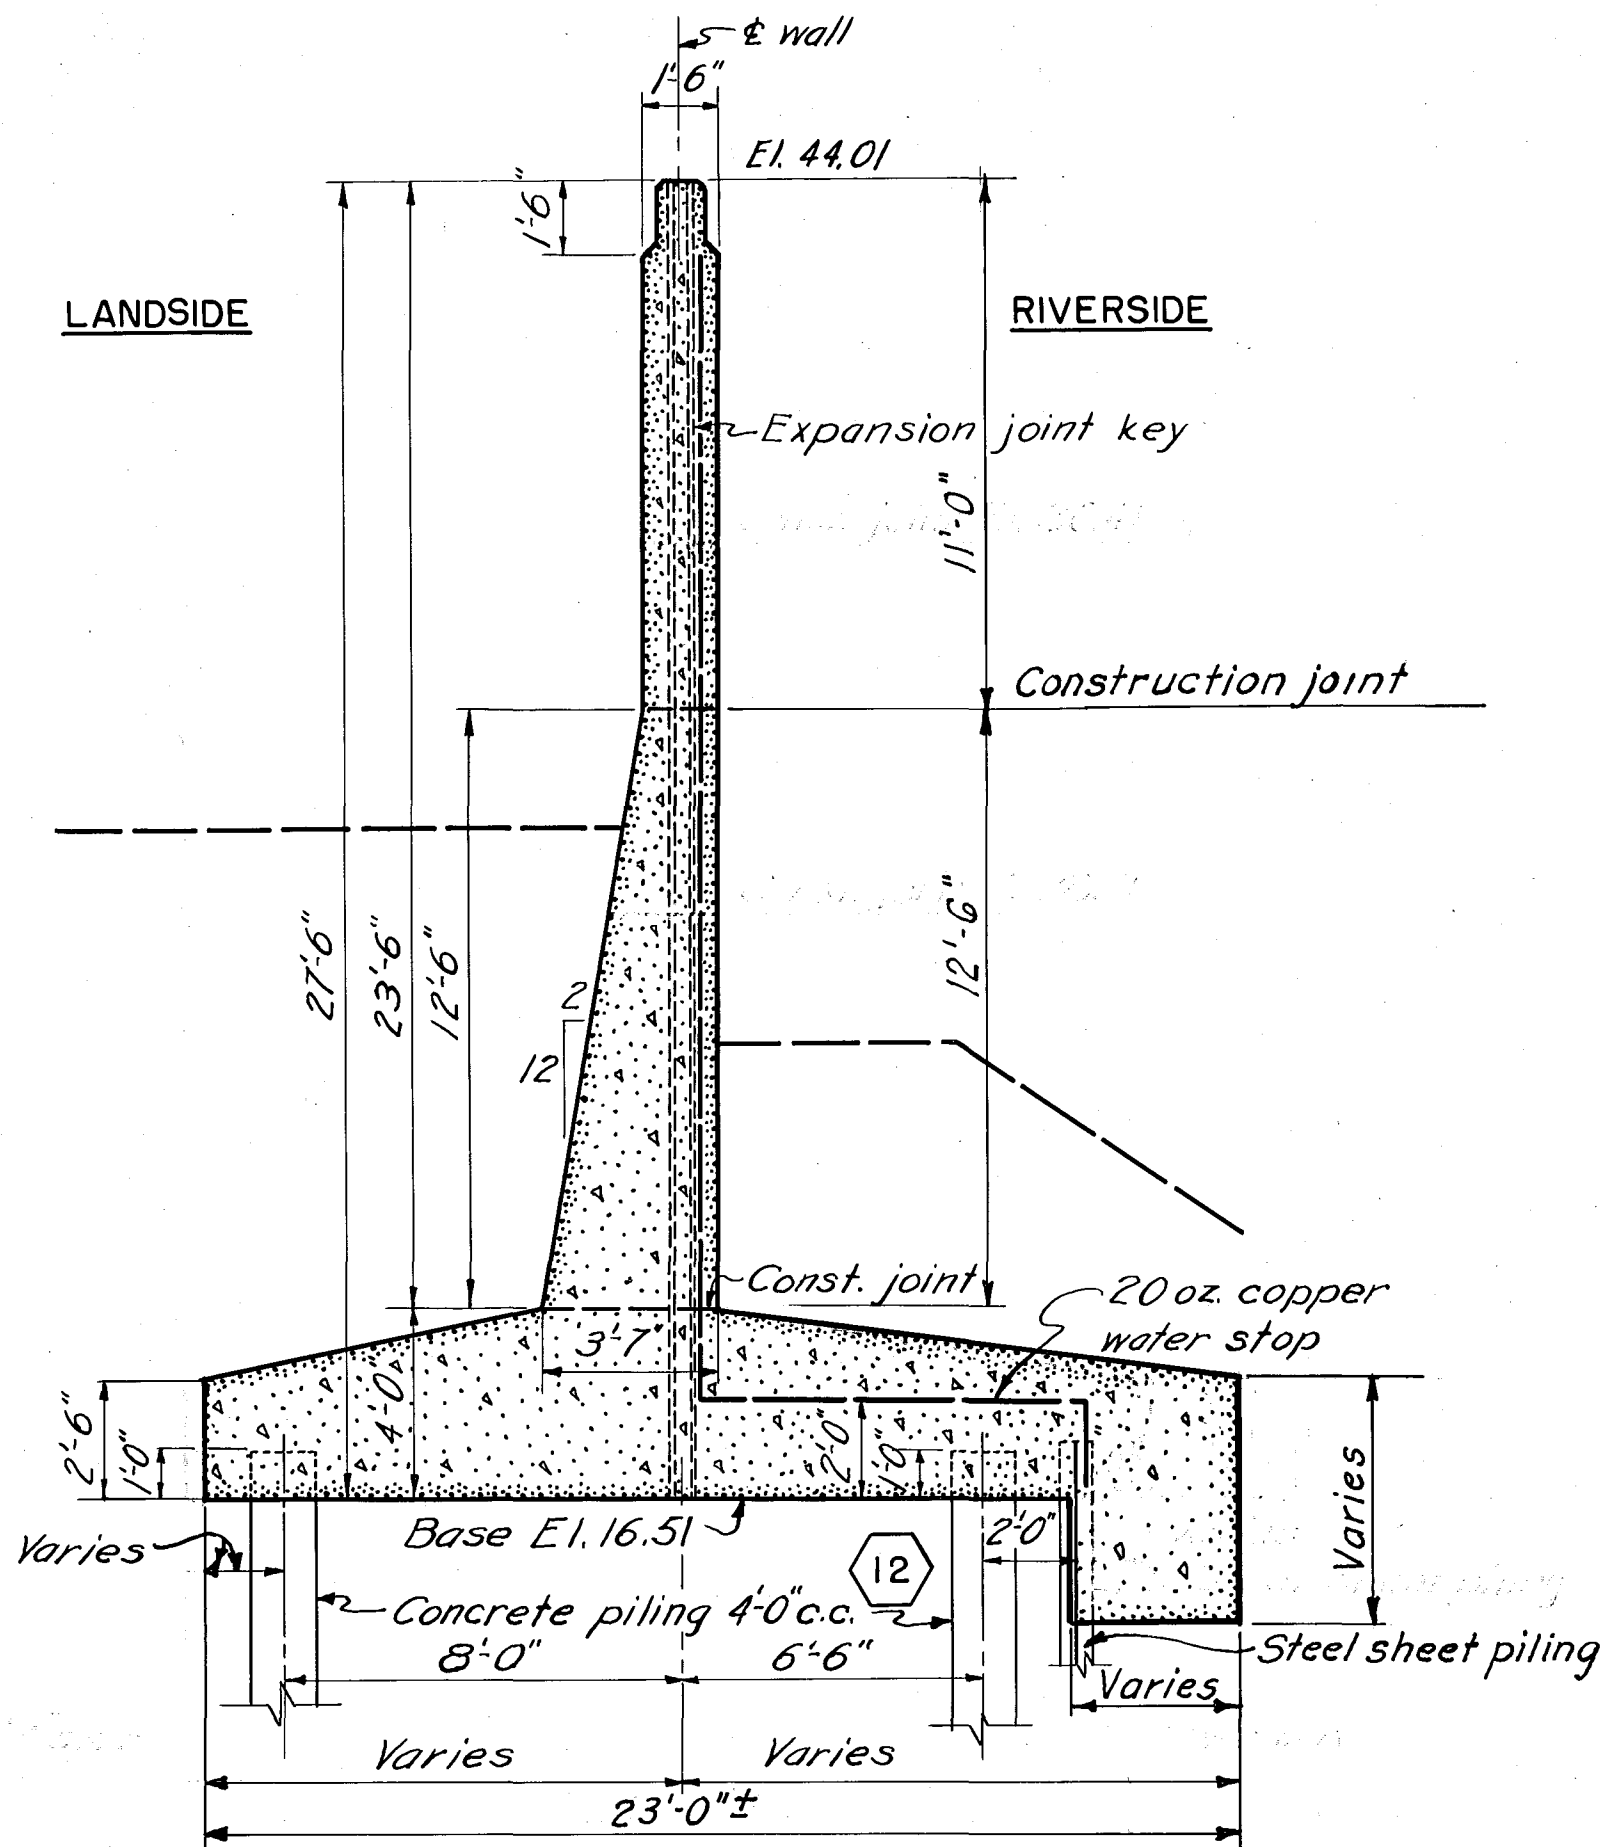

23'-6" WALL SECTION

STA. 88+38.86 TO STA. 88+85.34

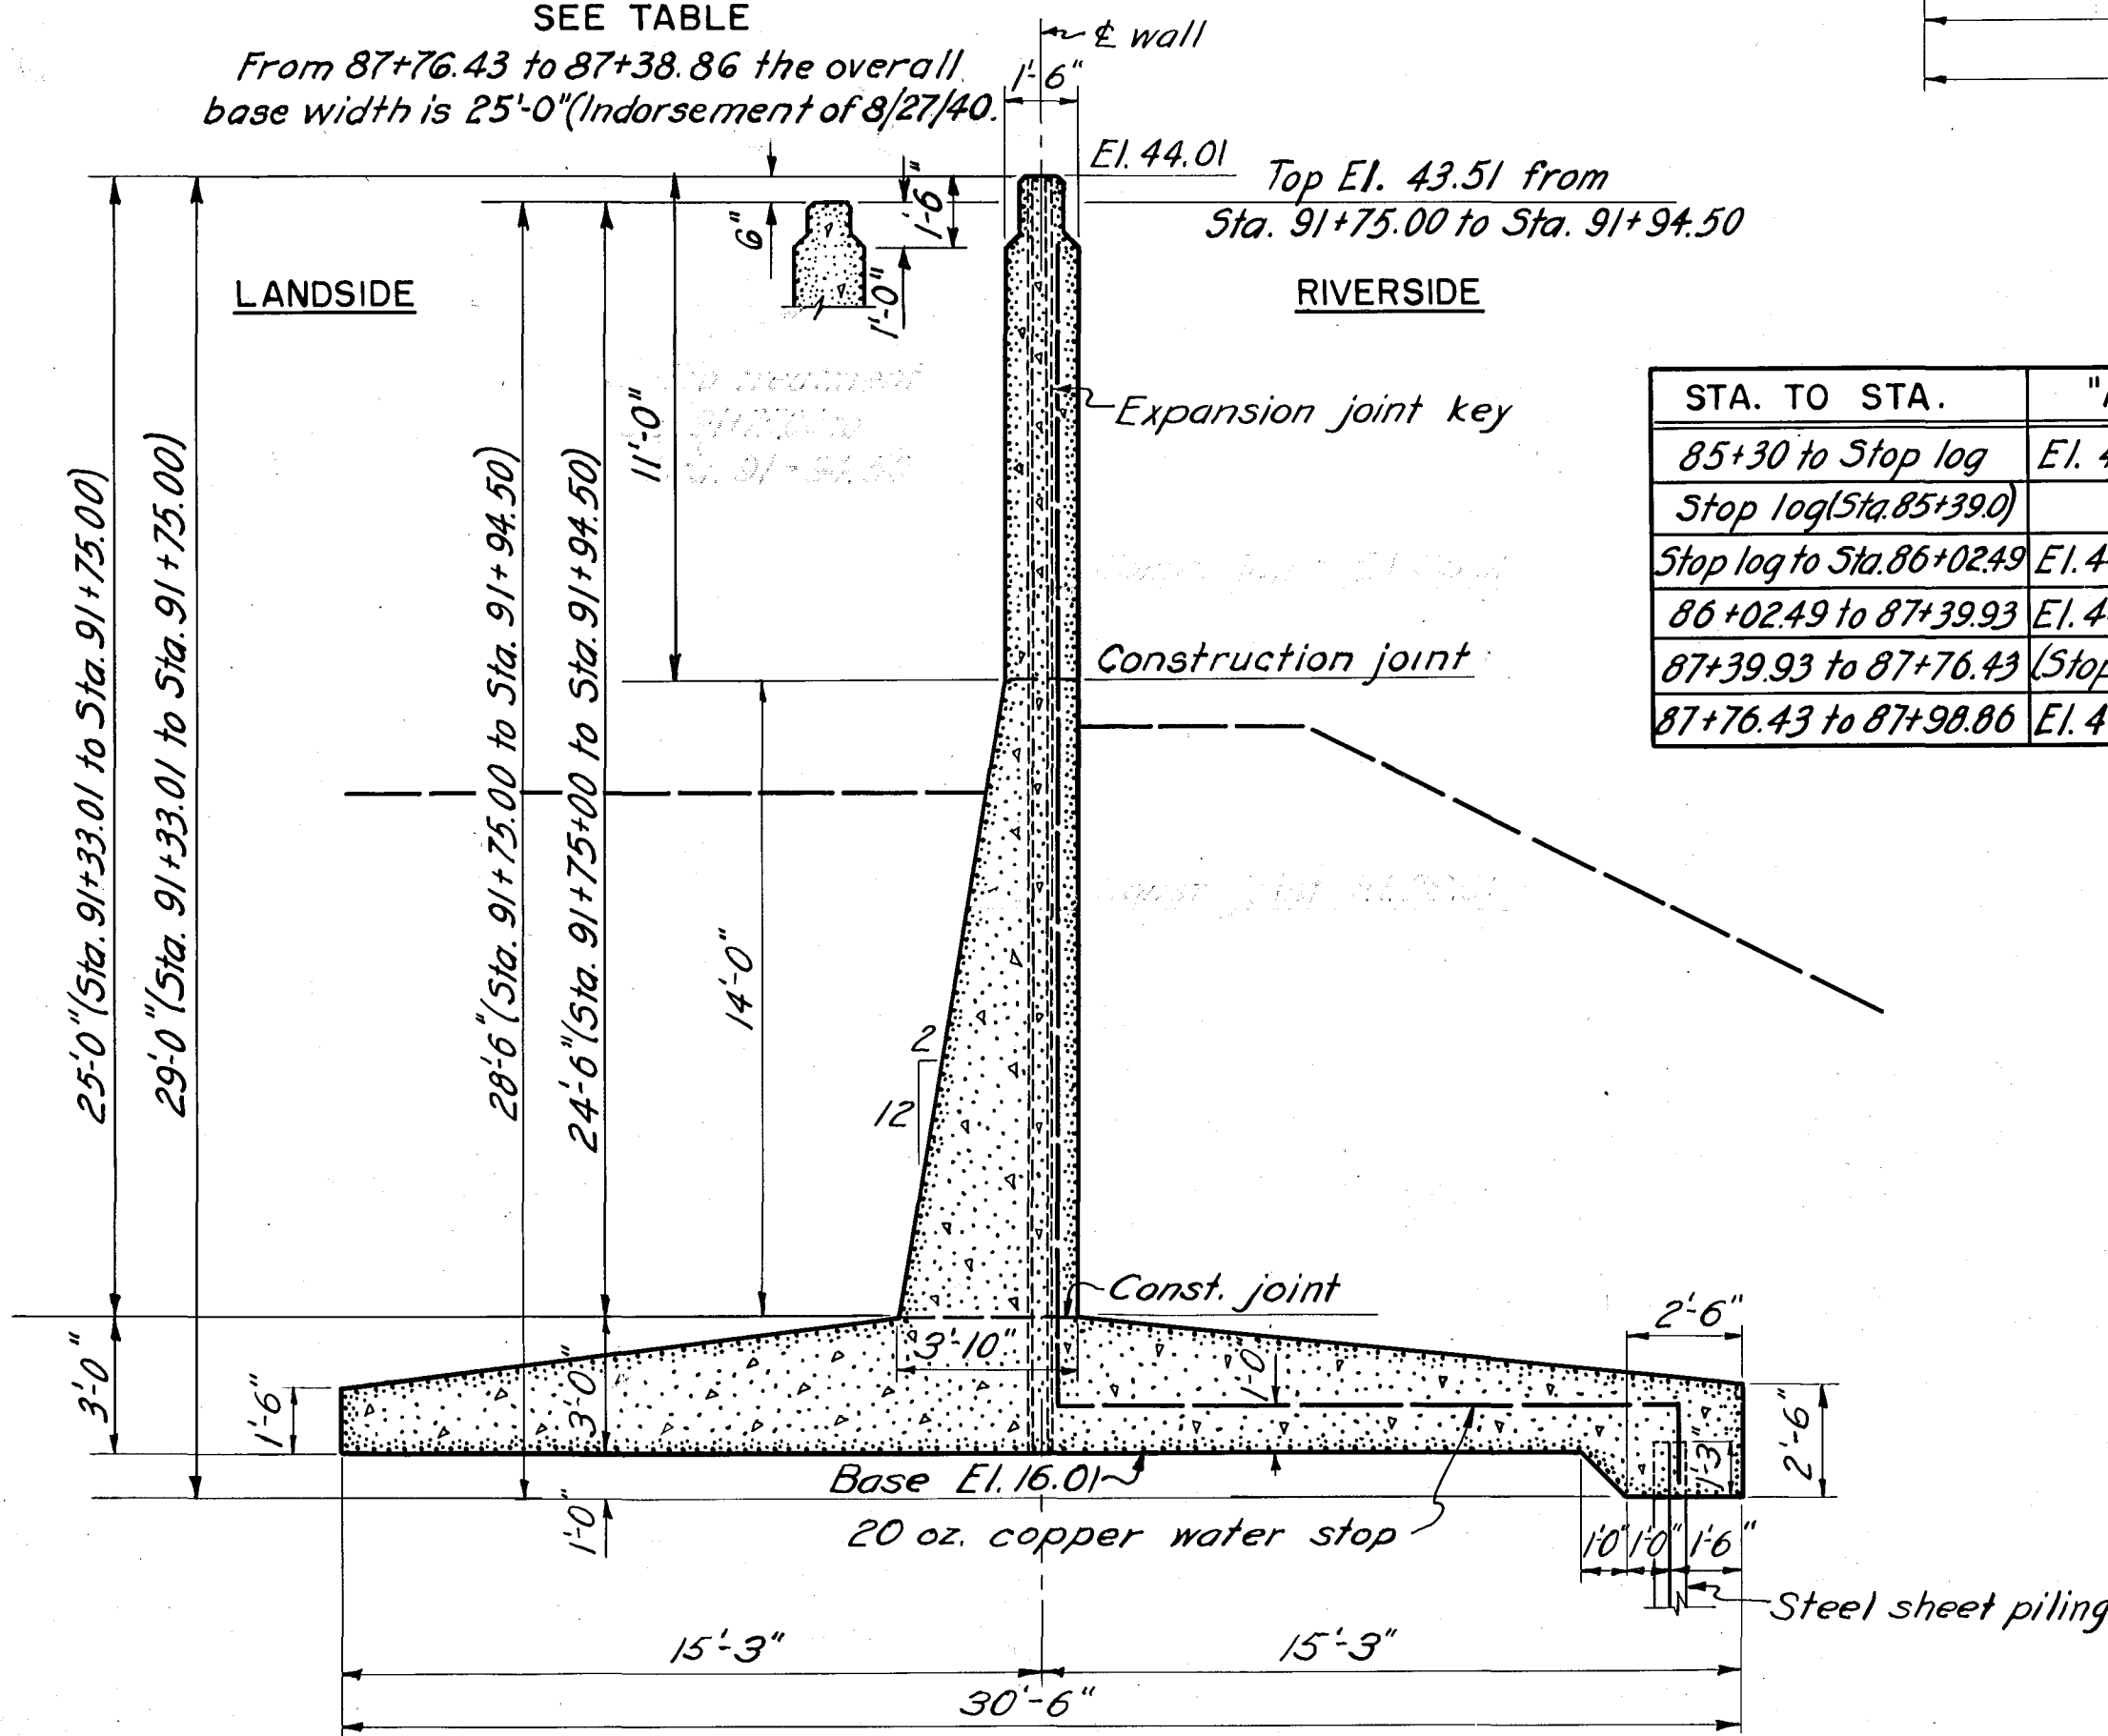

25'-0" WALL SECTION

STA. 91+33.01 TO STA. 91+94.50

NOTES

For general notes applying to this sheet see Sheet No. 20.
For steel reinforcing details see Sheet No. 112, 115 & 124.
For architectural details see Sheet No. 76.
For wall details at dike-wall connections see Sheets No. 59 & 63.

CONNECTICUT RIVER FLOOD CONTROL			
HARTFORD DIKE			
RIVERFRONT, MORGAN ST. TO STA. 96+73			
CONCRETE WALL SECTIONS NO. 5			
CONNECTICUT RIVER		CONNECTICUT	
IN 135 SHEETS		SCALE: 1/4 IN. = 1 FT.	
SHEET NO. 74			
U.S. ENGINEER OFFICE, PROVIDENCE, R.I., MAY 1940			
SUBMITTED: <i>W. B. Shaw</i>		APPROVED: <i>W. B. Shaw</i>	
DESIGNED: <i>W. B. Shaw</i>		CHECKED: <i>W. B. Shaw</i>	
DRAWN: <i>W. B. Shaw</i>		FISCAL YEAR 1940	
FILE NO. CT-4-2534			