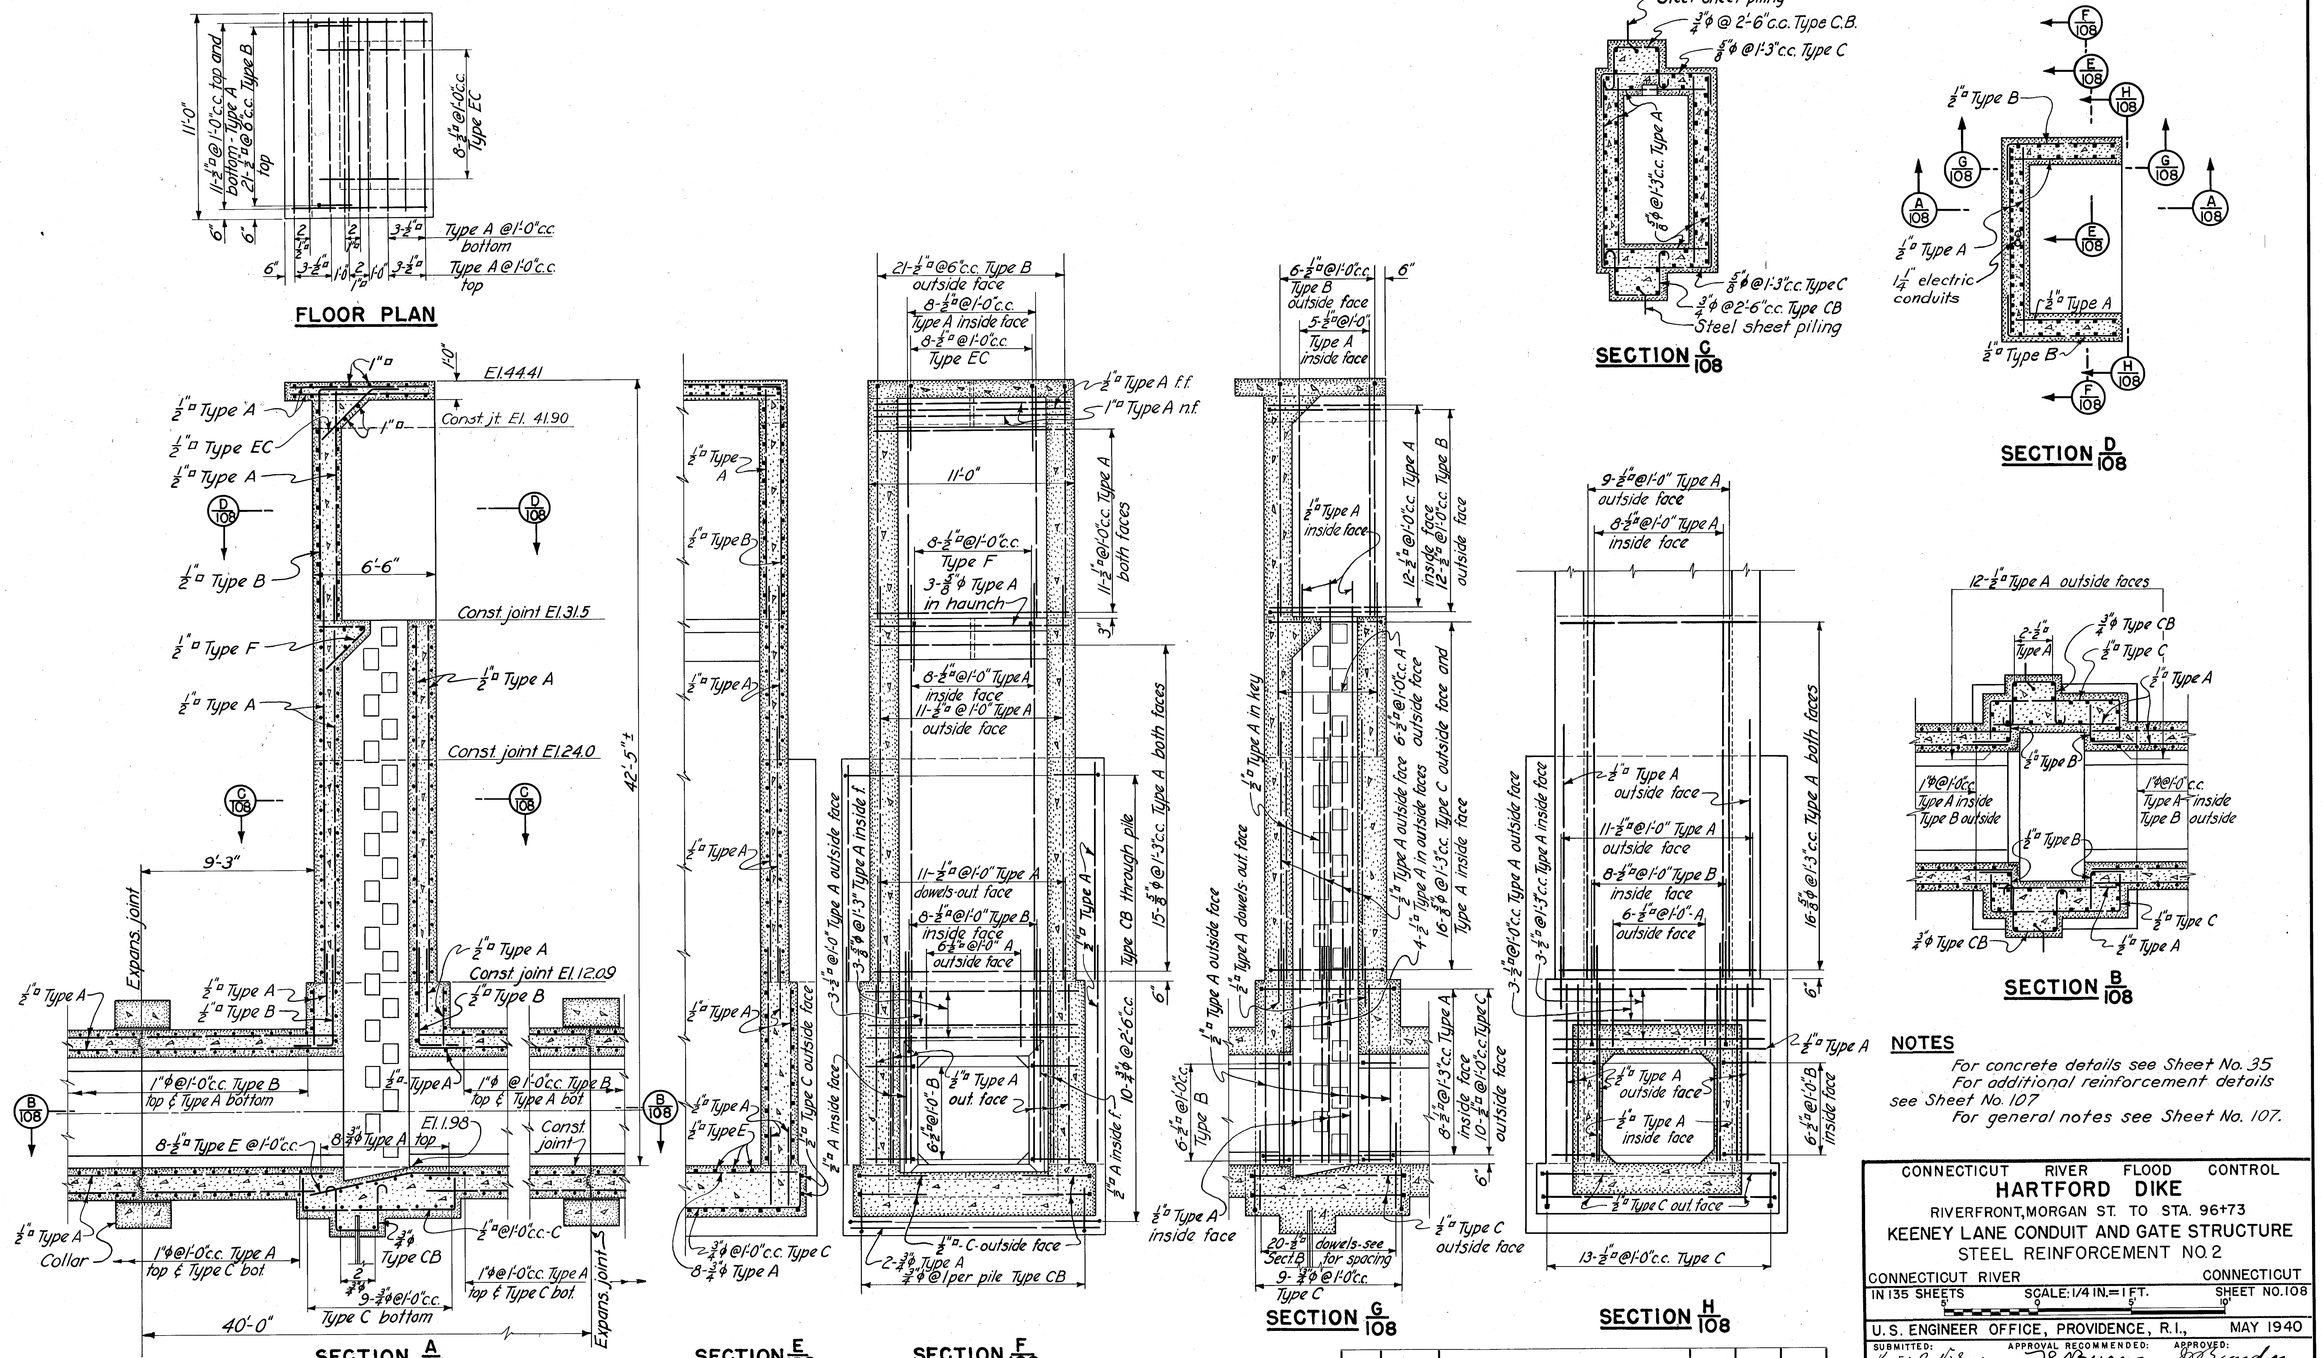

NOTES

For concrete details see Sheet No. 35
For additional reinforcement details see Sheet No. 107
For general notes see Sheet No. 107.

CONNECTICUT RIVER FLOOD CONTROL

HARTFORD DIKE

RIVERFRONT, MORGAN ST. TO STA. 96+73

KEENEY LANE CONDUIT AND GATE STRUCTURE

STEEL REINFORCEMENT NO. 2

CONNECTICUT RIVER — CONNECTICUT

IN 135 SHEETS — SCALE: 1/4 IN. = 1 FT. — SHEET NO. 108

U. S. ENGINEER OFFICE, PROVIDENCE, R.I., MAY 1940

SUBMITTED: Bruce B. Wilson, SENIOR ENGINEER, HEAD, DESIGN SECTION

APPROVAL RECOMMENDED: R. Burns, PRINCIPAL ENGINEER, CHIEF, F.C. ENGINEERING DIV.

APPROVED: Wm. Sanders, LT. COL., CORPS OF ENGINEERS, DISTRICT ENGINEER

DESIGNED: J. C. Sincerwall, ASSOC. ENGINEER

DRAWN: J.H.L.
TRACED: J.H.L.
CHECKED: RJM

FISCAL YEAR 1940

FILE NO. CT-4-2568

KEY	DATE	REVISION (Indicated by Δ)	REV. BY	CK. BY	AP. BY
	12-31-45	As built revisions			

Ht. 5 & 7b

108

11-15-4

PRINTED ON "ARKWRIGHT" TRACING CLOTH K & E CO., N.Y.