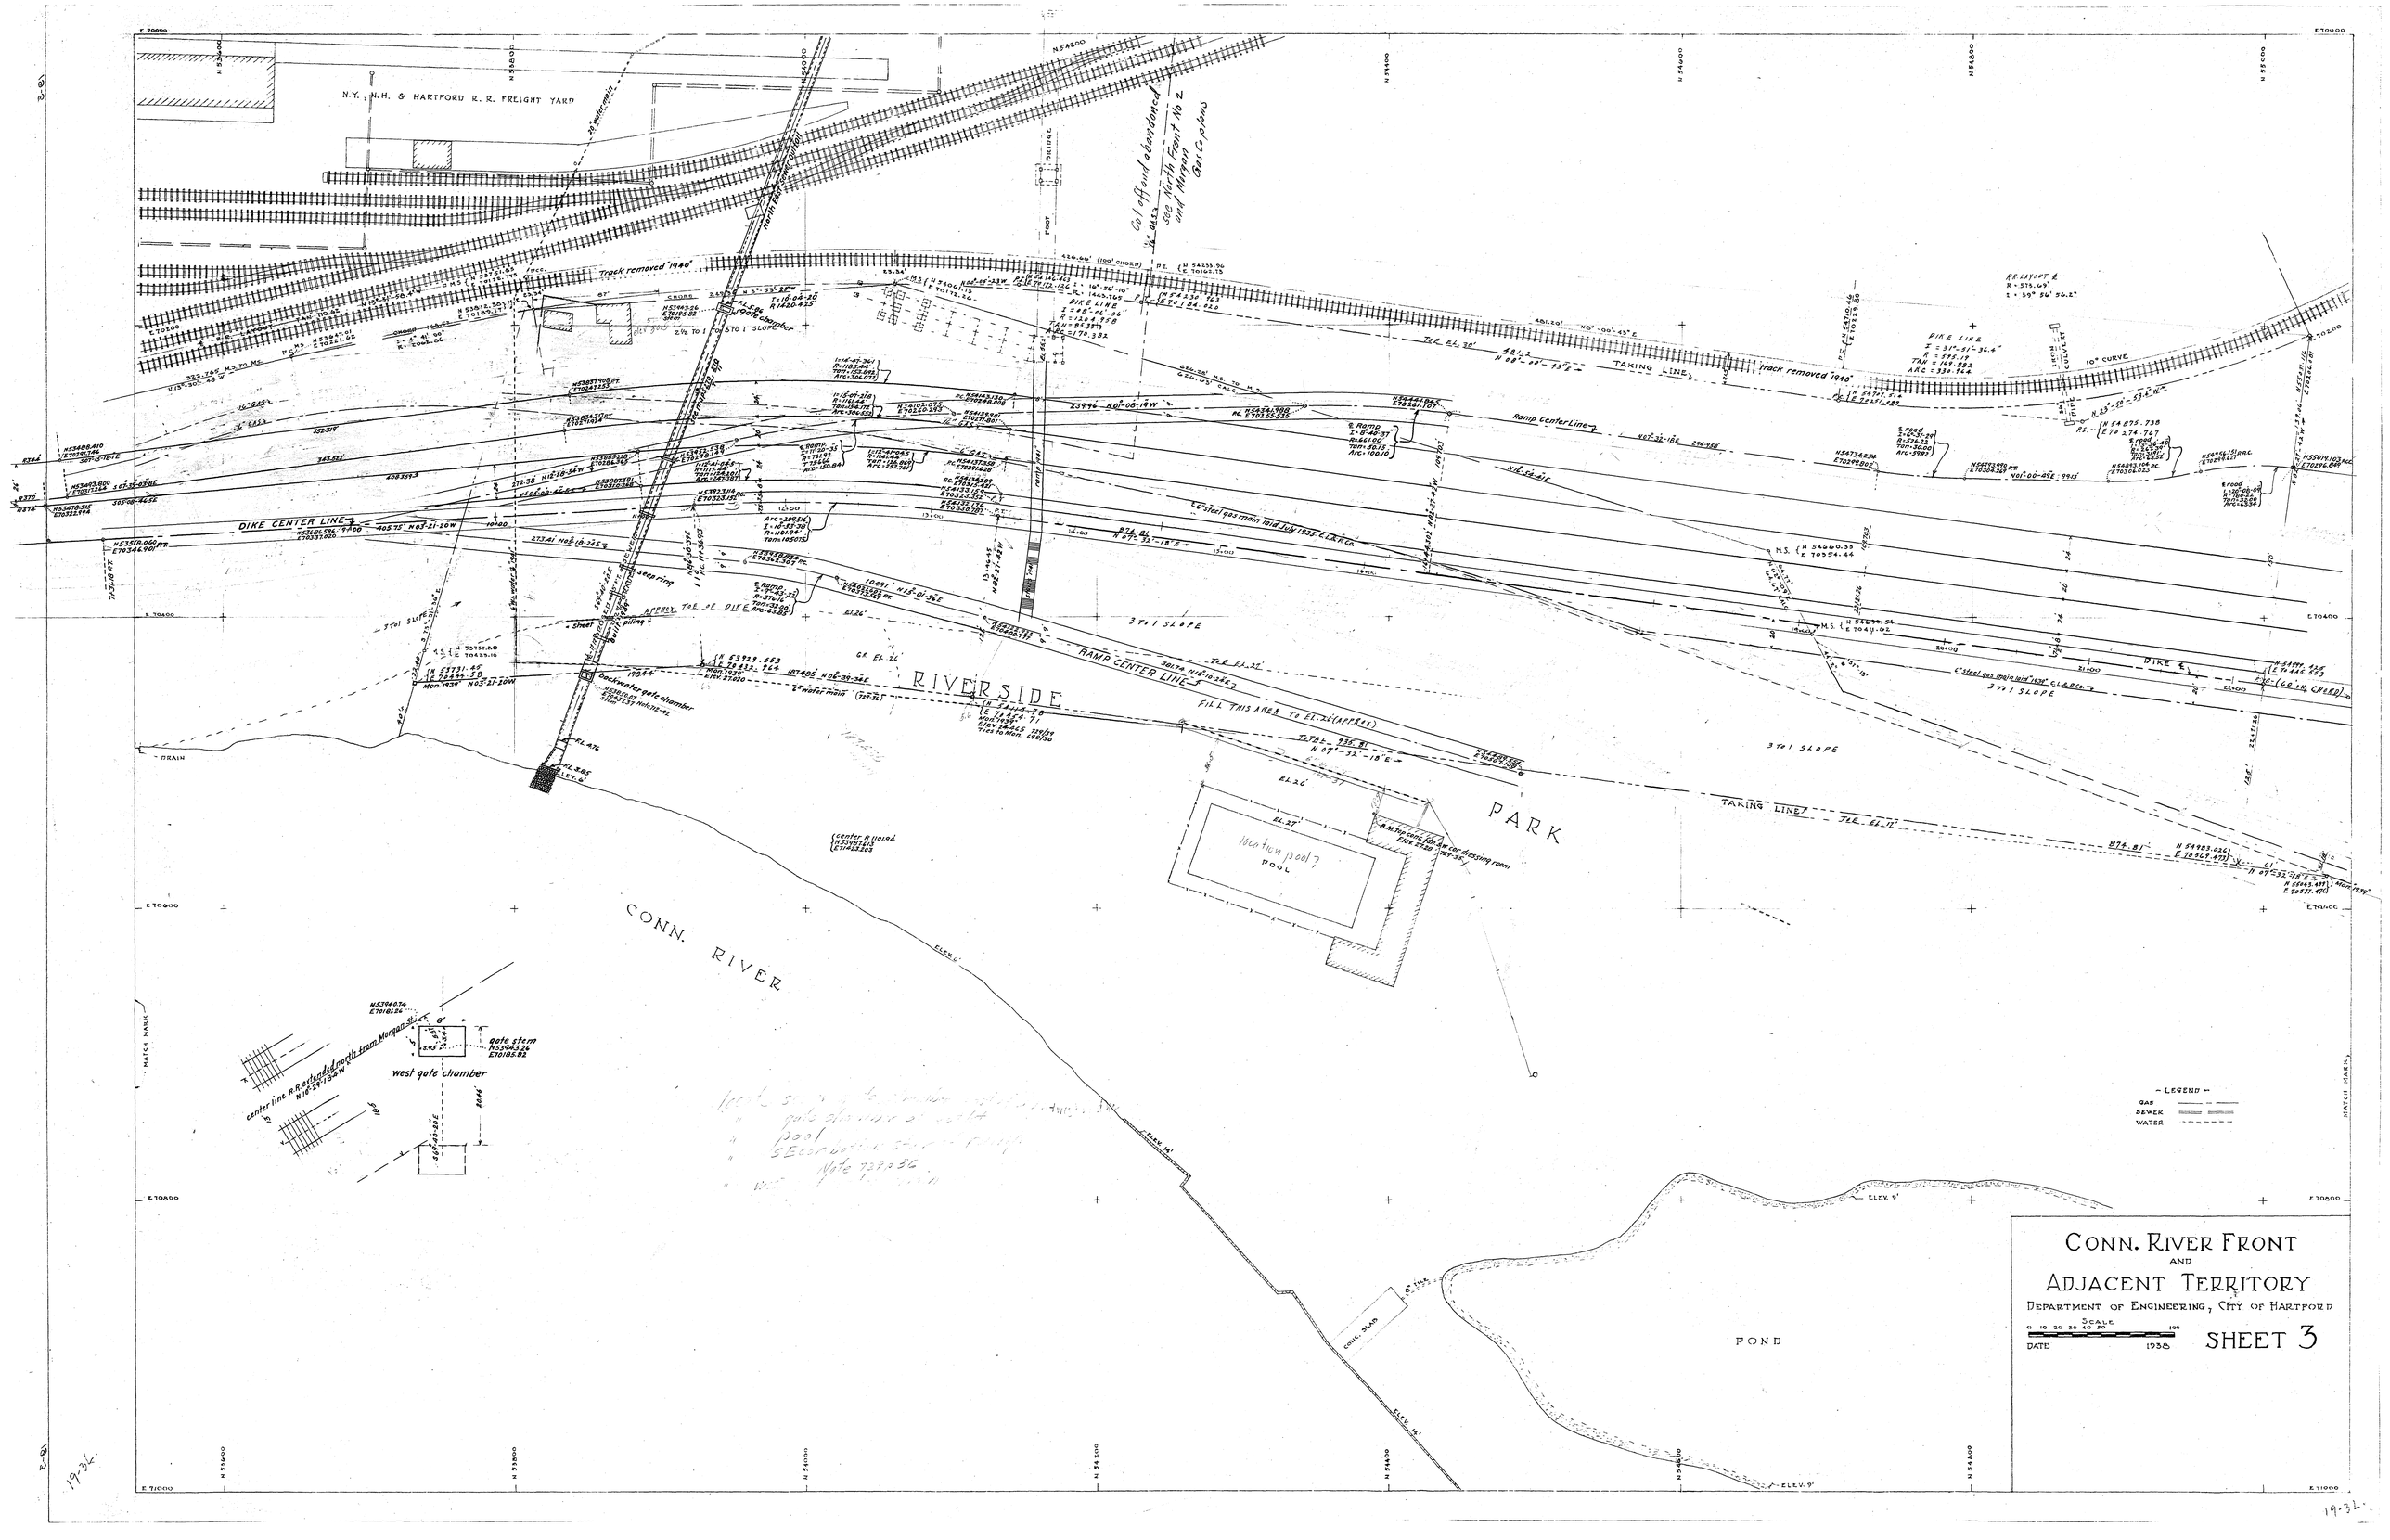
N.Y., N.H. & HARTFORD R.R. FREIGHT YARD
Track removed 1940
TAKING LINE
DIKE CENTER LINE
RAMP CENTER LINE
RIVERSIDE
PARK
CONN. RIVER
POOL
POND
DIKE
3 to 1 SLOPE
FILL THIS AREA TO EL. 26 (APPROX)
backwater gate chamber
west gate chamber
center line R.R. extended north from Morgan St.
gate structure
LEGEND
GAS
SEWER
WATER
CONN. RIVER FRONT
AND
ADJACENT TERRITORY
DEPARTMENT OF ENGINEERING, CITY OF HARTFORD
SCALE
DATE 1938
SHEET 3