


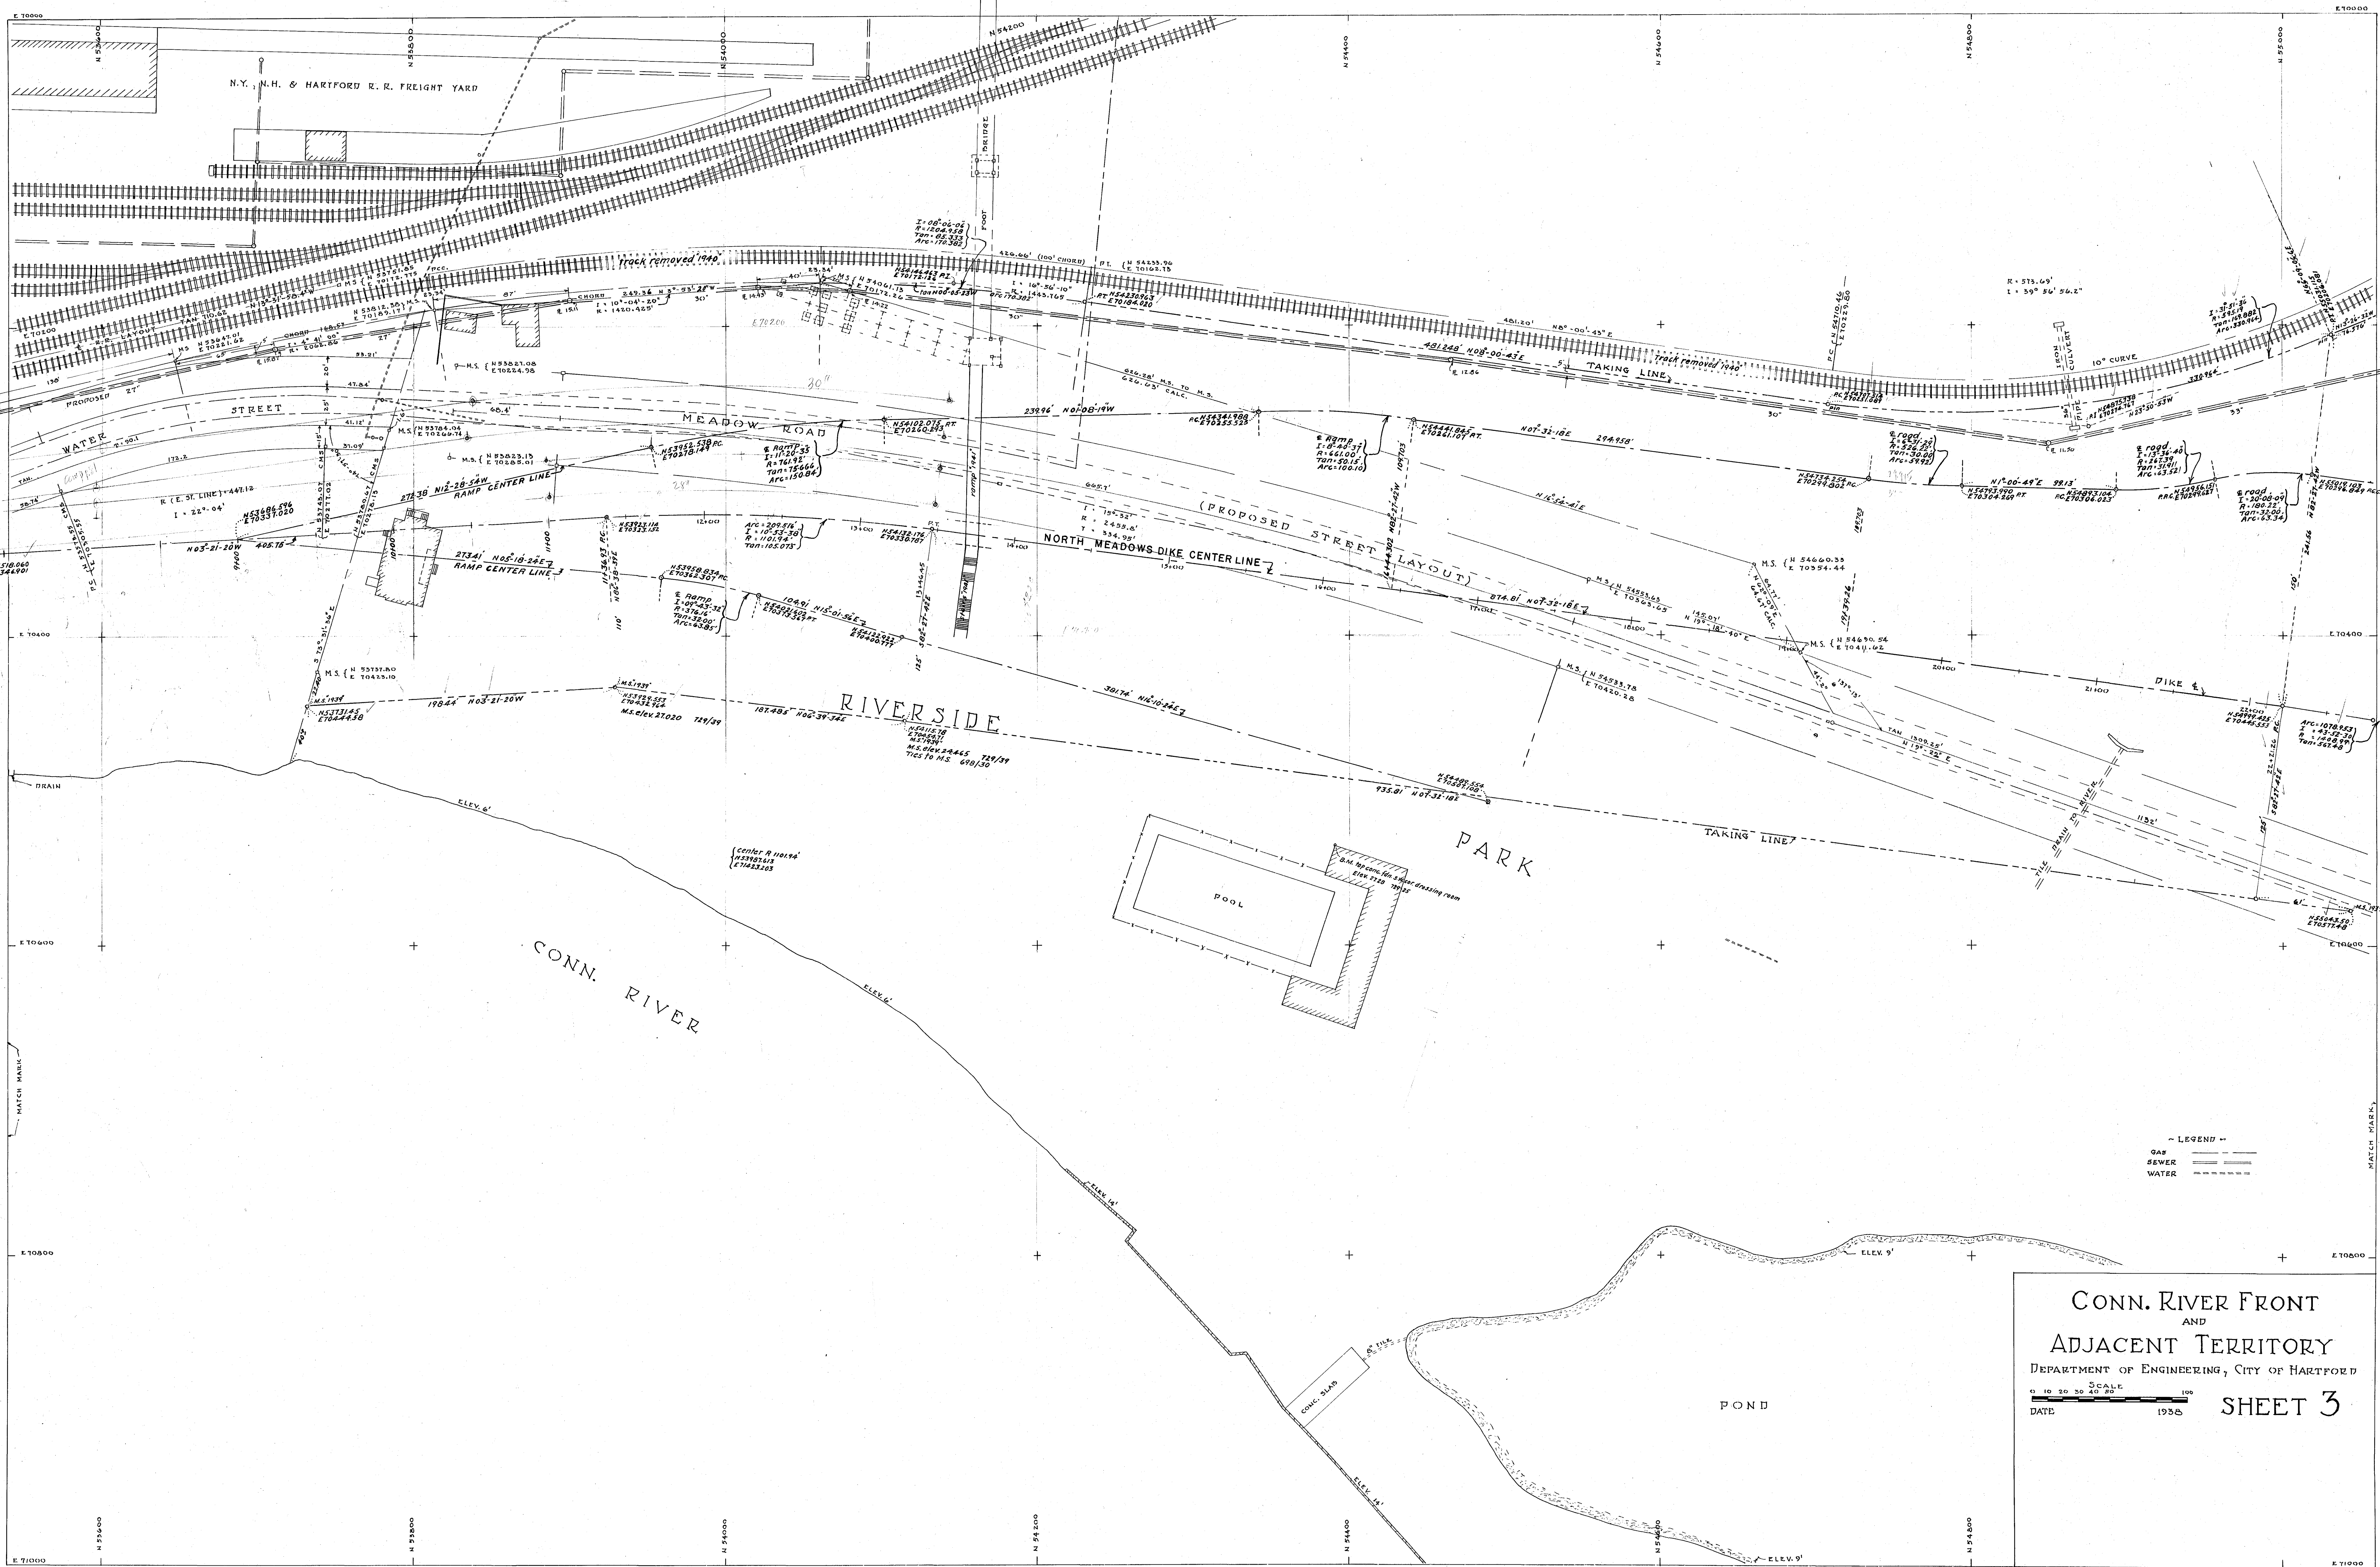

CONN. RIVER FRONT
AND
ADJACENT TERRITORY
DEPARTMENT OF ENGINEERING, CITY OF HARTFORD

SCALE
0 10 20 30 40 50 100
DATE 1938

SHEET 3