


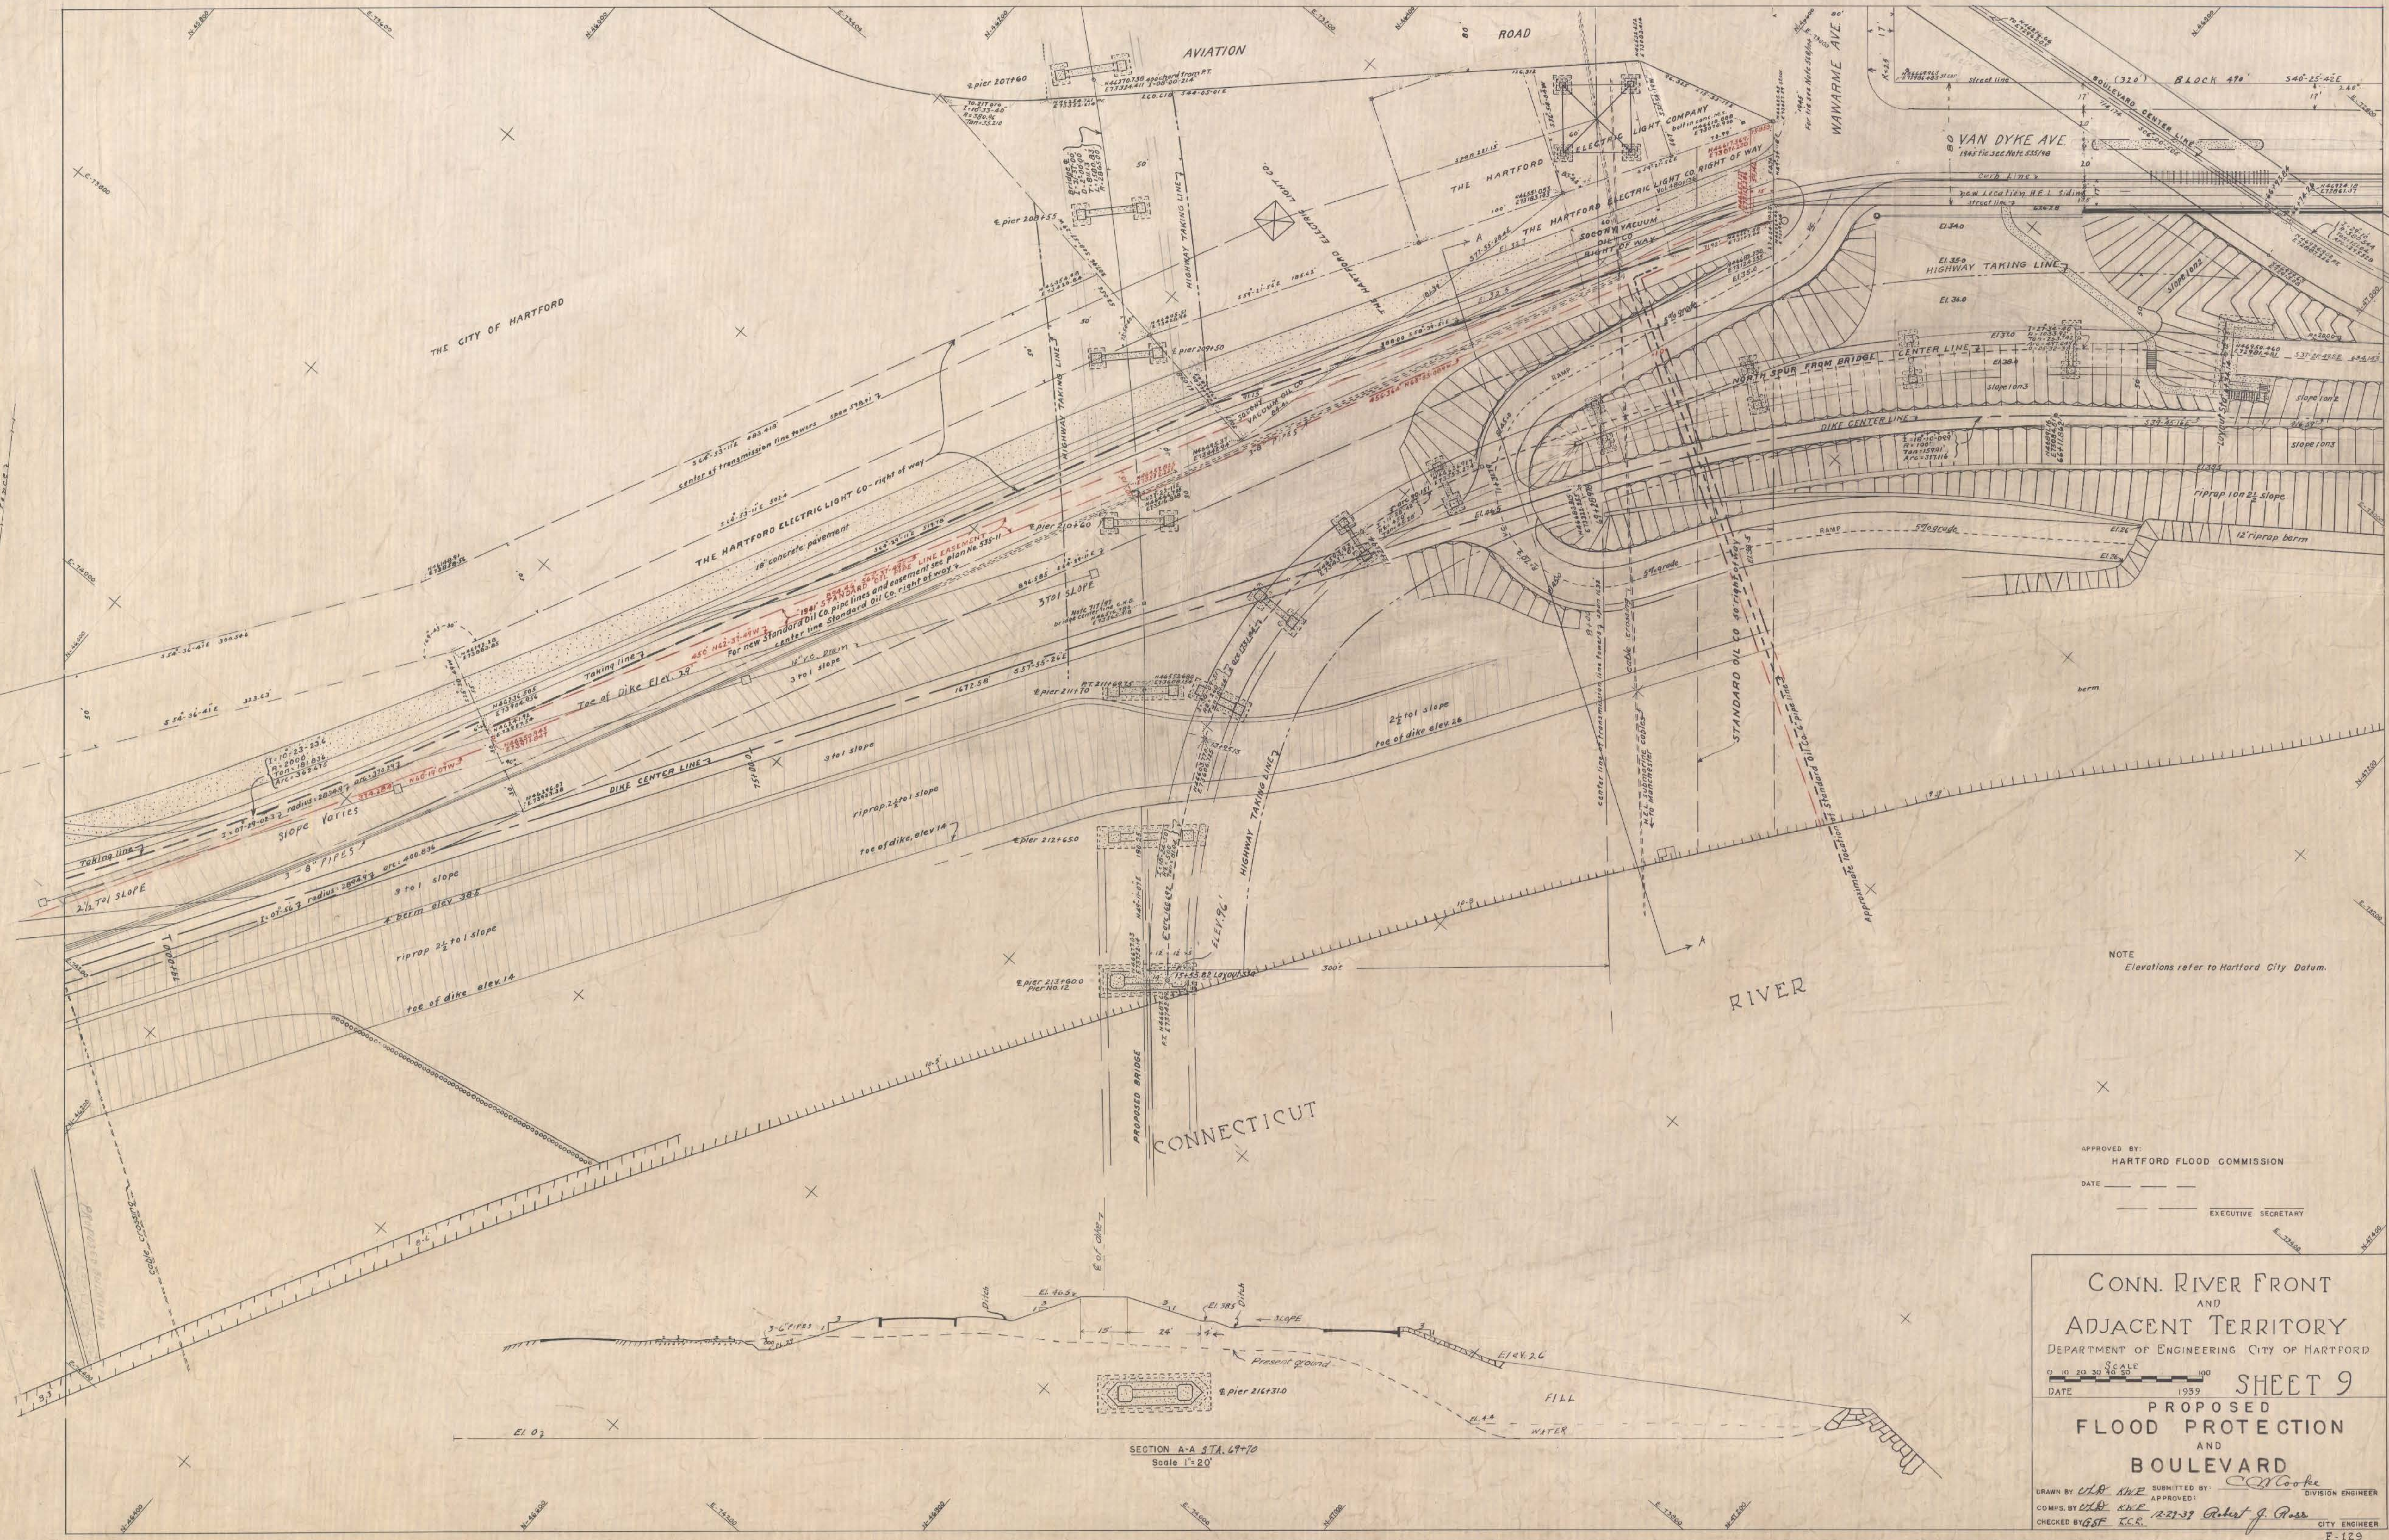

NOTE
Elevations refer to Hartford City Datum.

APPROVED BY:
HARTFORD FLOOD COMMISSION

DATE _____
EXECUTIVE SECRETARY _____

CONN. RIVER FRONT
AND
ADJACENT TERRITORY
DEPARTMENT OF ENGINEERING CITY OF HARTFORD

SCALE
0 10 20 30 40 50
DATE 1939

SHEET 9

PROPOSED
FLOOD PROTECTION
AND
BOULEVARD

DRAWN BY *W. H. R. R.* SUBMITTED BY *W. H. R. R.* DIVISION ENGINEER
COMPS. BY *W. H. R. R.* APPROVED: *Robert J. Ross* CITY ENGINEER
CHECKED BY *W. H. R. R.* 12-27-39

F-129