SARGEANT STREET
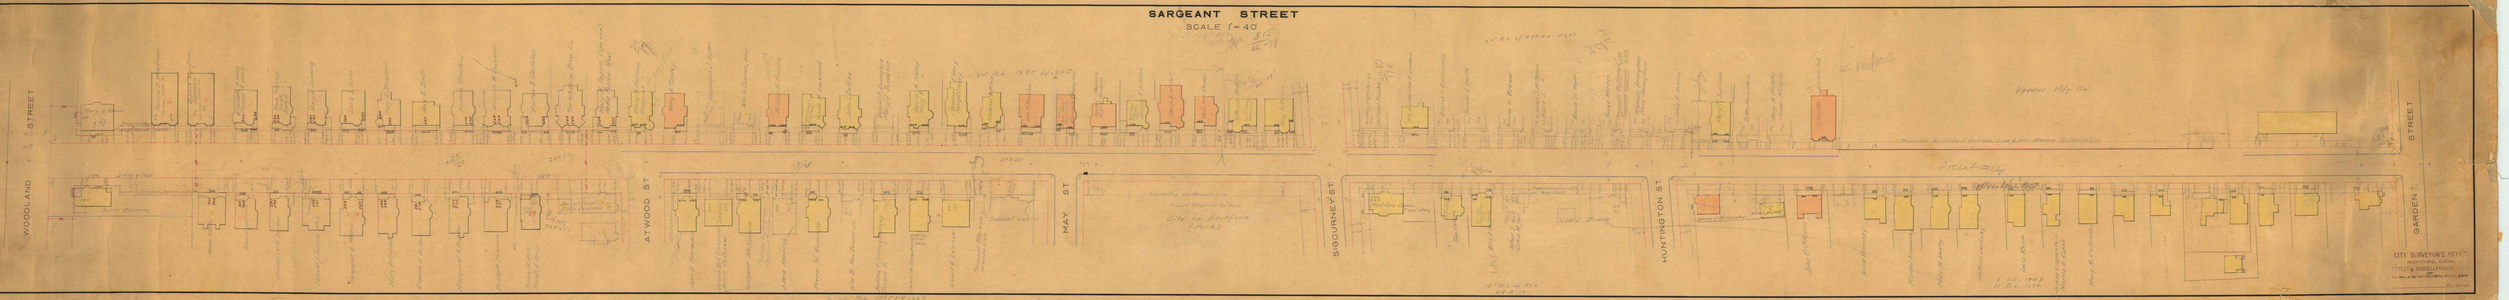
SCALE 1" = 40'