
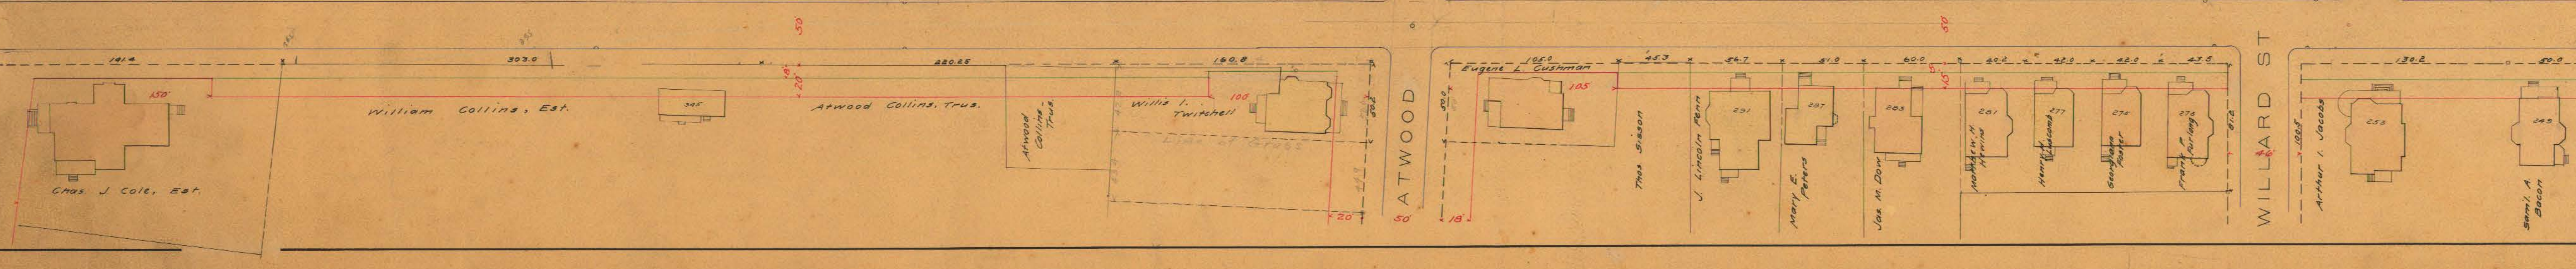


WOODLAND STREET



WILLARD ST

ATWOOD STREET

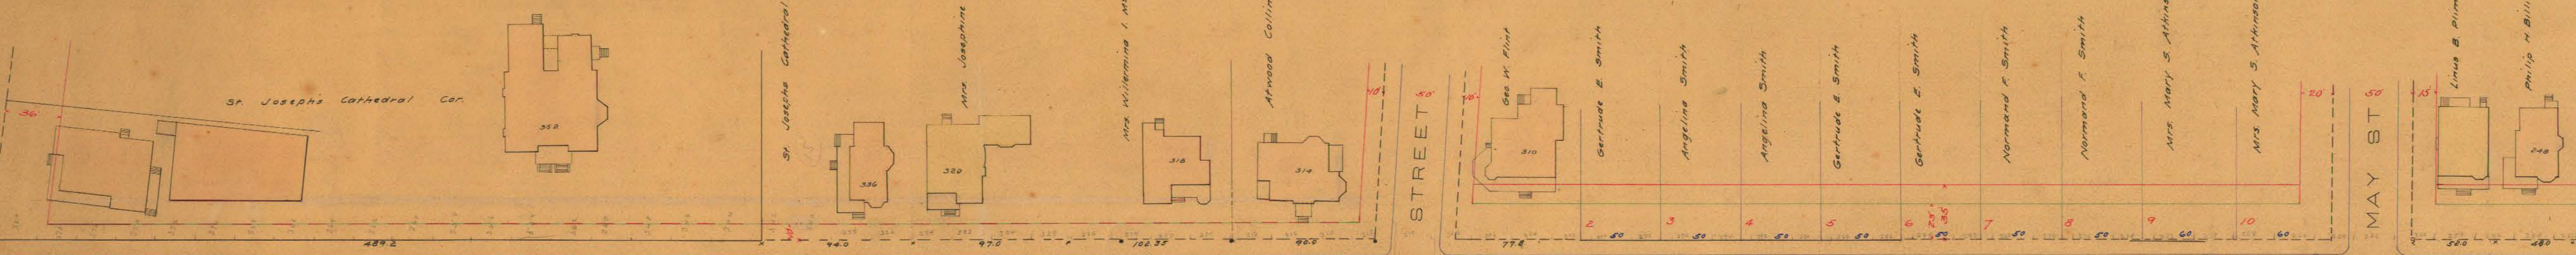



MAY ST

ATWOOD STREET

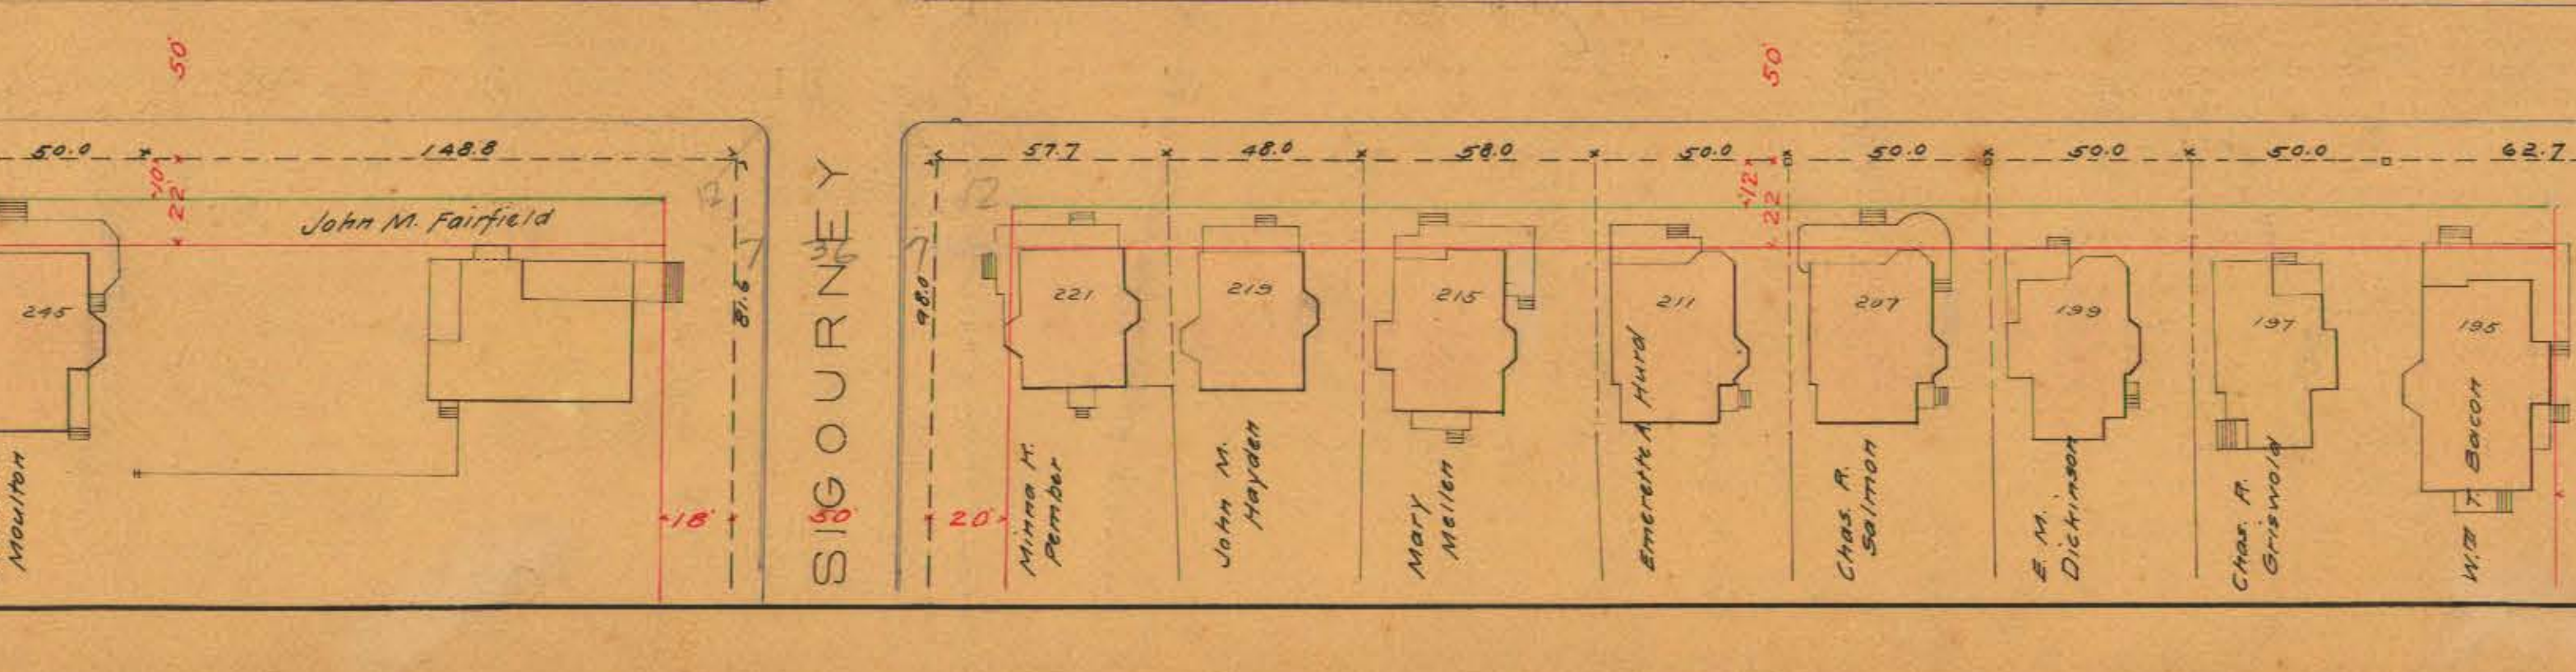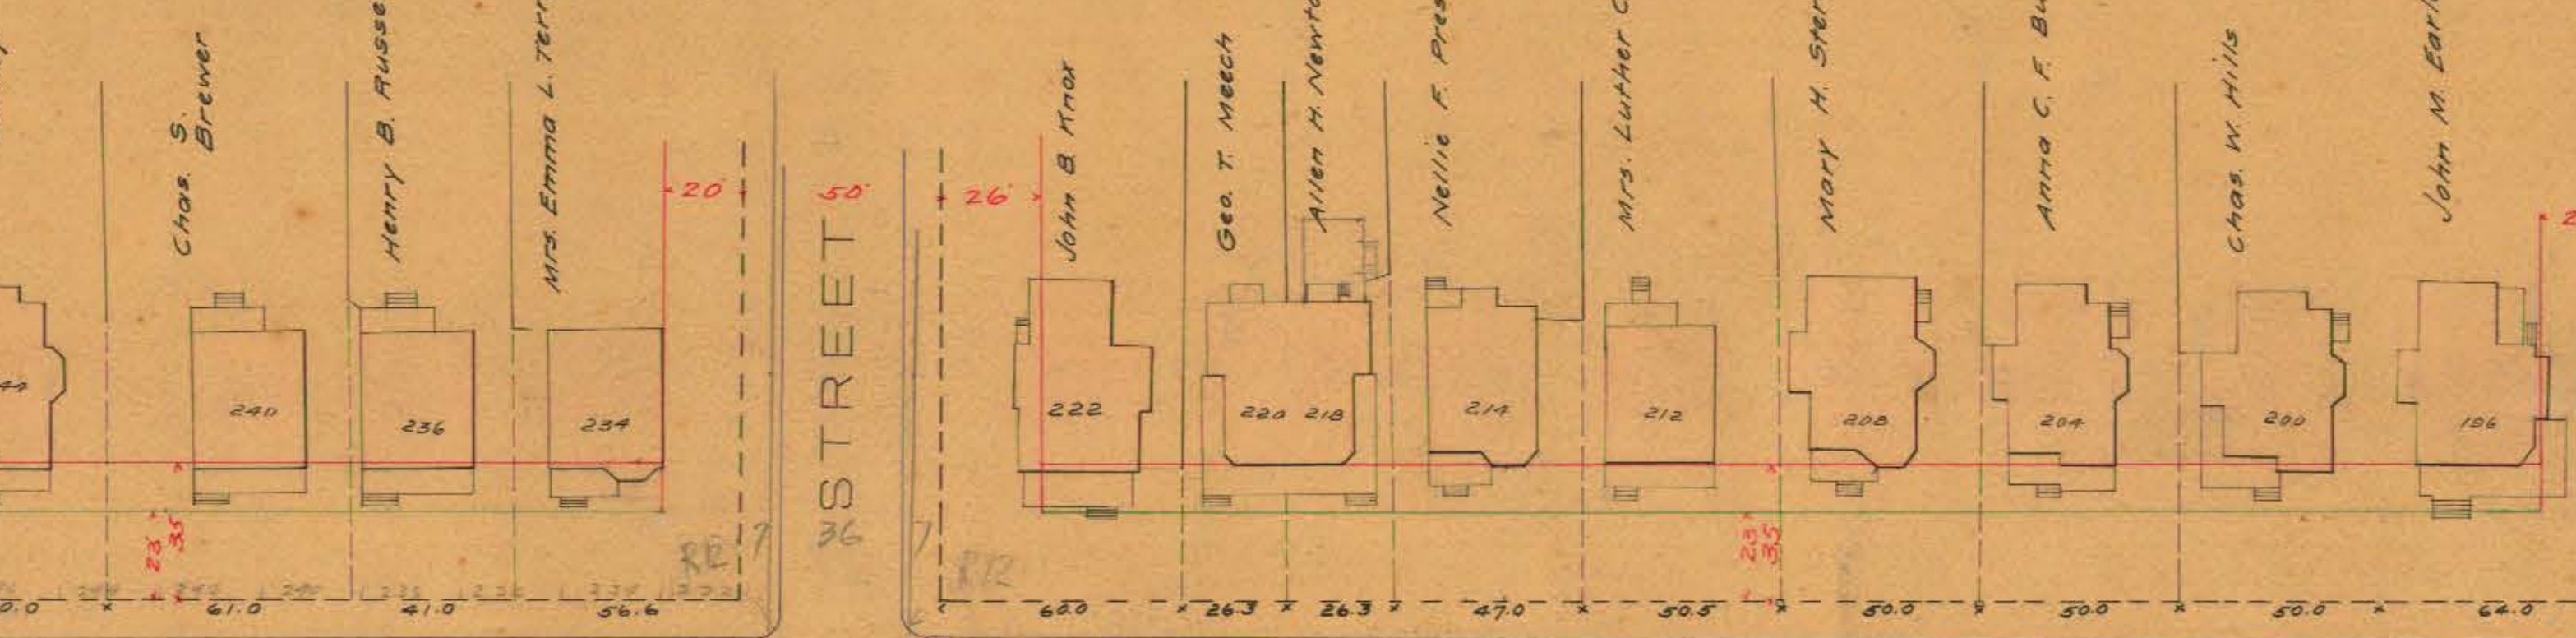



MAY ST

ATWOOD STREET

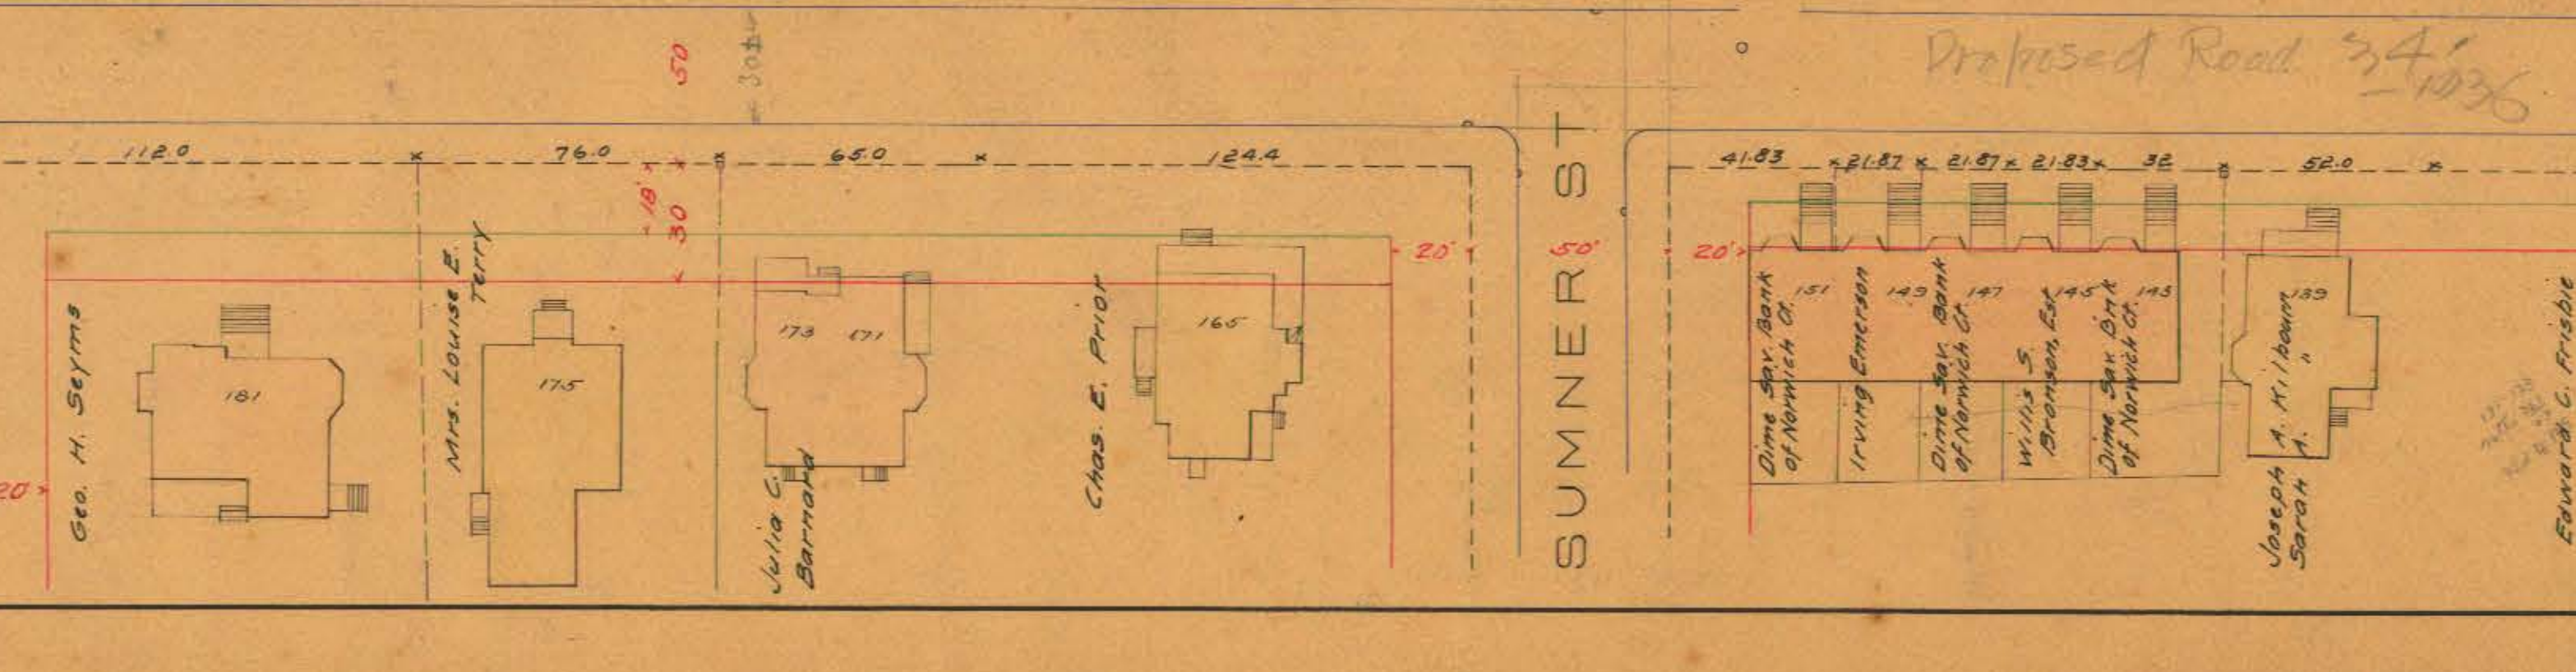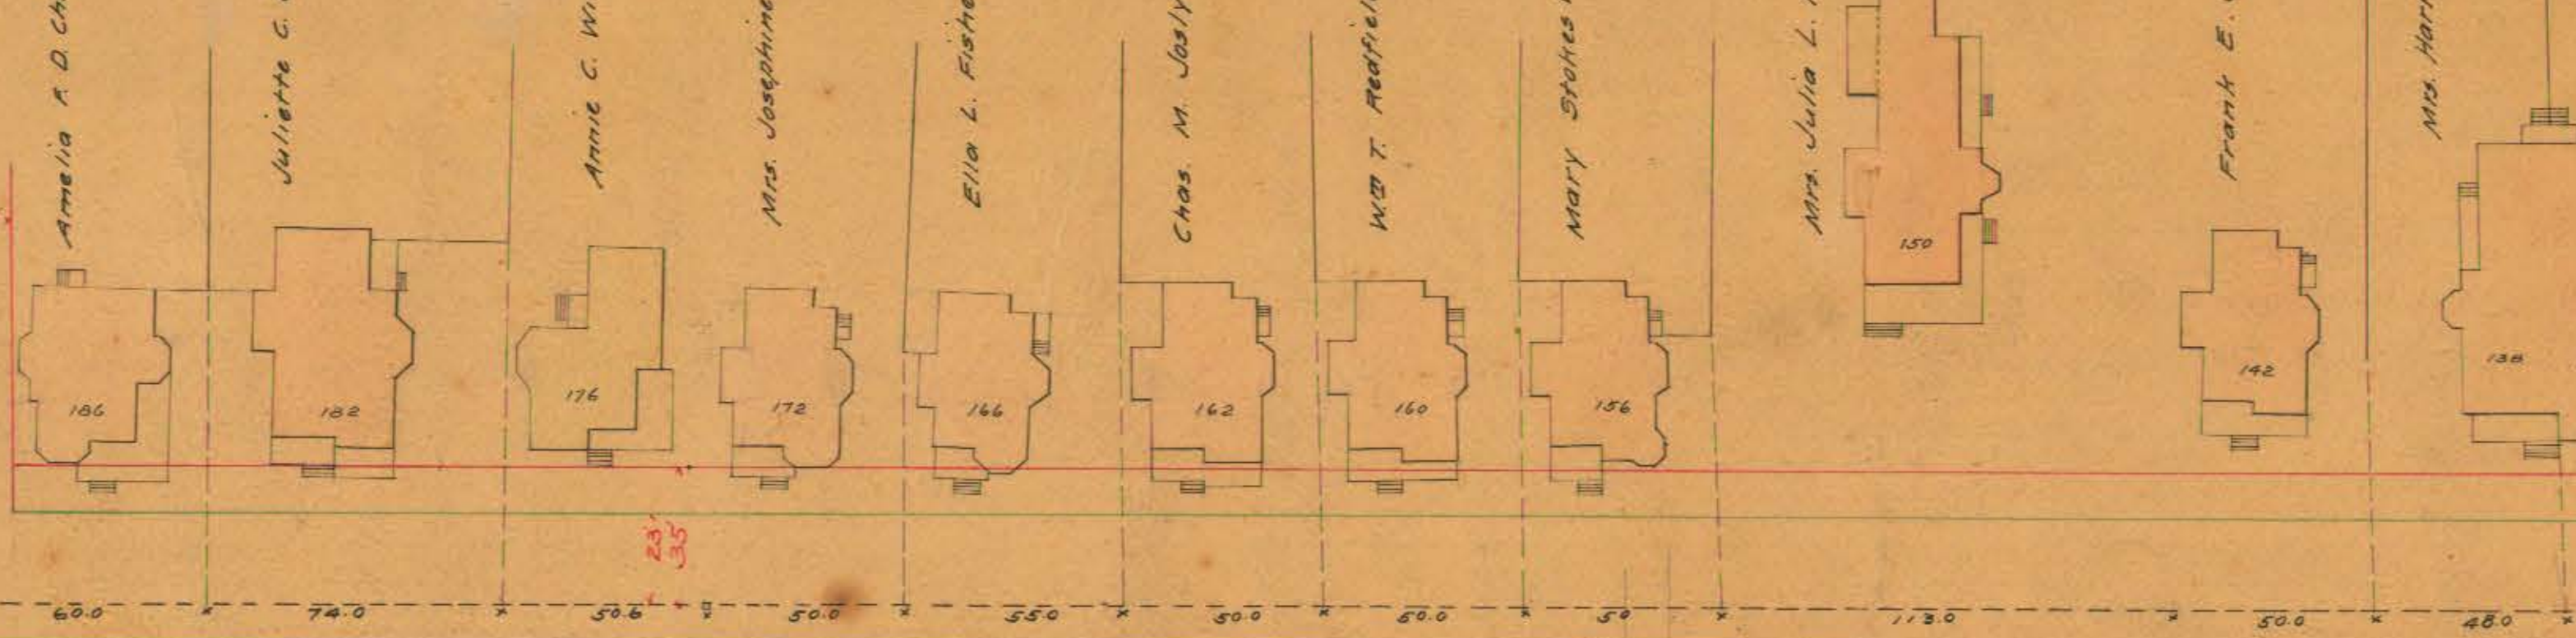

MAY ST

ATWOOD STREET

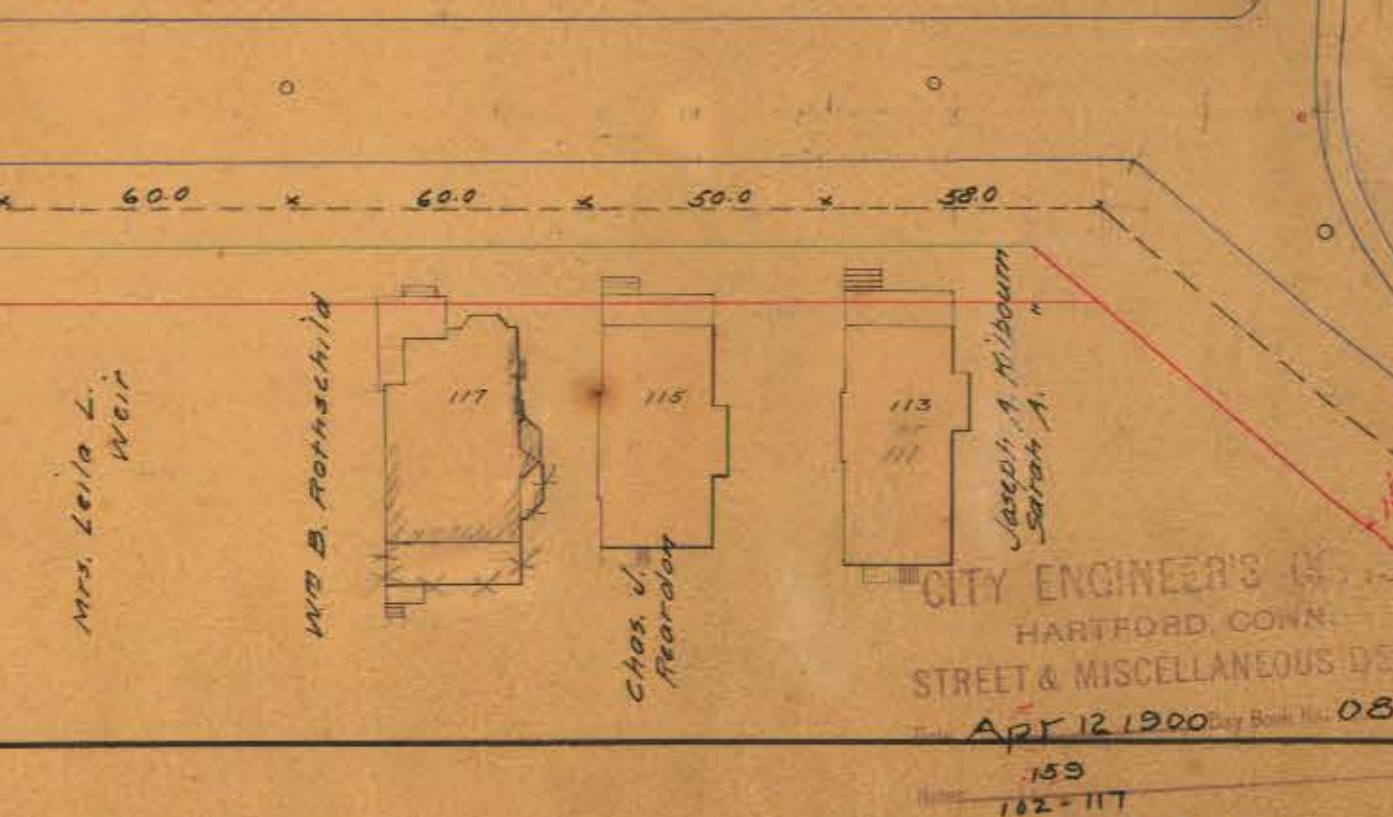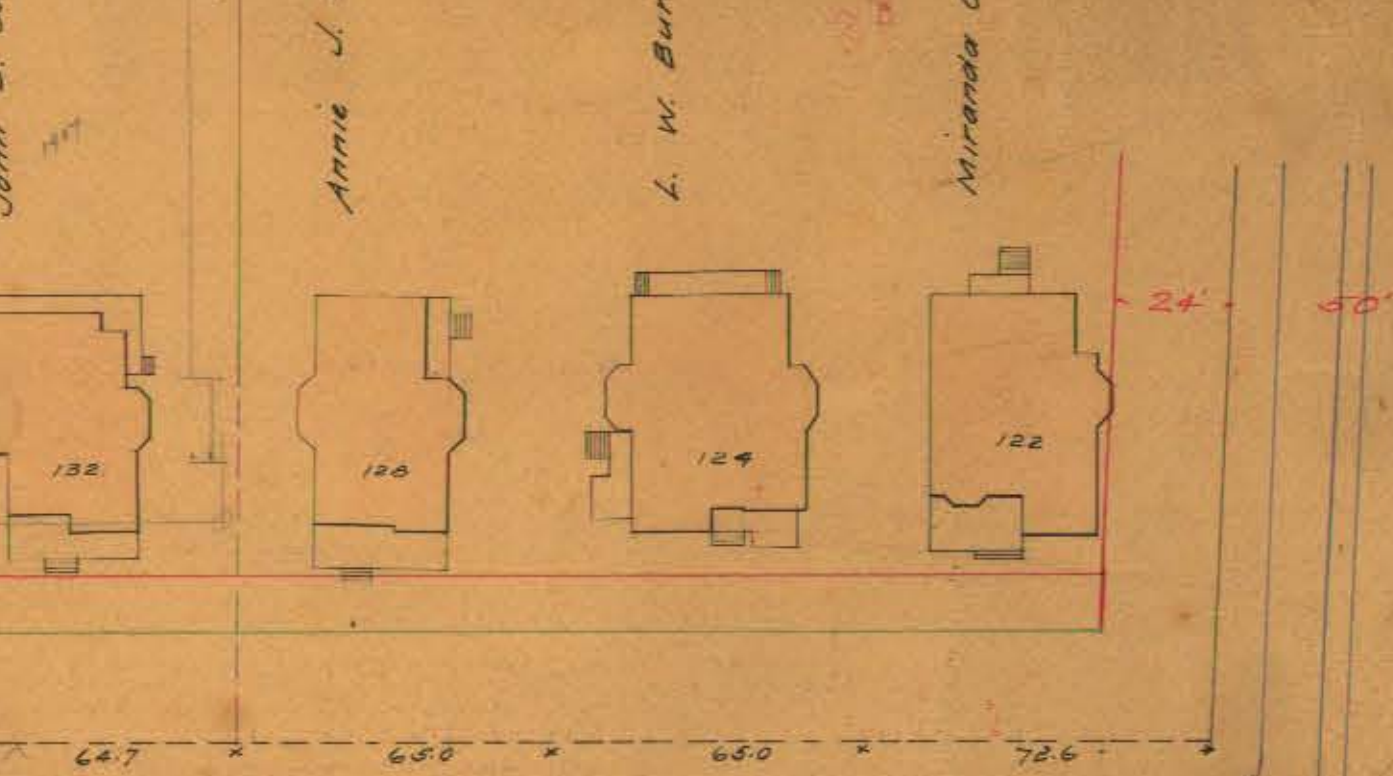

MAY ST

ATWOOD STREET