


Out of Service, April 12-1938

See Sheet 22

Out of Service April 12-1939

Out of Service, April 12-1939

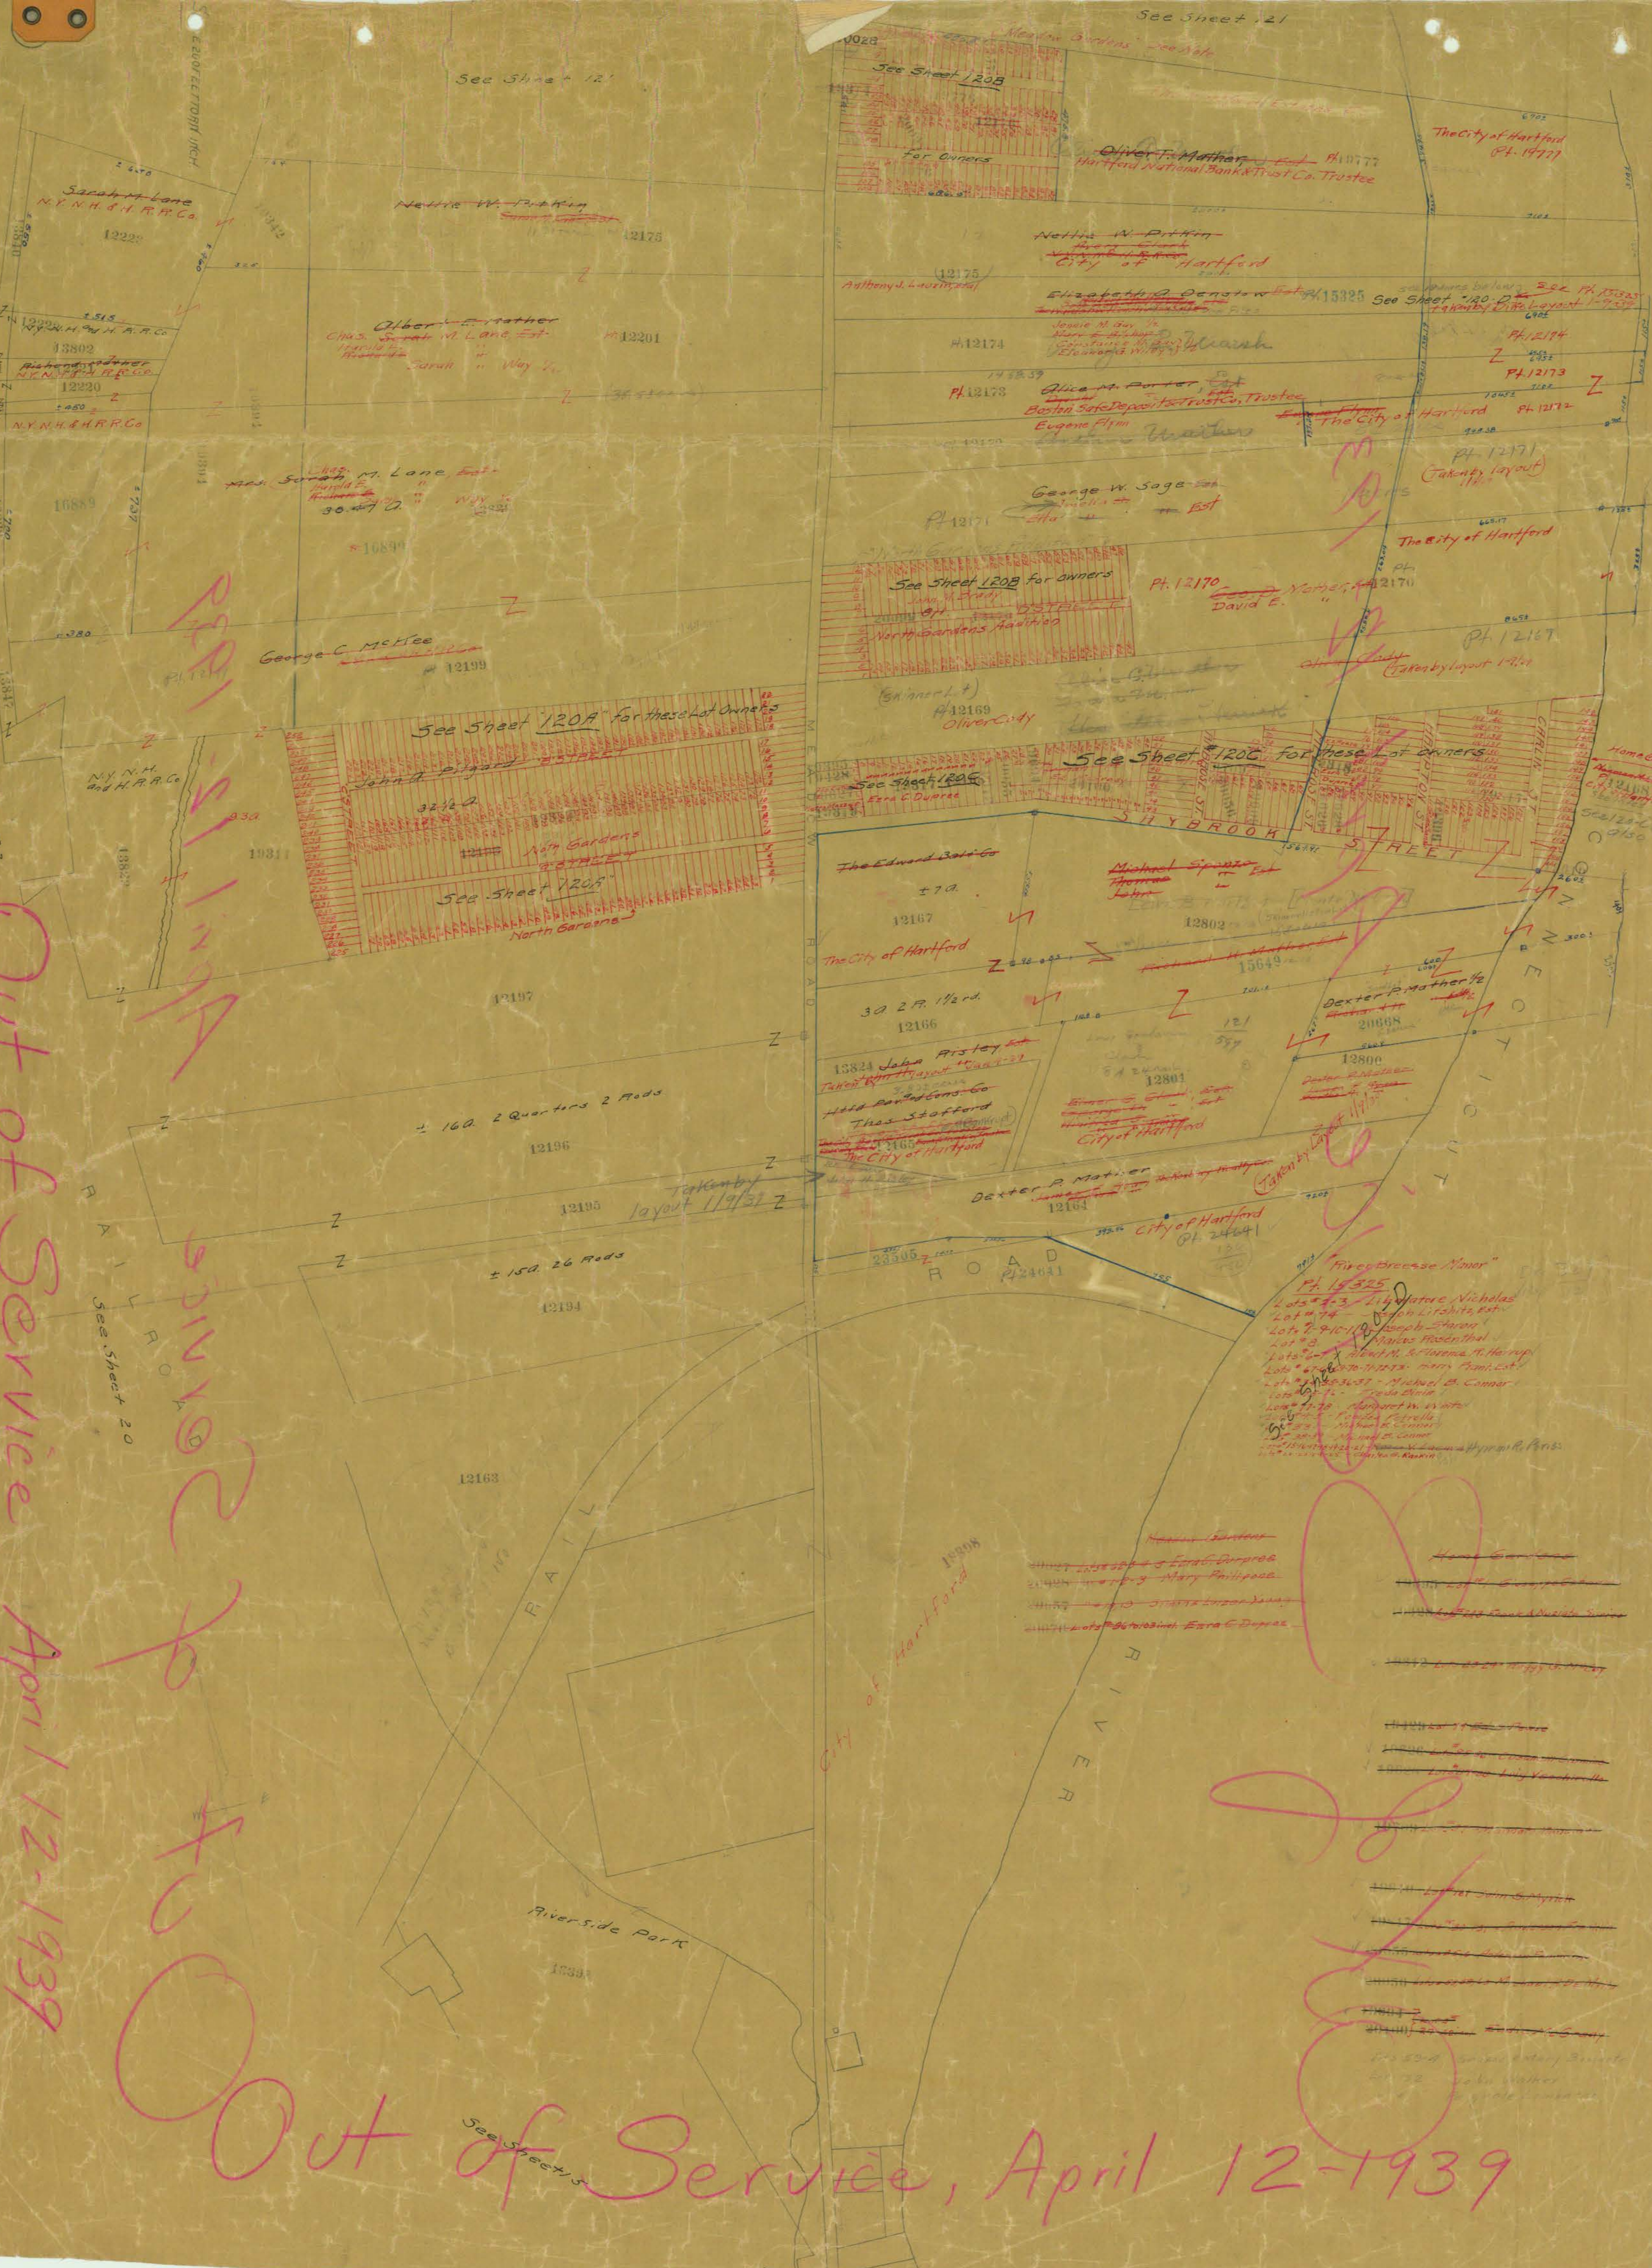

Out of Service, April 12-1938

See Sheet 22

Out of Service April 12-1939

Out of Service, April 12-1939