
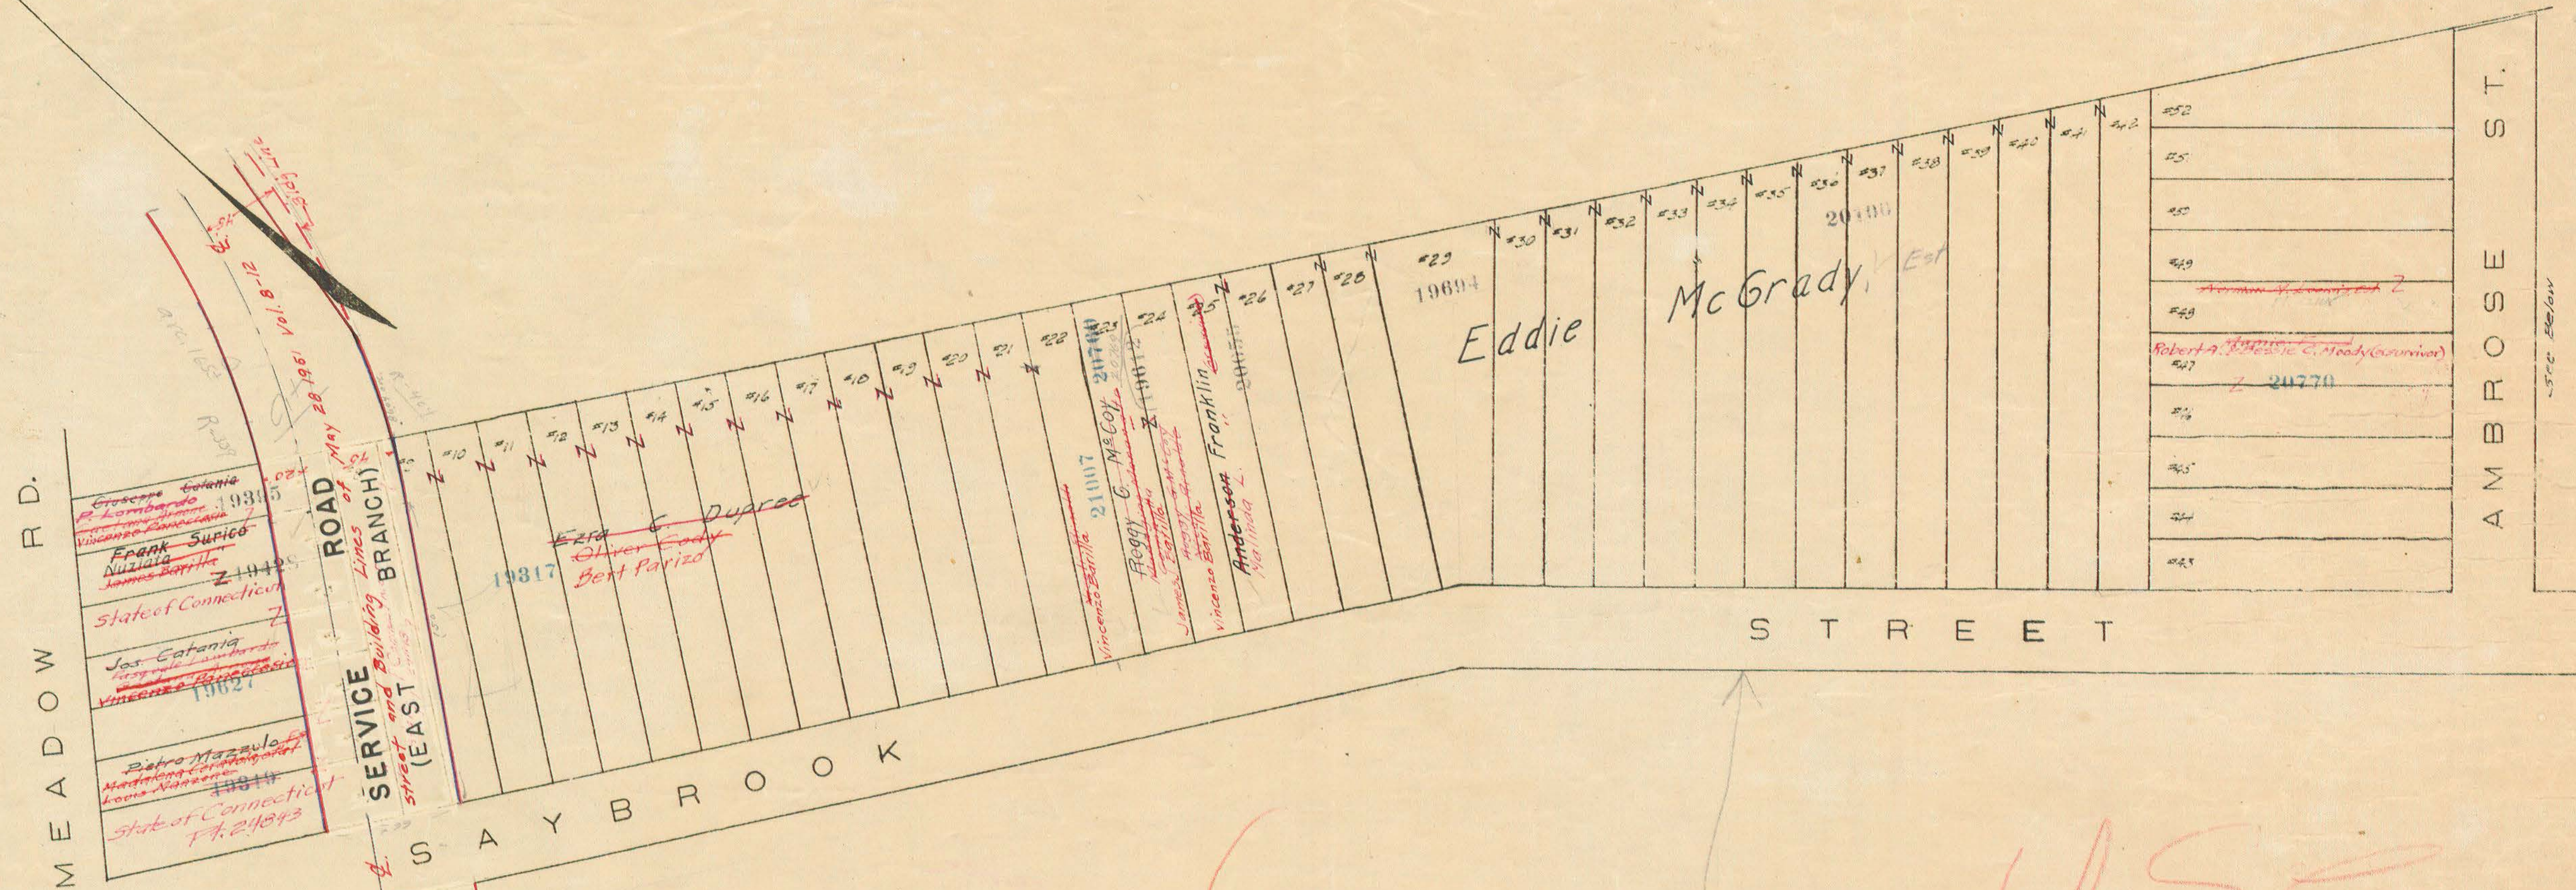


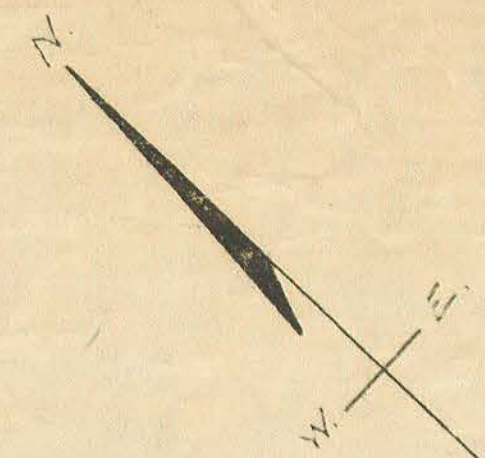


OUT 05-10-54

USE

All lots not otherwise marked are owned by Norman M. Loomis, Jr.
Formerly Pt. 12168
Adolph Loomis
Frank M. Nicolle

Assign file numbers as lots are sold.
(Part of 12168)

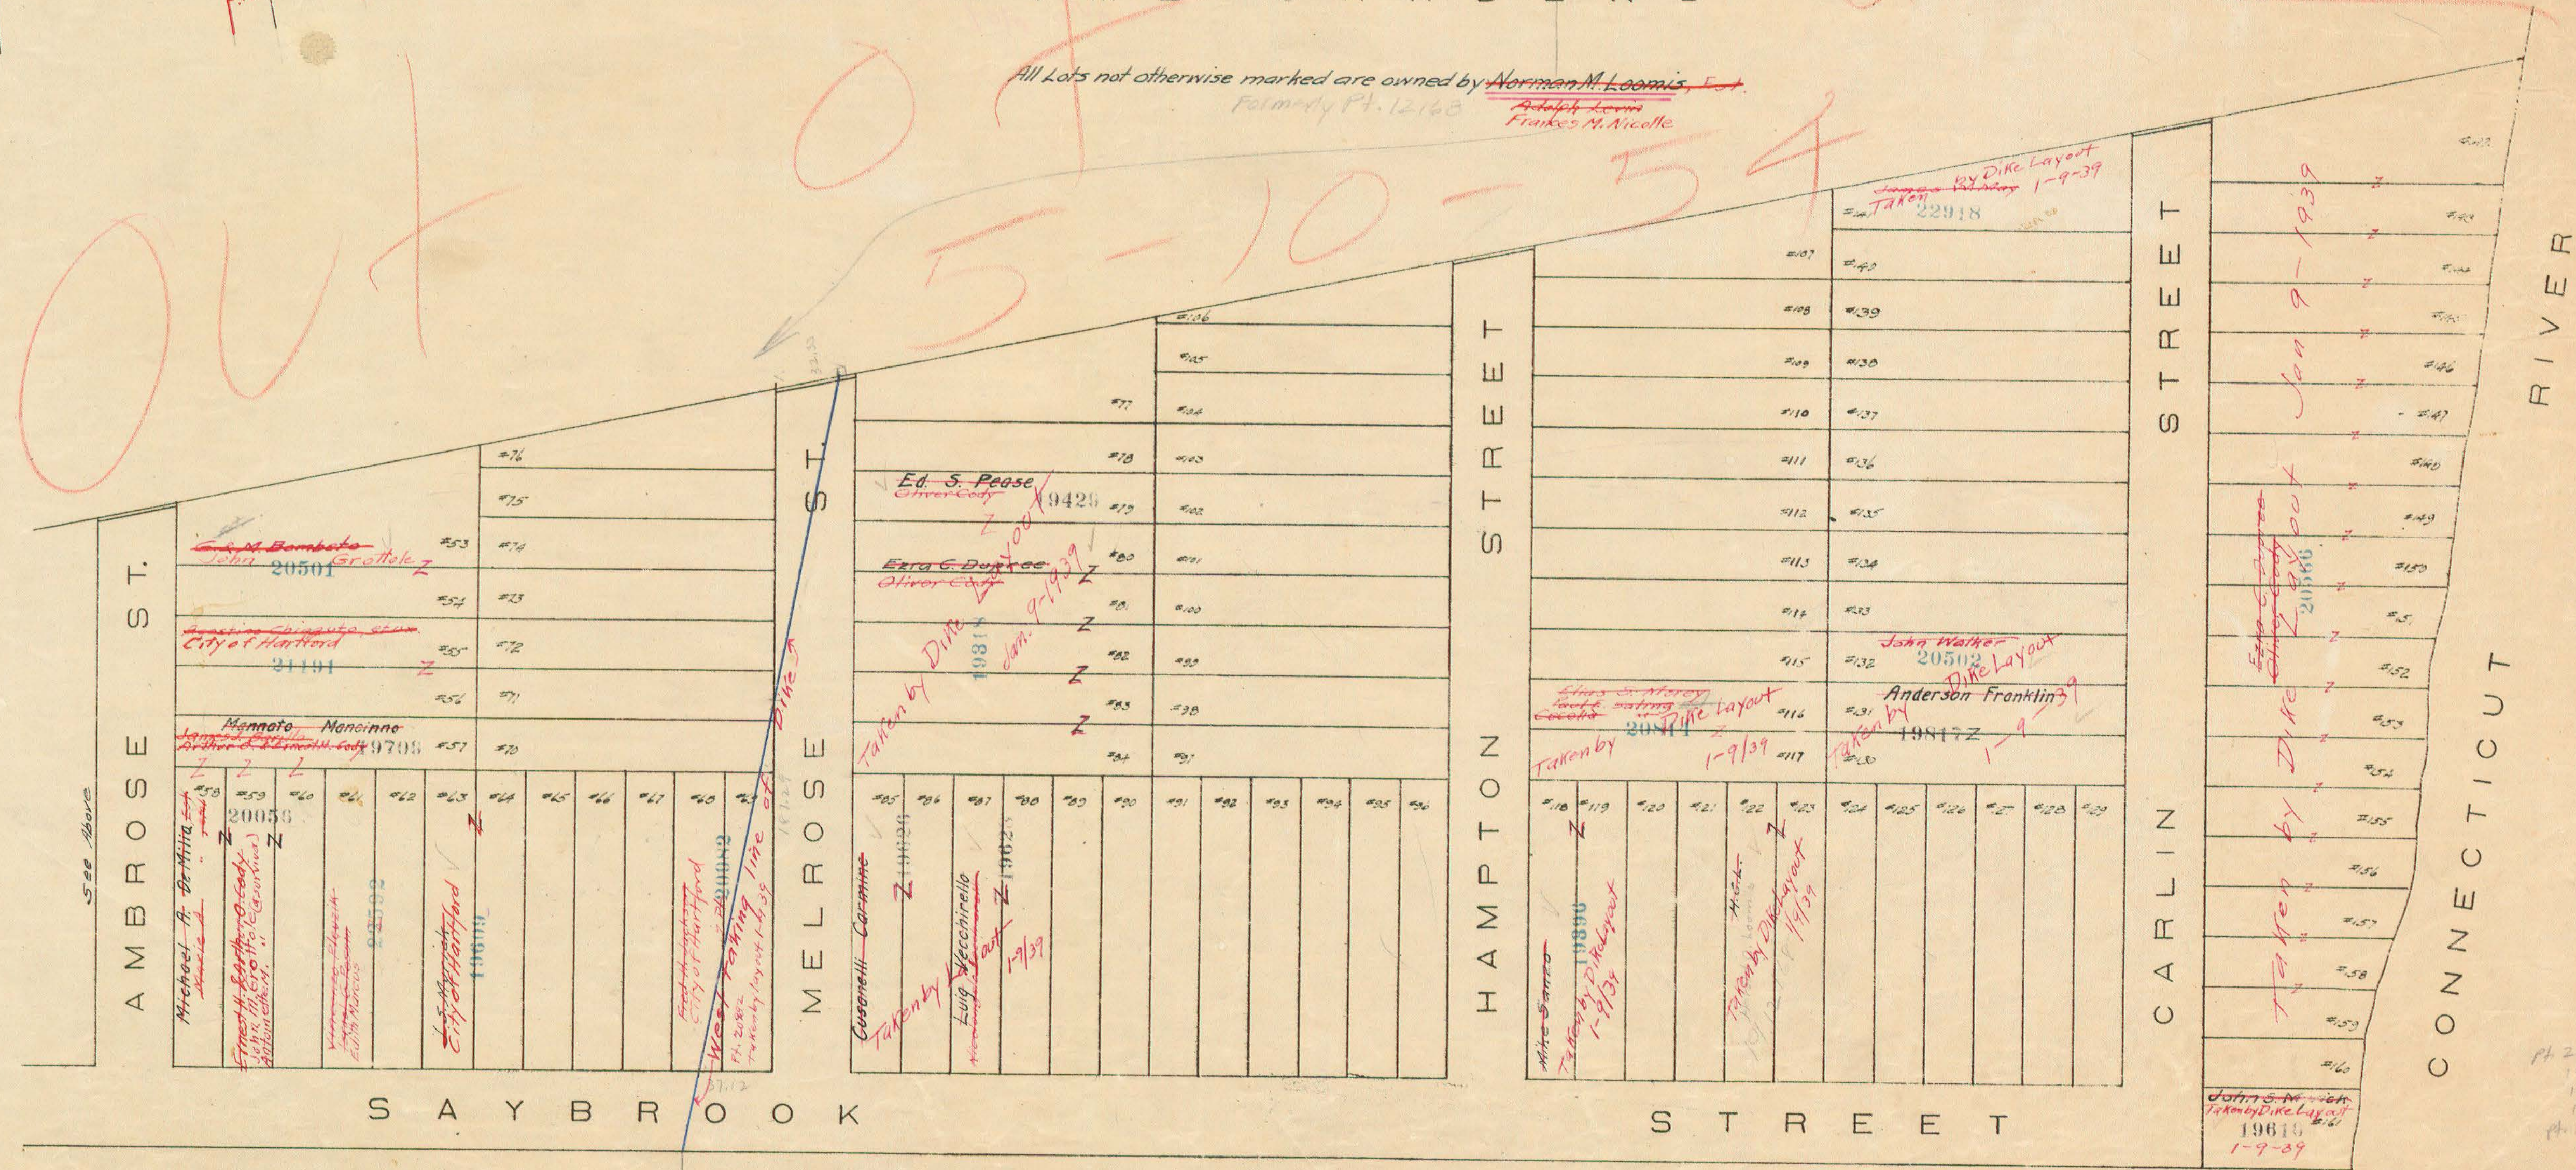

SCALE 50 FEET TO AN INCH

All blank lots owned by City of Hartford
Pt 12168

Pt 20782
19426
19427
