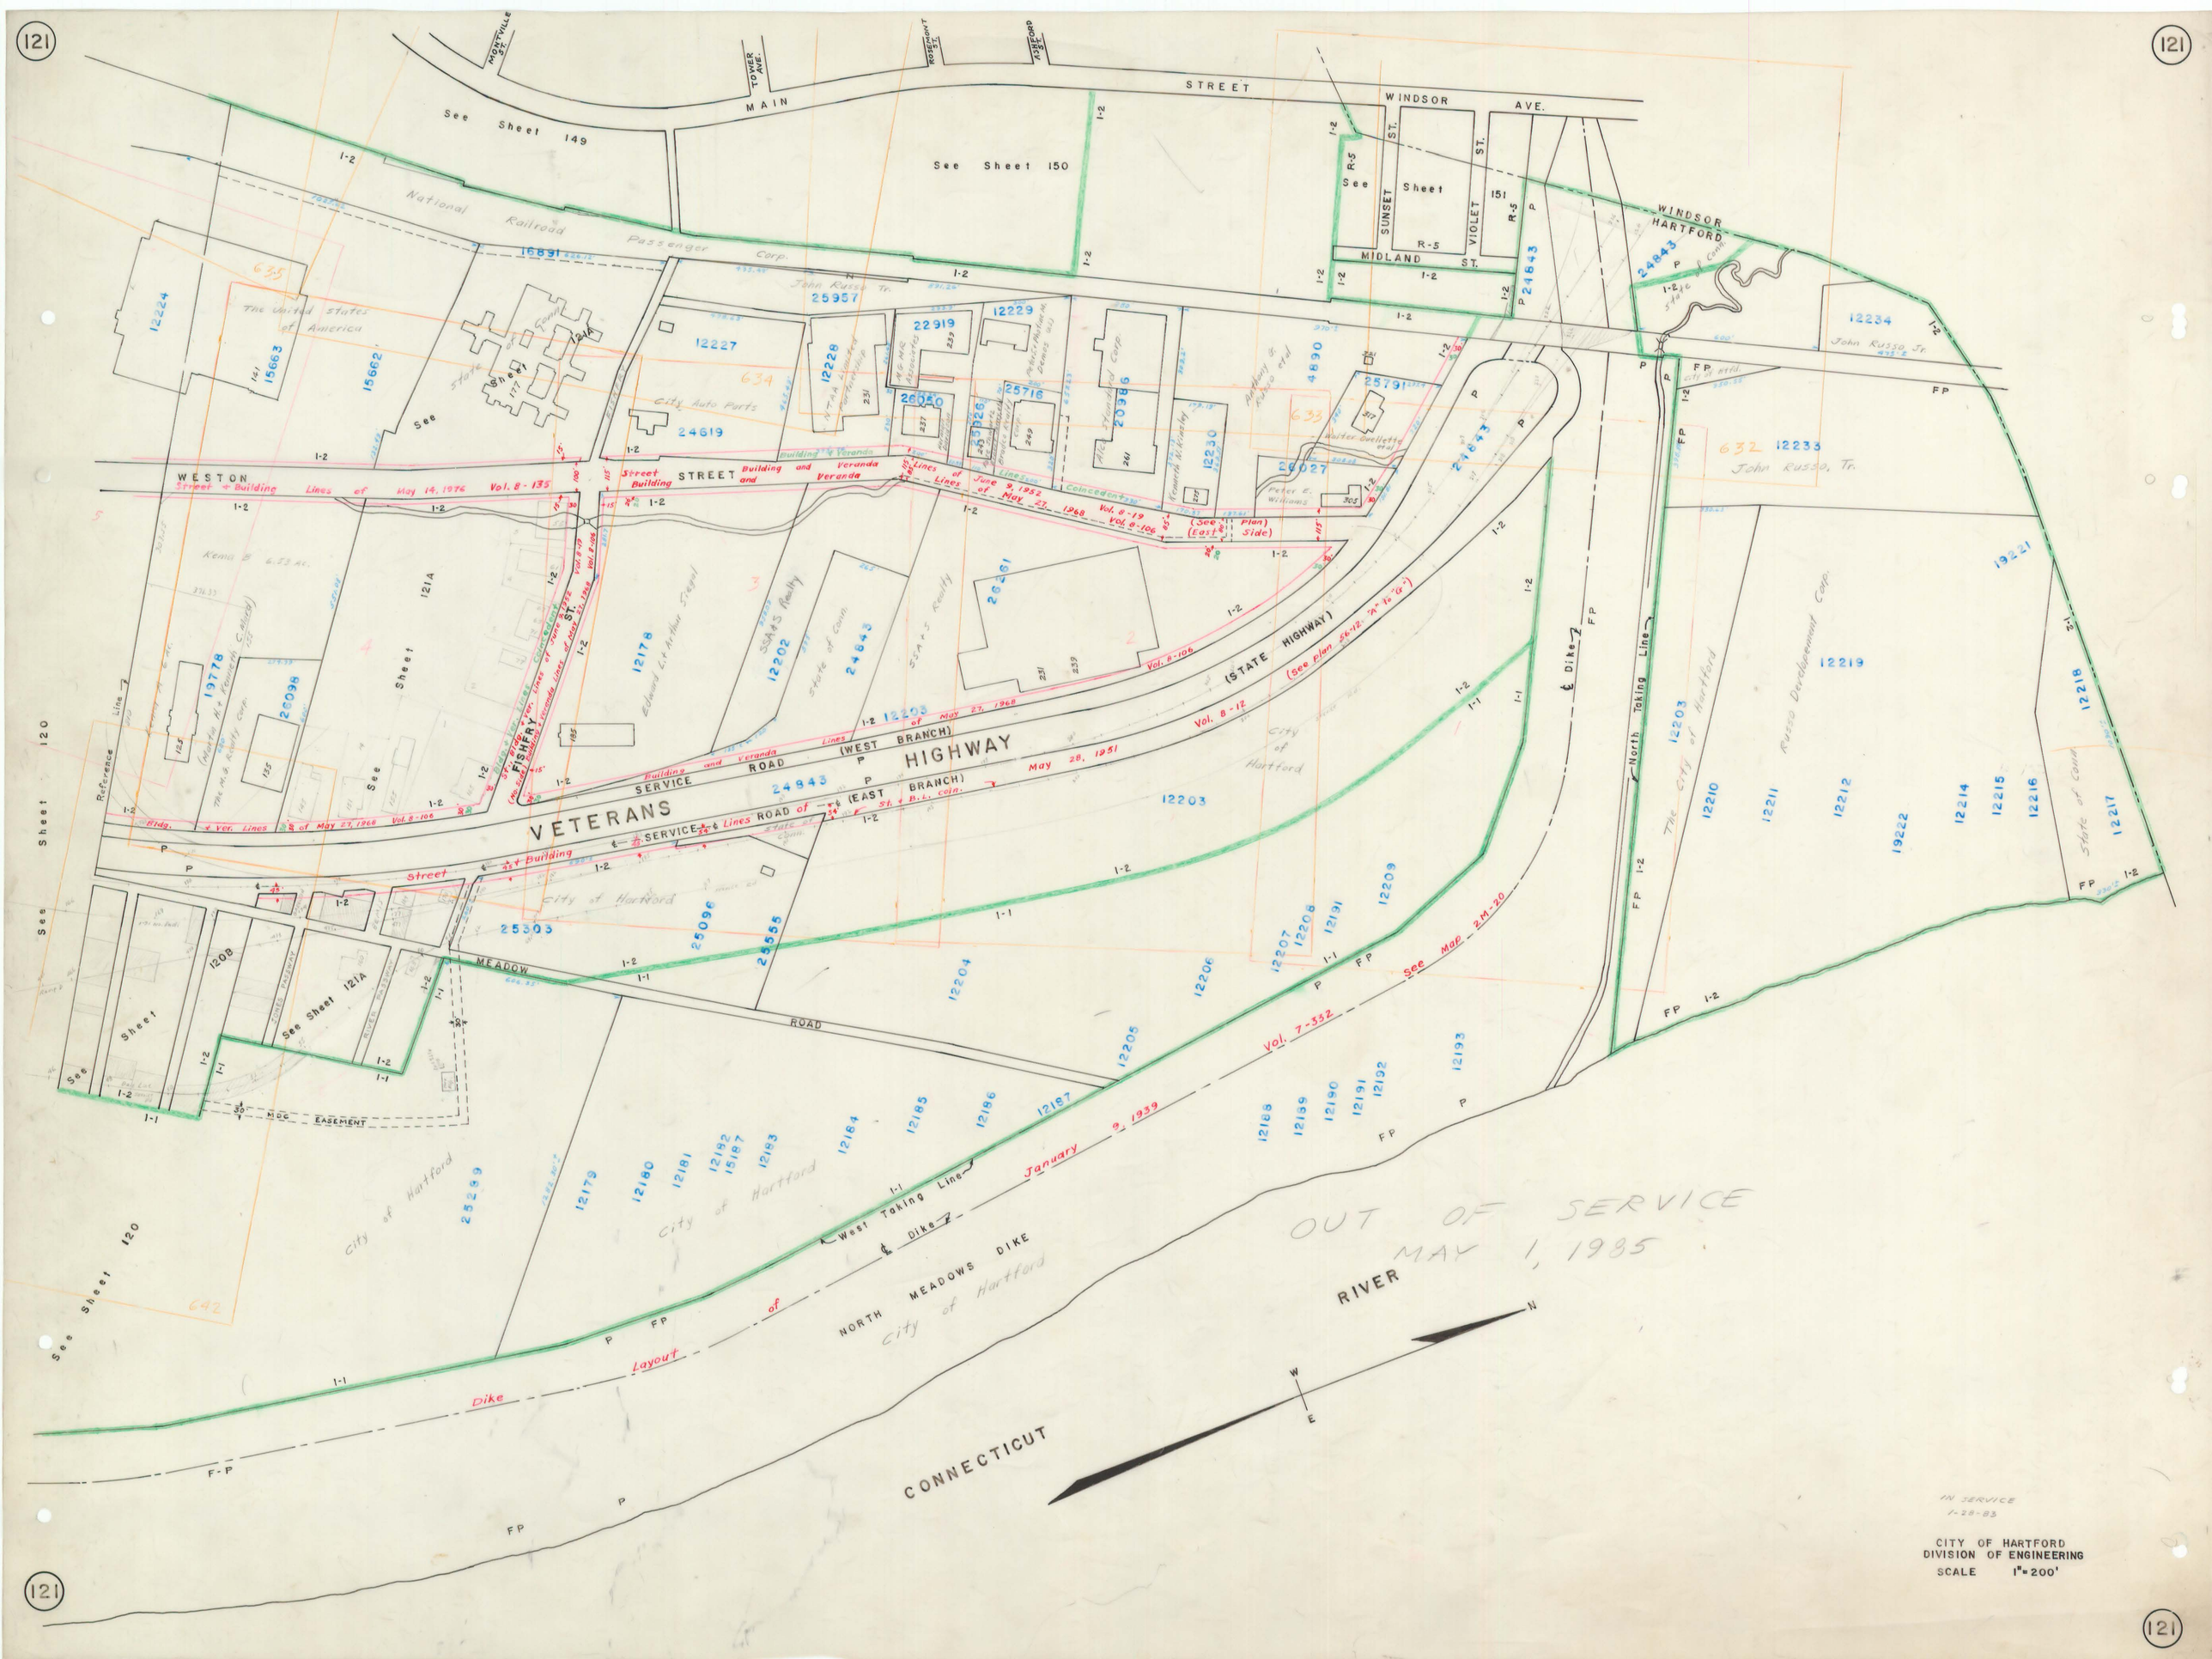

IN SERVICE
1-28-83

CITY OF HARTFORD
DIVISION OF ENGINEERING
SCALE 1" = 200'