


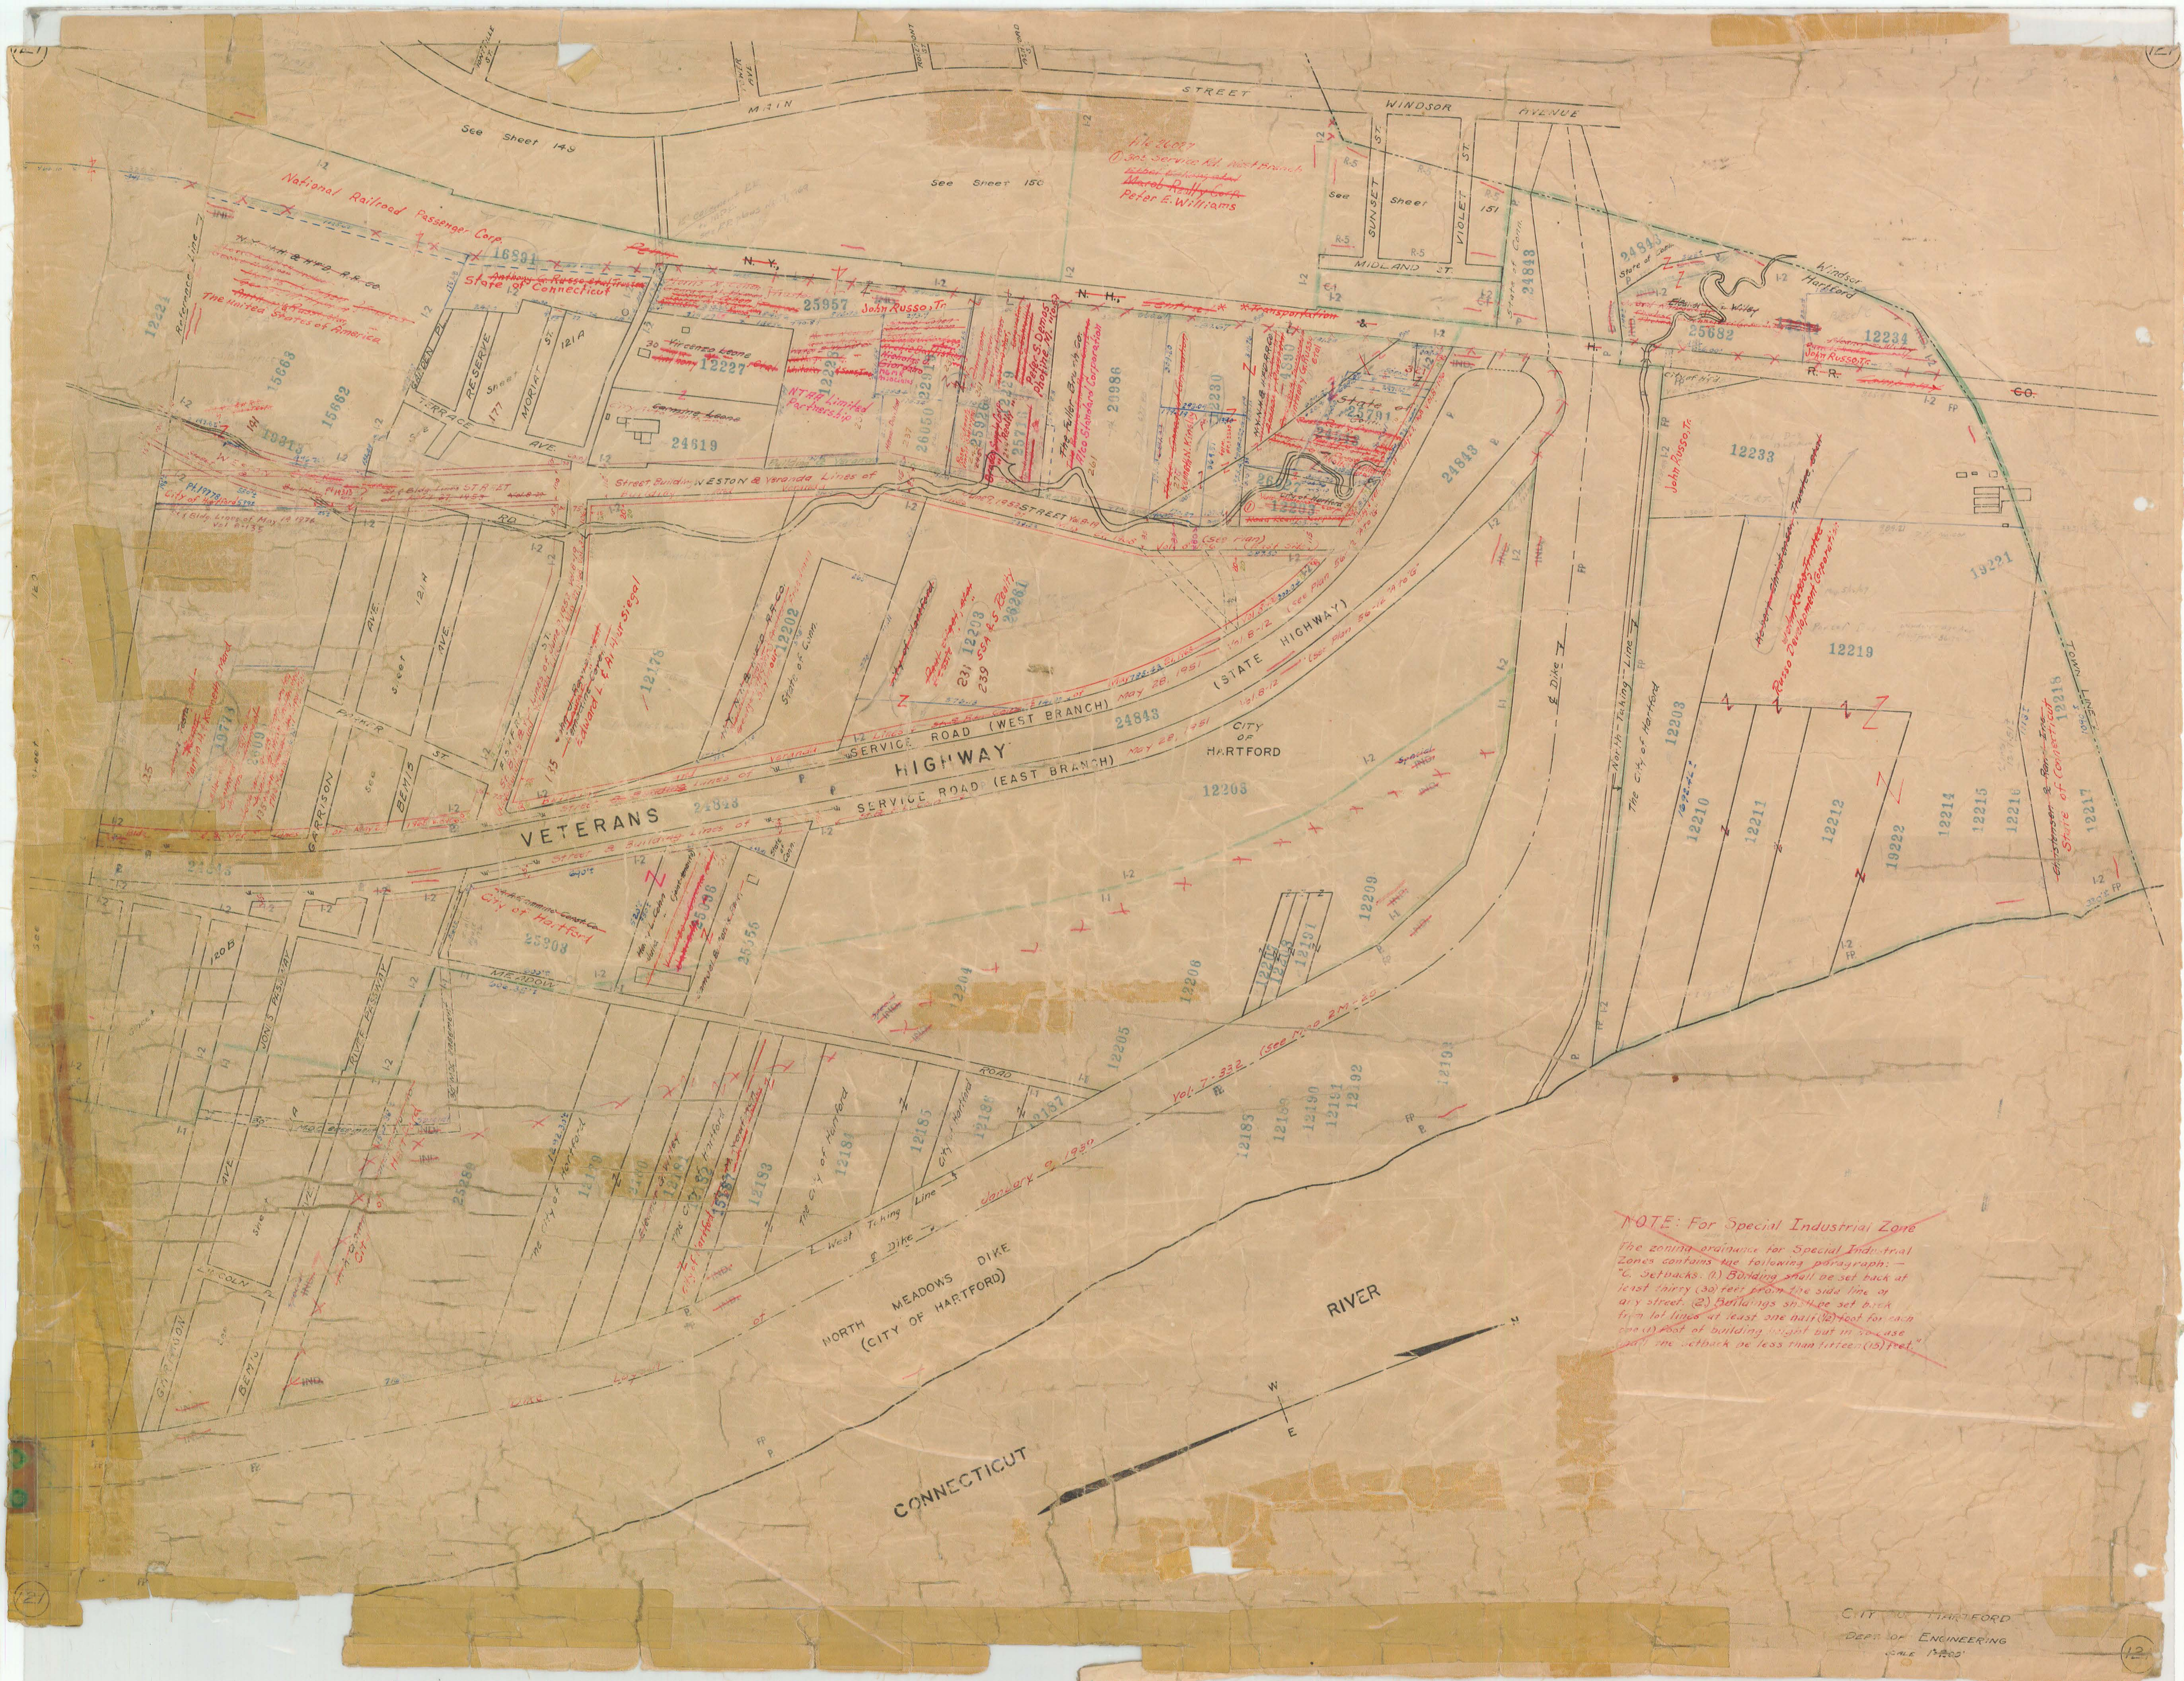

**NOTE: For Special Industrial Zone**  
The zoning ordinance for Special Industrial Zones contains the following paragraphs: -  
"C. Setbacks. (1) Building shall be set back at least thirty (30) feet from the side line or any street. (2) Buildings shall be set back from lot lines at least one half (1/2) foot for each one (1) foot of building height but in no case shall the setback be less than fifteen (15) feet."