


Fishery St.

FISHERY ST.


Note: On first assignment of numbers mark formerly part #12177

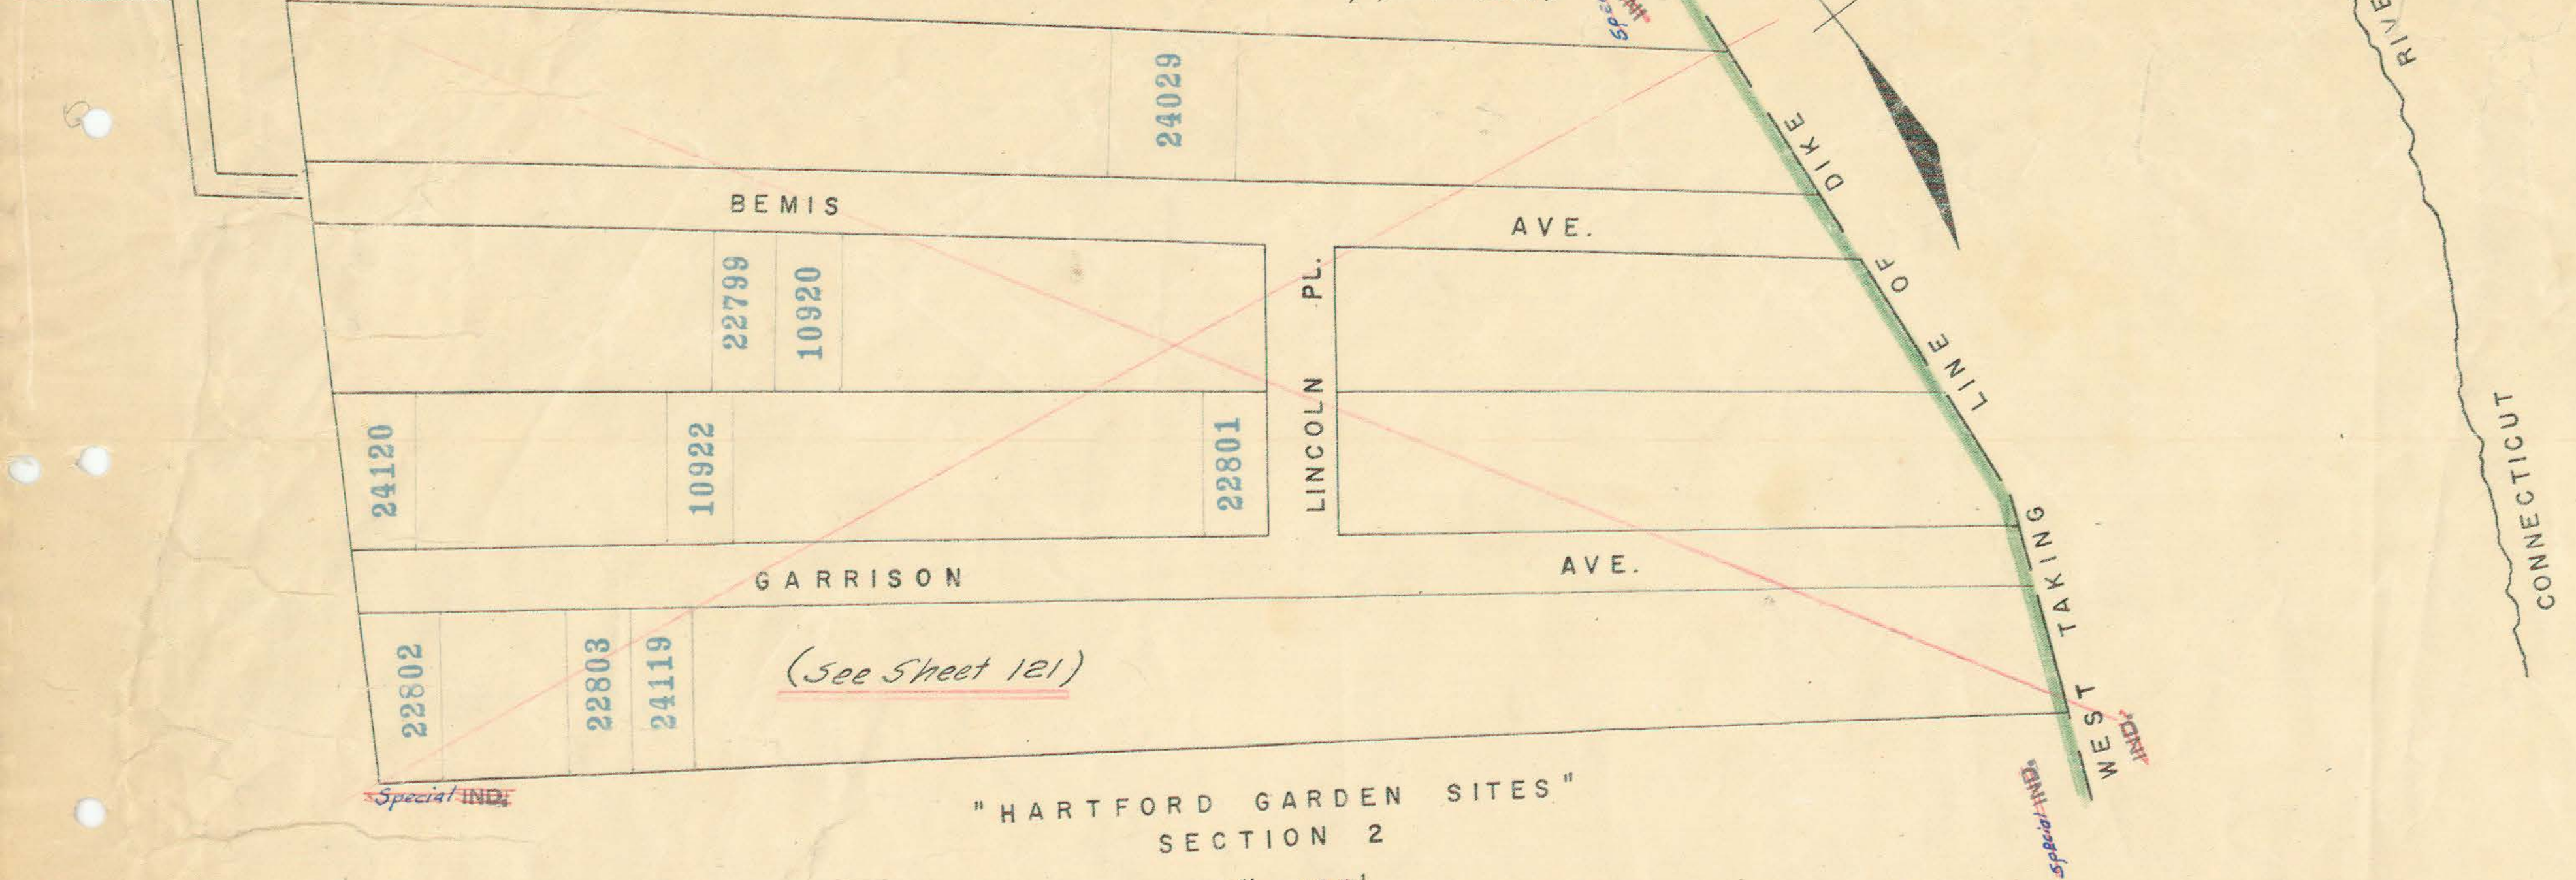

National Railroad Passenger Corp.
H. X. N.H. & H. RR. CO.


"HARTFORD GARDEN SITES"
SECTION 2
Owned by The City of Hartford
1" = 100'

NOTE: For Special Industrial Zone
Adopted June 11, 1956
The zoning ordinance for Special Industrial Zones contains the following paragraph:
C. Setbacks. (1) Building shall be set back at least thirty (30) feet from the side line of any street. (2) Buildings shall be set back from lot lines at least one half (1/2) foot for each one (1) foot of building height but in no case shall the set back be less than fifteen (15) feet.

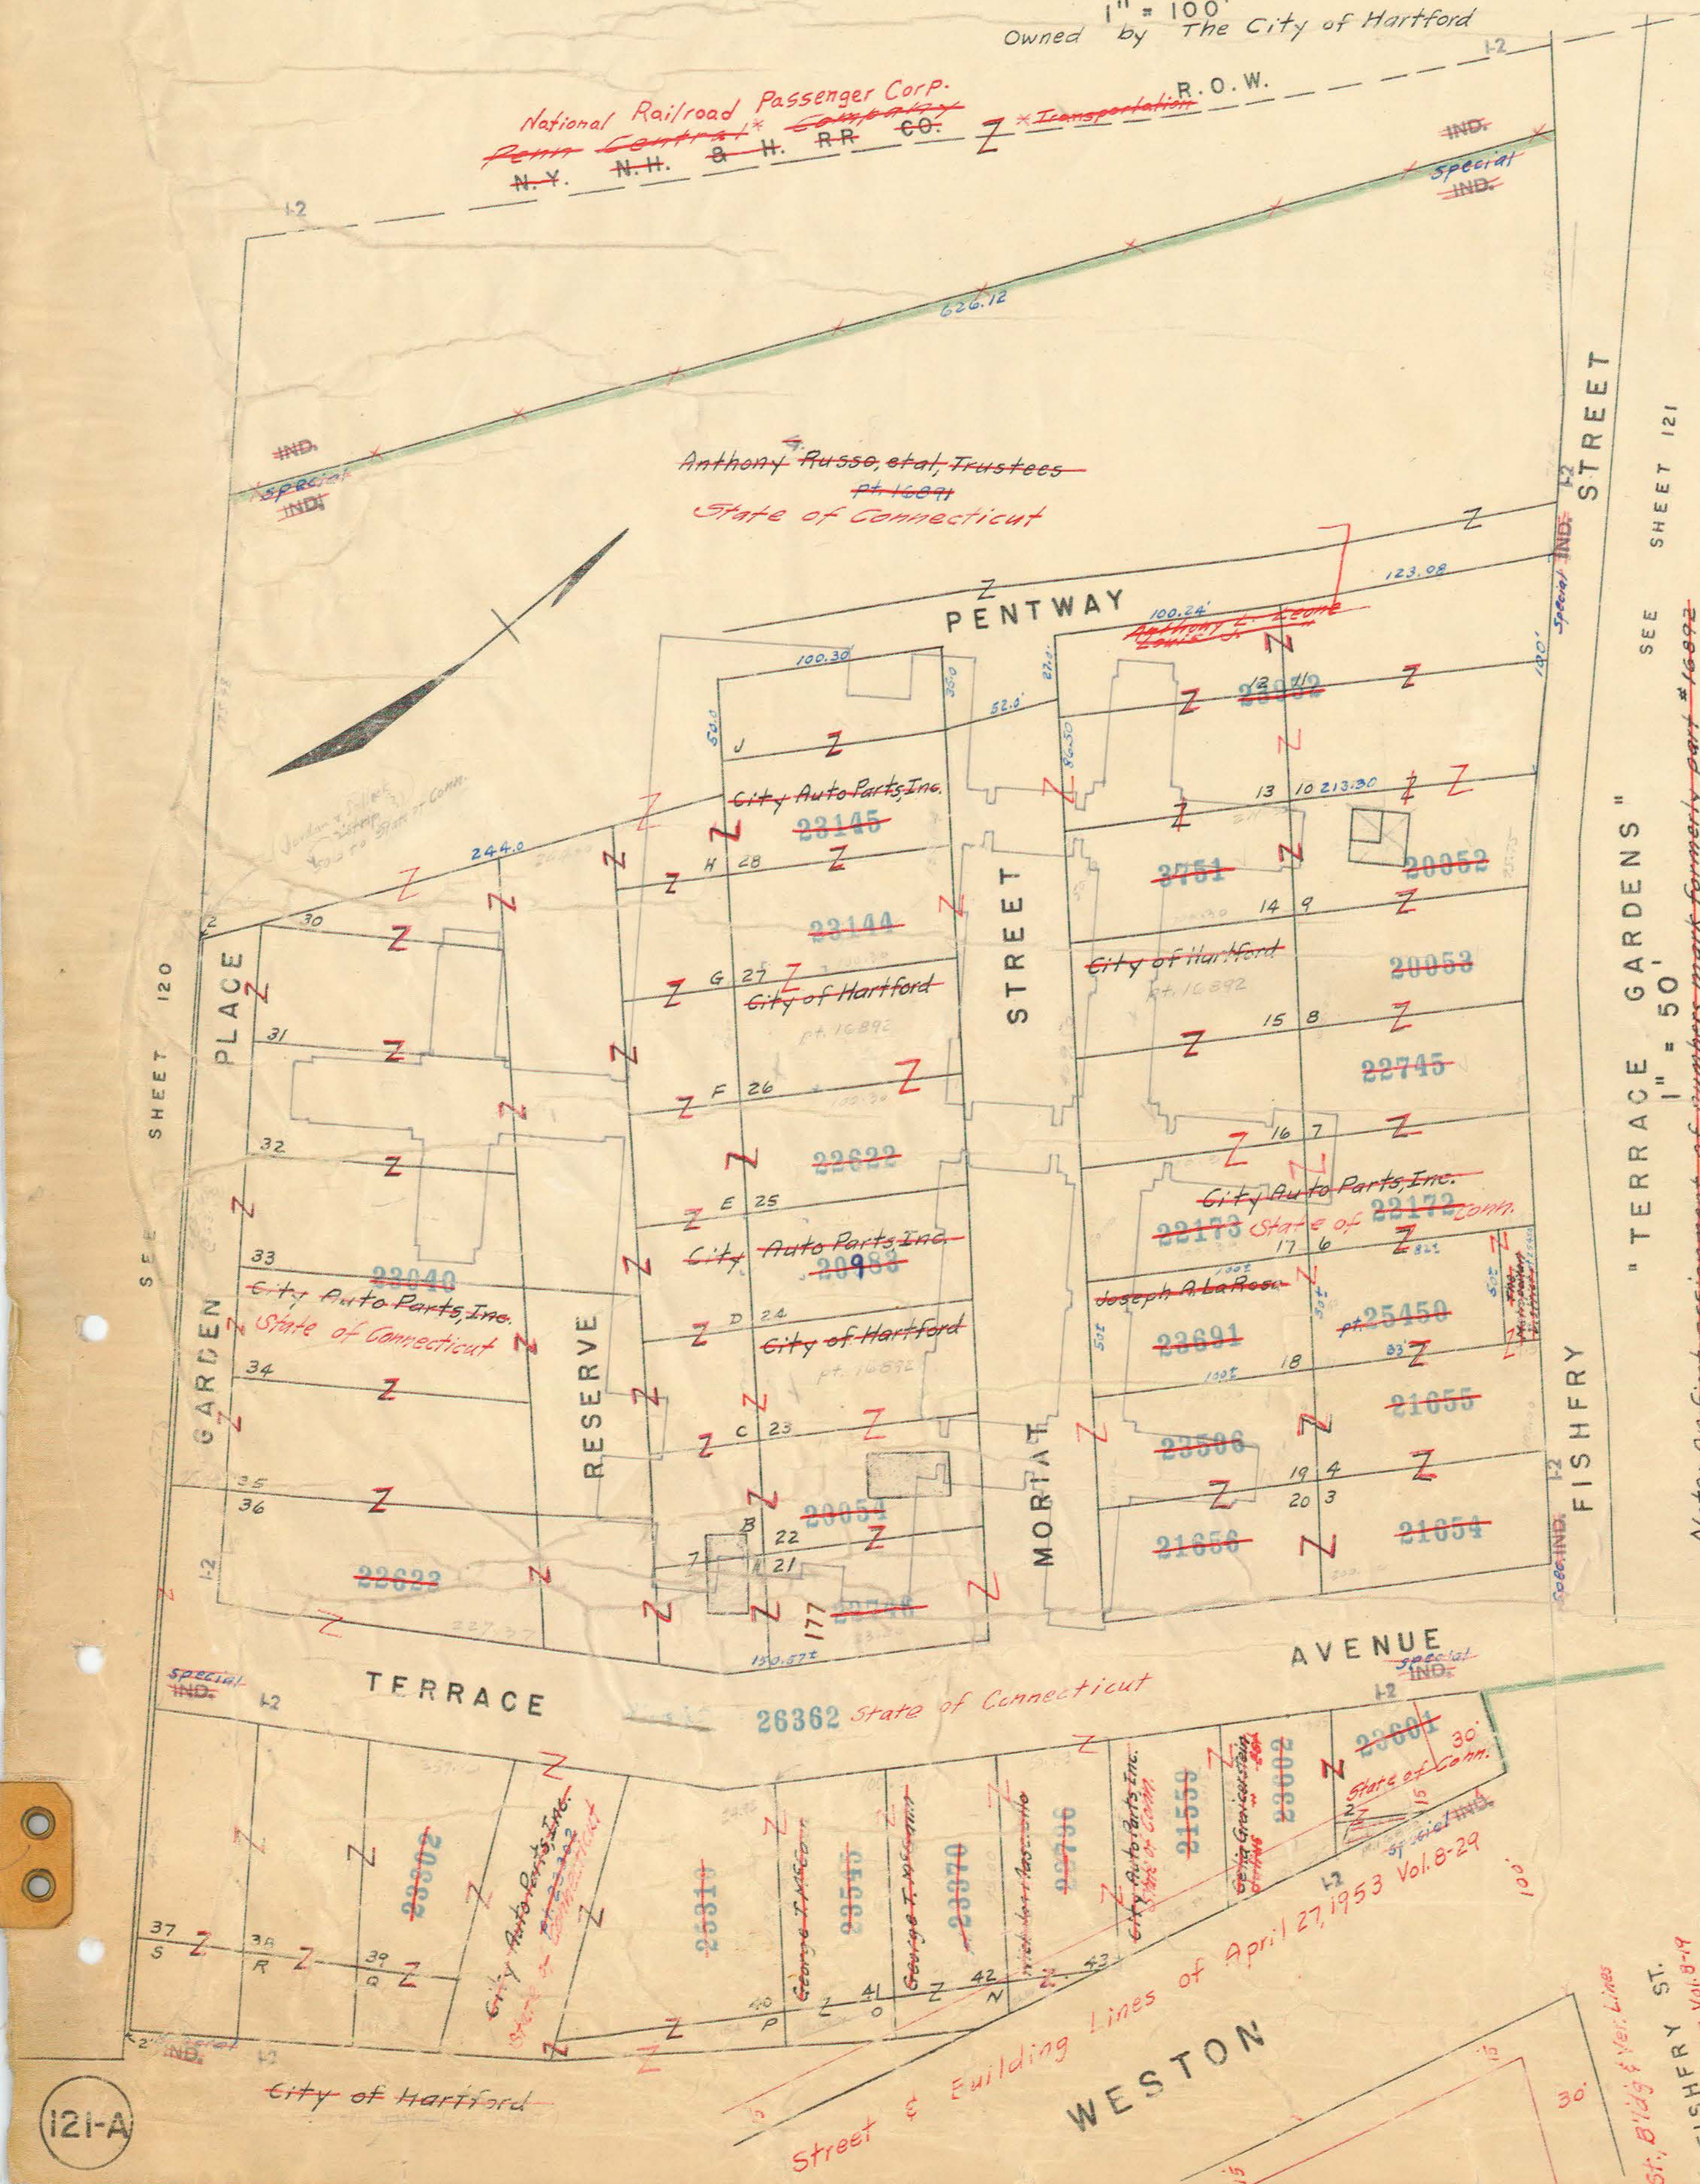


Note: On first assignment of numbers mark formerly part #12177

STREET
Lines of June 9, 1952 Vol. 8-19

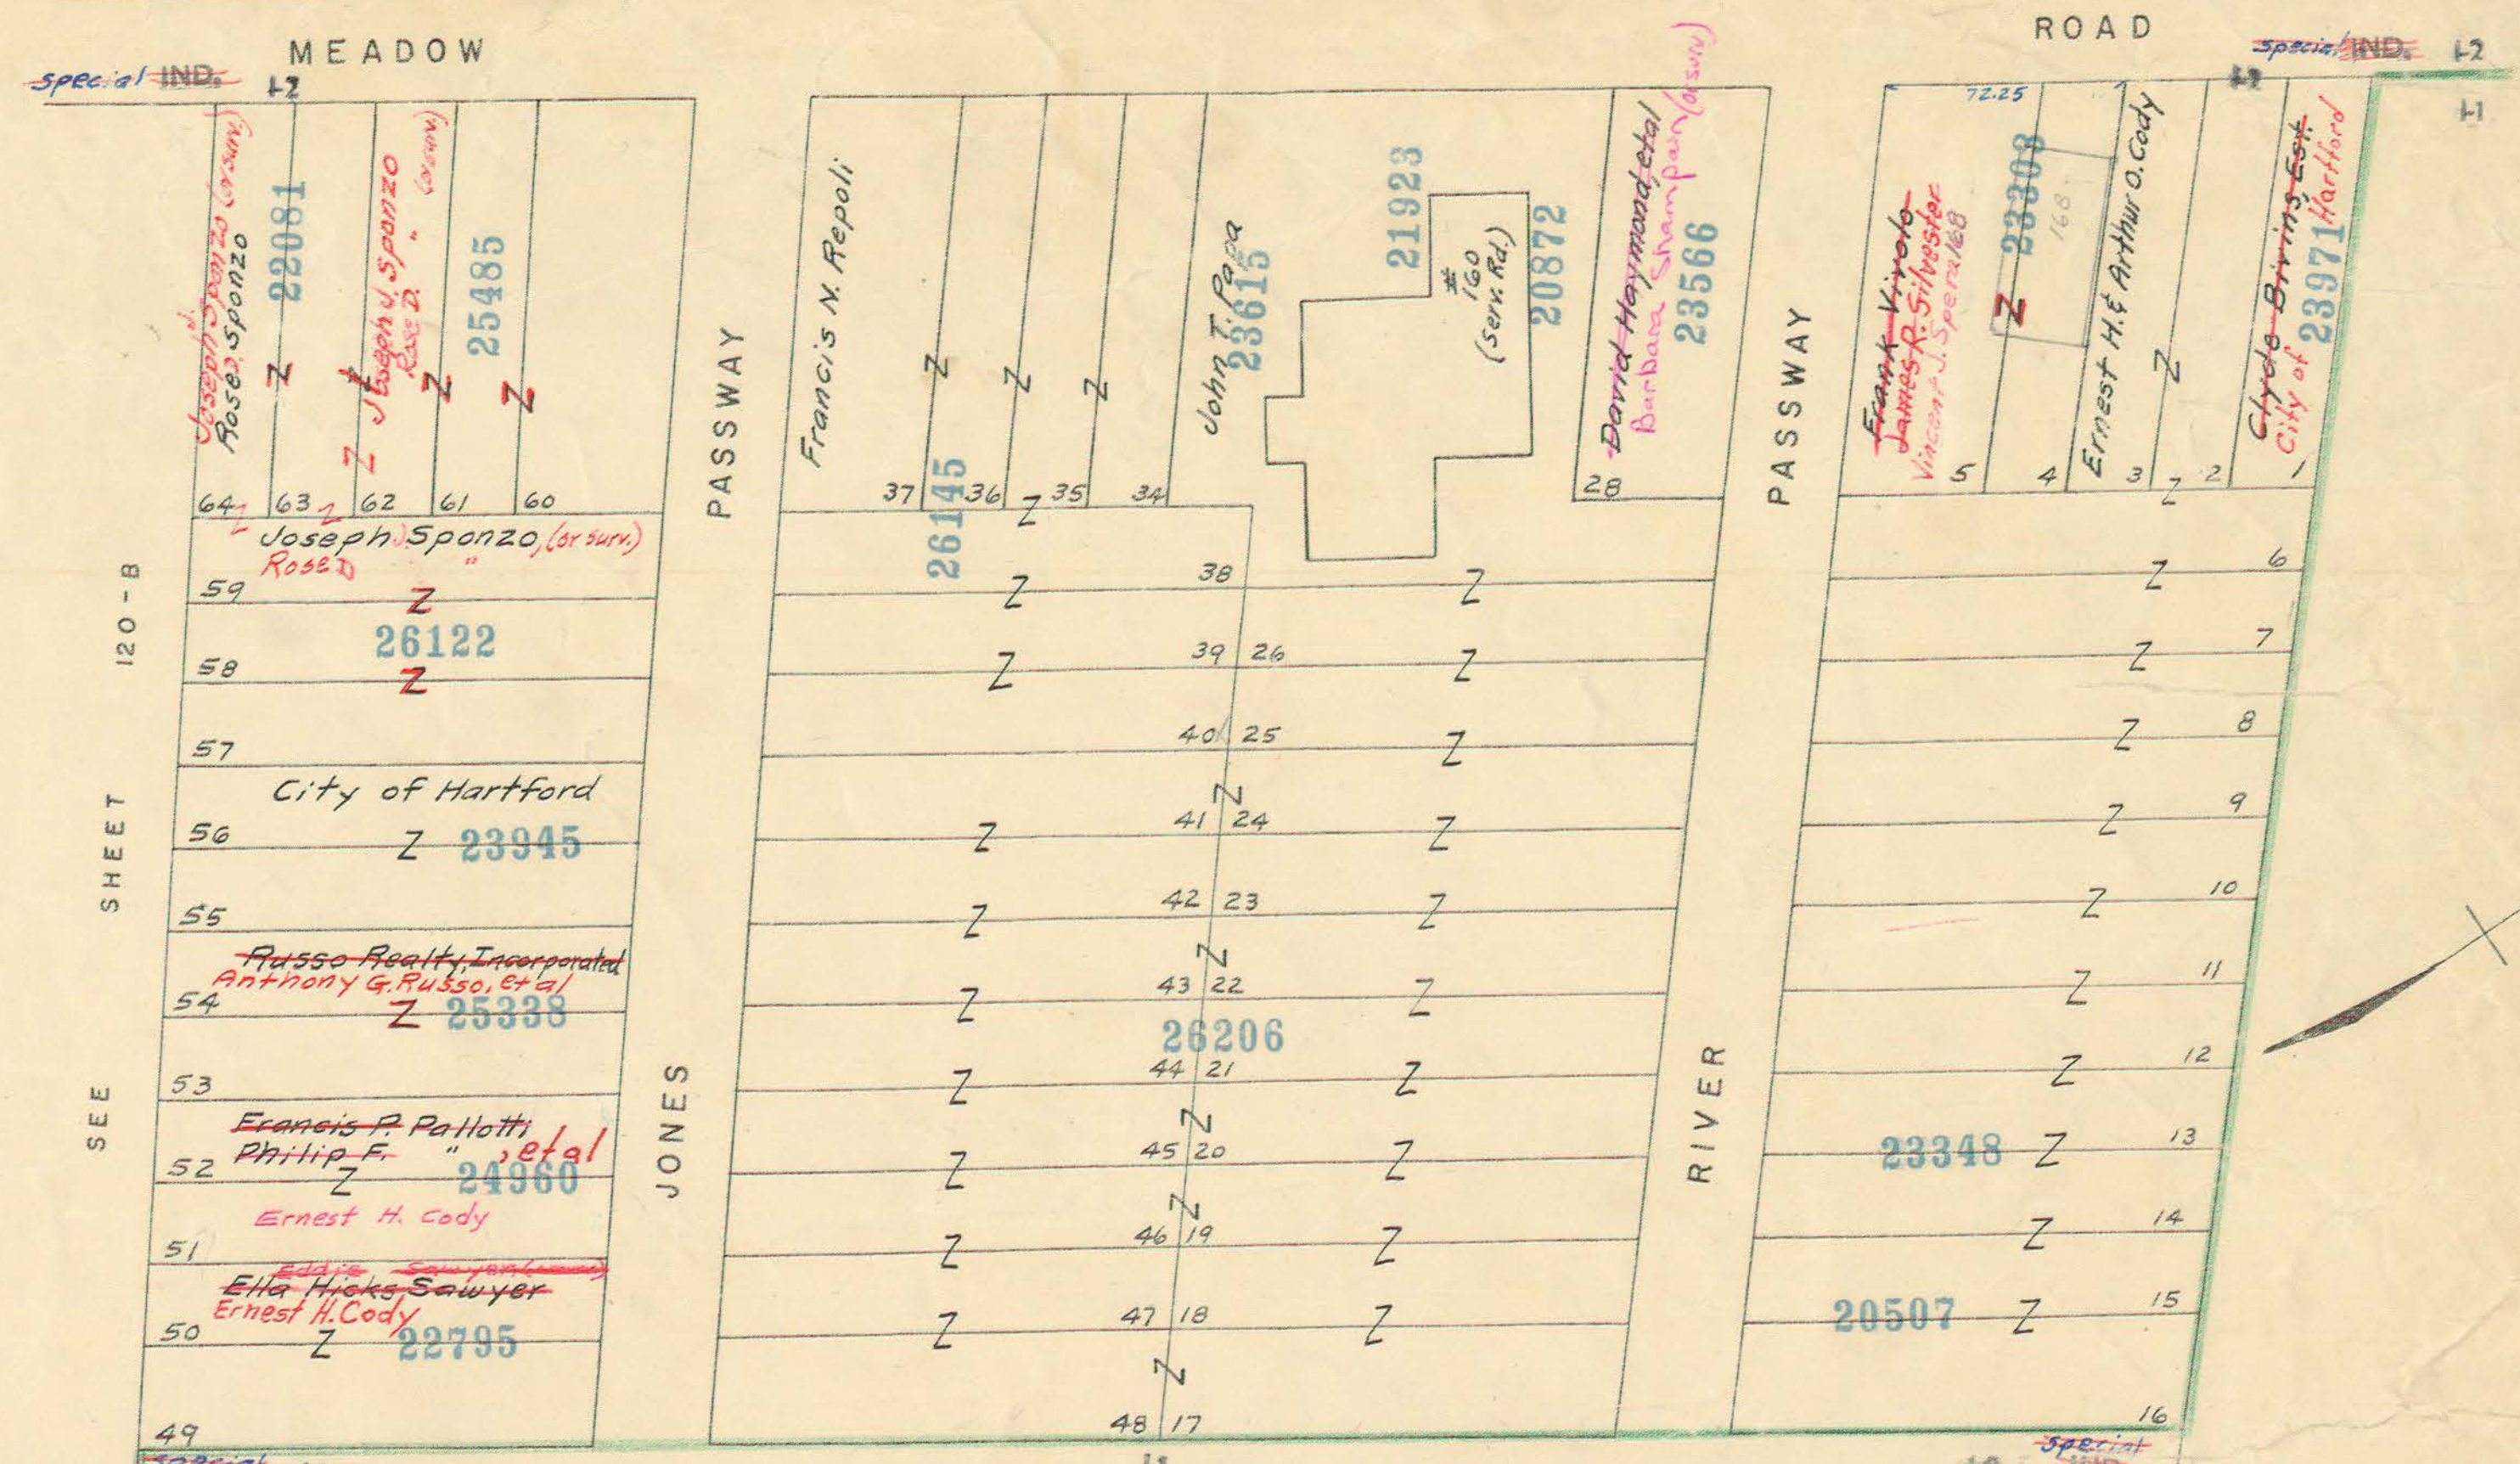

"RIVER PARK GARDENS"
1" = 50'

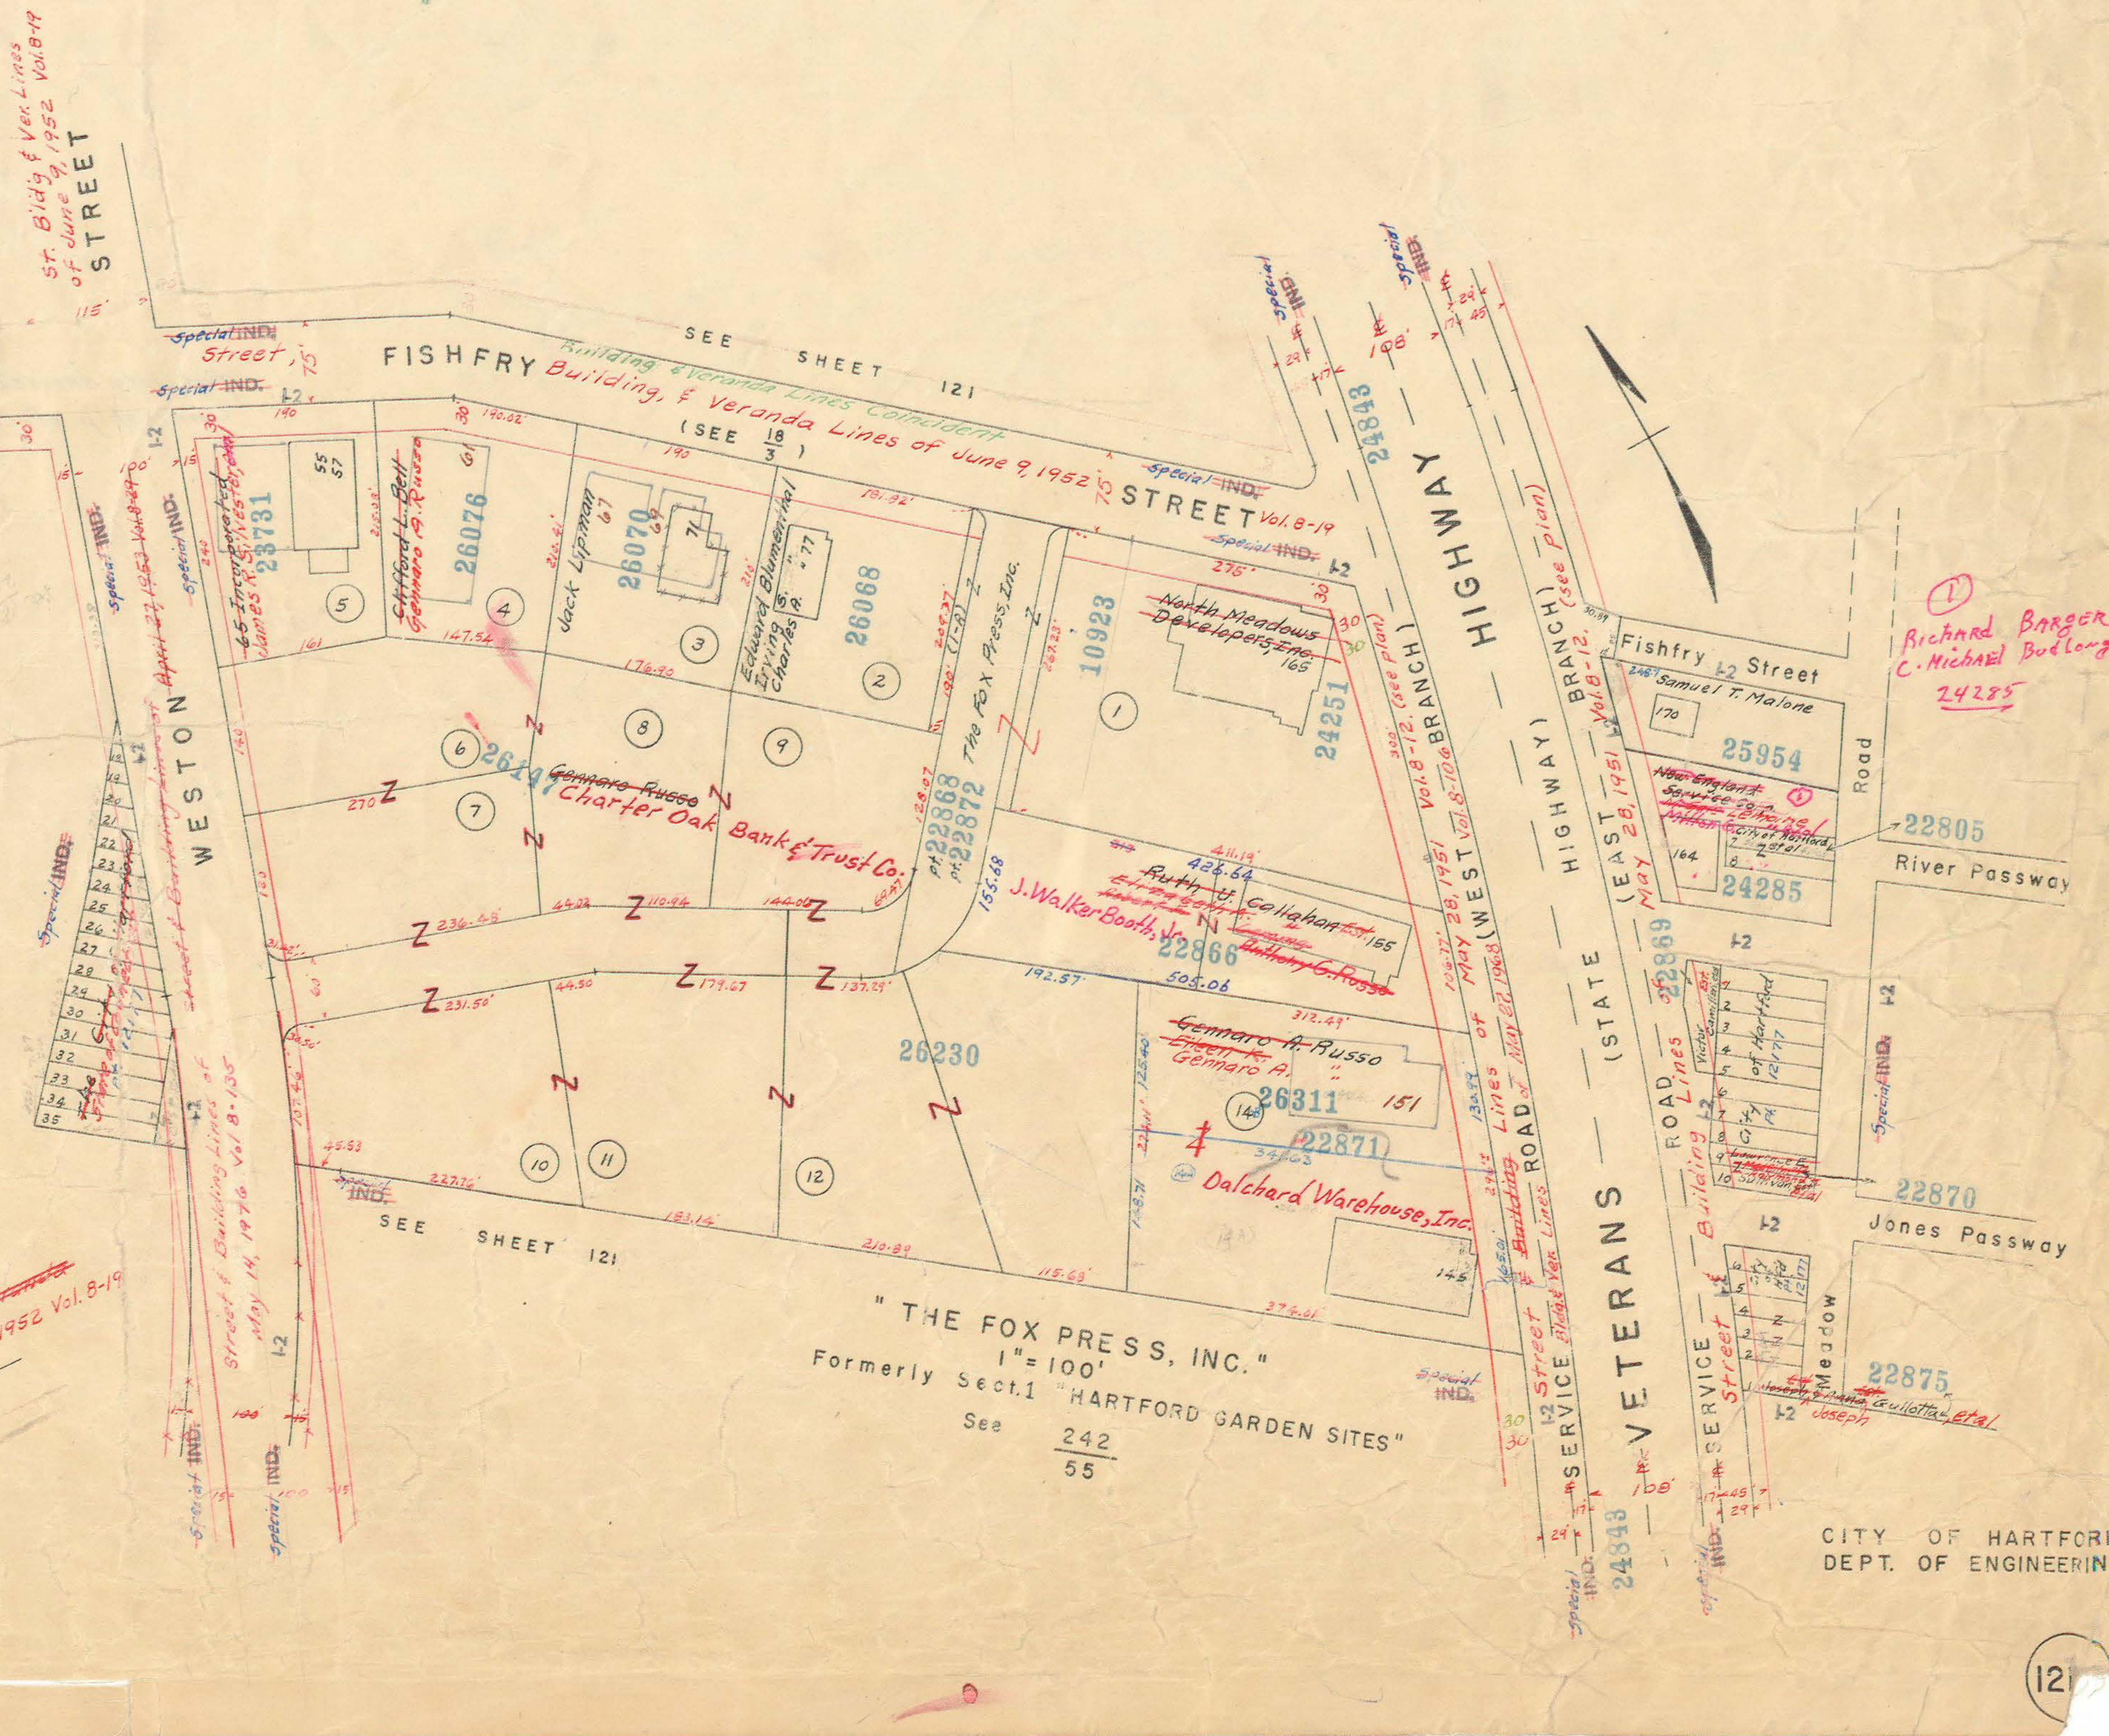

"THE FOX PRESS, INC."
Formerly Sect. 1 "HARTFORD GARDEN SITES"
See 242/55