
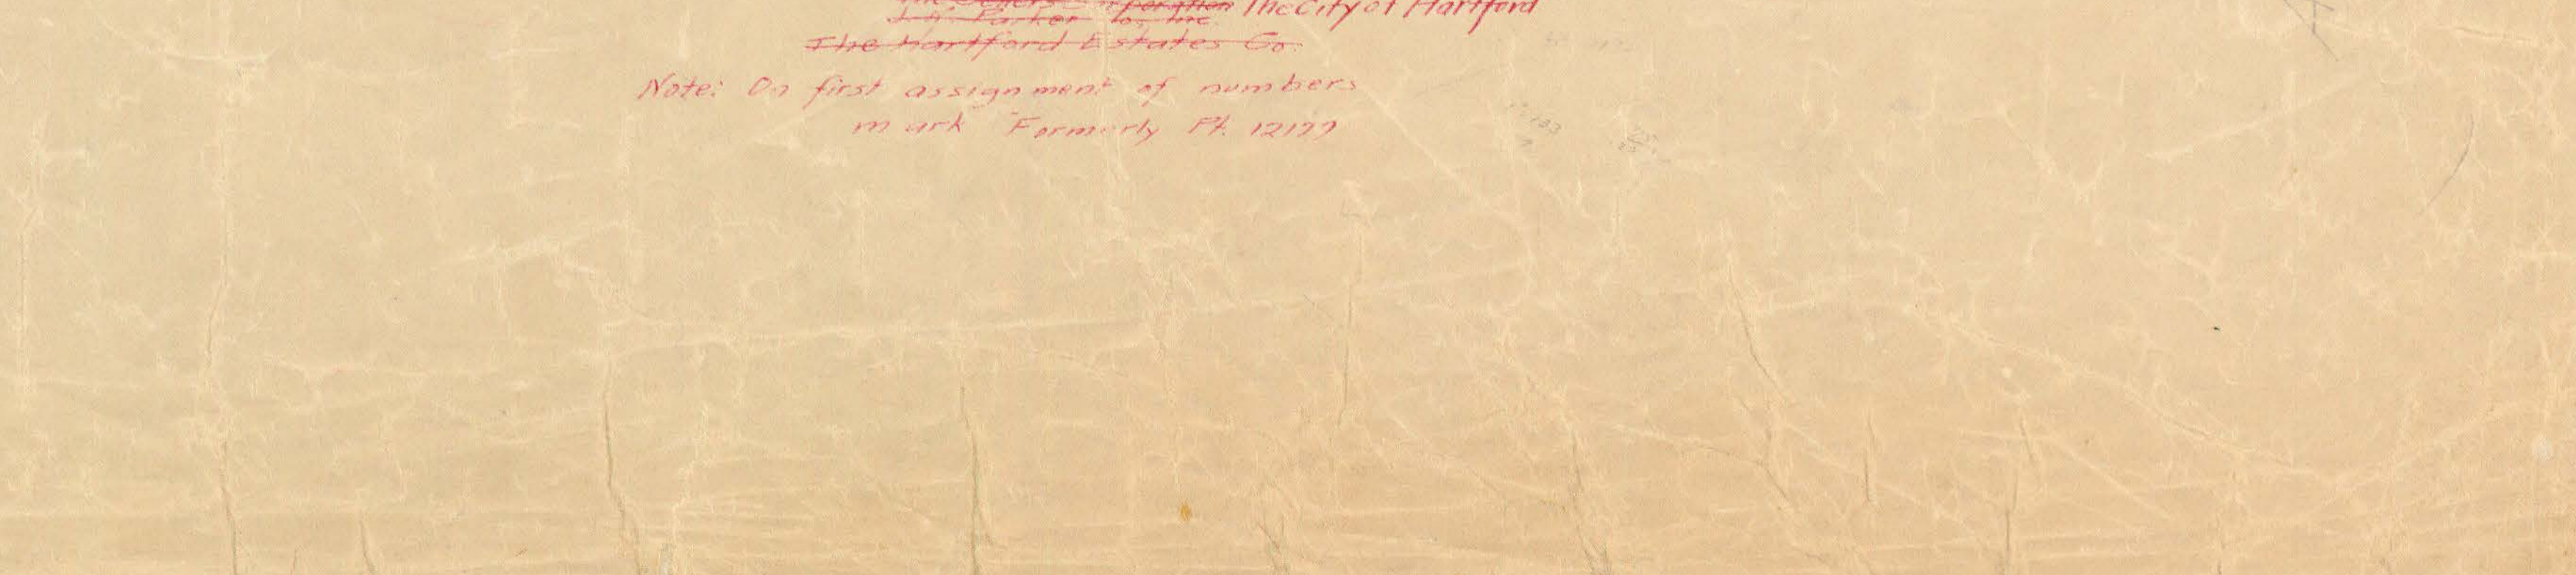
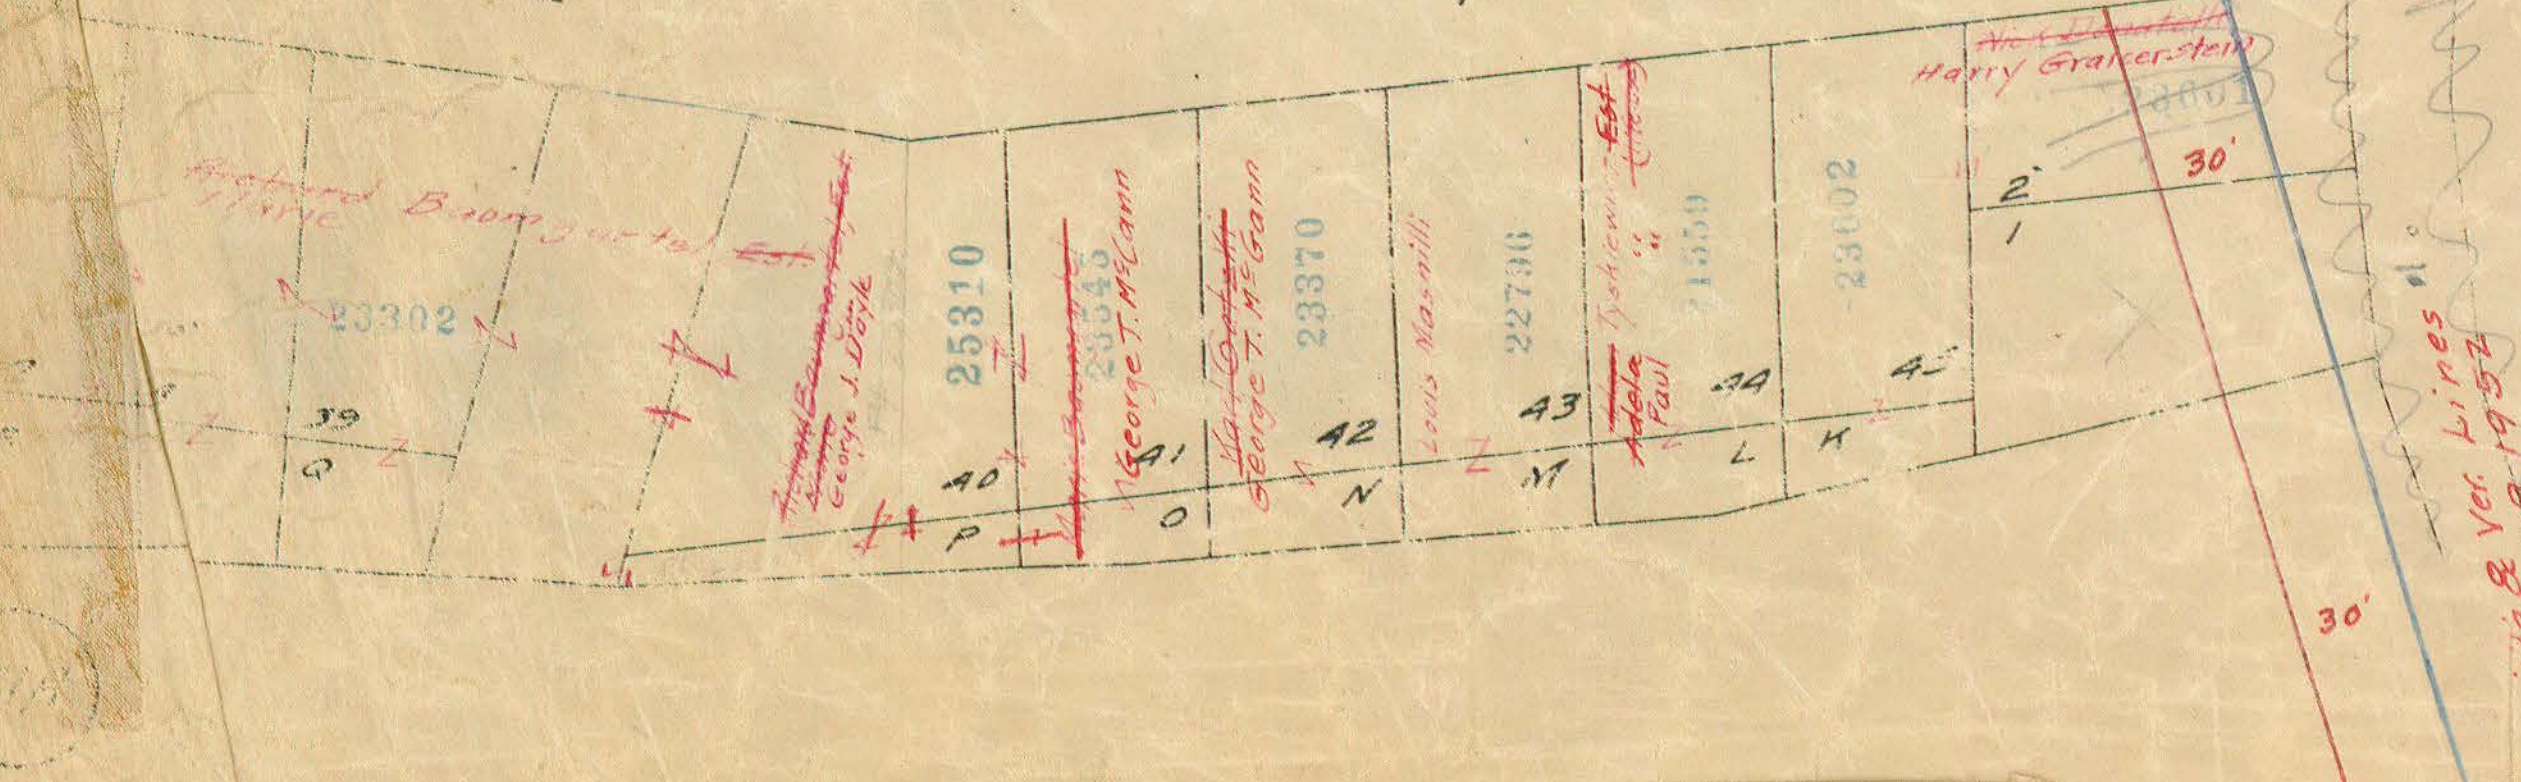
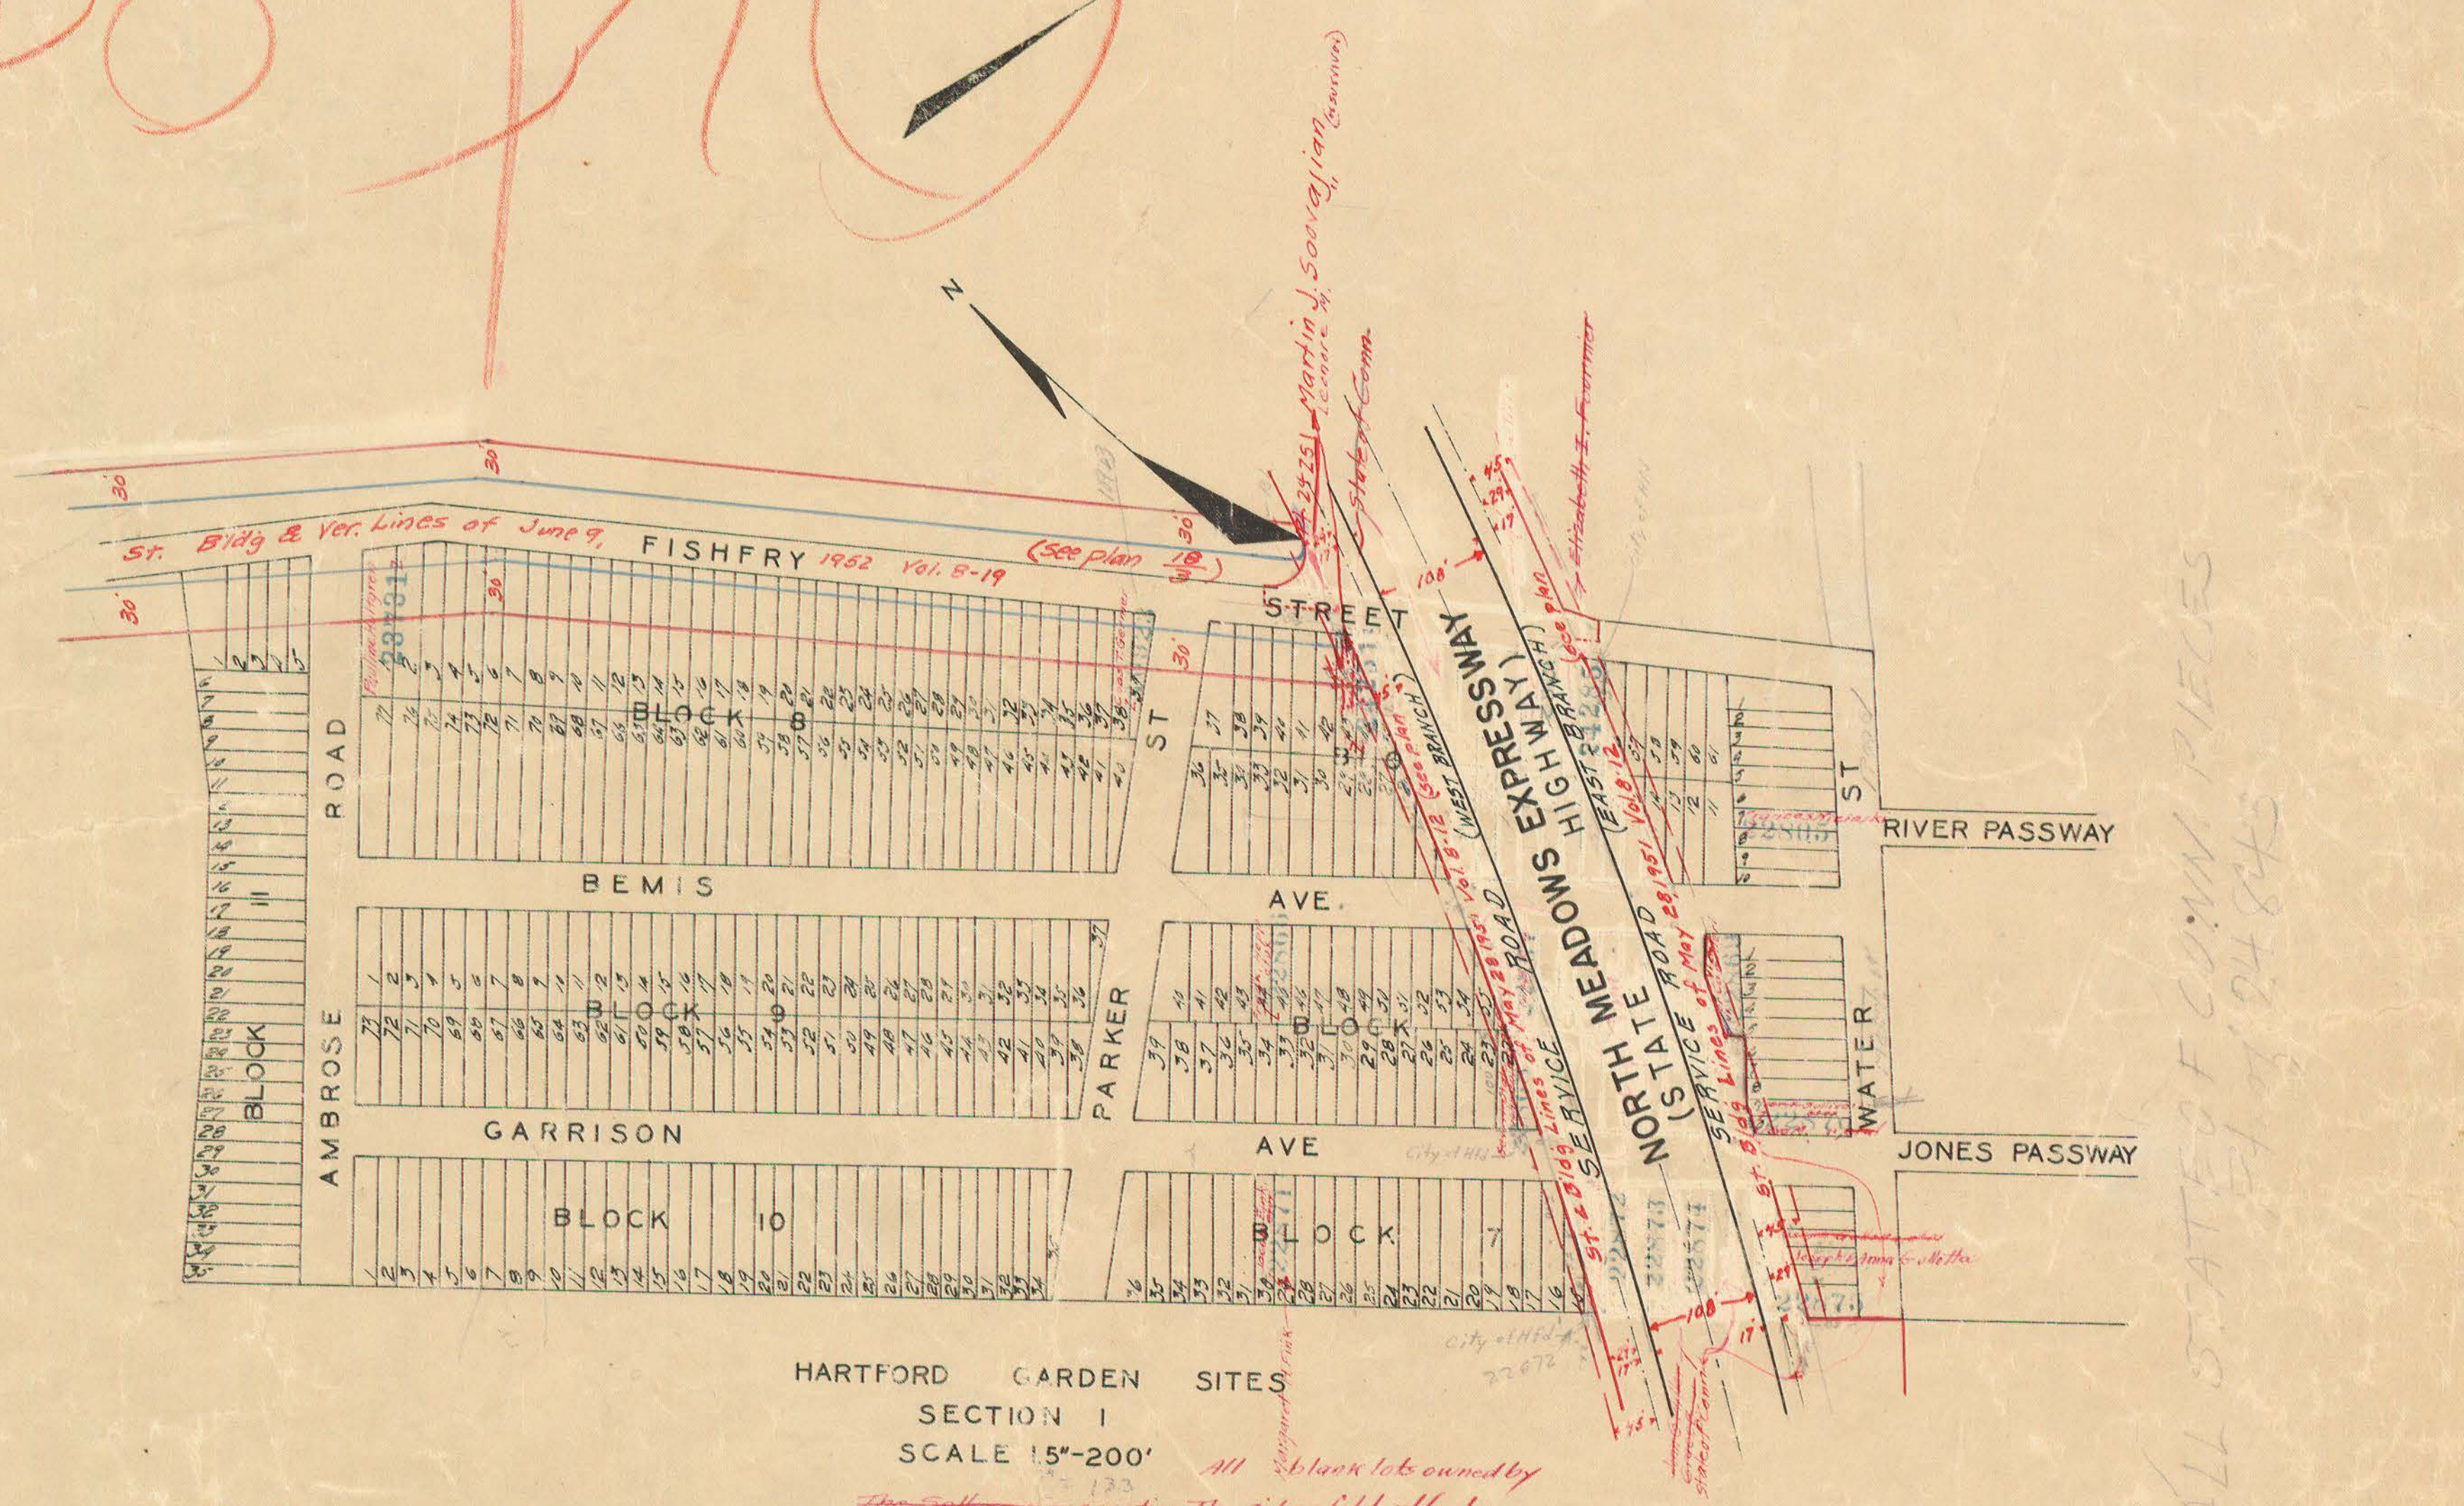
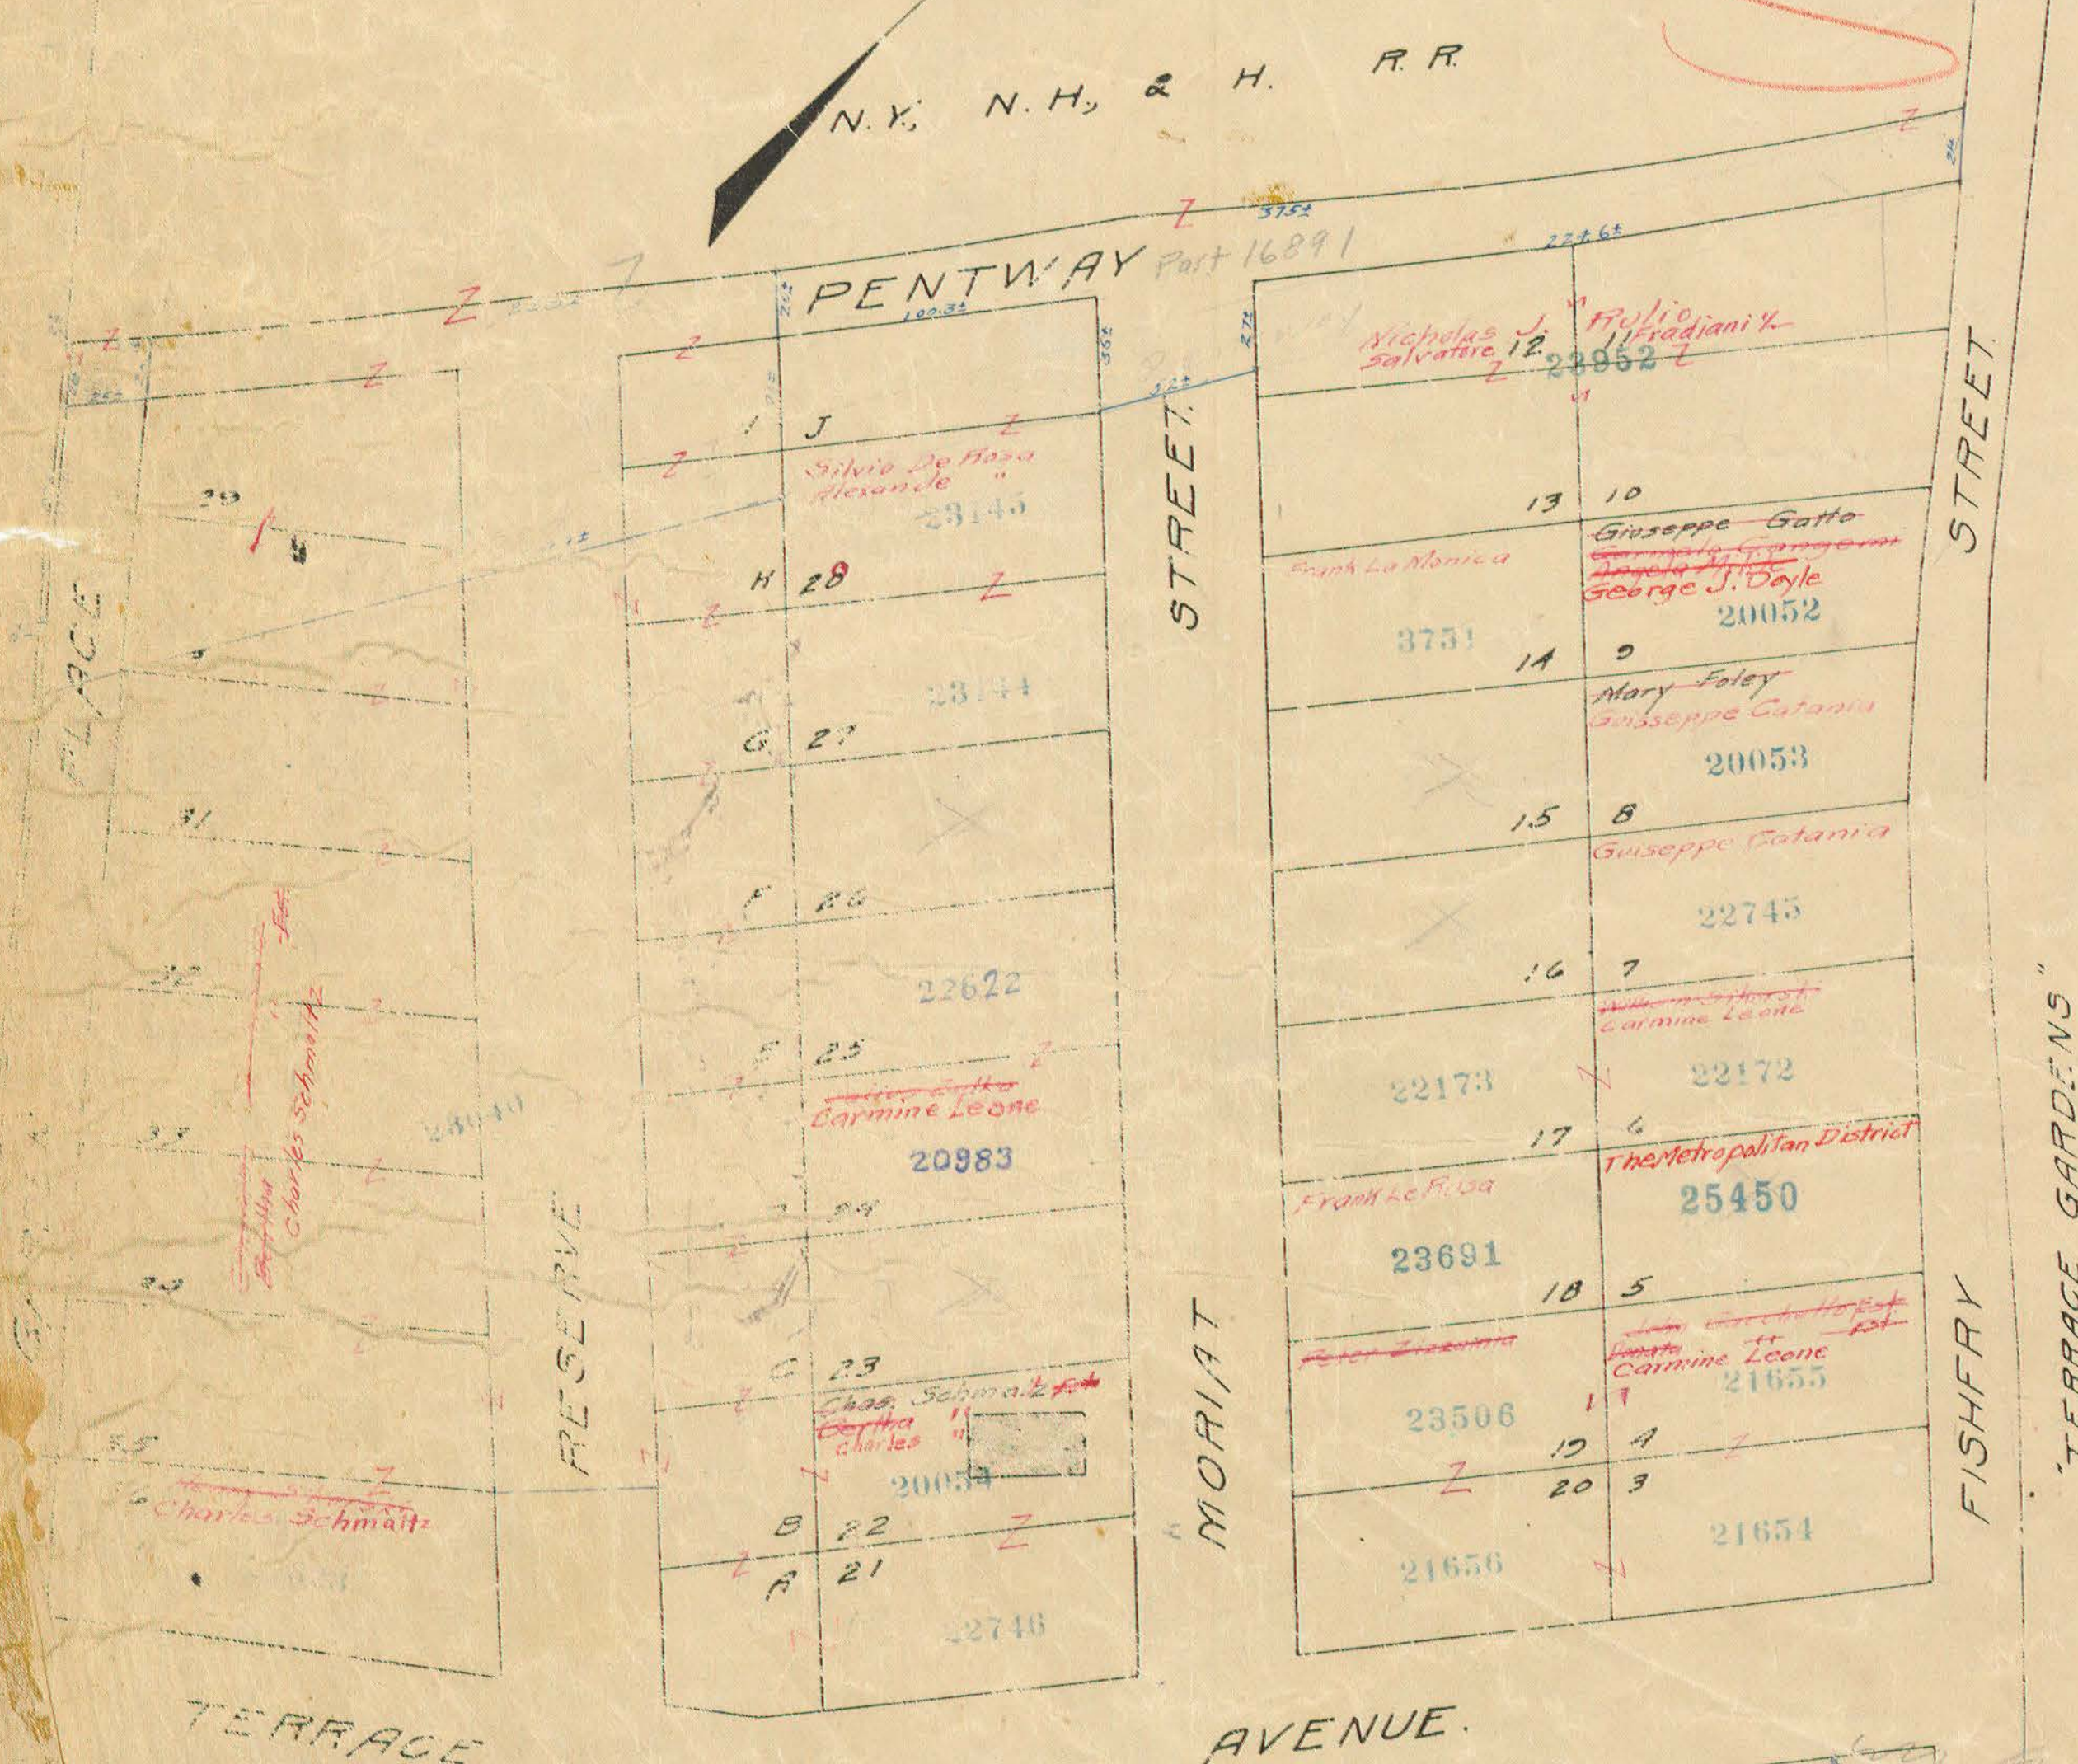
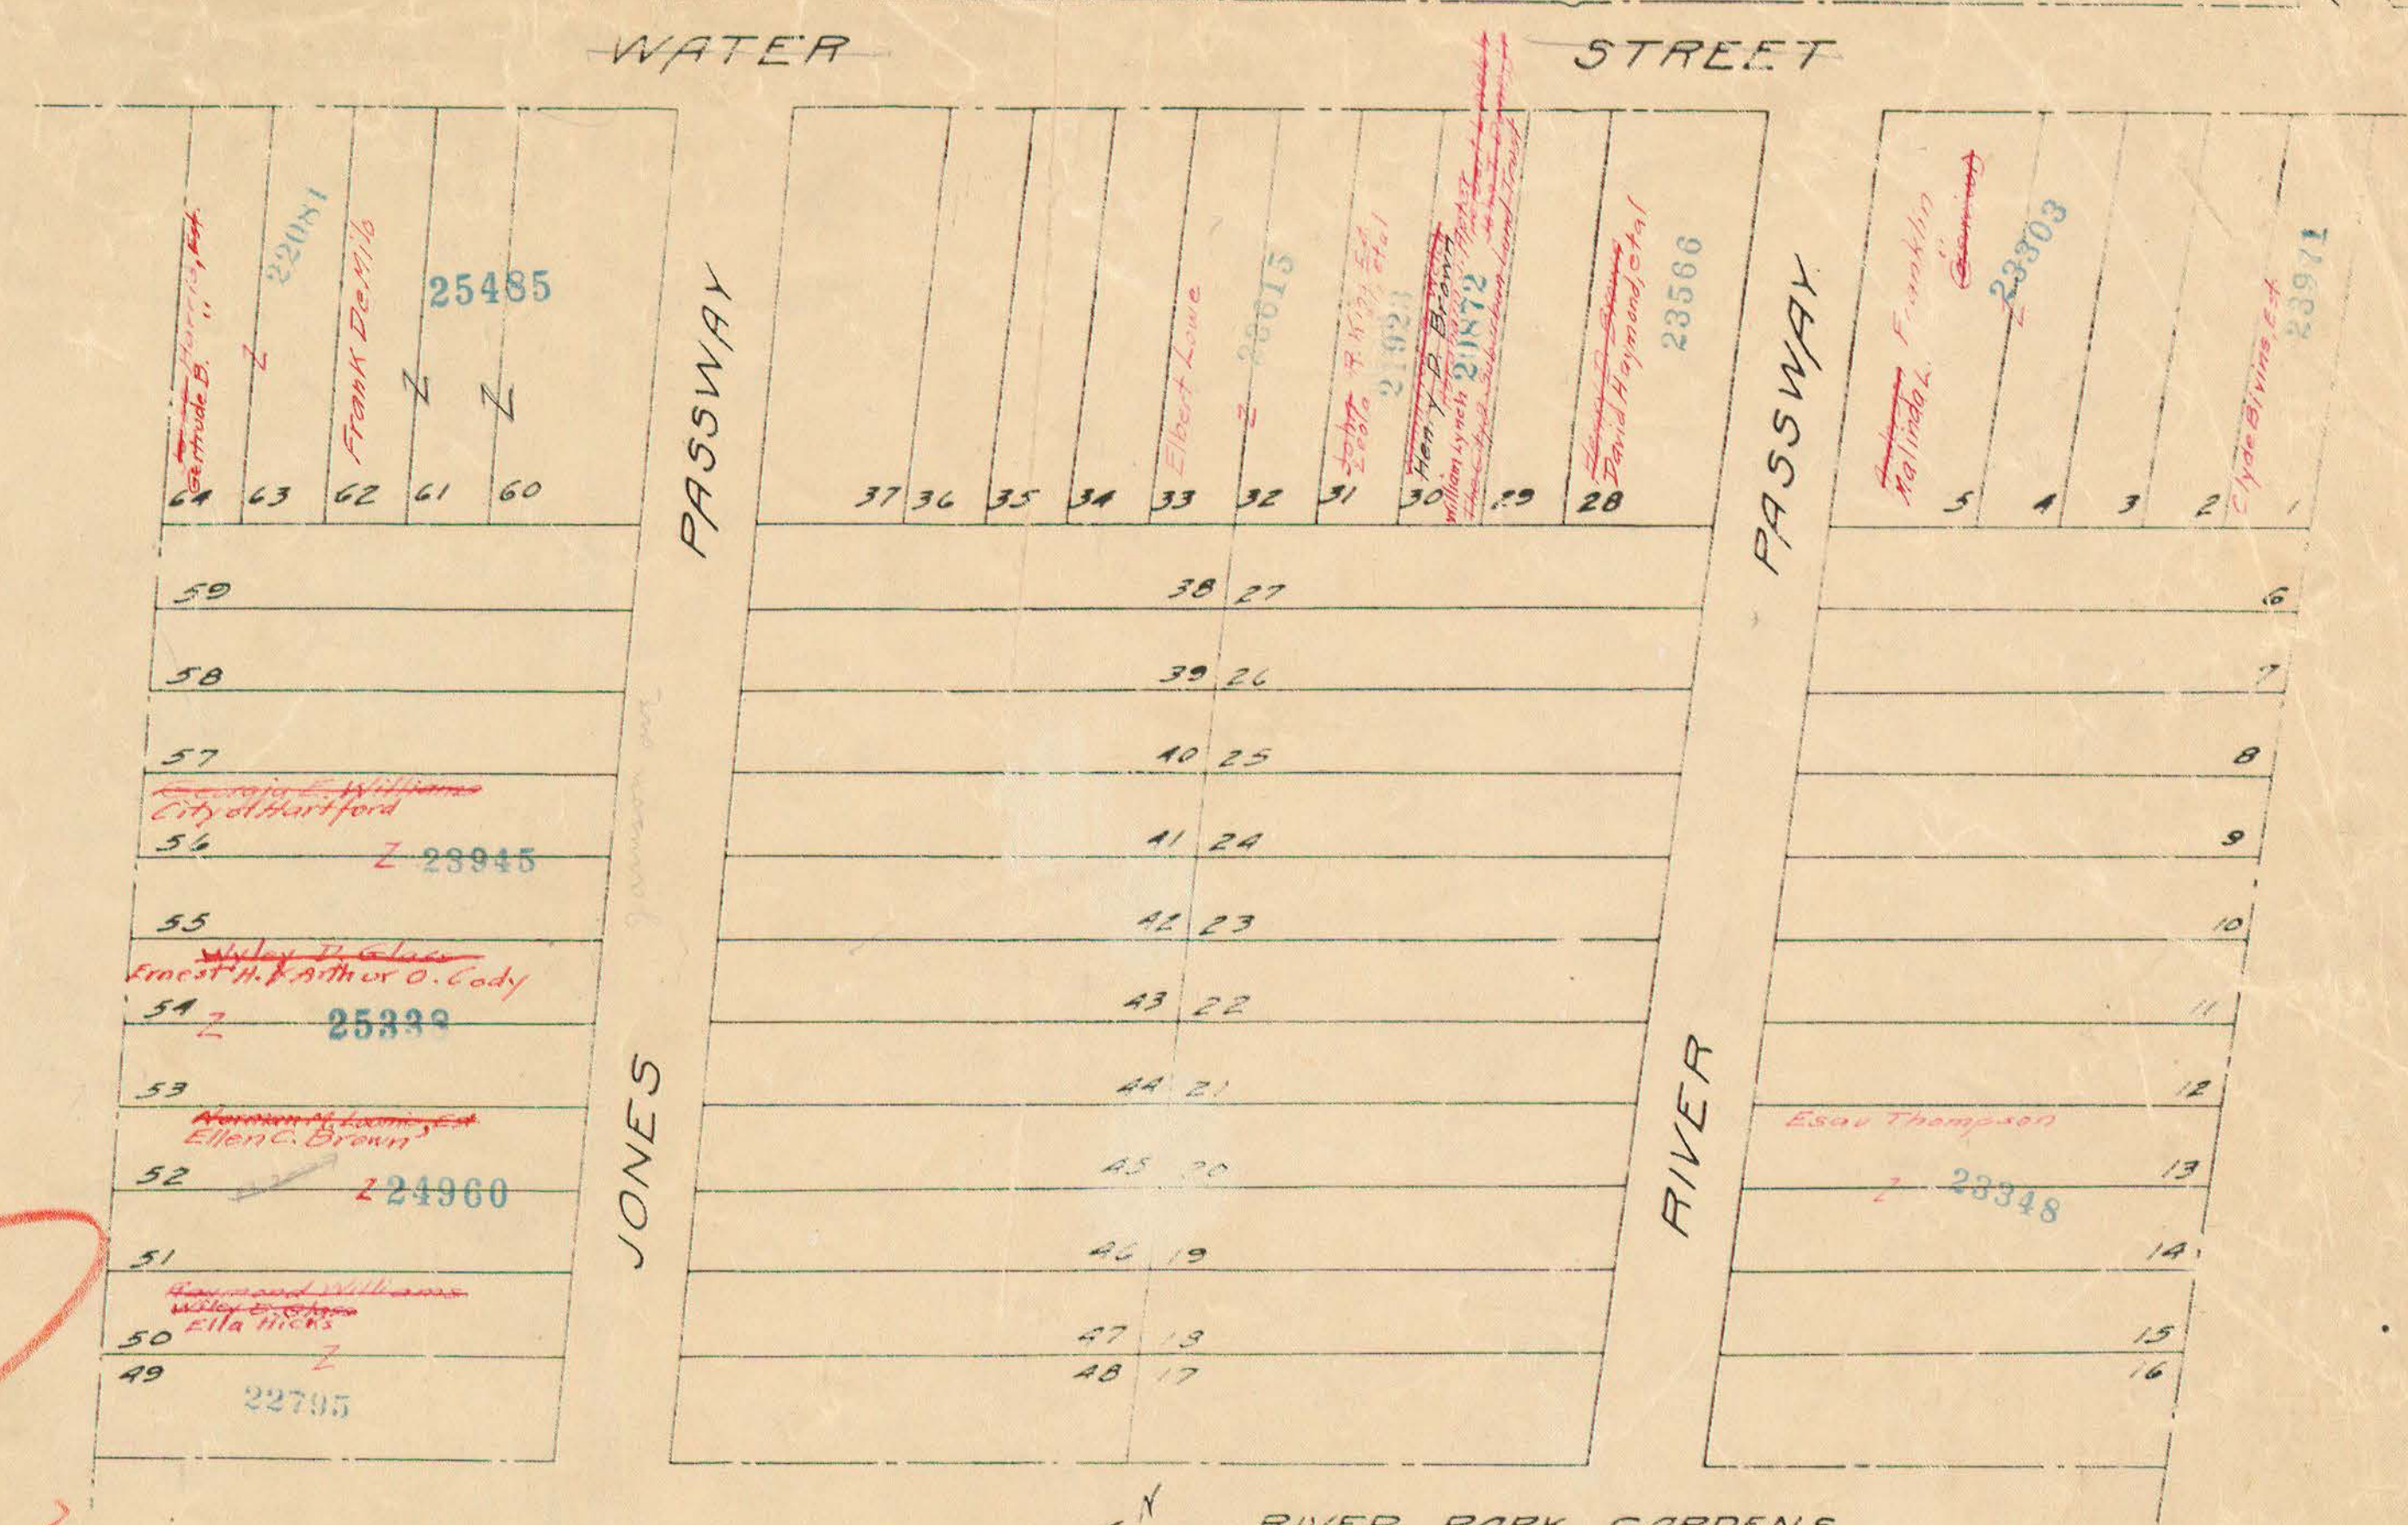


all blank lots owned by
The City of Hartford
The Hartford Estates Co.
Note: On first assignment of numbers mark Formerly Pt. 12177

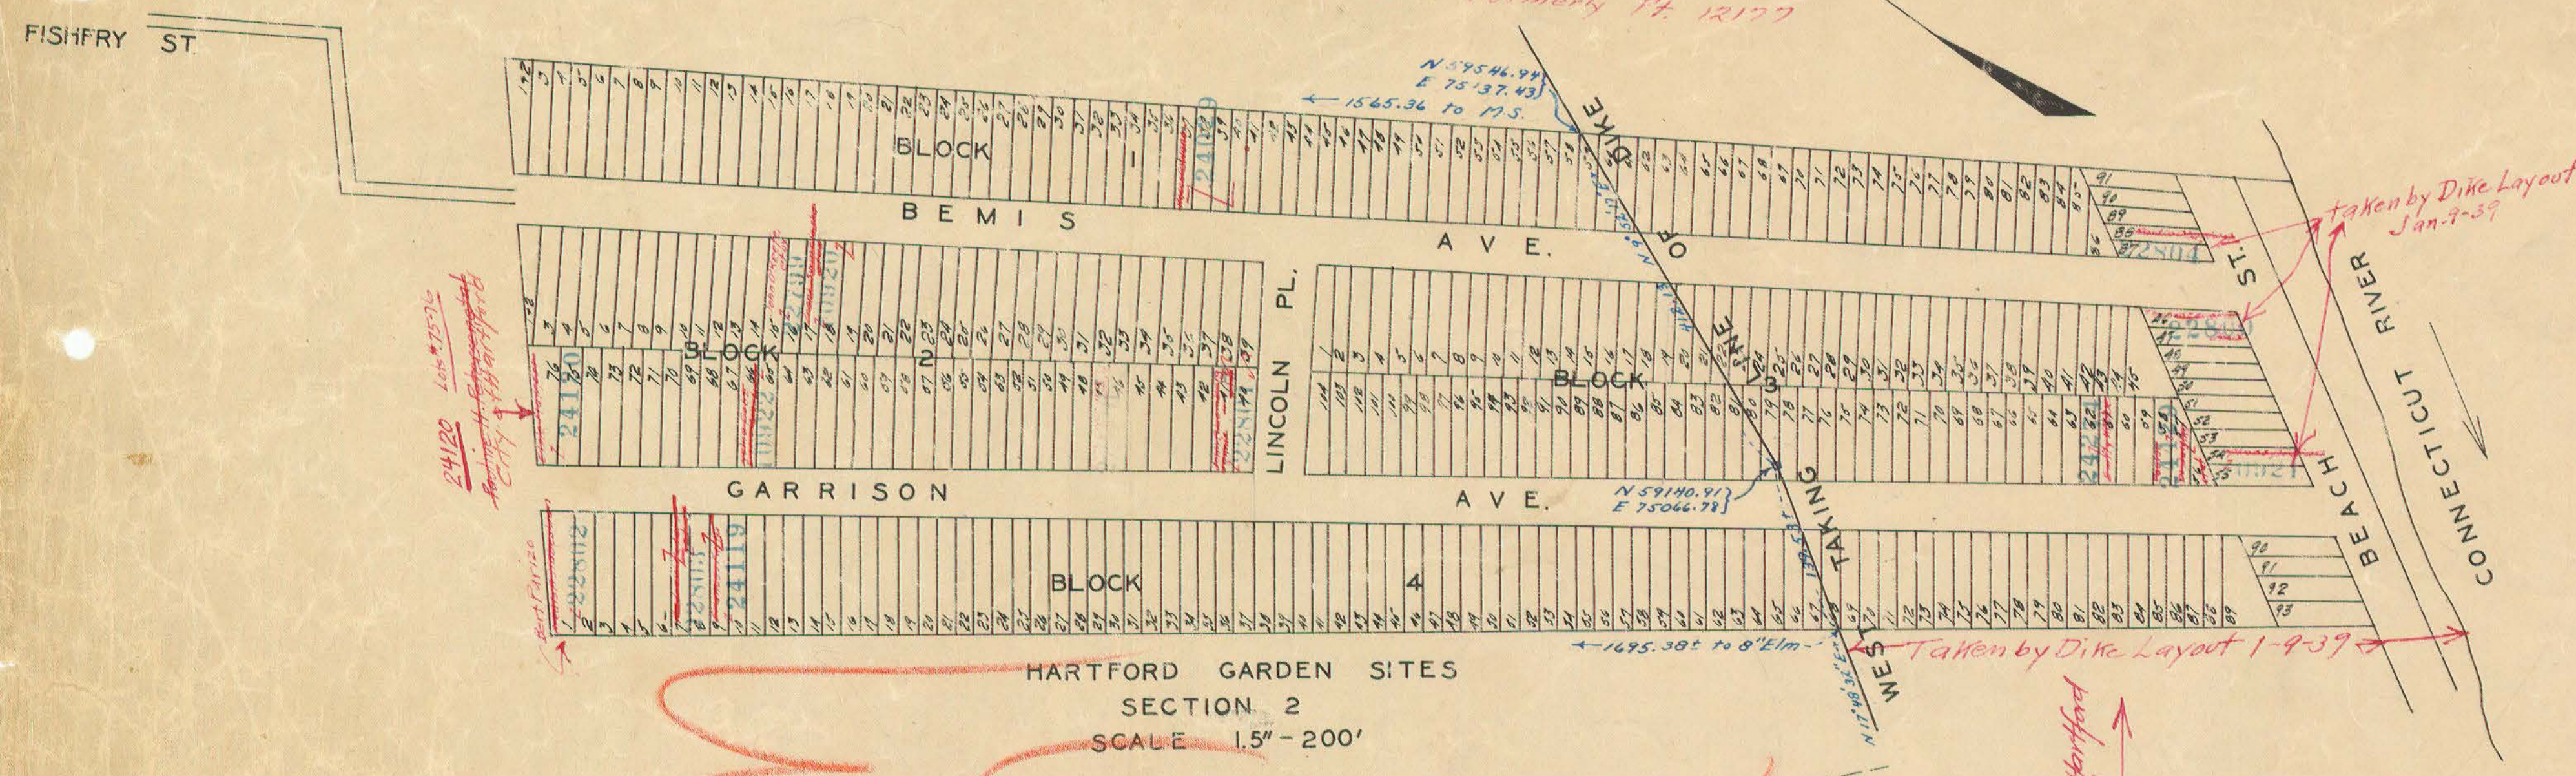

ALL STATED OWN PILES
24422 24423