
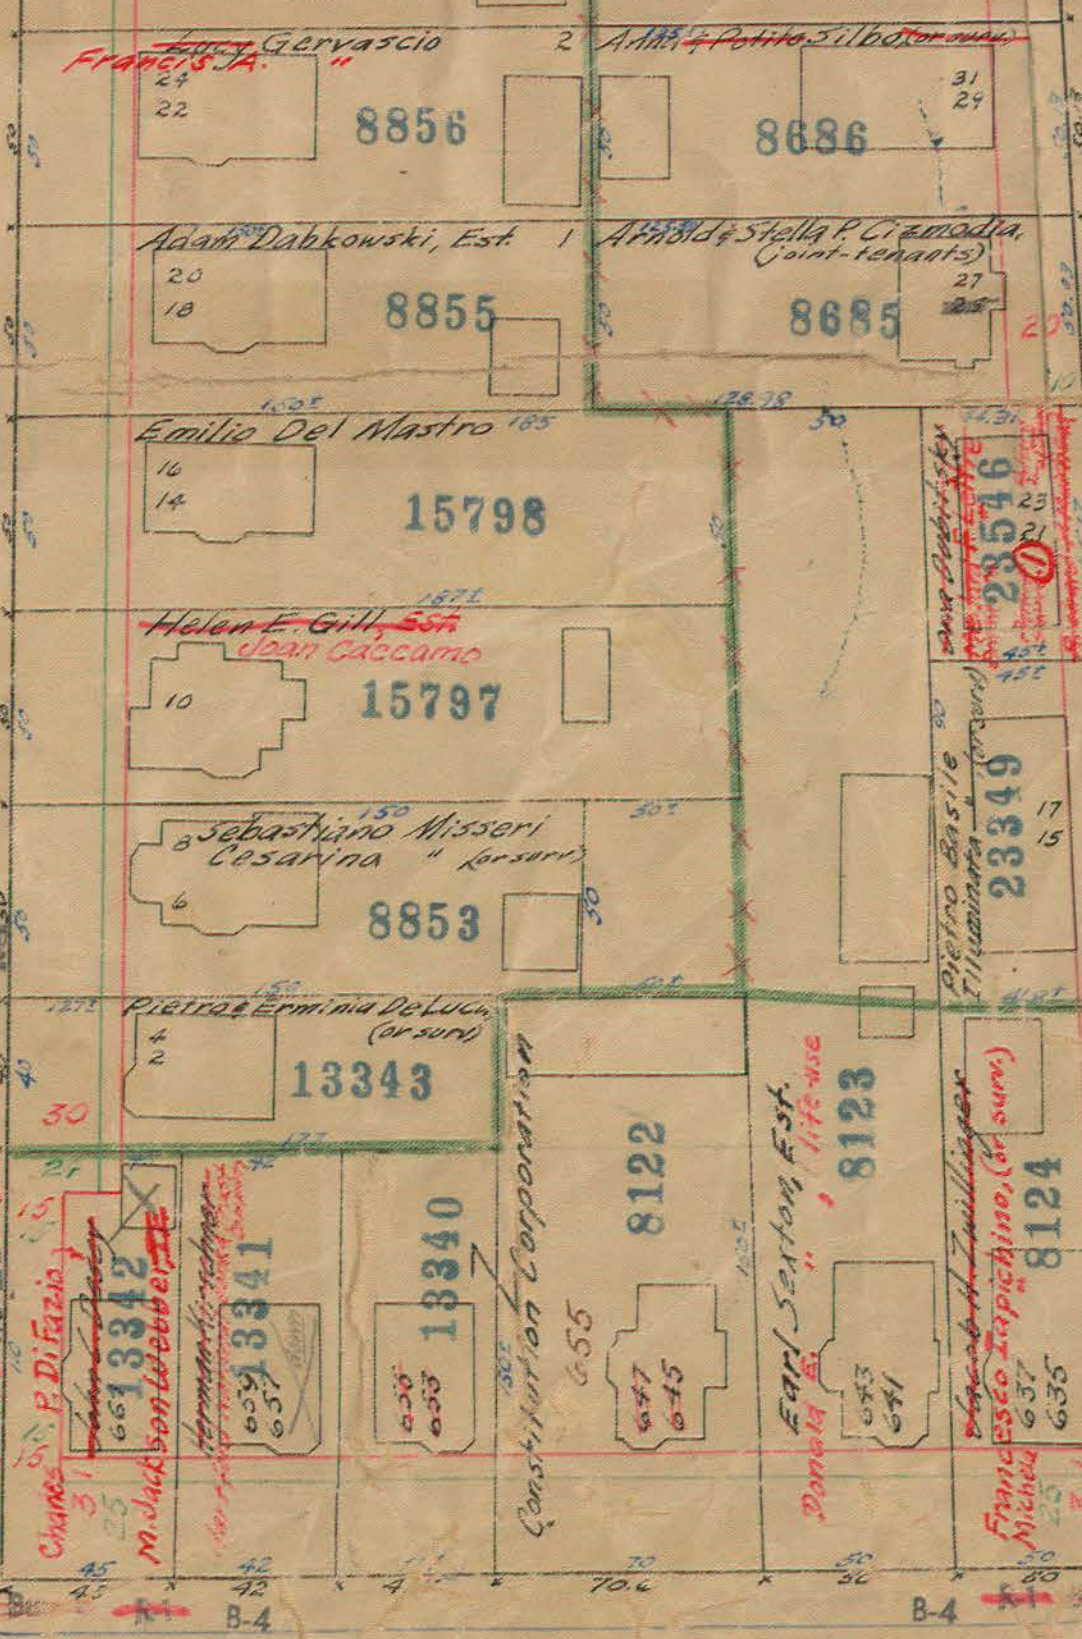
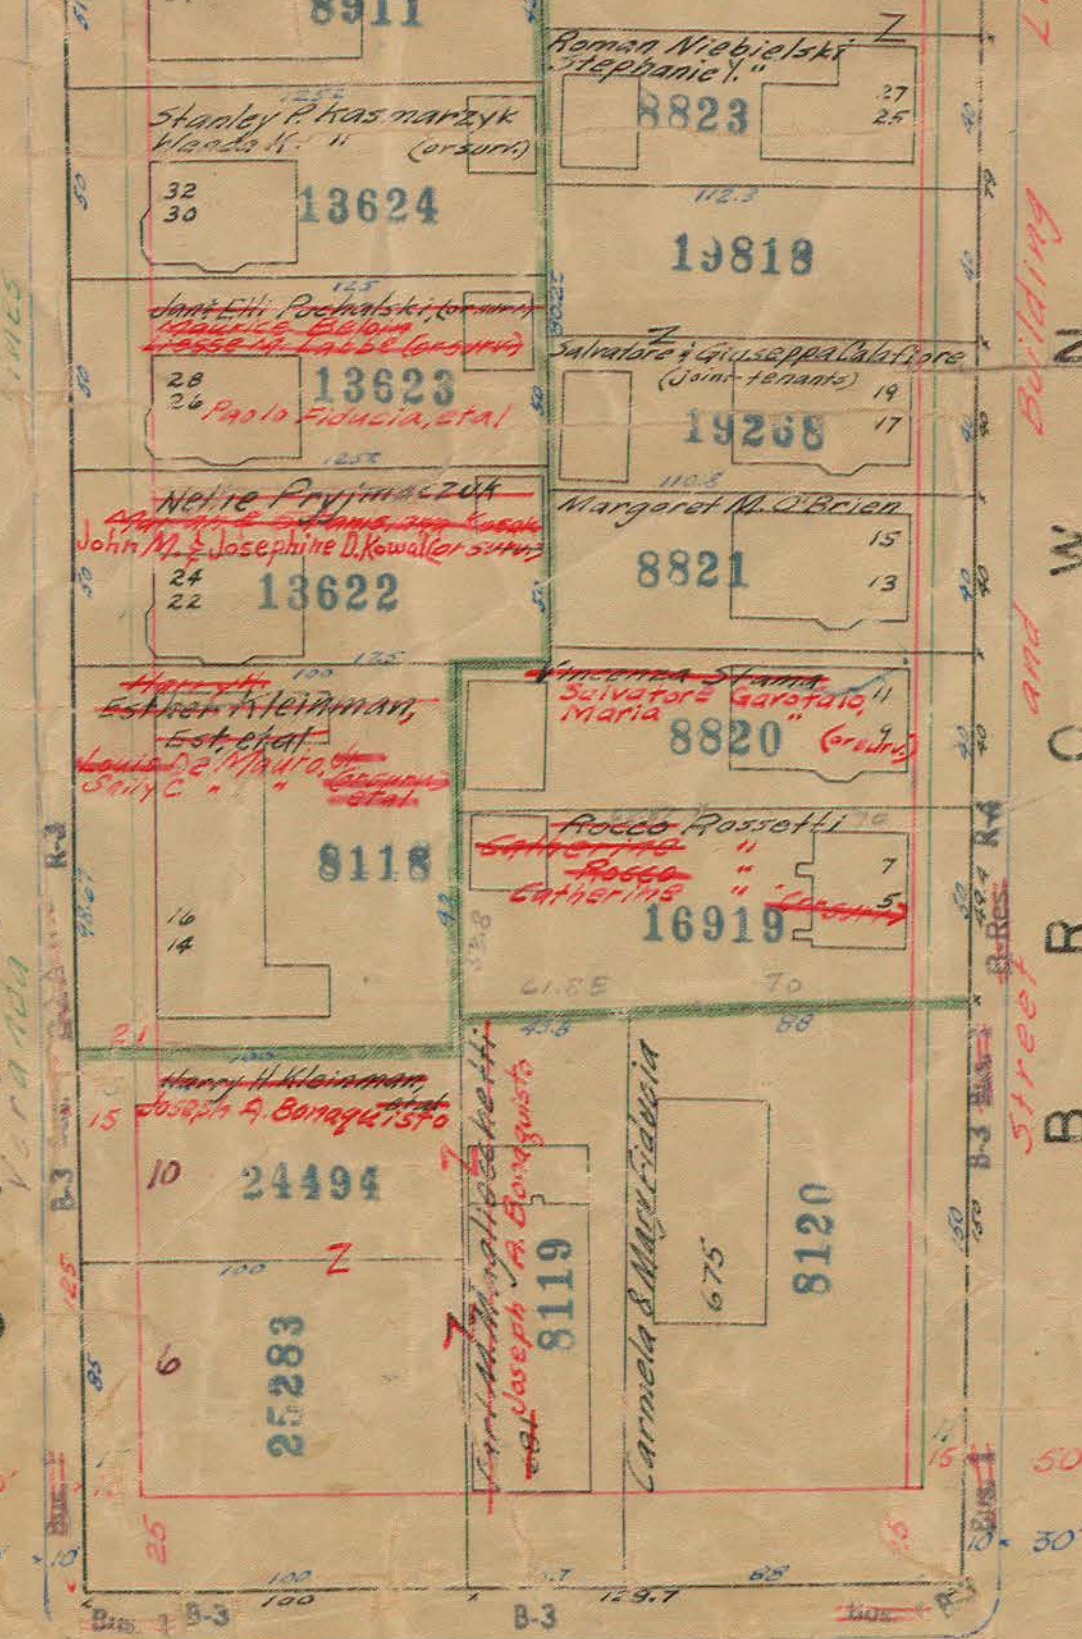
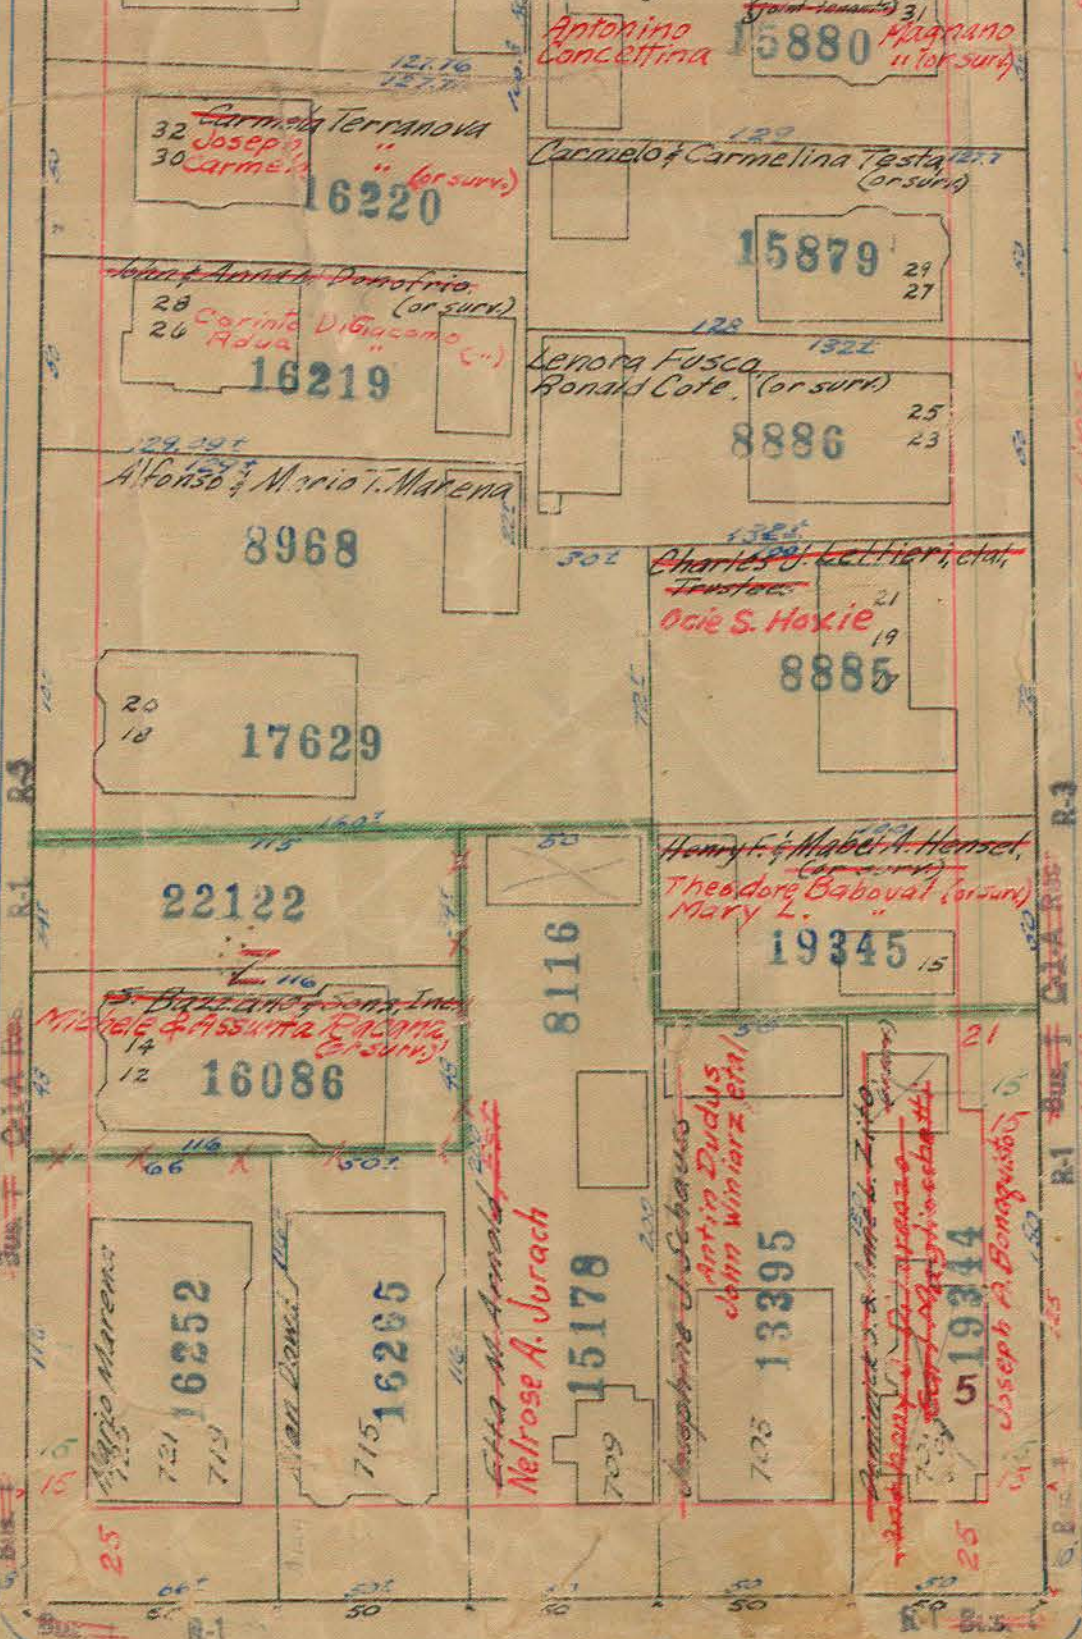
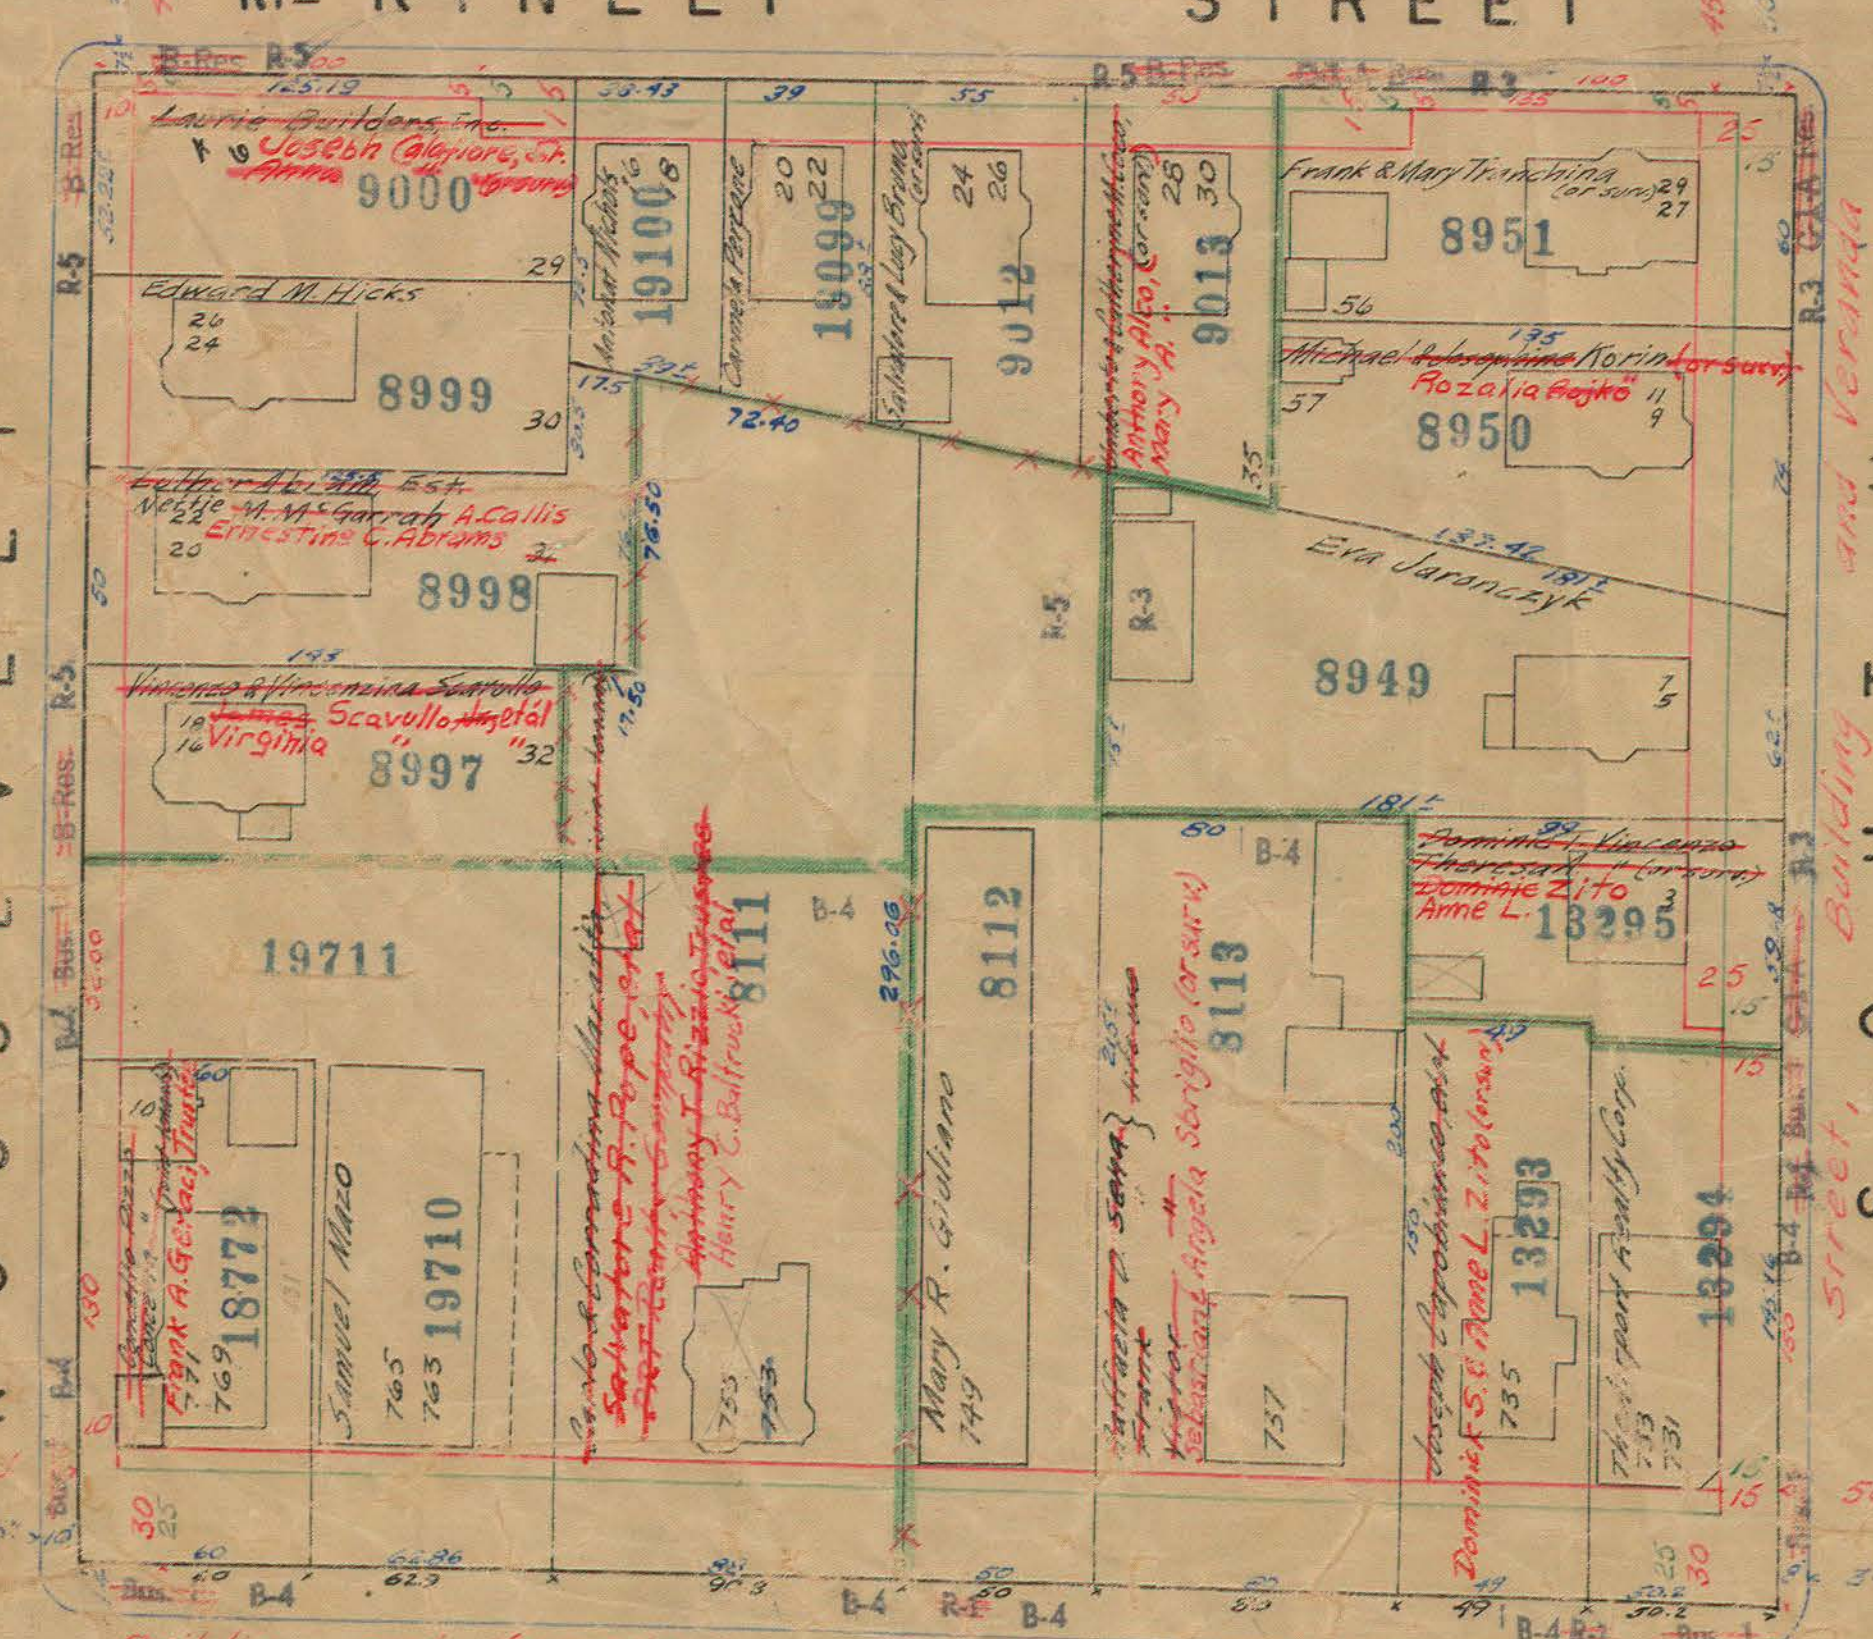
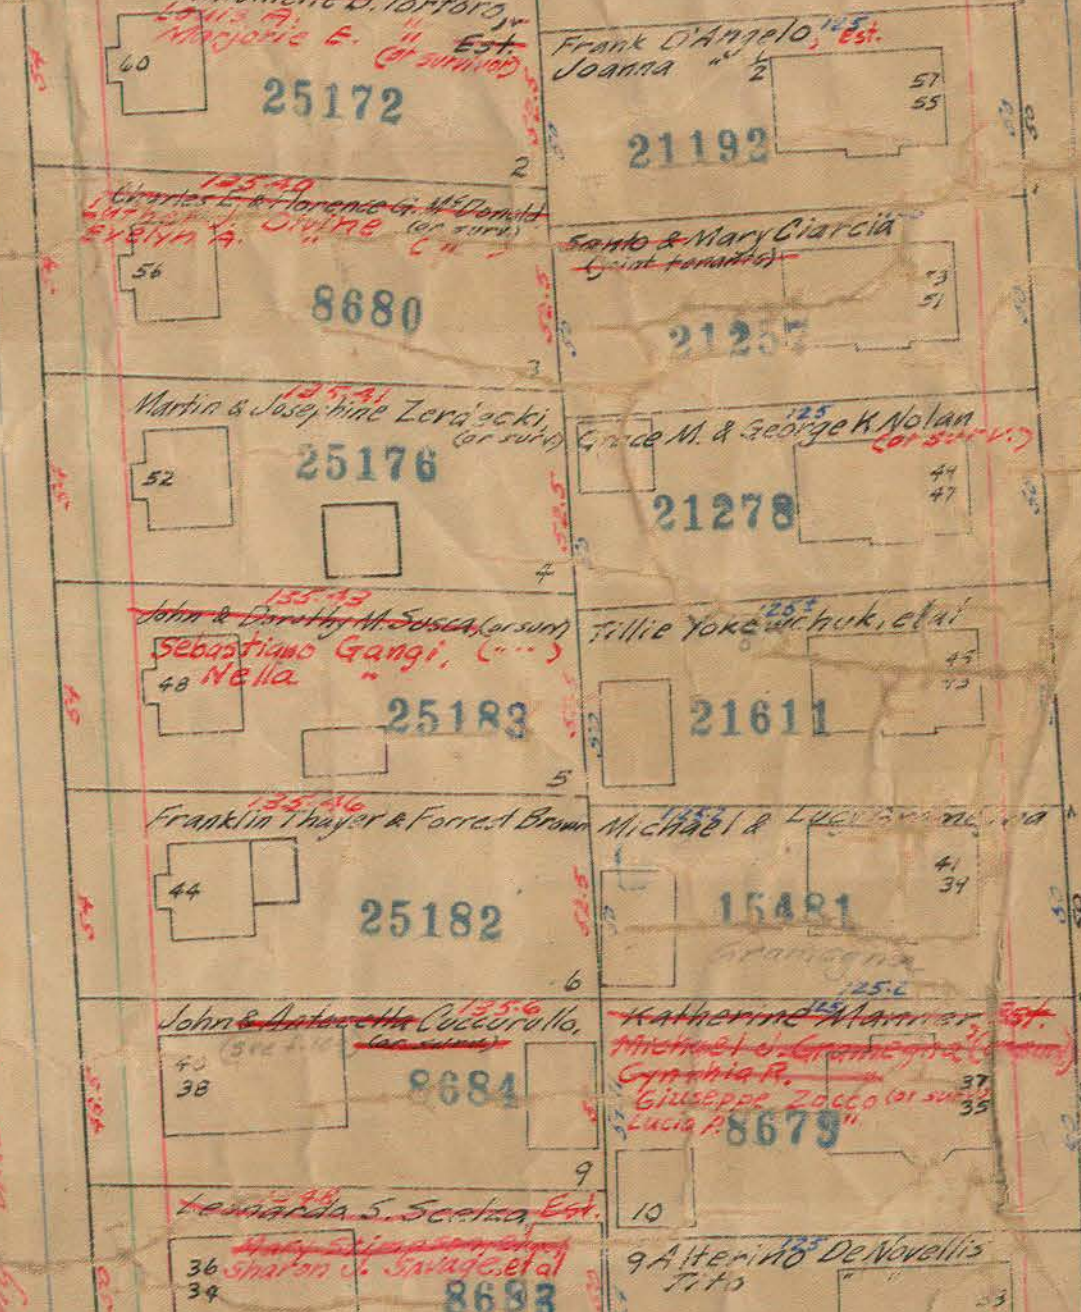
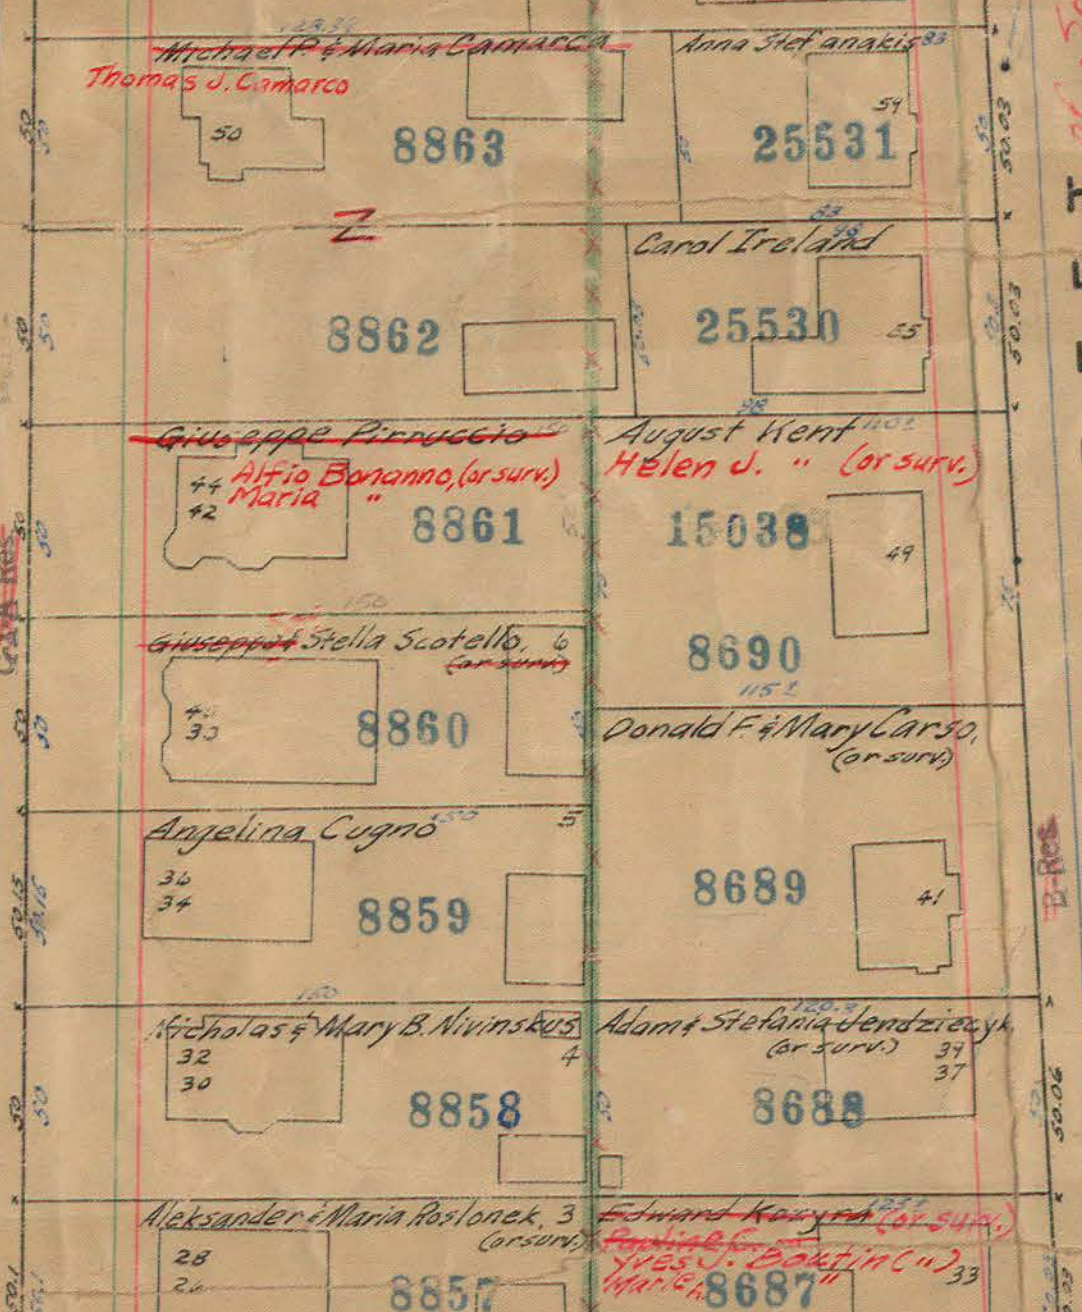
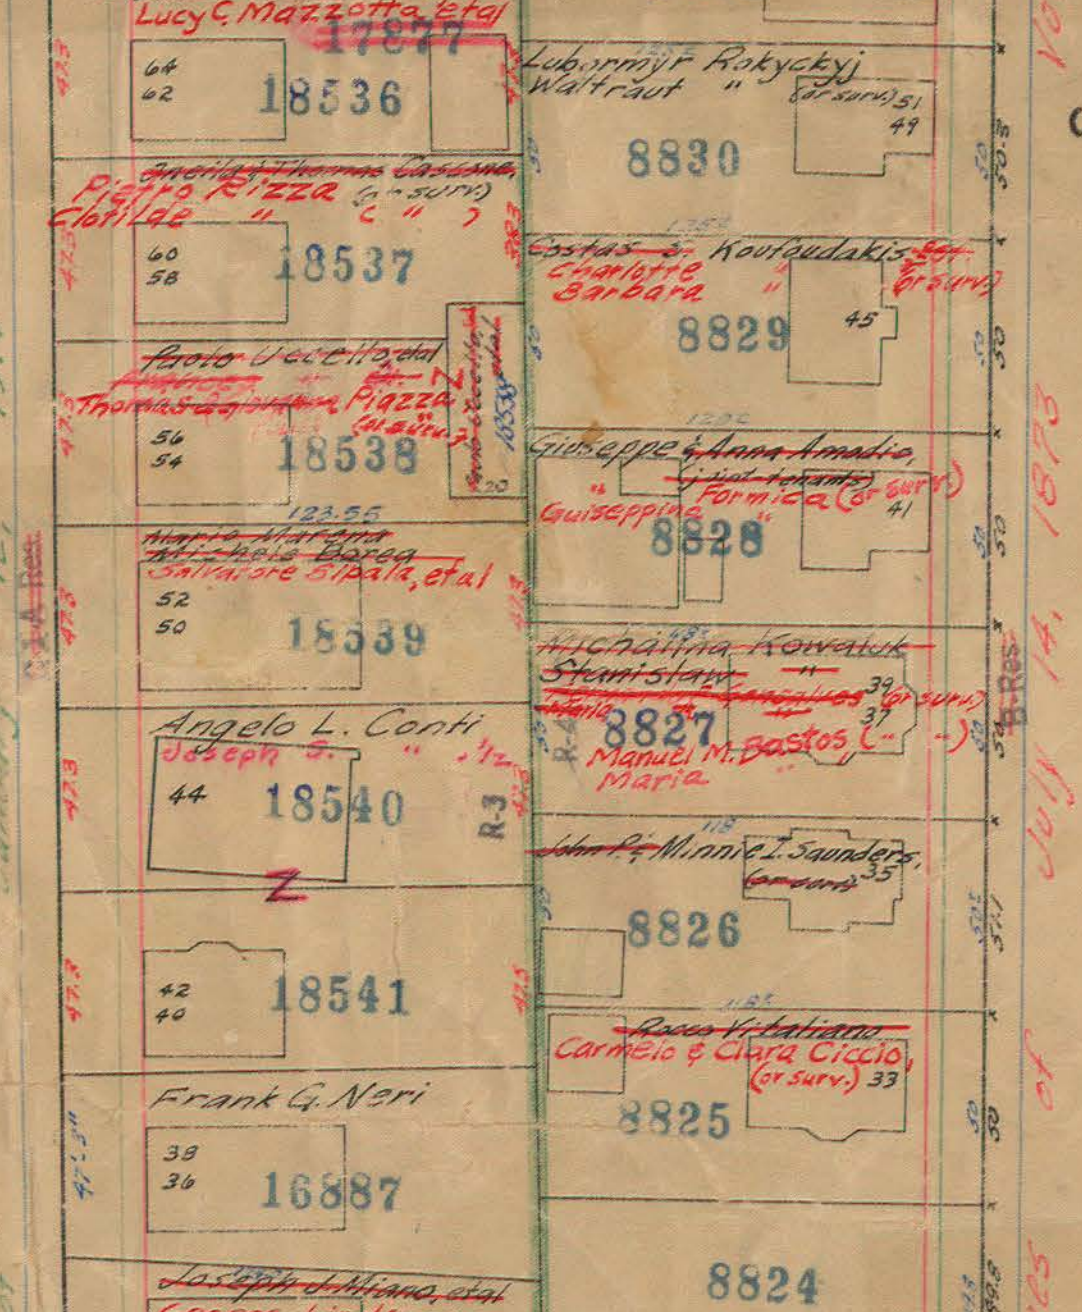
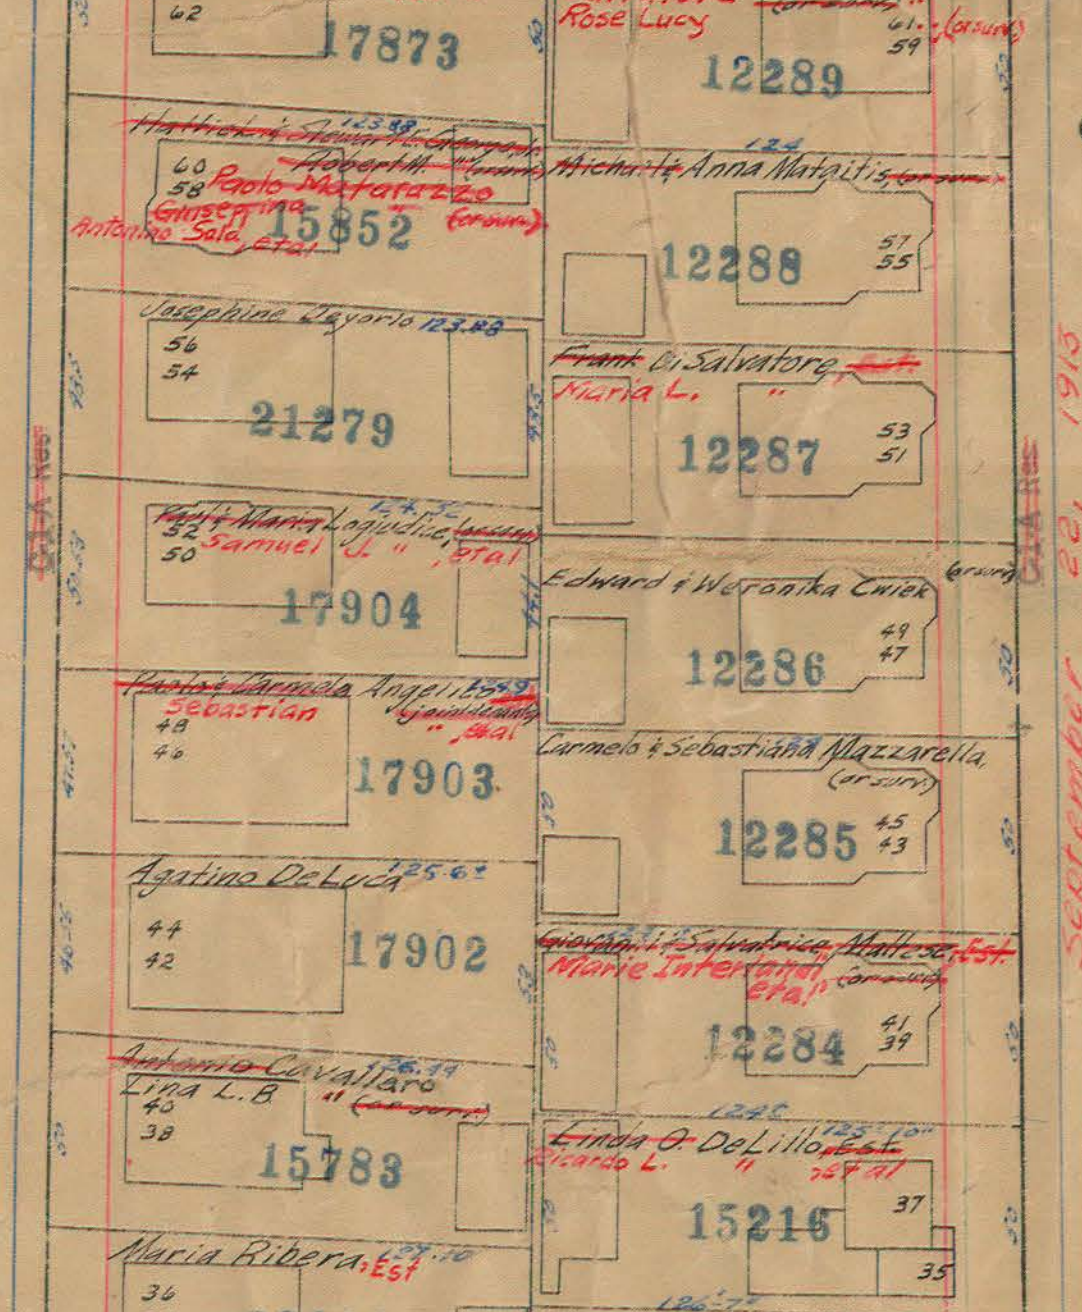
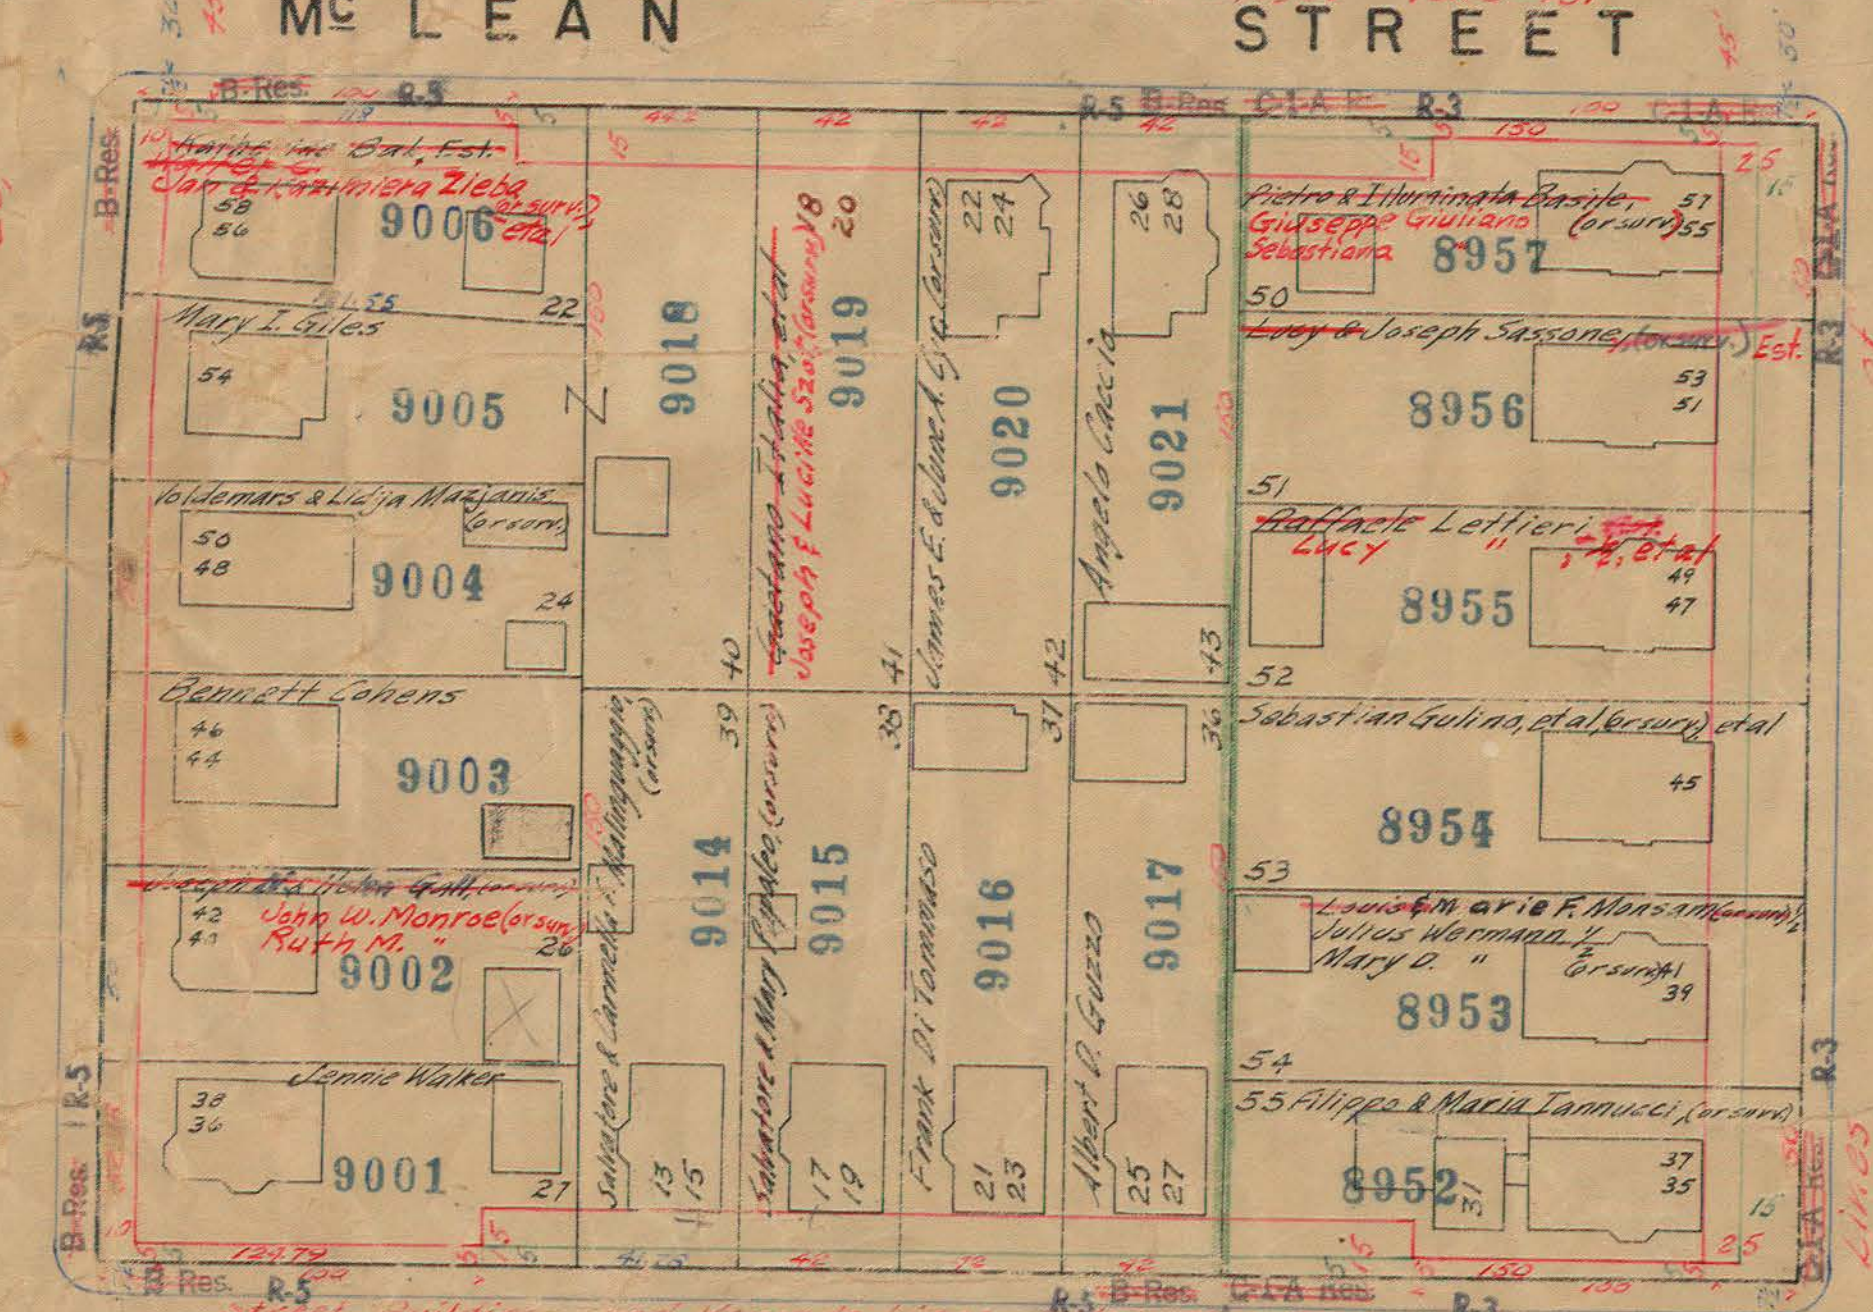
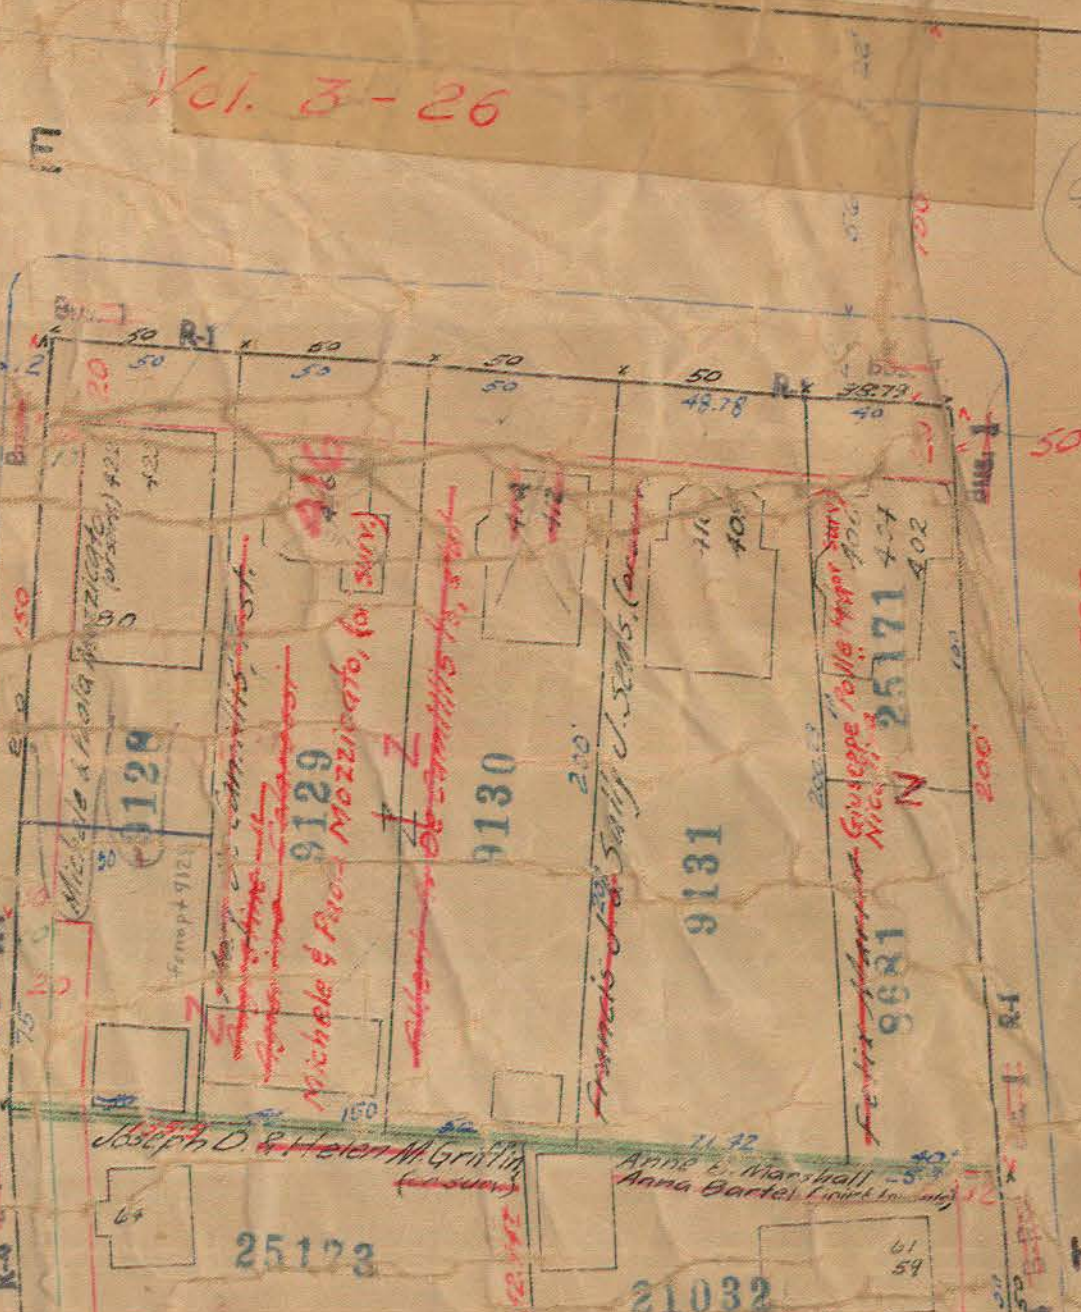
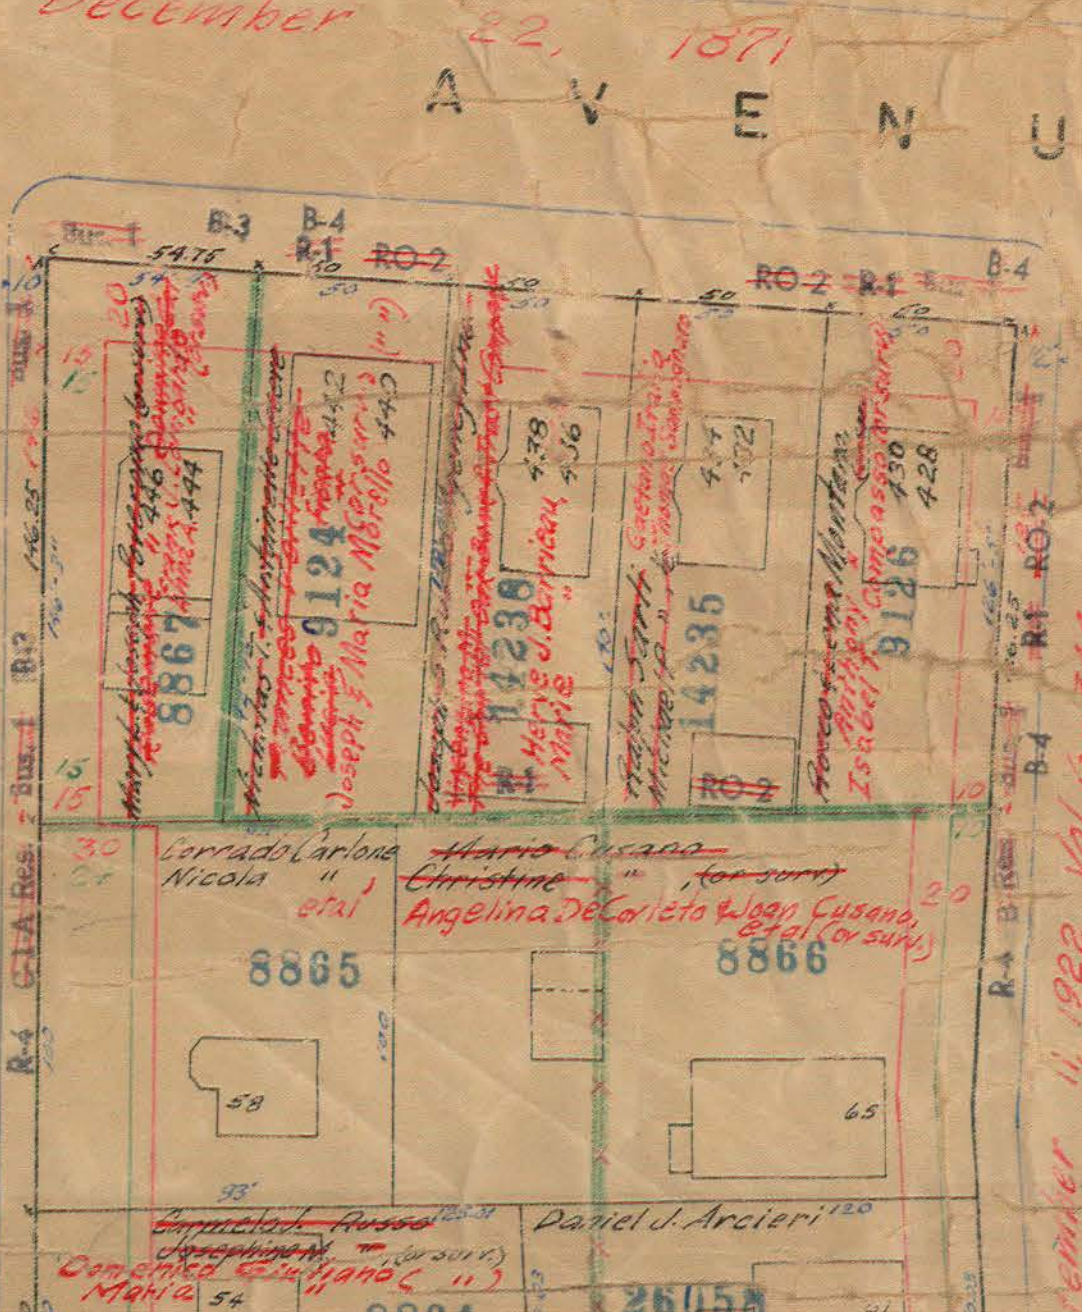
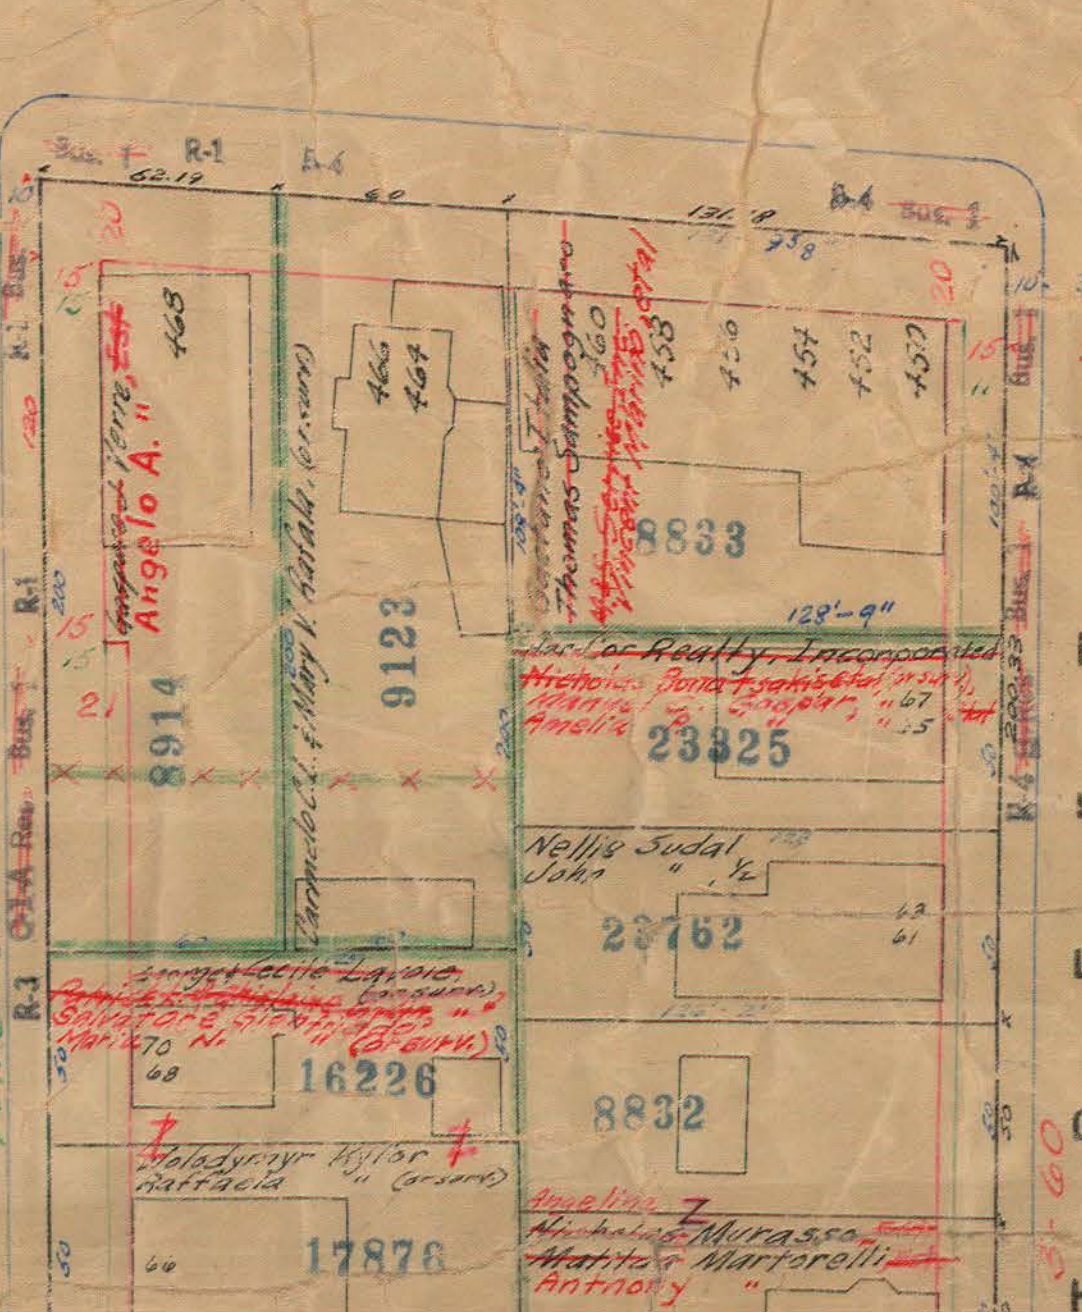
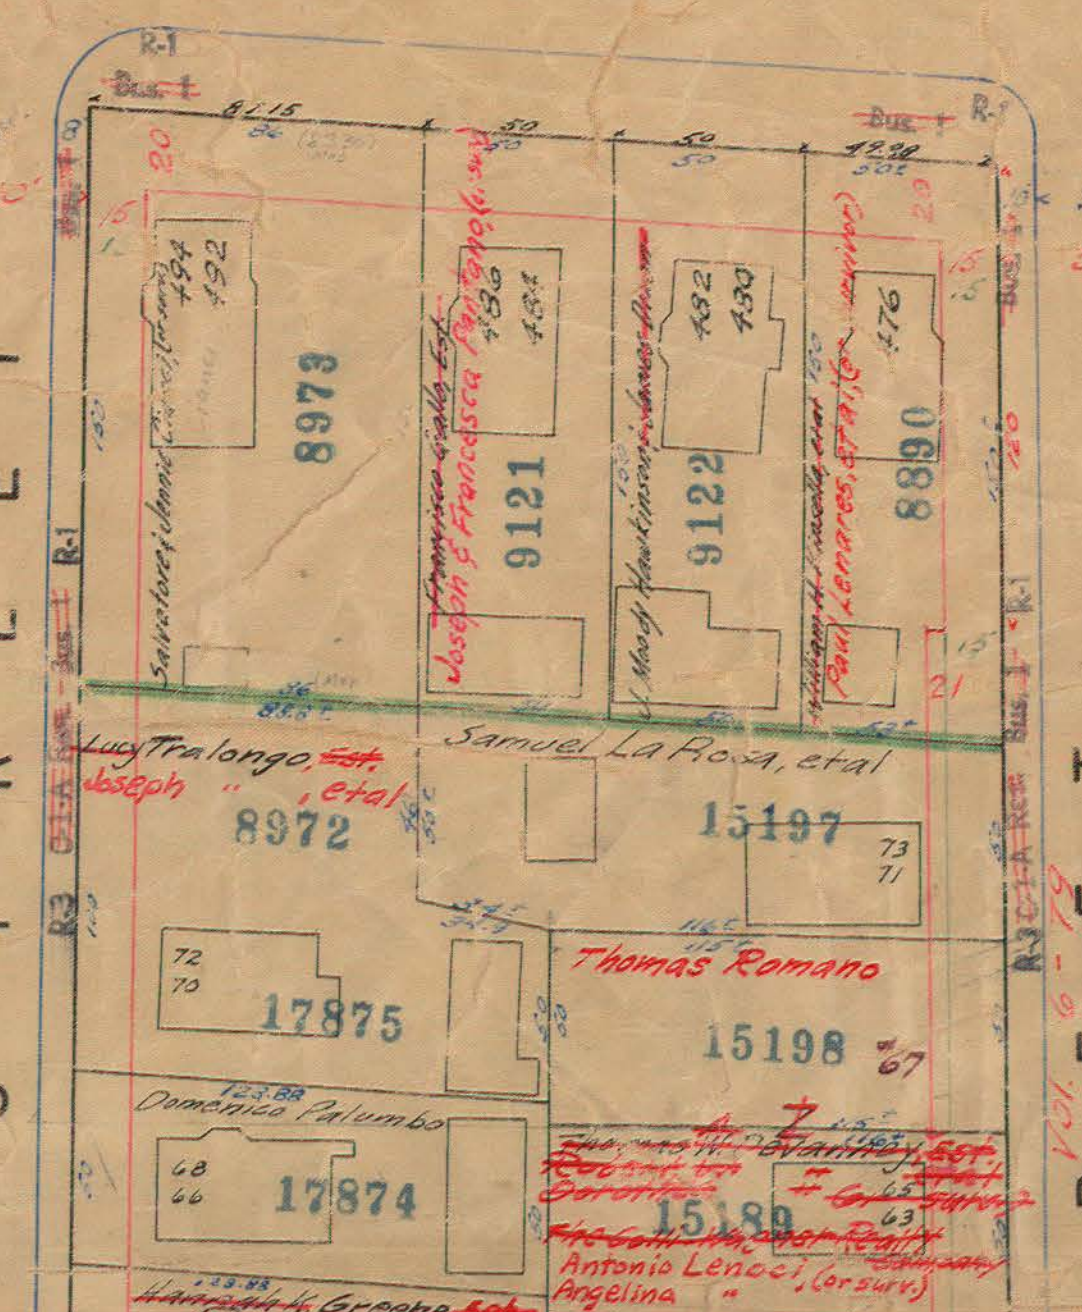


FRANKLIN

Building Lines

December 22, 1871
A V E N U E Vol. 3-26

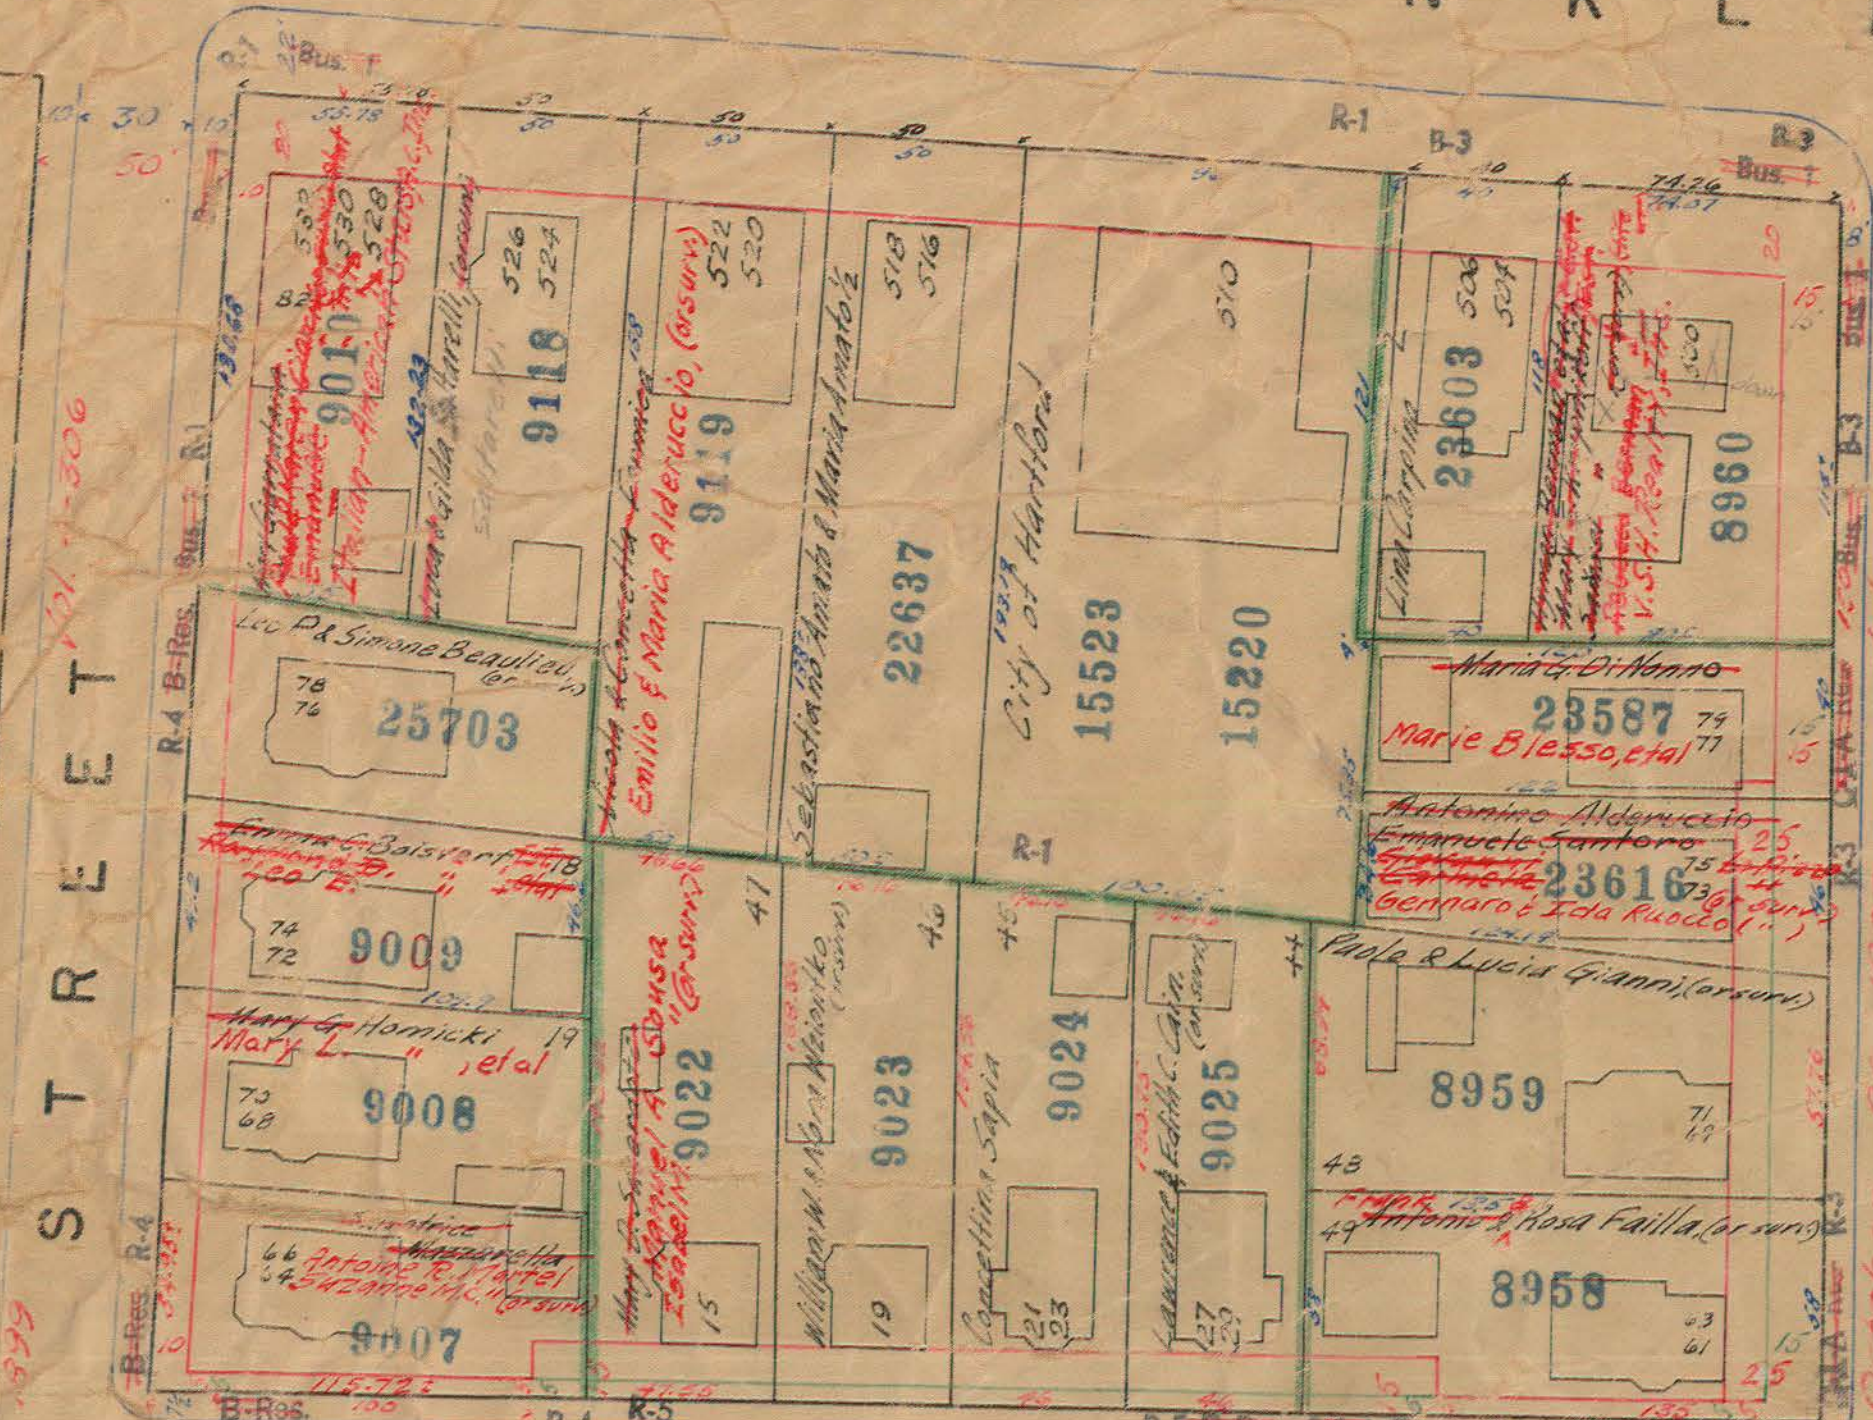

W E T H E R S F I E L D

A V E N U E