
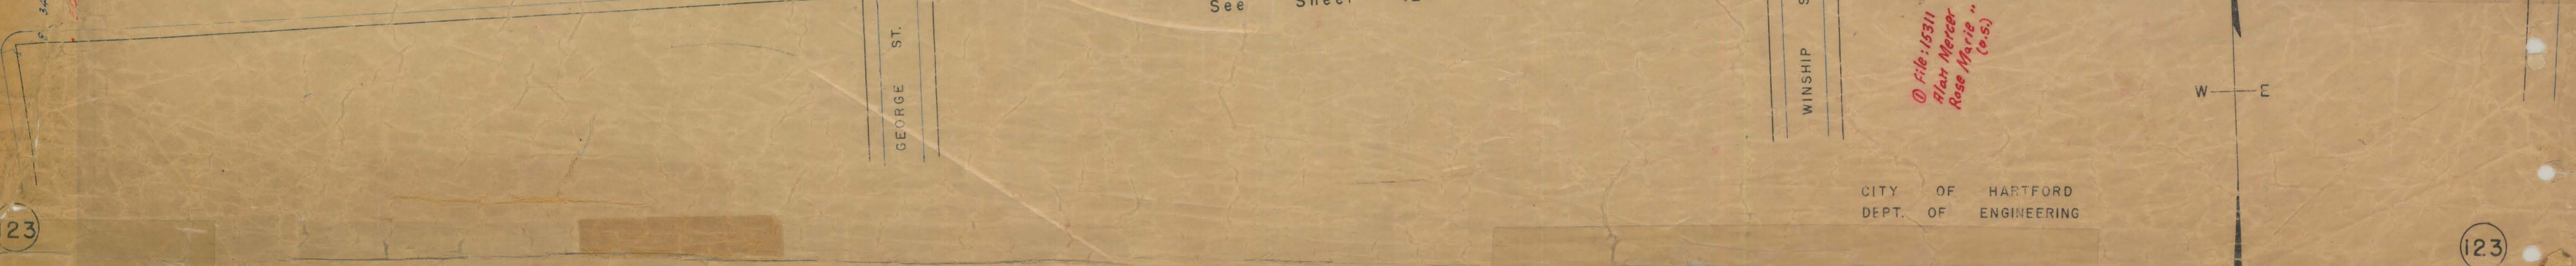
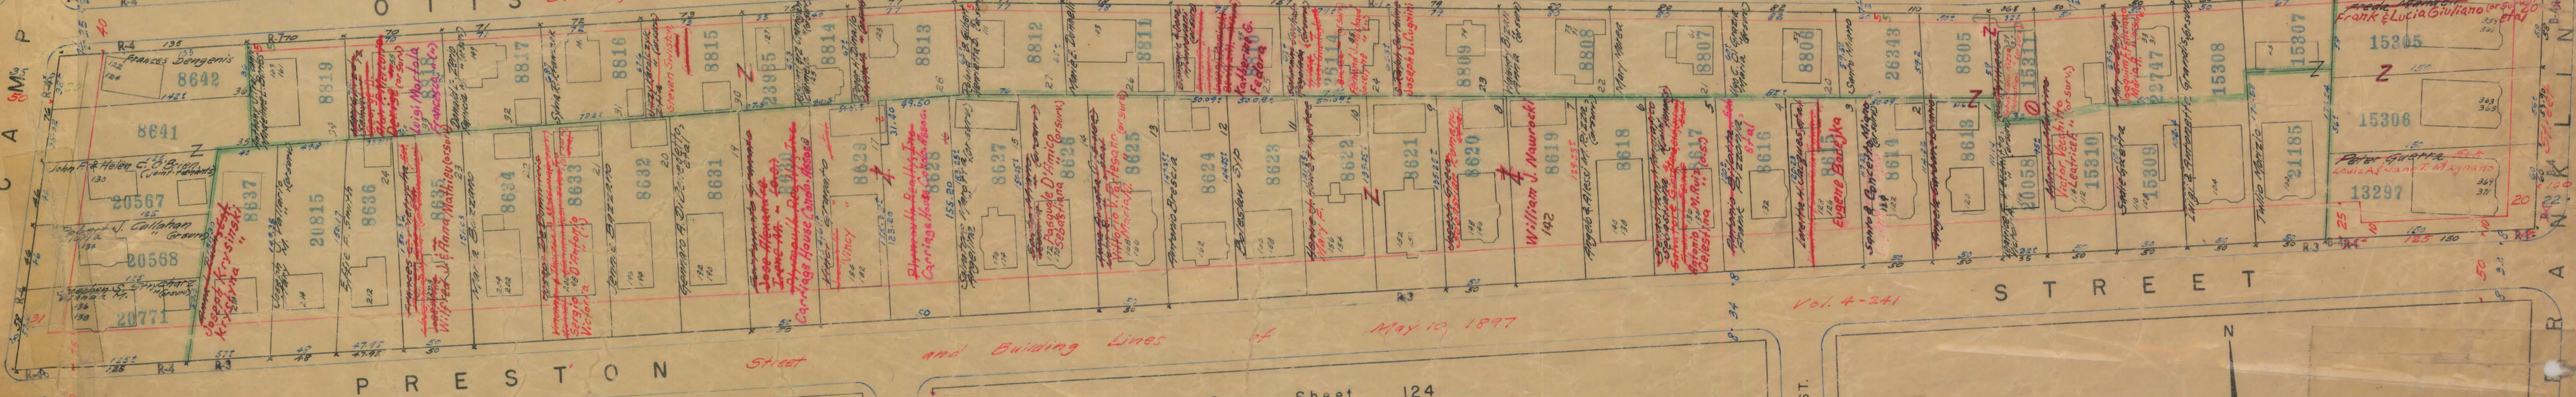
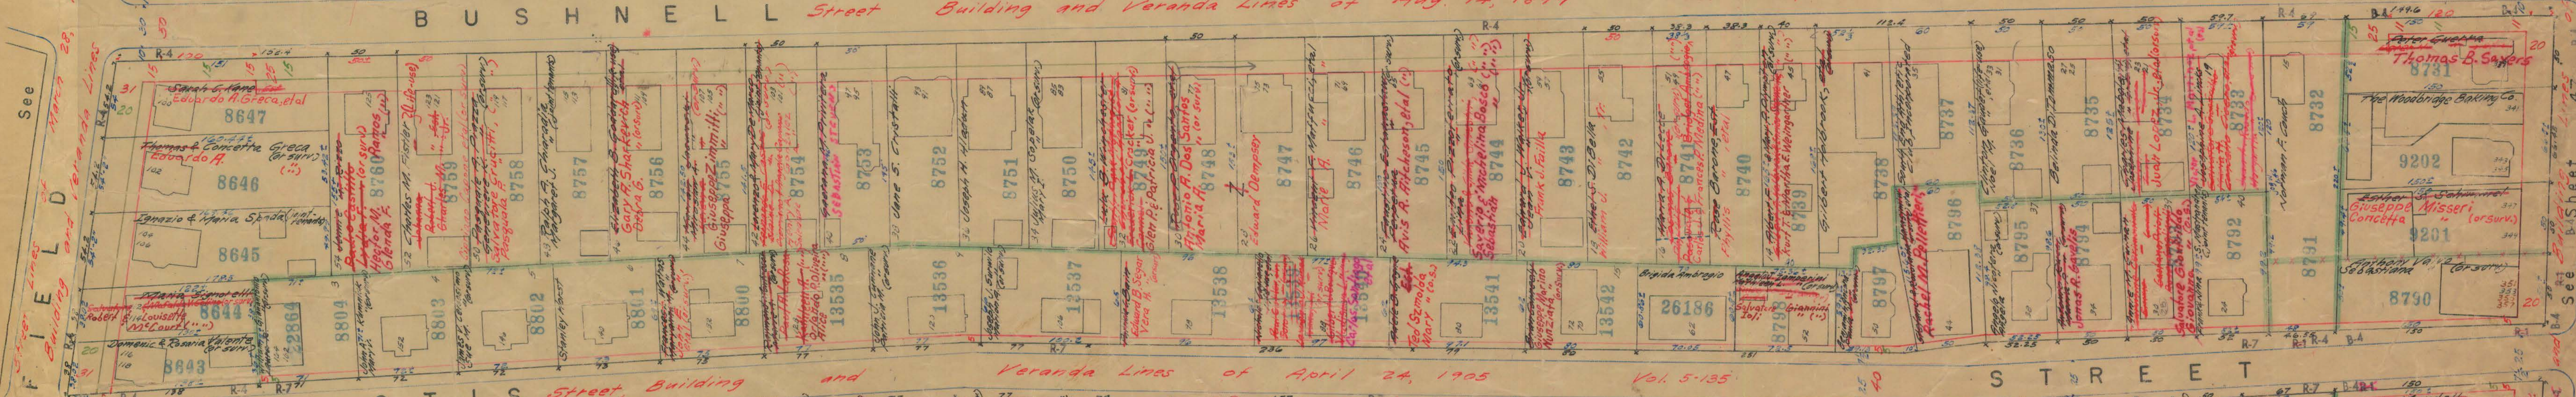


See Sheet 48

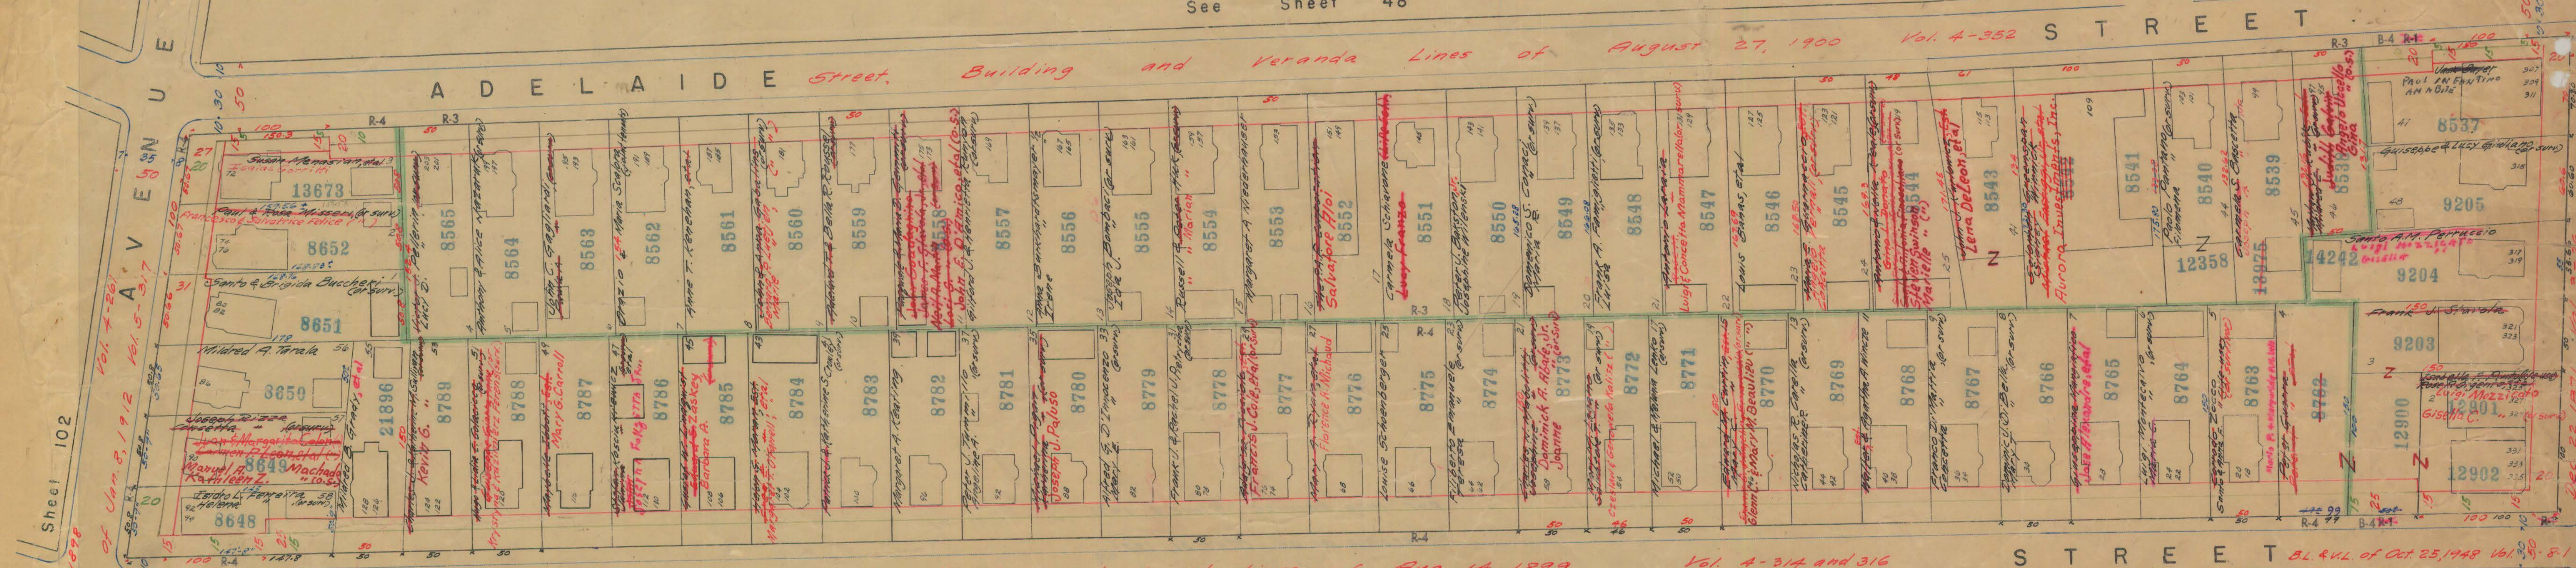

CITY OF HARTFORD
DEPT. OF ENGINEERING

File 15311
Alex Mercer
Rose Marie
(o.s.)