


PRESTON

Street and Building Lines of May 10, 1897


Vol. 4-241

STREET

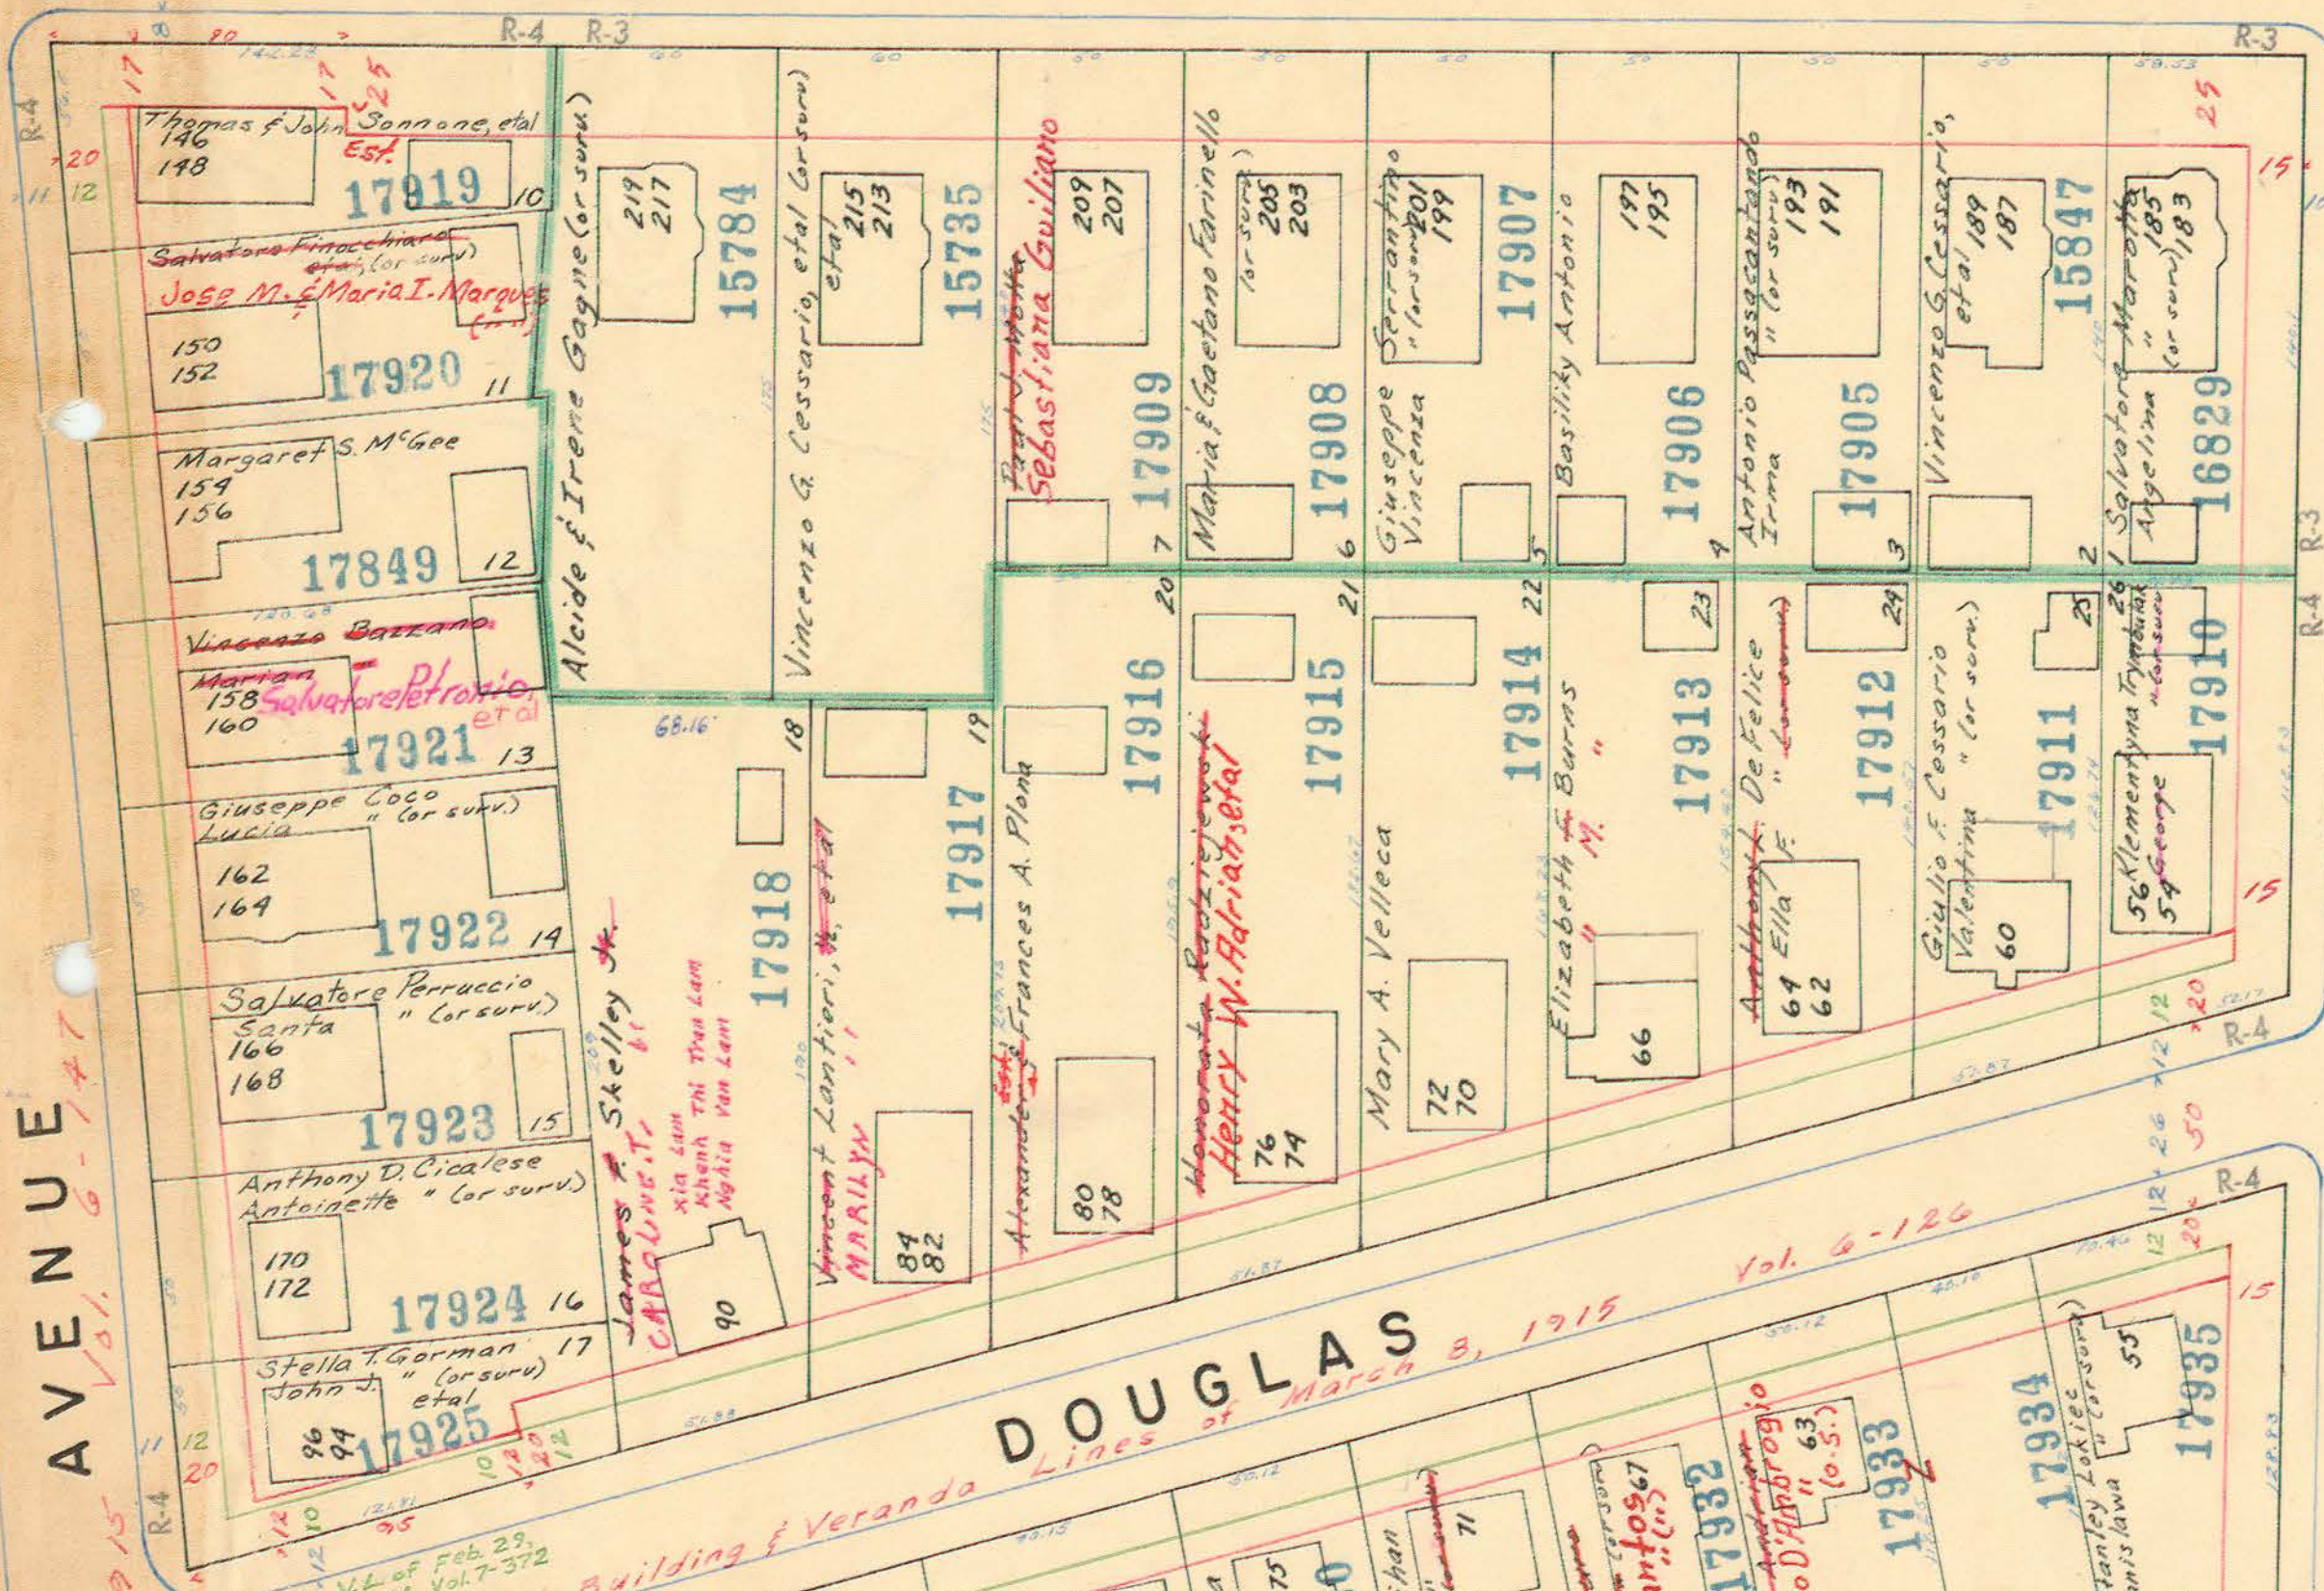


DOUGLAS

Street, Building & Veranda Lines of March 8, 1915 Vol. 6-126

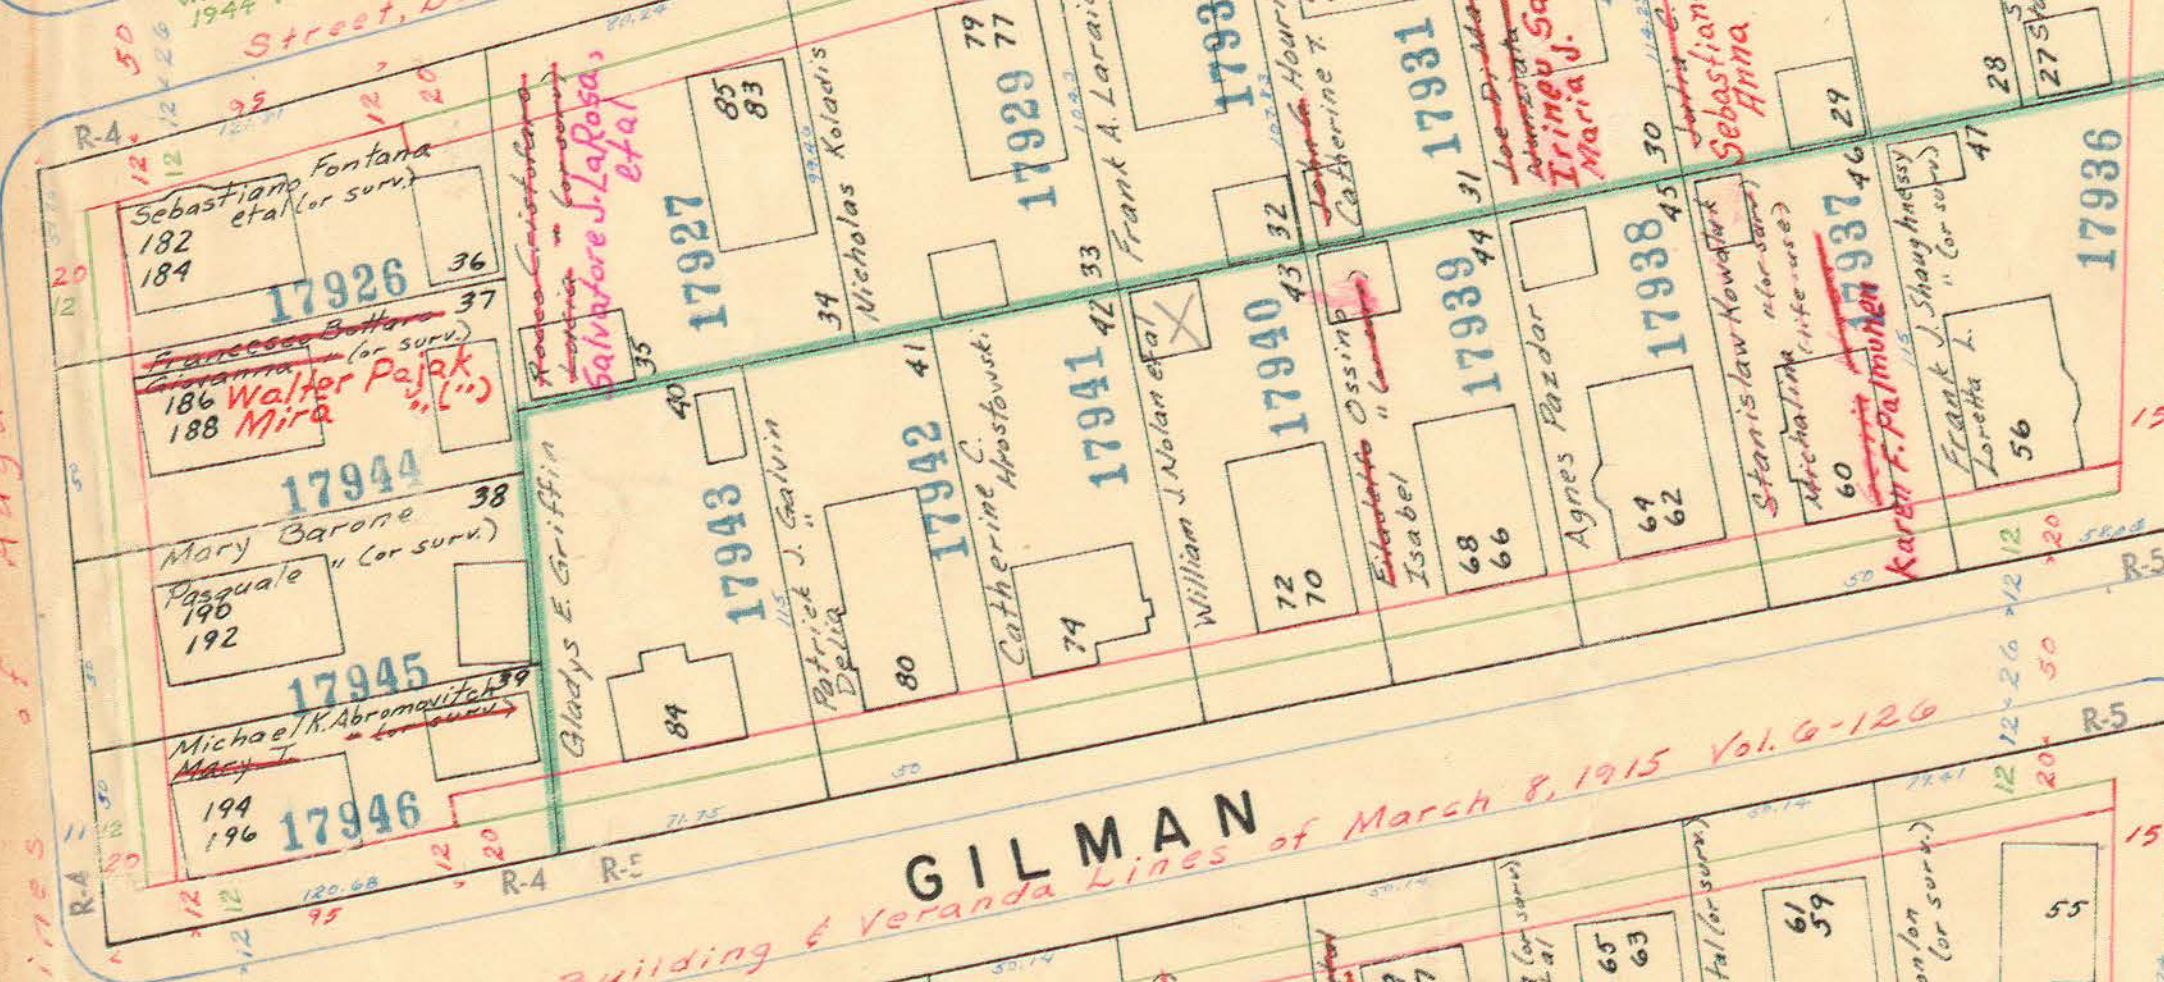


GILMAN

Street, Building & Veranda Lines of March 8, 1915 Vol. 6-126

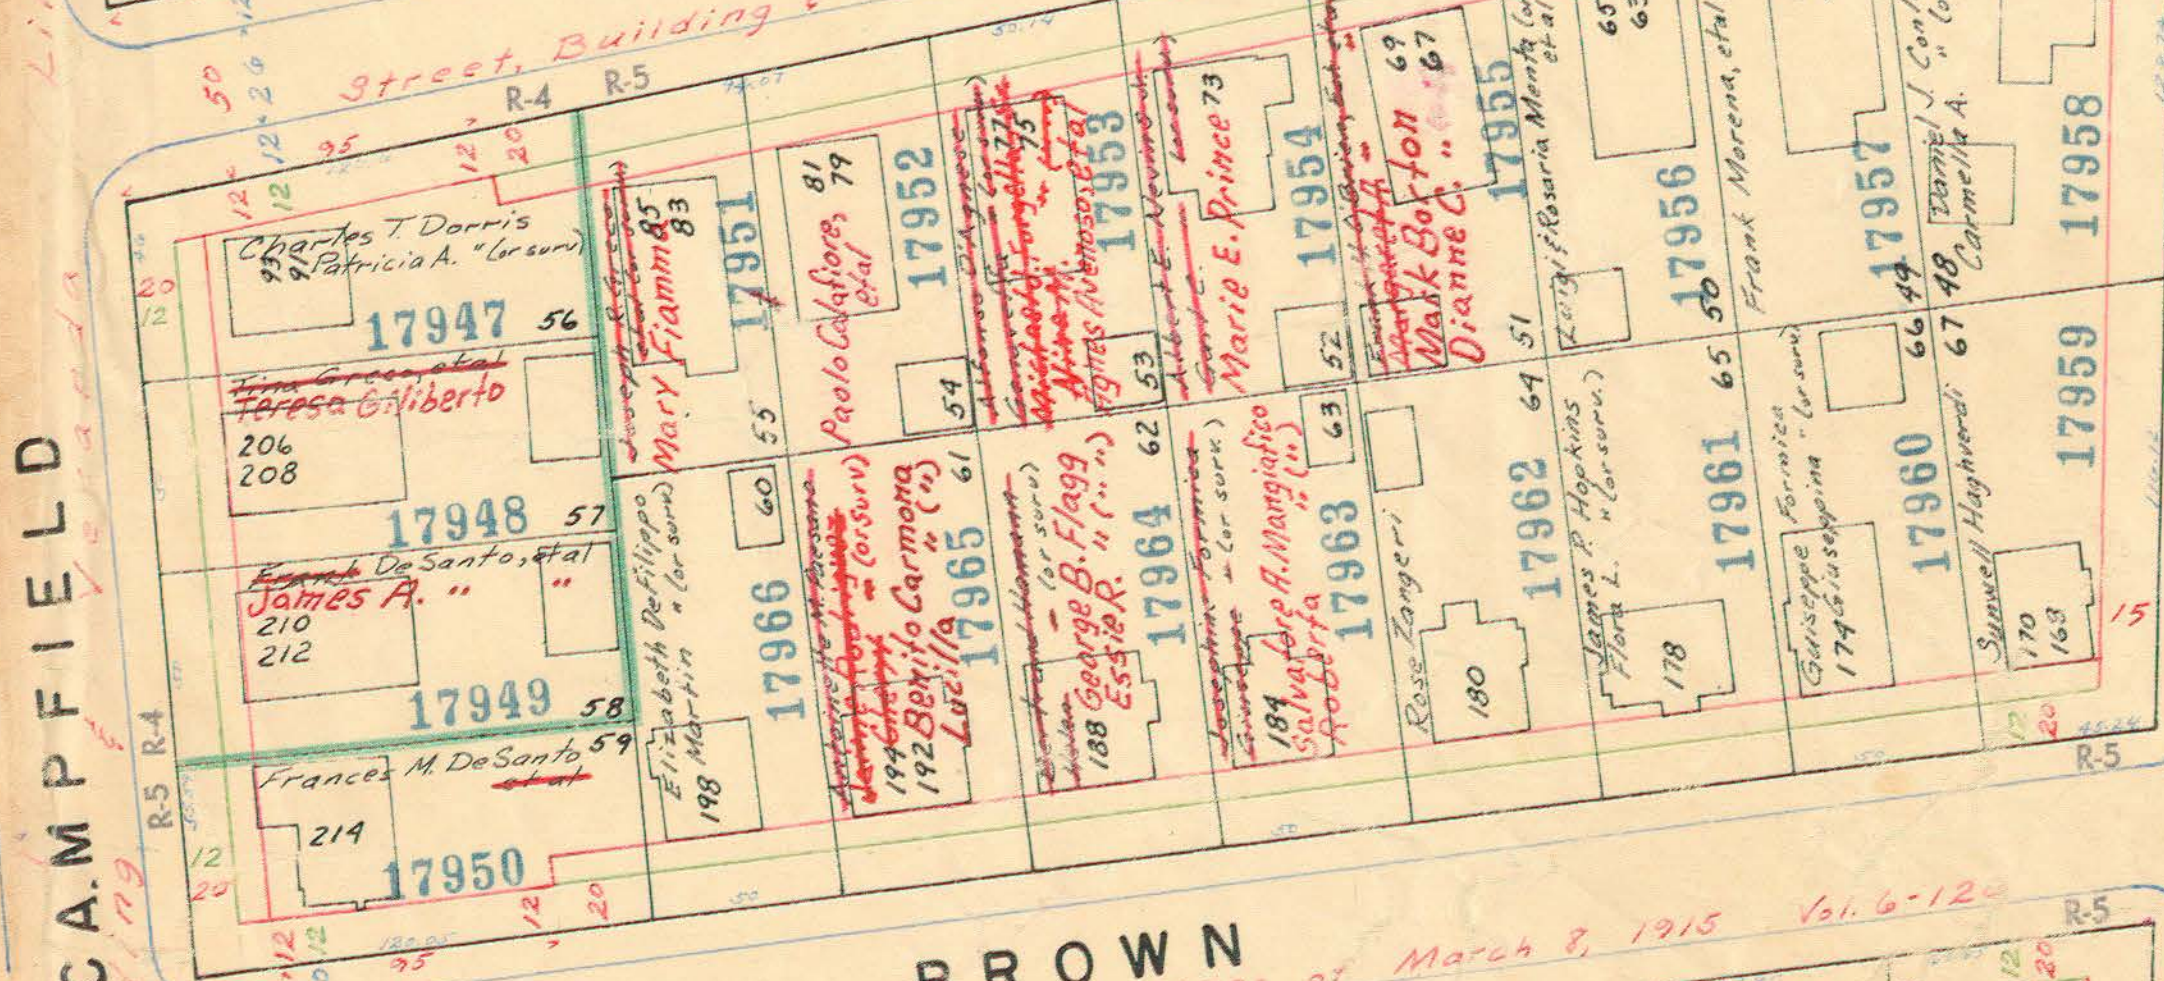


BROWN

Street, Building & Veranda Lines of March 8, 1915 Vol. 6-126

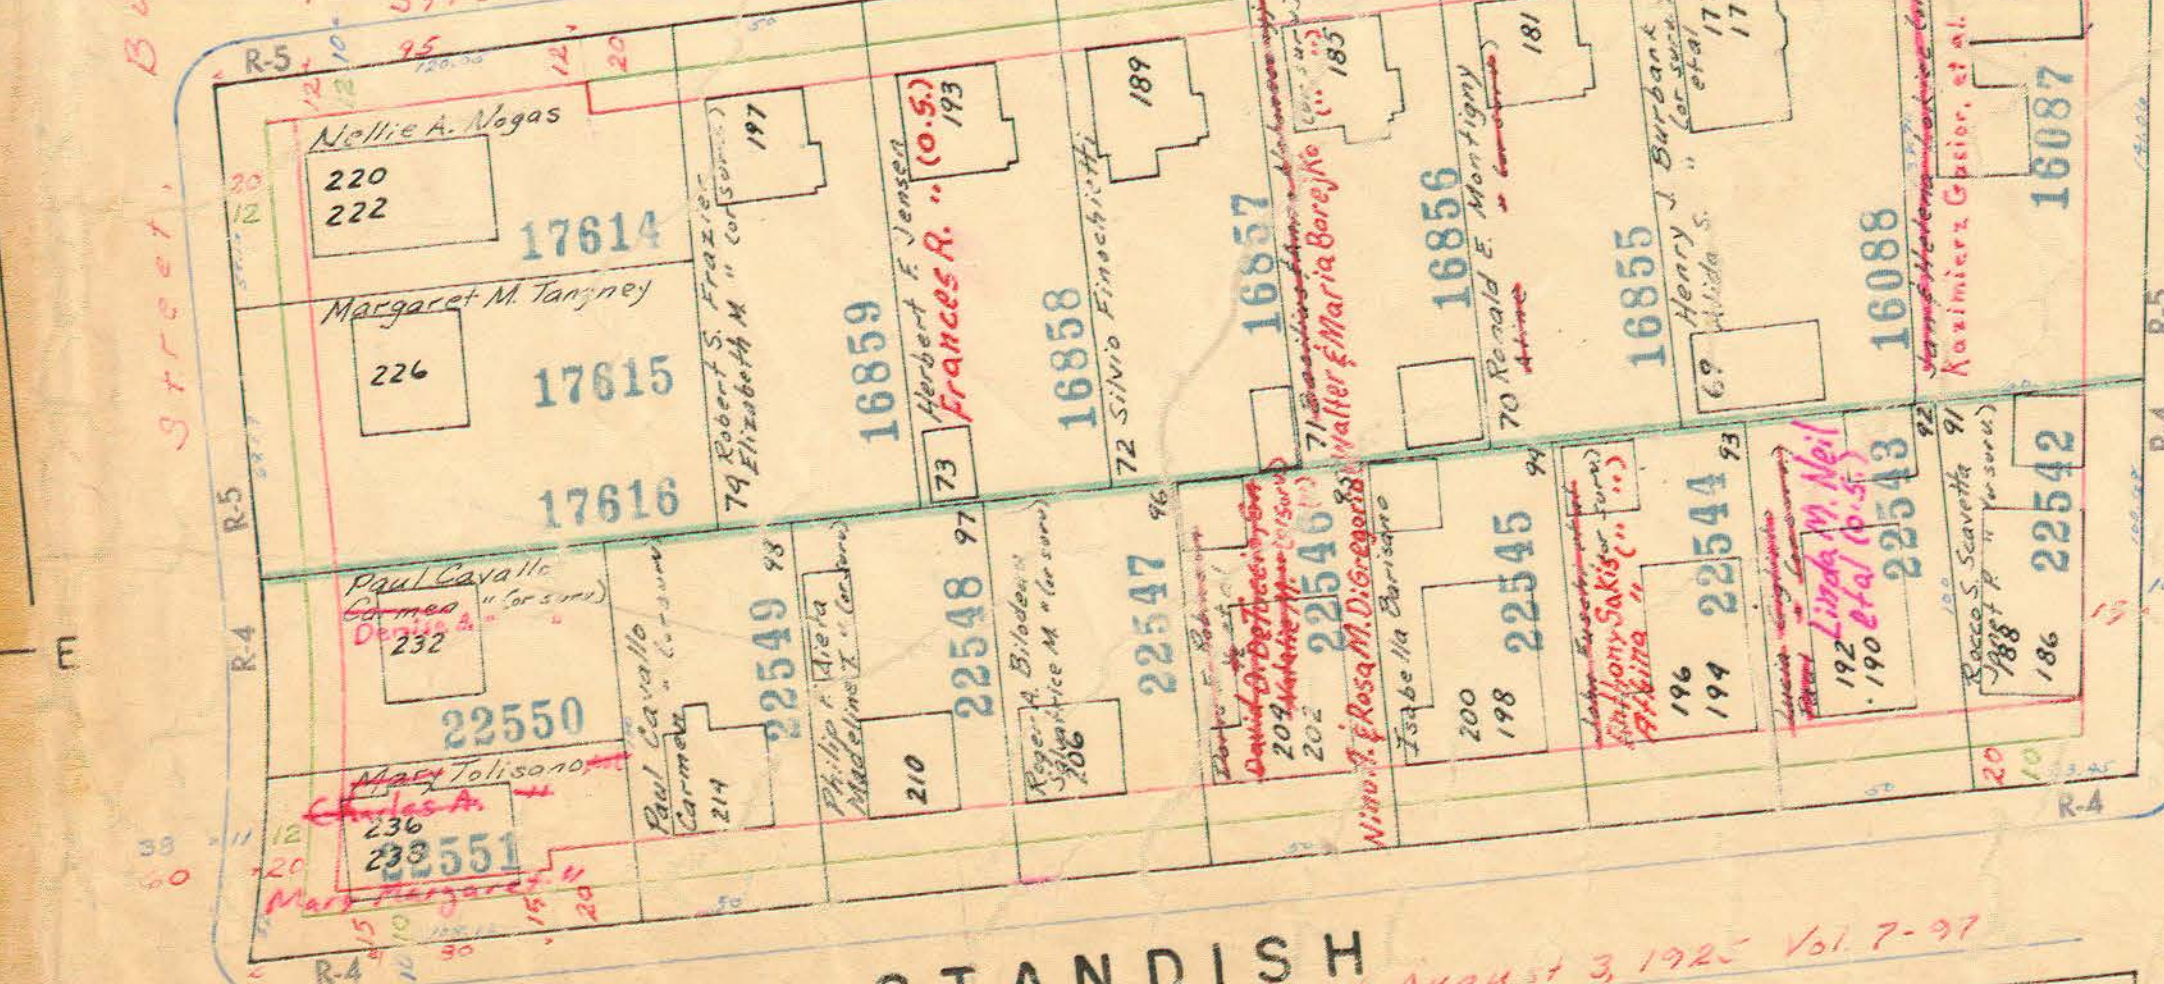

STANDISH

Street, Building & Veranda Lines of August 3, 1925 Vol. 7-97

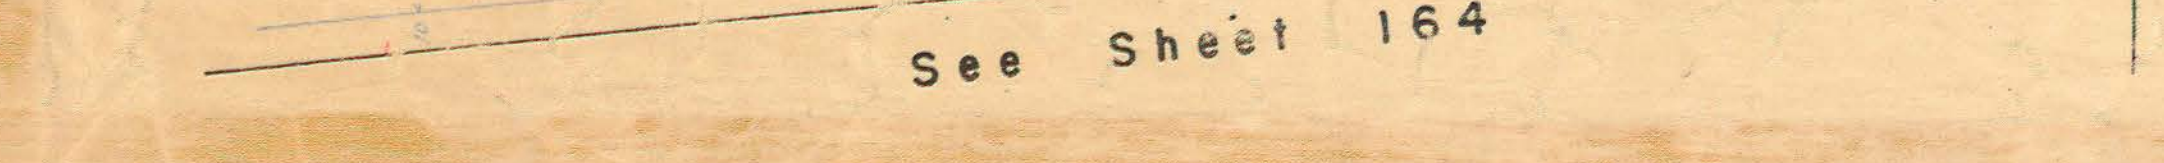





STREET

STREET

STREET

GEORGE

STREET

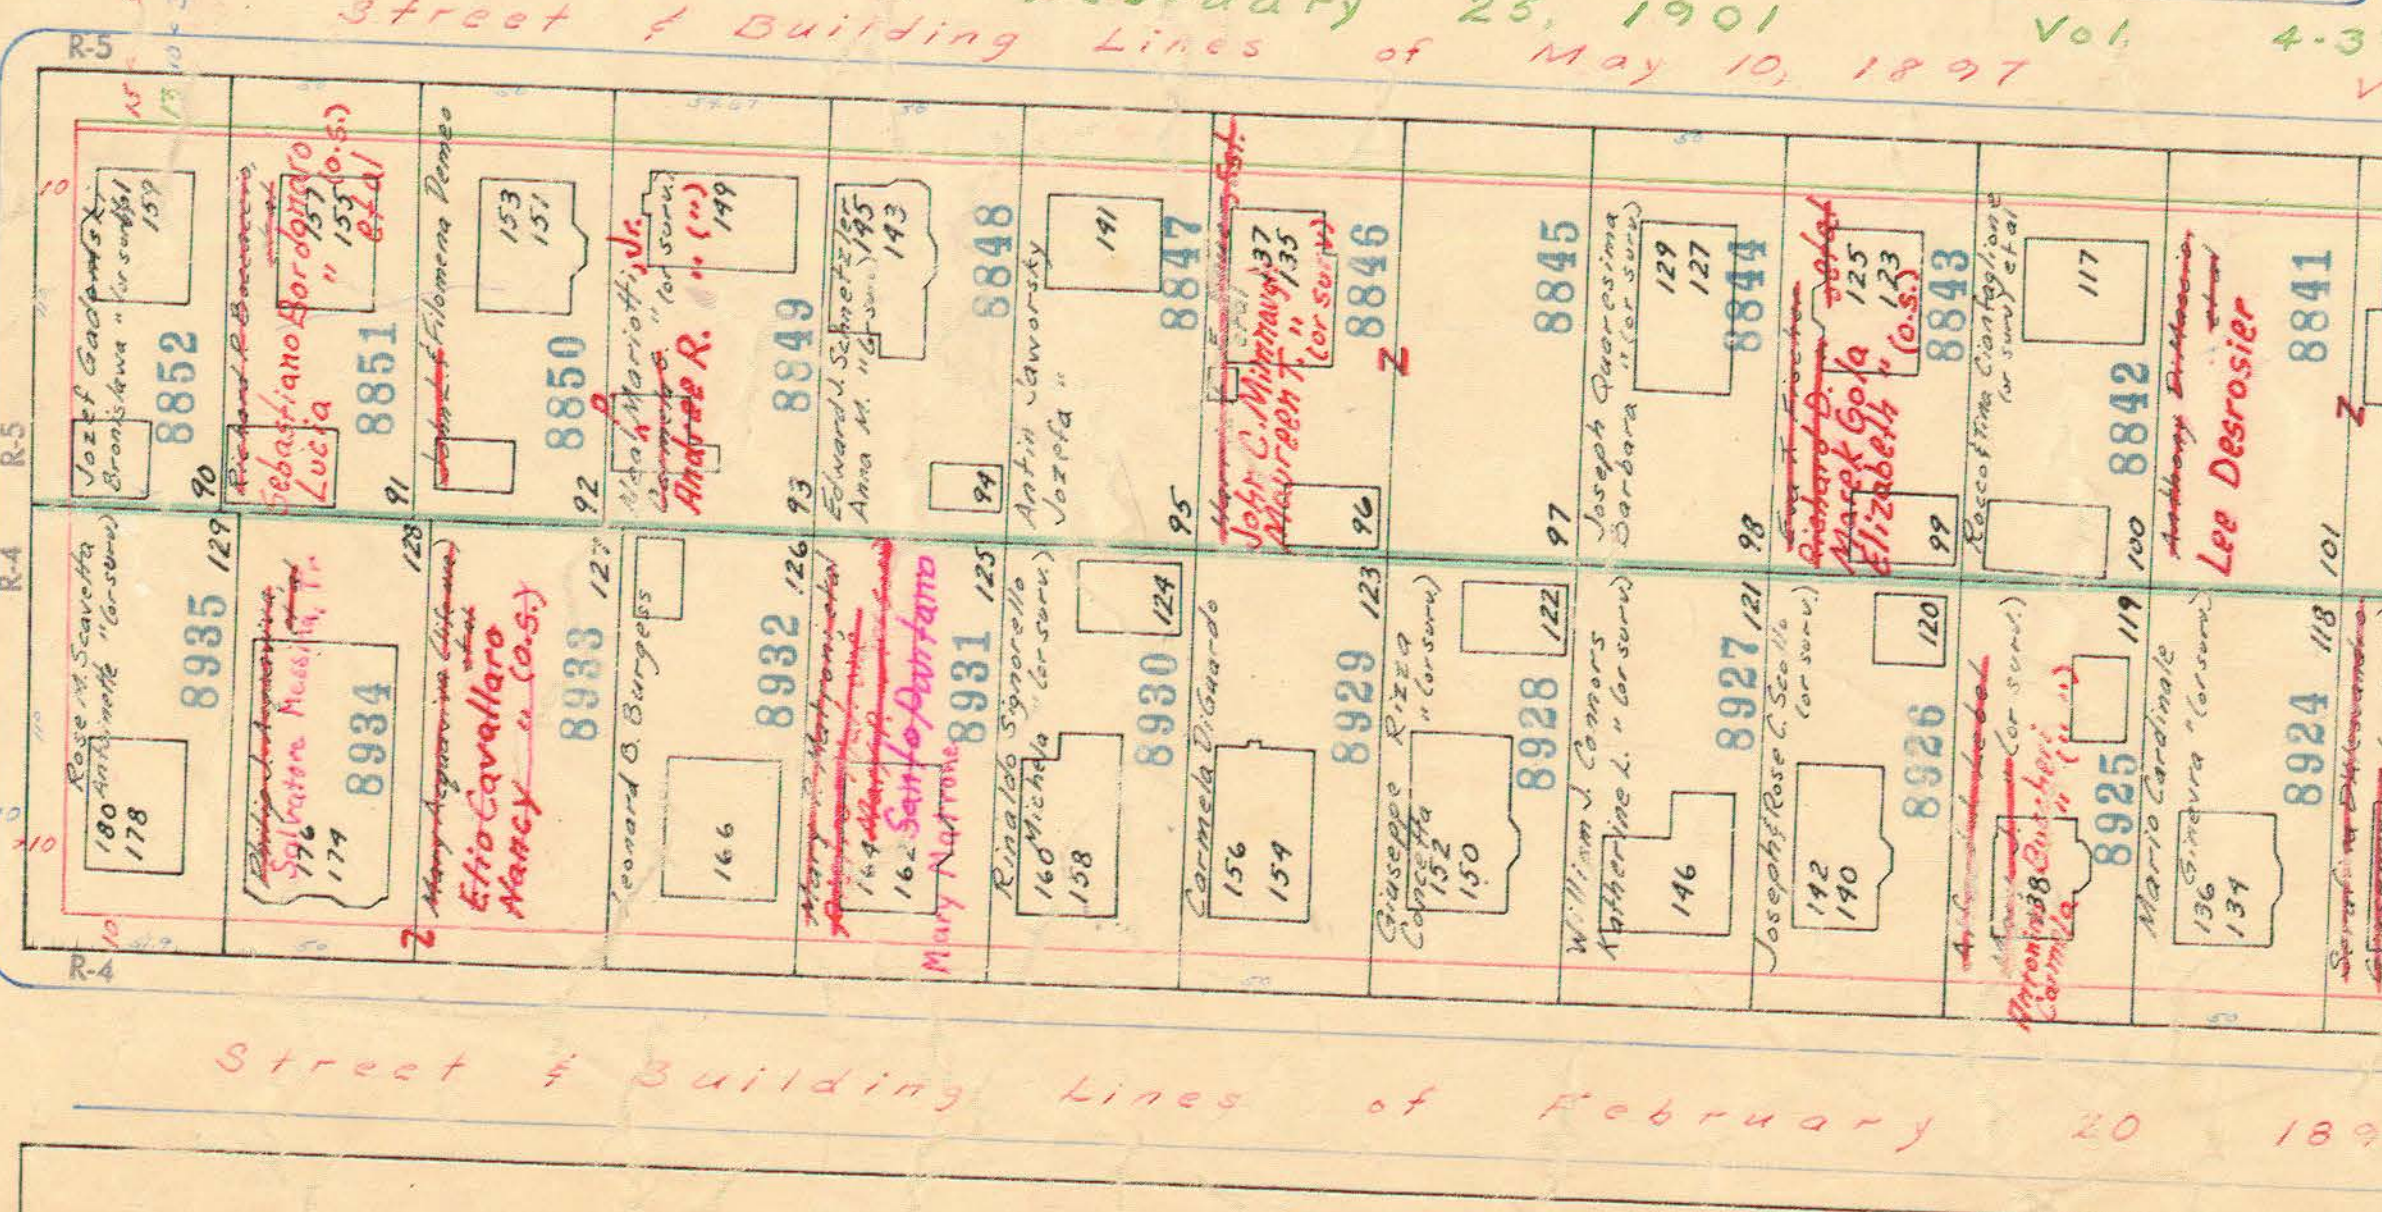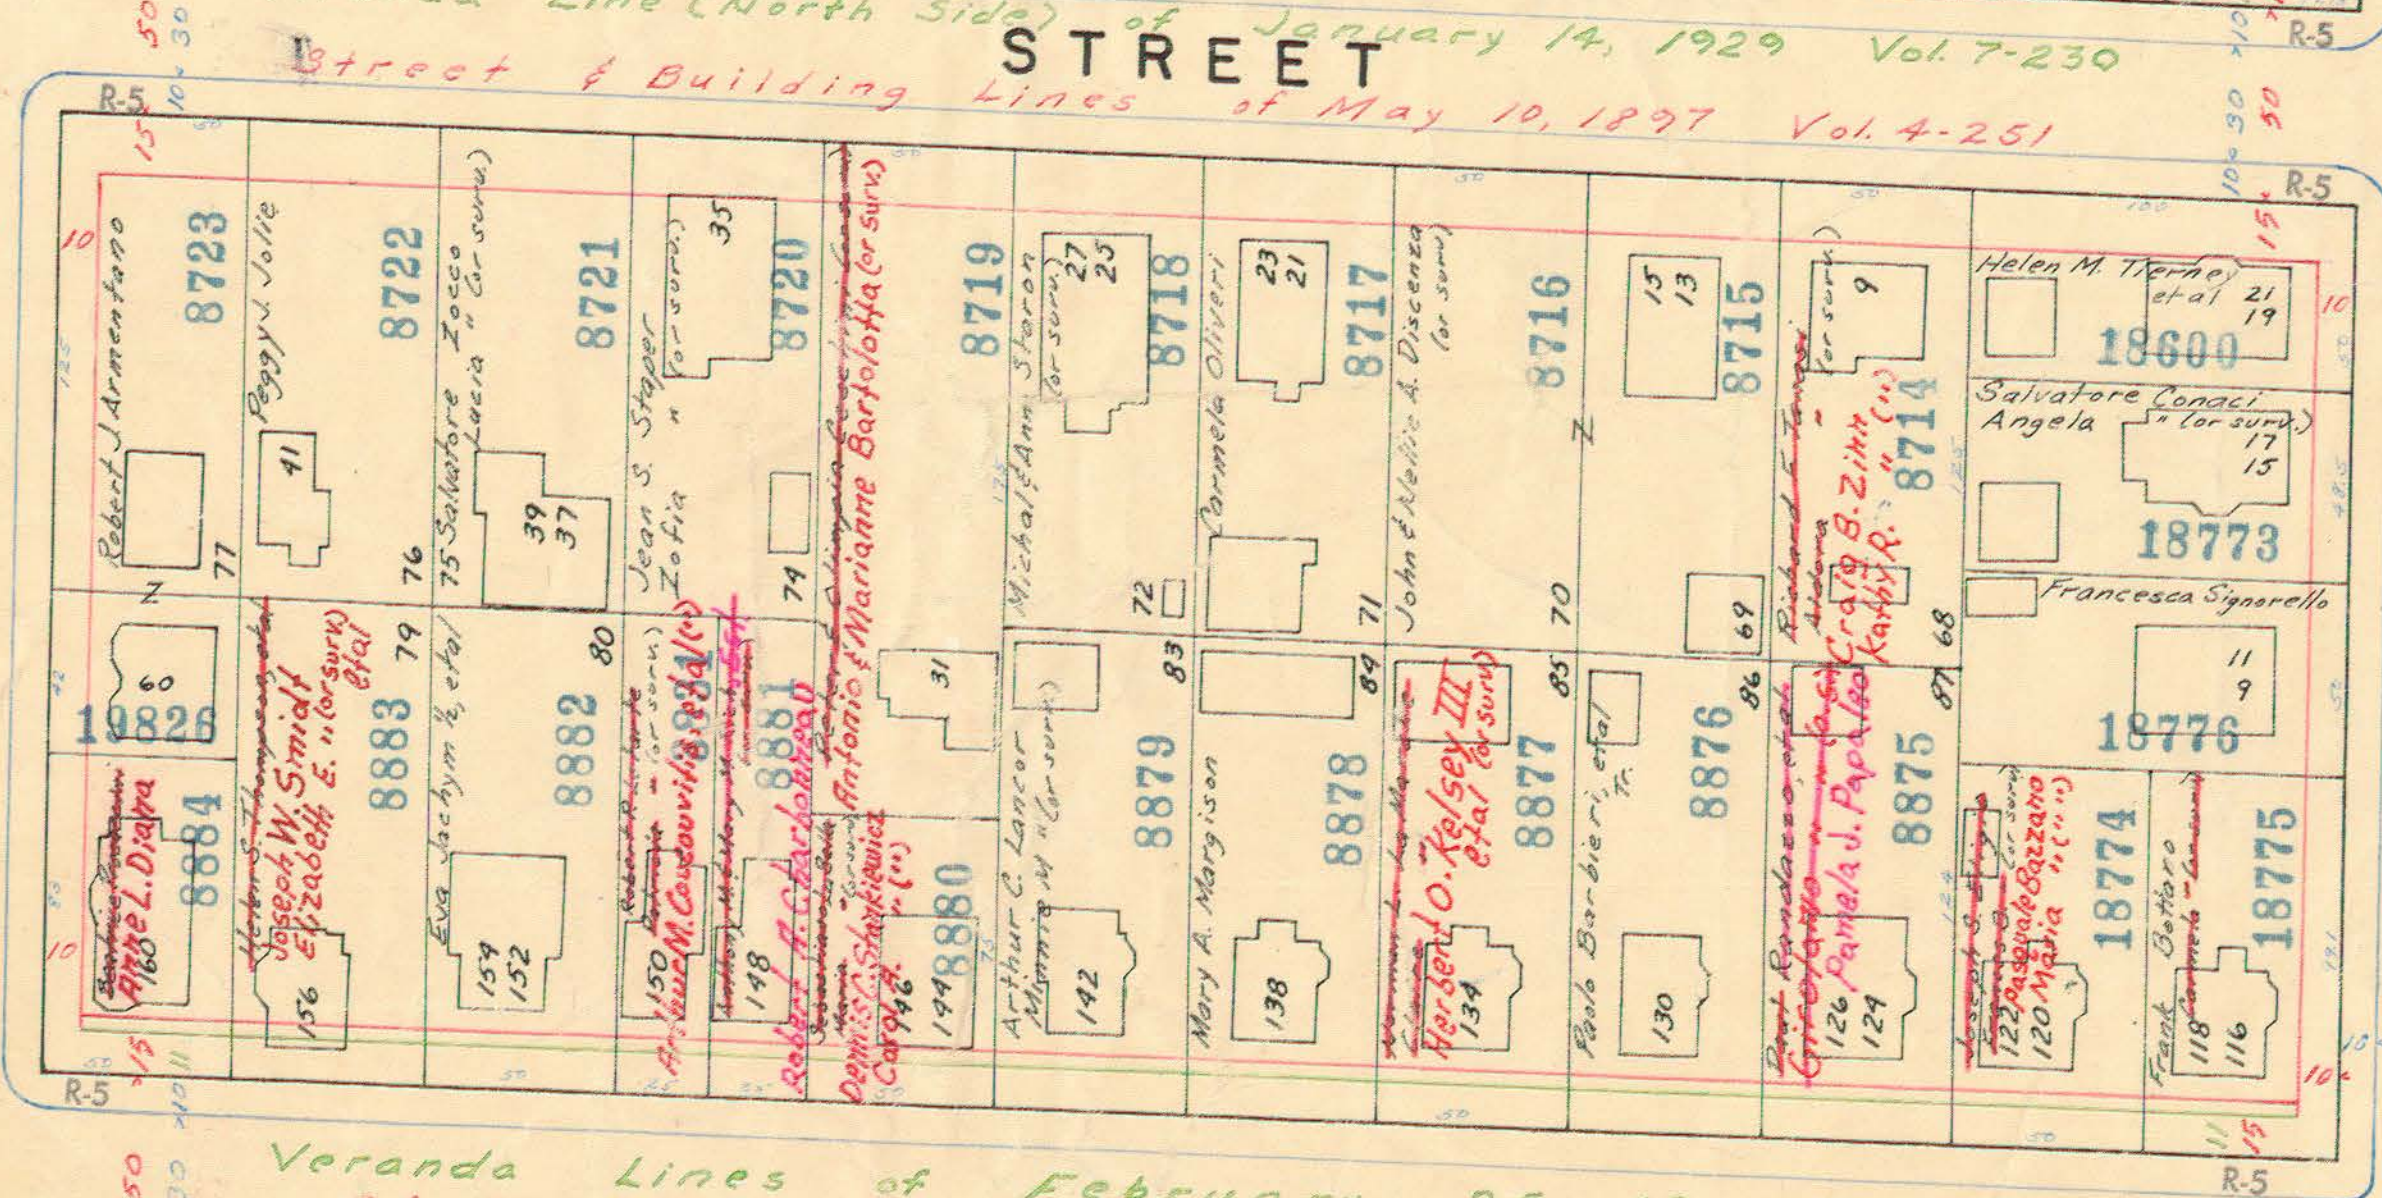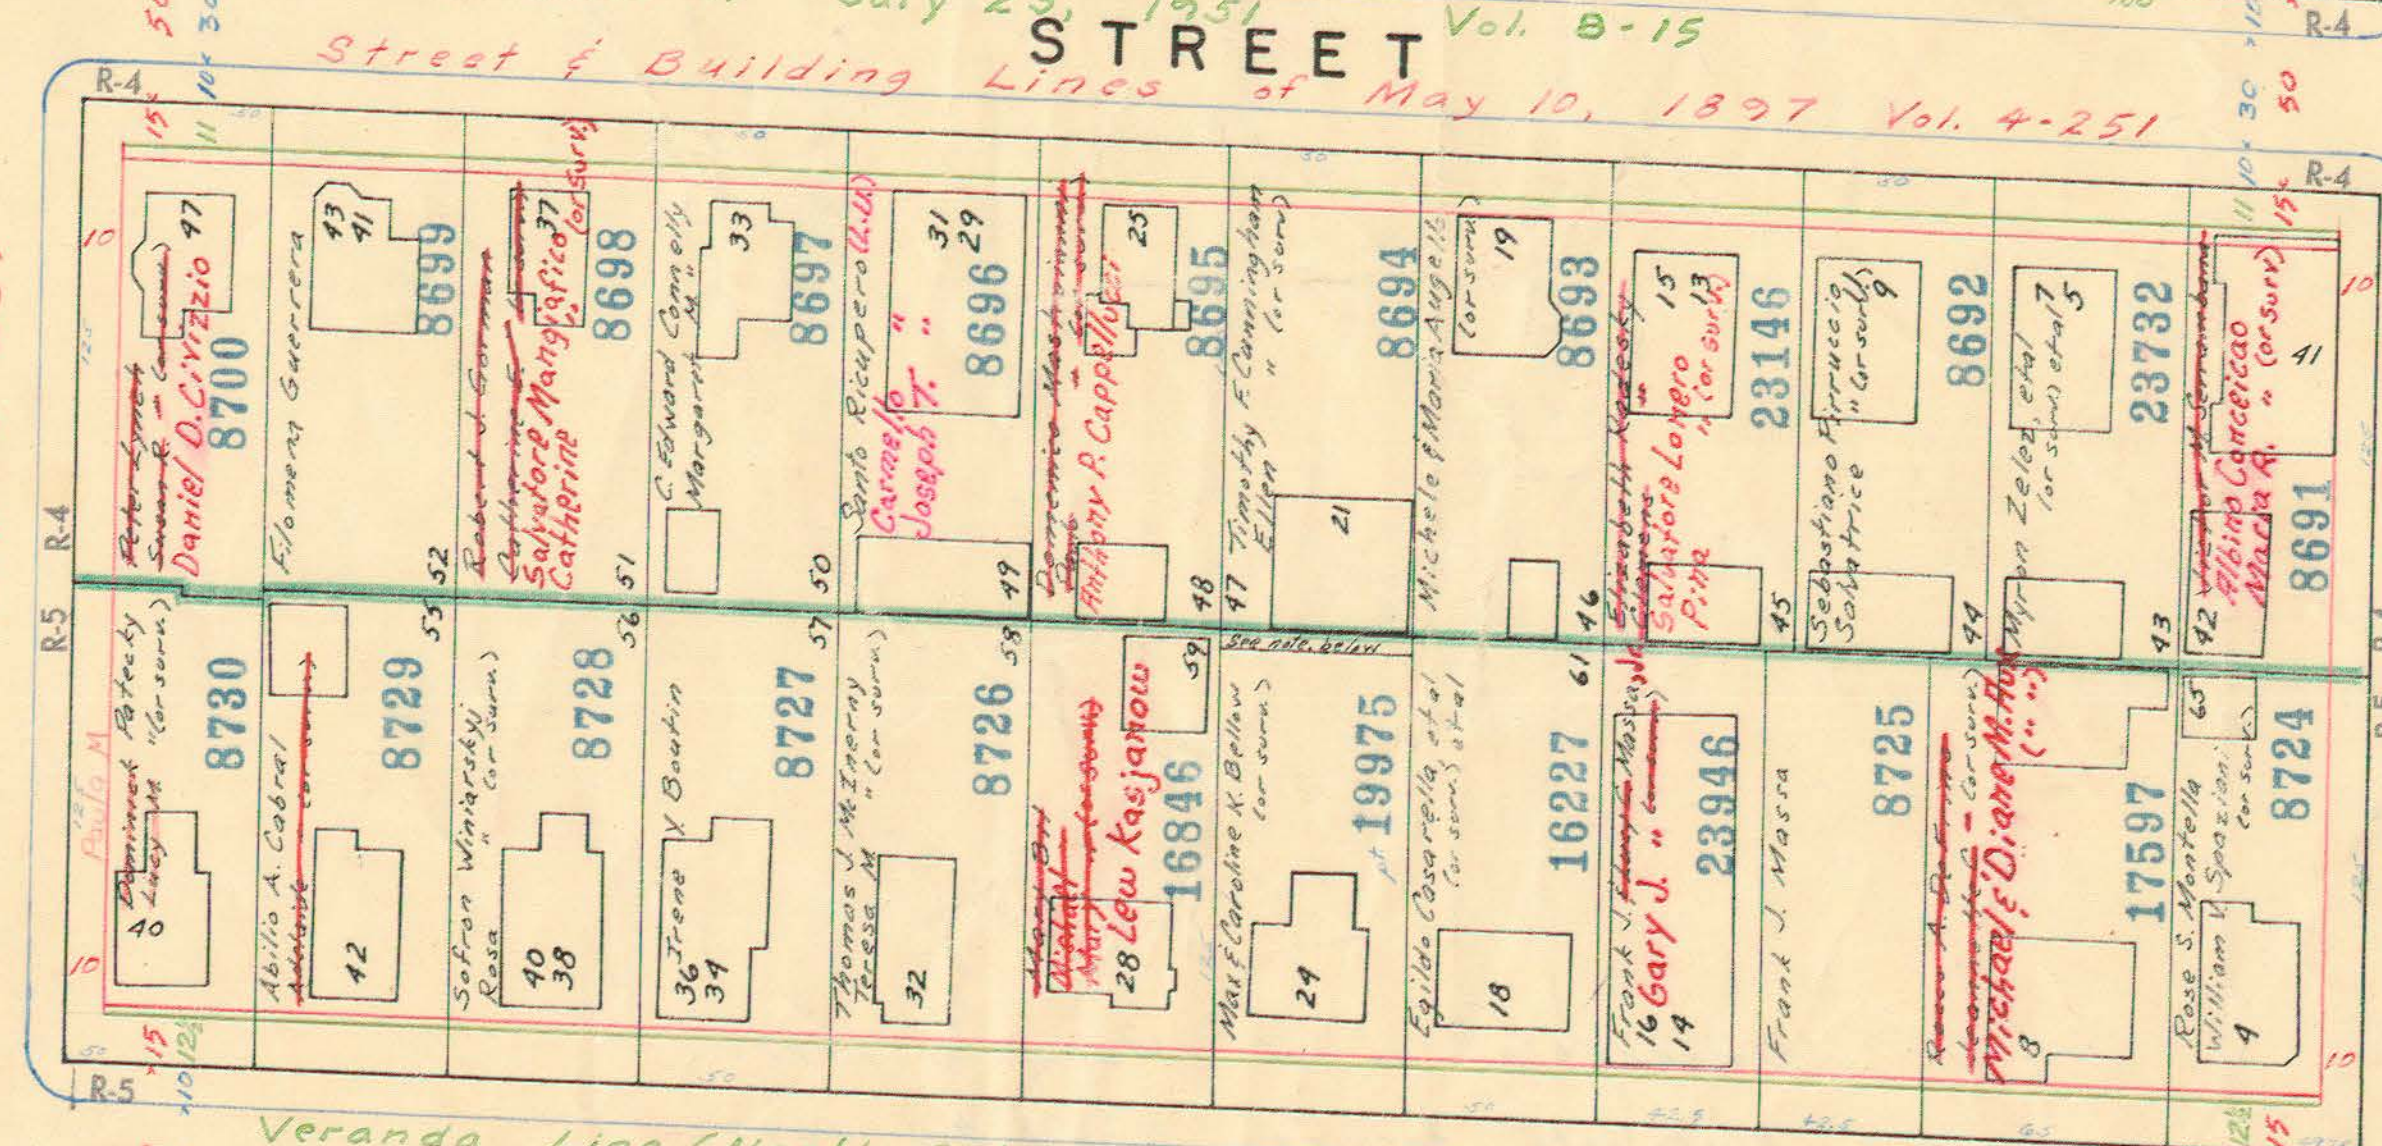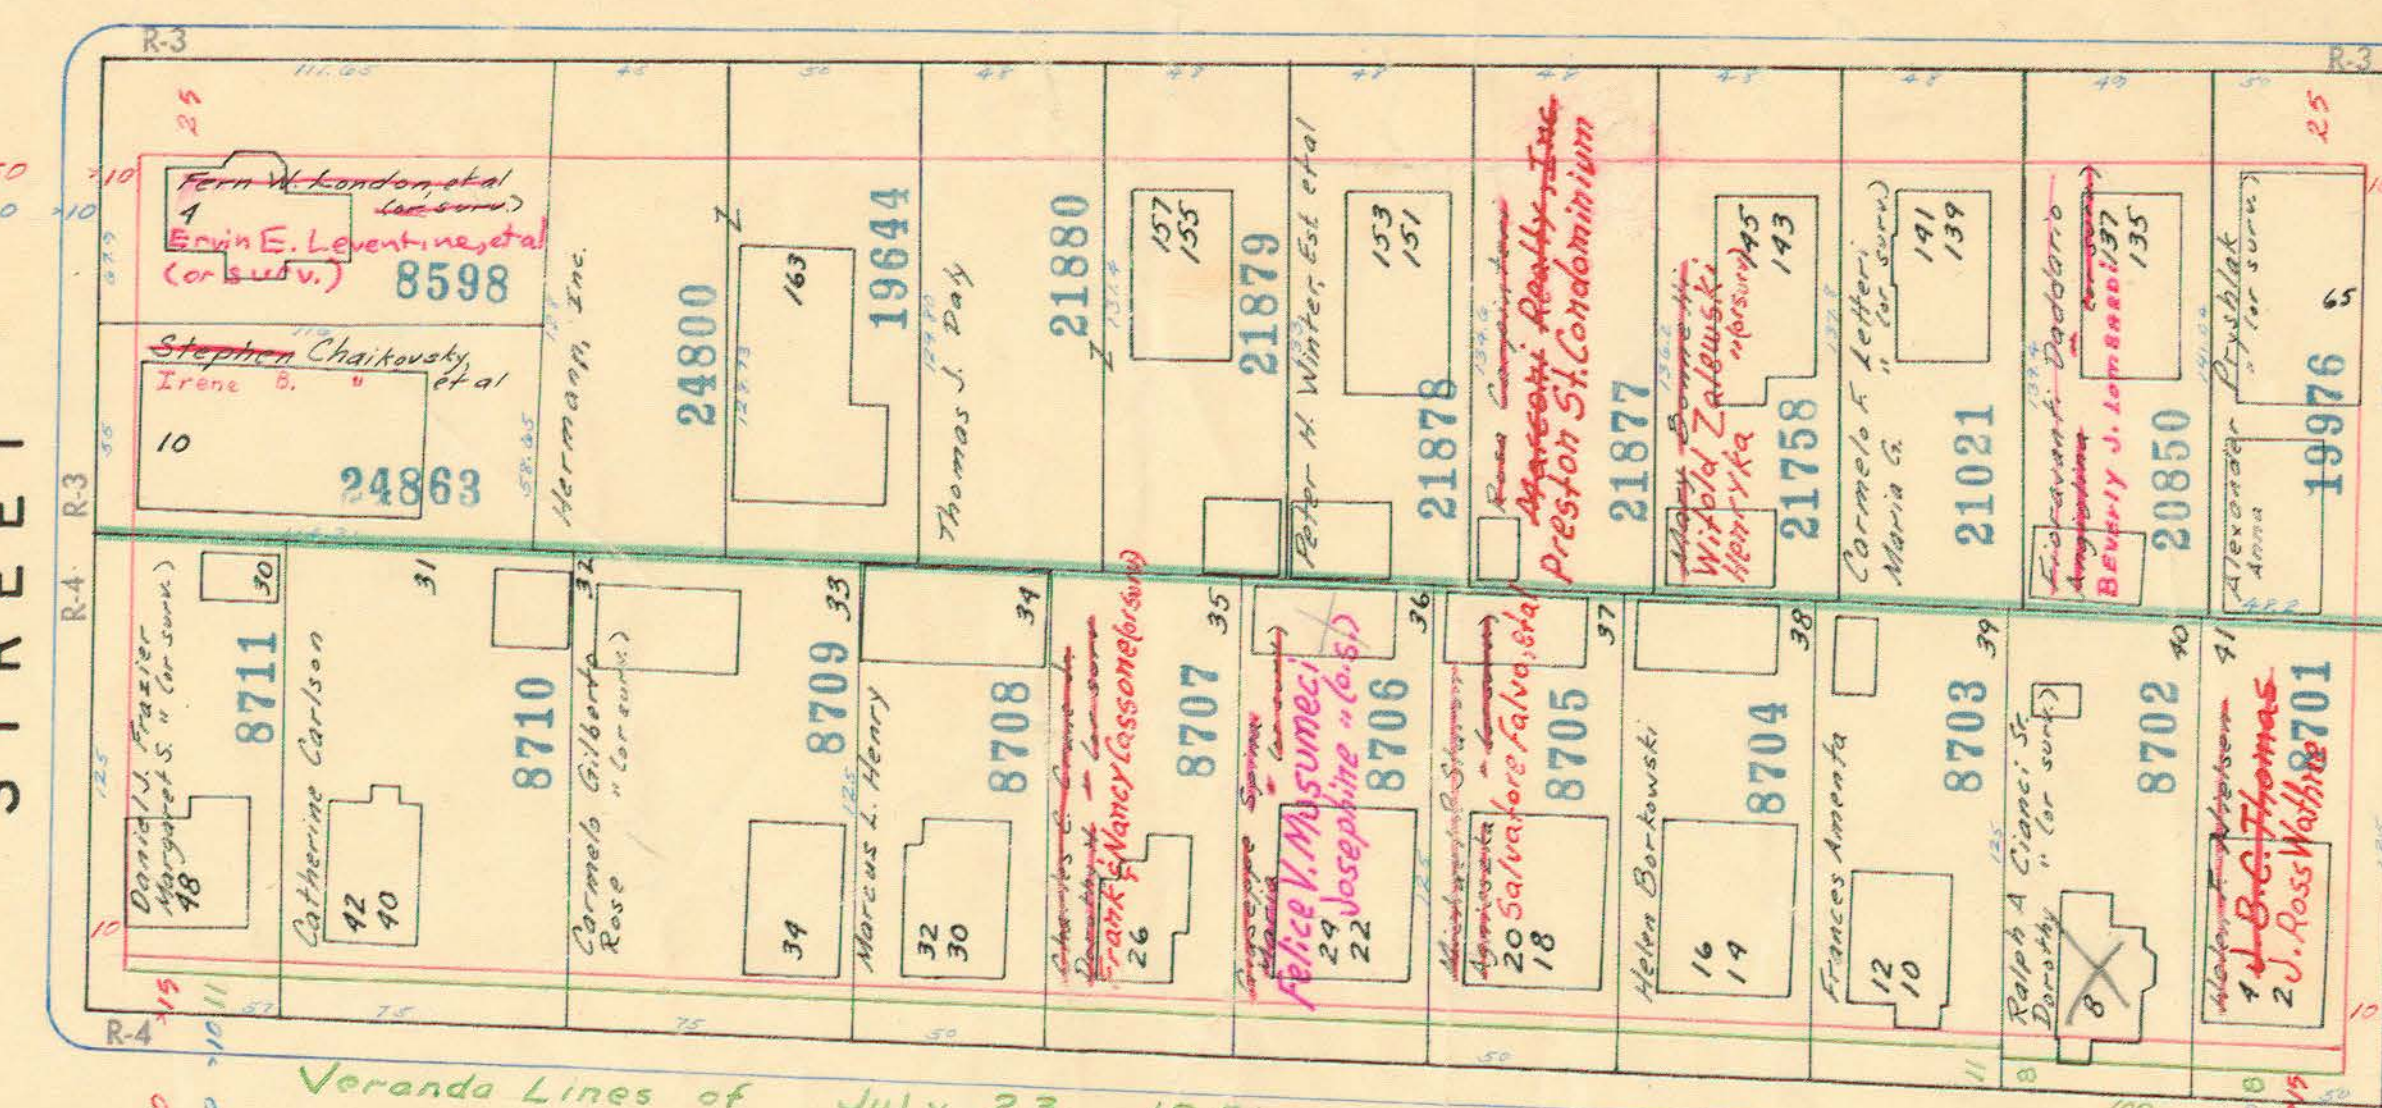

STREET

WINSHIP

STREET

STREET

STREET

