


Out of service May 11, 1965

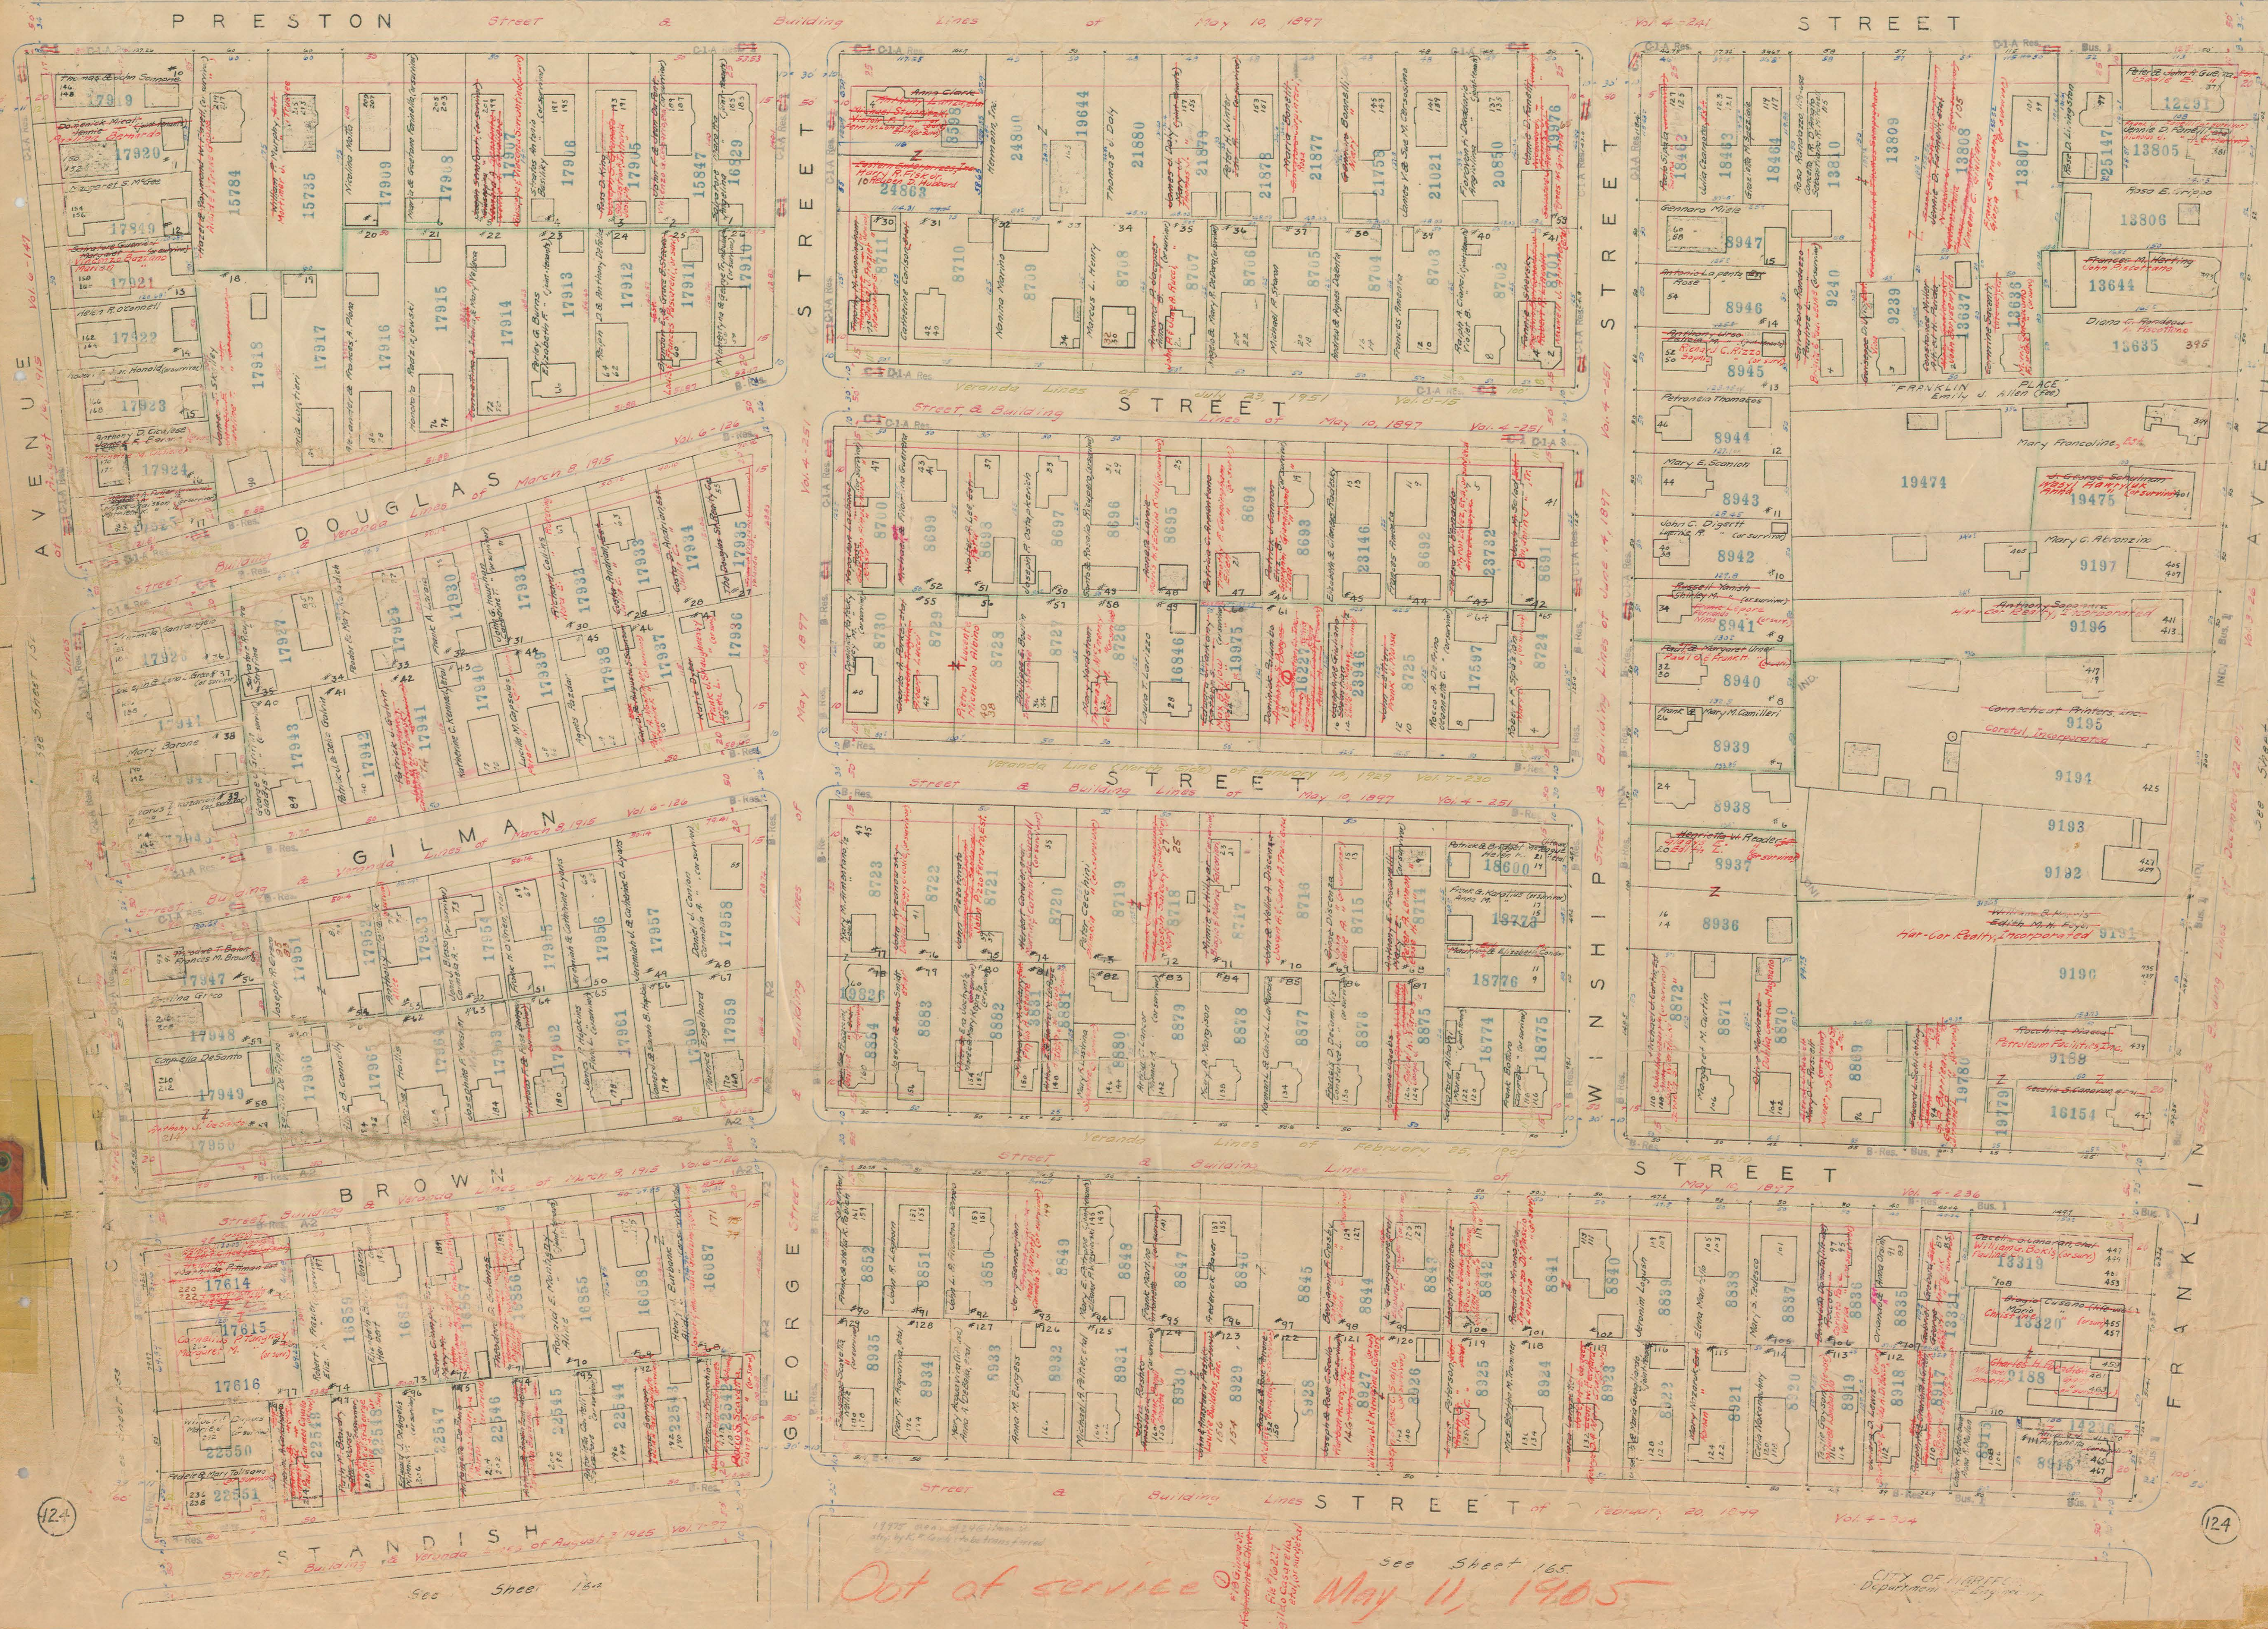

Out of service May 11, 1965