


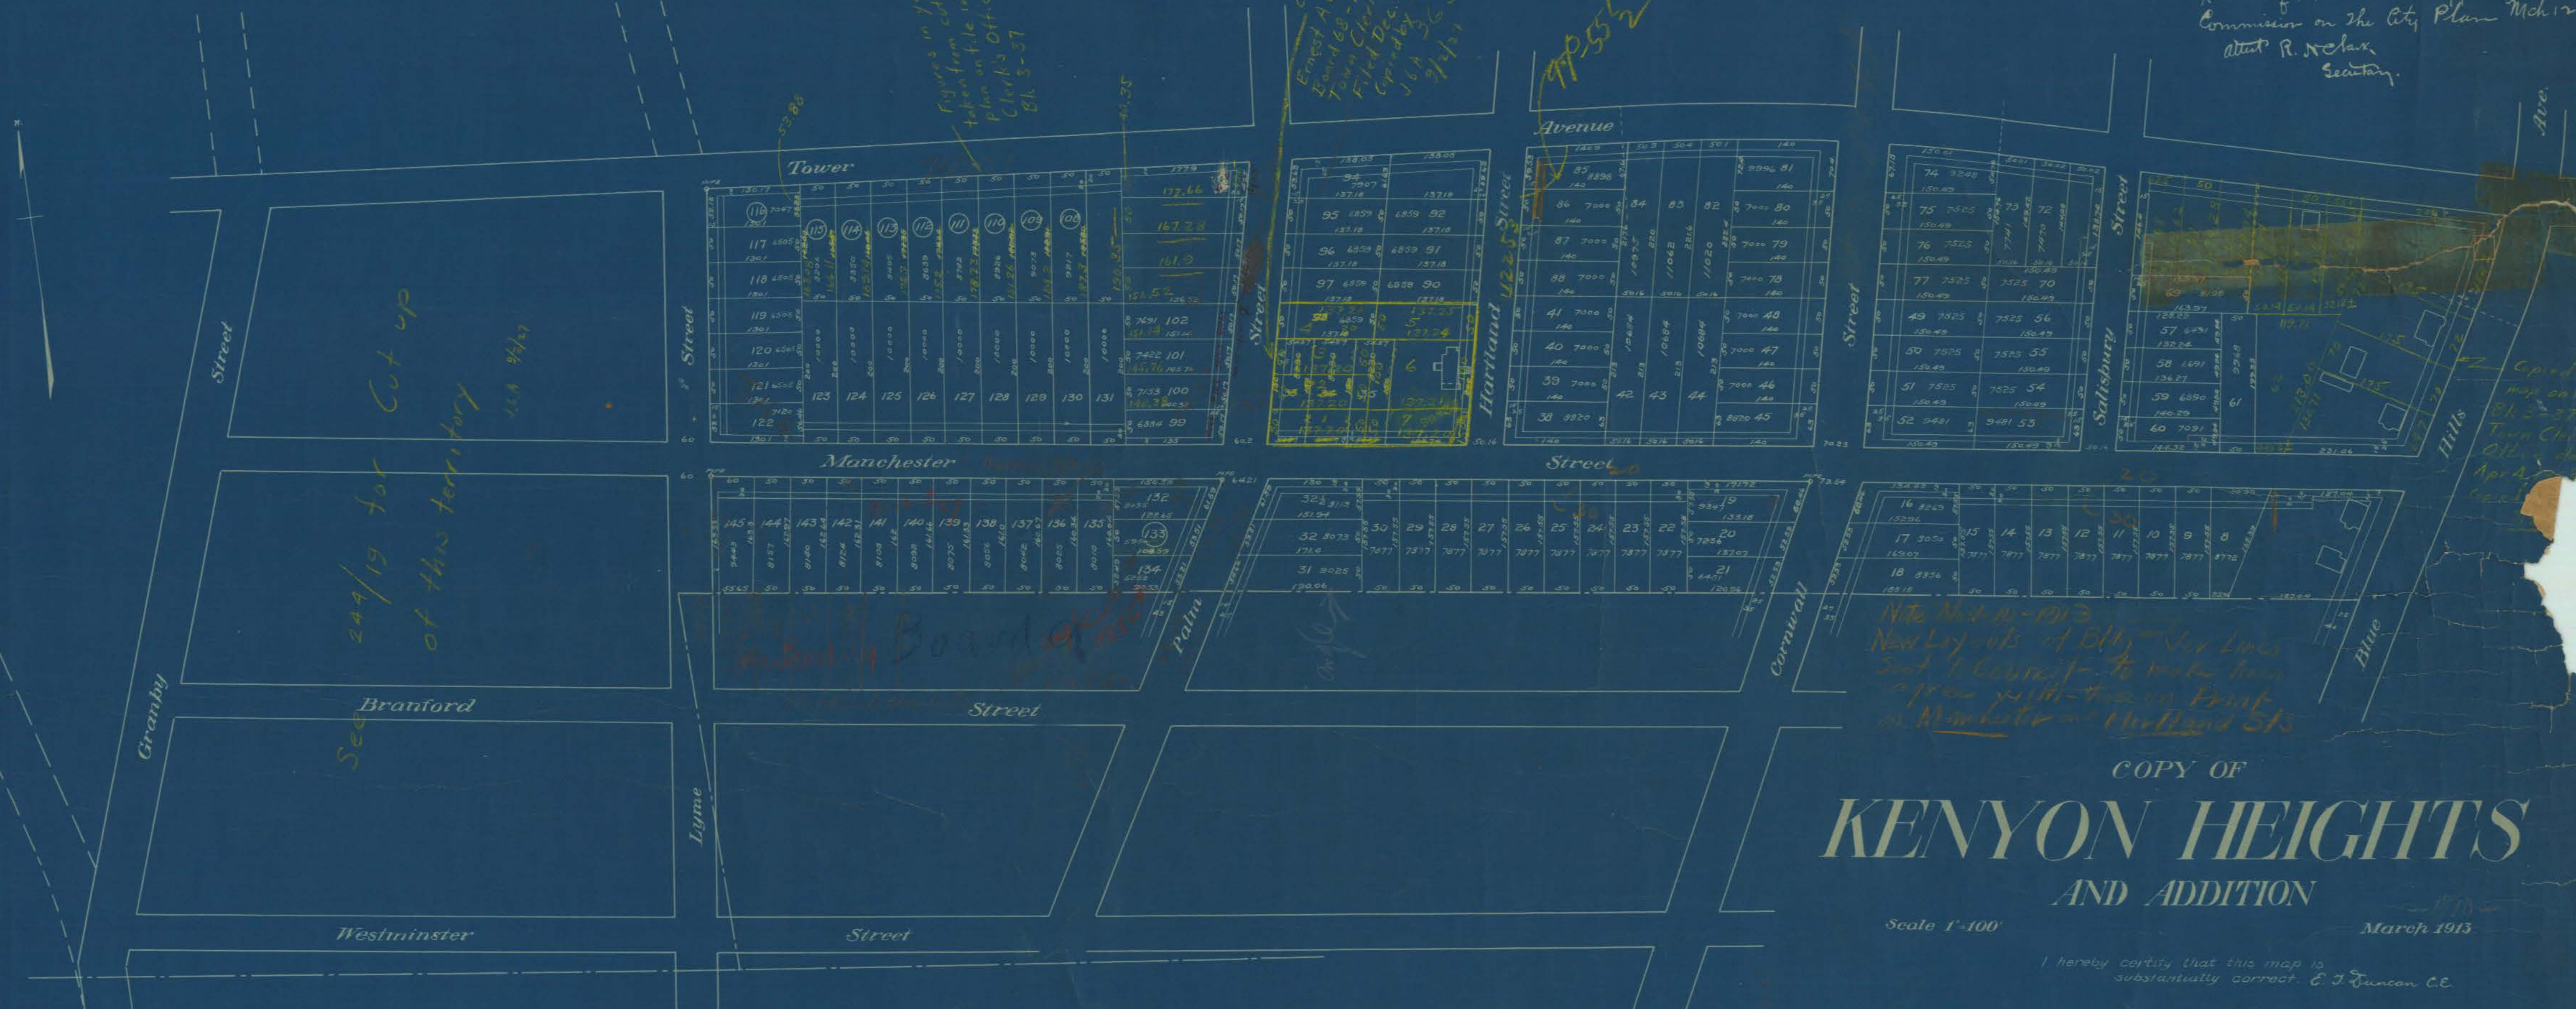

Location of streets hereon approved in
Commission on the City Plan Mch 12 '12
Attest R. McLean
Secretary.

Cut up
E and 68 - File 62
Town Clerk's Office
Filed Dec. 8 1913
J. A. 363
3/4/14

Figures in yellow
taken from cut up
Plan on file in Town
Clerk's Office
Blk 3-37

244/19 for Cut up
of this territory
See 9/4/14

Cut up
map on file
Blk 3-37
Town Clerk's
Office
Apr 4
1914

Note Map No. - 1913
New Layouts of Blue Hills Ave
Sent to Council - To make them
agree with those on Print
of Manchester and Portland Sts

COPY OF
KENYON HEIGHTS
AND ADDITION

Scale 1"=100' March 1913

I hereby certify that this map is
substantially correct. E. J. Duncan C.E.

SHOWING THAT PORTION OF THE ORIGINAL PLAN
RECORDED IN THE TOWN CLERK'S OFFICE, NOW OWNED BY
The Maynard Land Co., Inc.
Providence, R.I.