


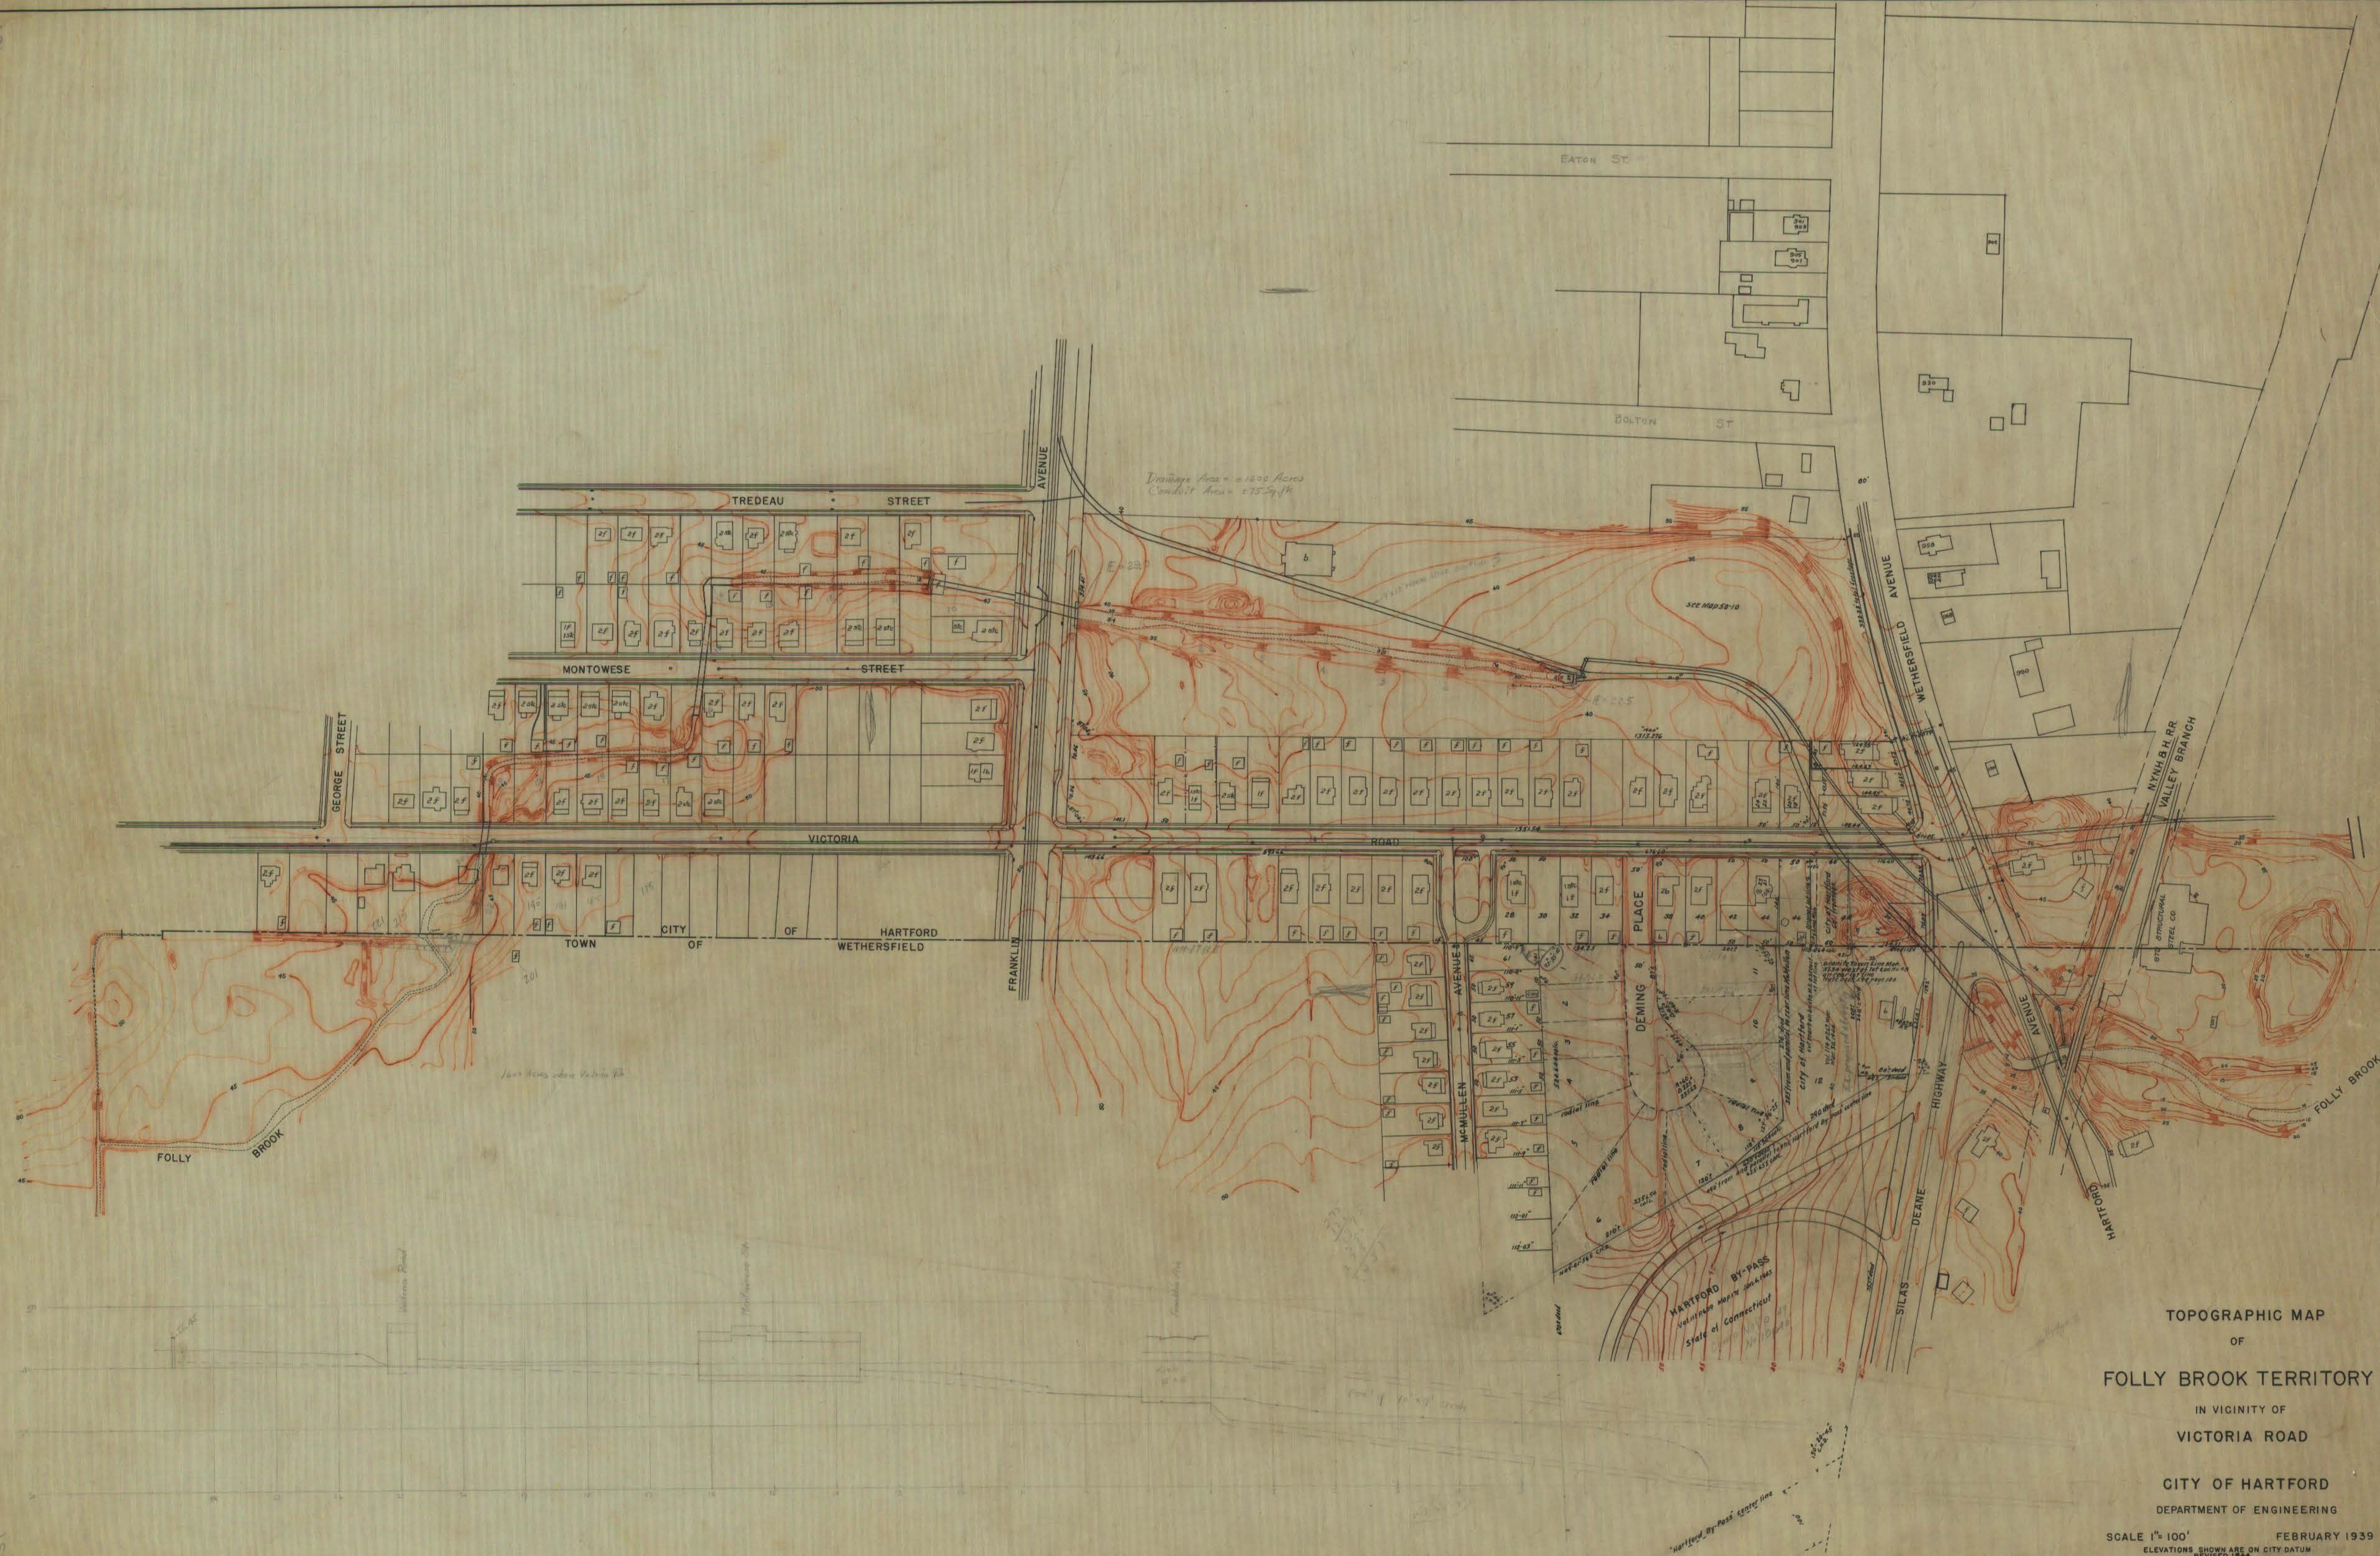

TOPOGRAPHIC MAP
OF
FOLLY BROOK TERRITORY
IN VICINITY OF
VICTORIA ROAD
CITY OF HARTFORD
DEPARTMENT OF ENGINEERING
SCALE 1"=100'
FEBRUARY 1939
ELEVATIONS SHOWN ARE ON CITY DATUM
REVISED 1944