


Market Street

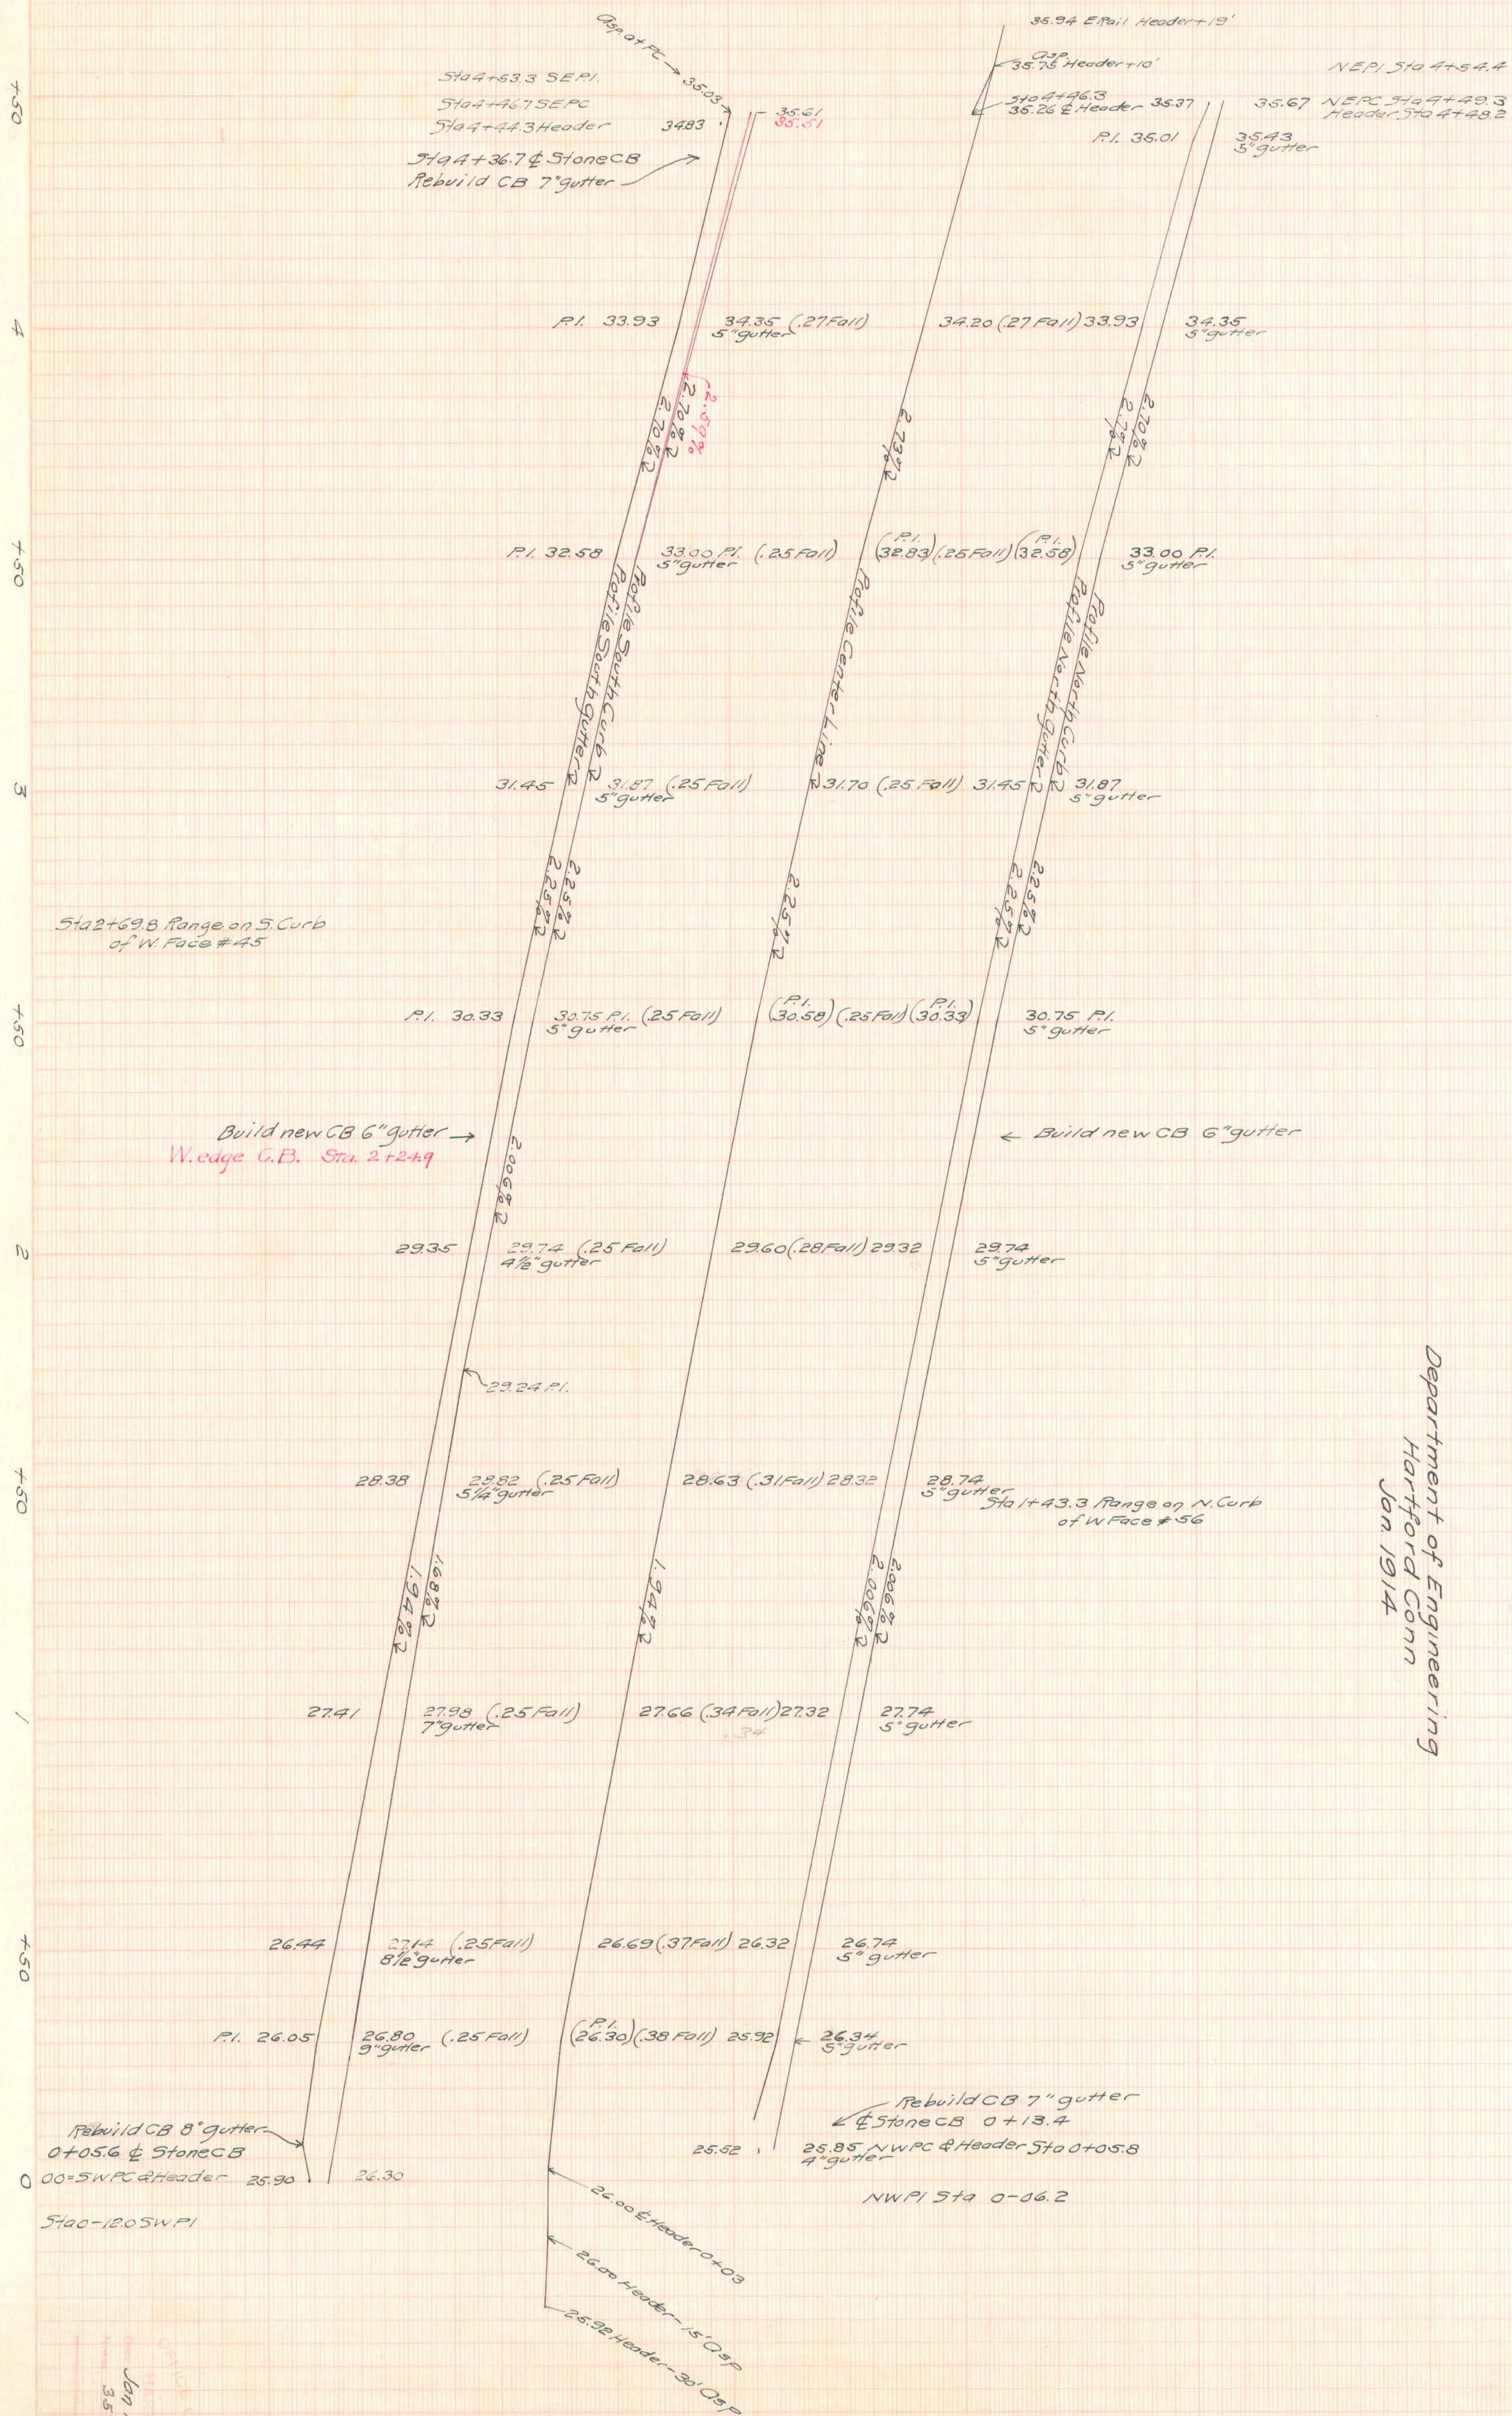

TALCOTT STREET
FRONT STREET TO MARKET STREET
CURB AND PAVING GRADES
HOR SCALE 1" = 20'
VER SCALE 1" = 2'
Stations measured on South Curb Line

Department of Engineering
Hartford Conn
Jan 1914

Front Street

Jan 1914 03418
357-98