


Pleasant Street

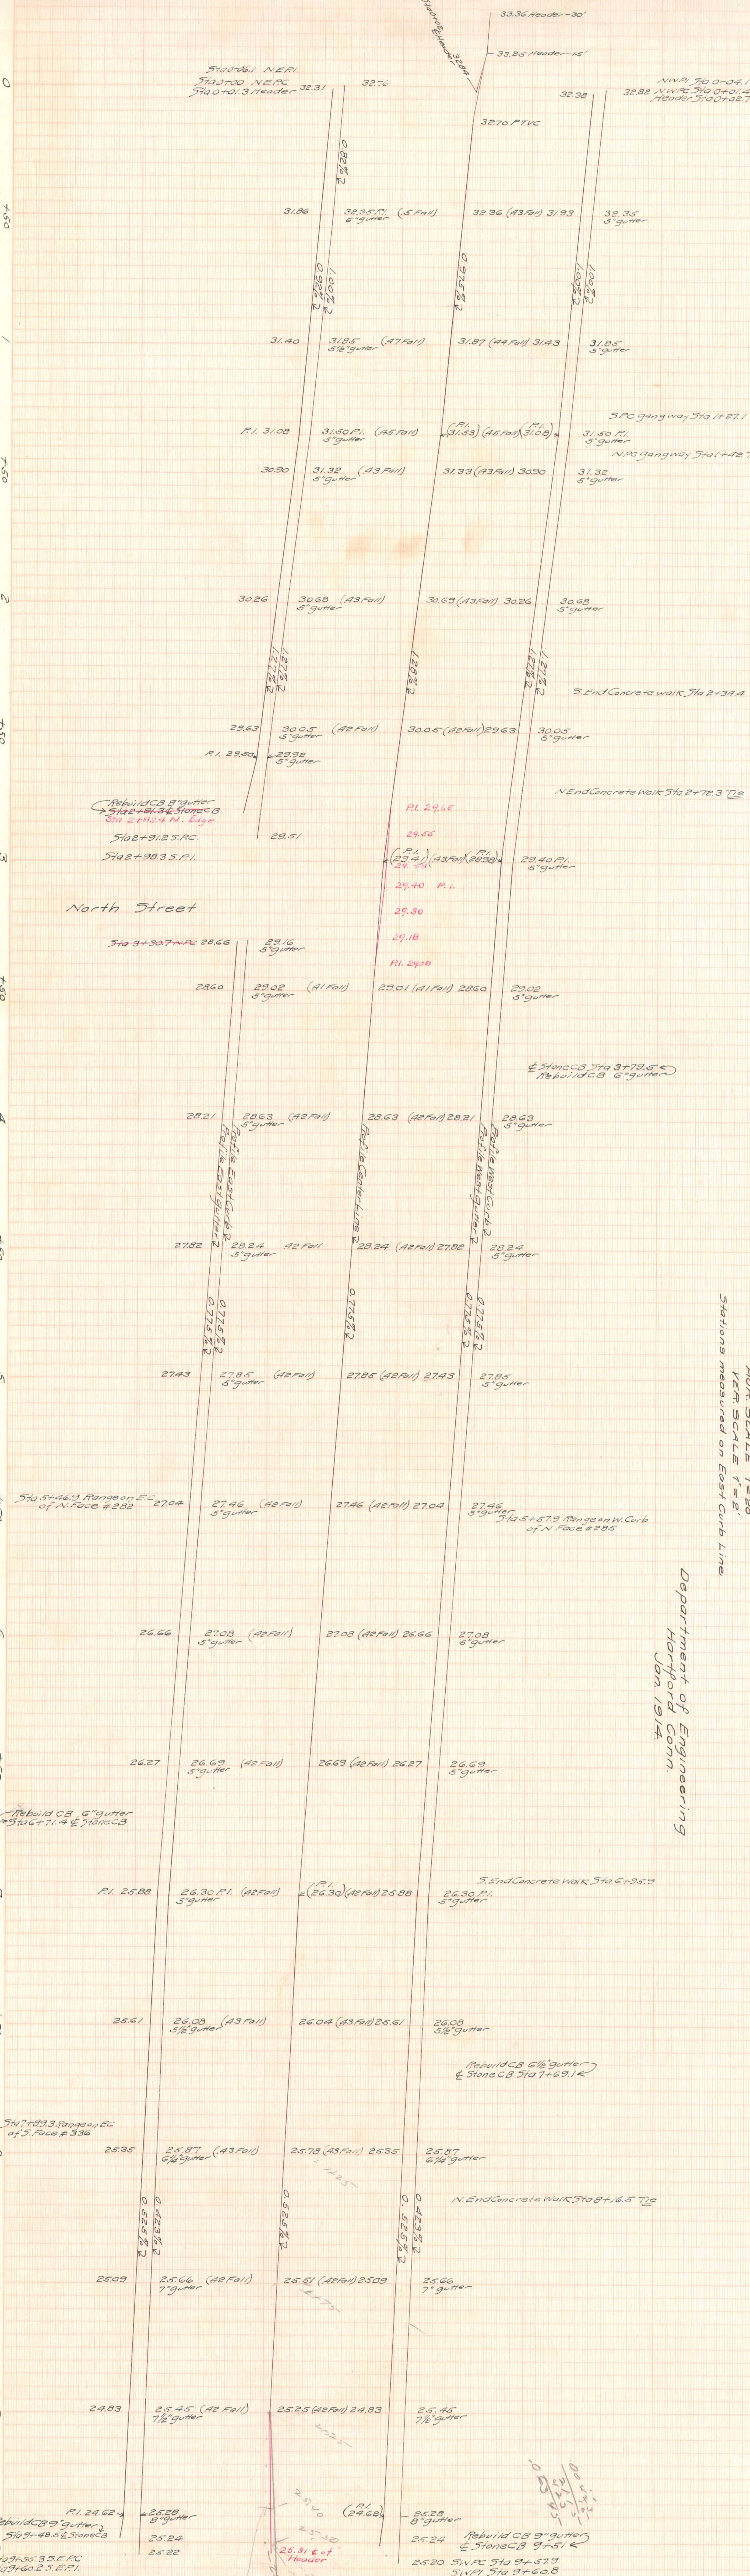

WINDSOR STREET  
PLEASANT STREET TO AVON STREET  
CURB AND PAVING GRADES  
HORIZONTAL SCALE 1"=20'  
VERTICAL SCALE 1"=2'

Stations measured on East Curb Line

Department of Engineering  
Hartford Conn.  
Jan. 1914

North Street

Avon Street

Grade of this portion  
of St. to be determined  
after header is set  
across Windsor St at  
Avon St.

OFFICE OF CITY ENGINEER  
HARTFORD, CONN.  
Date: Jan. 14, 1914  
357-108