

CONSTRUCT NEW 8" REINF. CONC. SIDEWALK RAMP
(TYPE 1) 5" CONC. WALK AND INSTALL NEW
STRAIGHT GRANITE CURB

APPROX. LIMIT OF CONSTRUCTION
STA. 9+87 AT WOOD STREET

INSTALL GEOTEXTILE FABRIC, PRIOR TO
PLACING PROCESSED TRAPROCK BASE,
STA. 9+87 TO STA. 15+00.

EXCAVATE EXISTING PAVEMENT 17" BELOW FINISHED
GRADE. CONSTRUCT 12" PROCESSED TRAPROCK BASE,
3 1/2" PREMIXED BIT CONC. BINDER COURSE, AND
1 1/2" BIT CONC. SURFACE COURSE (CLASS I) STA.
9+87 TO STA. 15+00.

CONSTRUCT NEW 8" REINF. CONC. SIDEWALK RAMP
(TYPE 1) 5" CONC. WALK AND RESET.
STRAIGHT GRANITE CURB

CONSTRUCT NEW 8" REINF. CONC. SIDEWALK RAMP
(TYPE 2) 5" CONC. WALK AND RESET RADIUS
GRANITE CURB

INSTALL HARTFORD TYPE "C" CB.

INSTALL 12" OF NEW 15" PVC
DRAIN PIPE (min. slope=0.50%)

NOTES:

1. RIM OR FRAME ELEVATIONS OF ALL UTILITY GATE BOXES,
HANDHOLES, AND CATCH BASINS ARE TO BE ADJUSTED AS
REQUIRED TO MATCH PROPOSED FINISHED PAVED SURFACES.

2. (B) CONSTRUCT BIT. CONC. DRIVEWAY RAMP

(C) SAWCUT BETWEEN EXISTING RAMPED SECTION AND
SIDEWALK AND CONSTRUCT 8" REINF. CONC. DRIVEWAY
RAMP

(E) EXIST. DRIVEWAY RAMP TO REMAIN

(S) CONSTRUCT 8" REINF. CONC. SIDEWALK

3. CALL BEFORE YOU DIG - THE CONTRACTOR IS HEREBY REMINDED
THAT TITLE 16 CHAPTER 293 OF THE CONNECTICUT GENERAL
STATUTES REQUIRES NOTIFICATION TO UTILITY COMPANIES
OF PENDING EXCAVATION AT OR NEAR PUBLIC UTILITIES. THE
CONTRACTOR SHALL CALL 1-800-922-4455 AT LEAST 48 HOURS
PRIOR TO EXCAVATION.


4. INSTALL 6" OF 6"x18" GRANITE CURB TO BE SET ON EACH
SIDE OF CATCH BASIN WHERE INSTALLING BIT. CONC. LIP
CURBING.

STRIP BIT PAVEMENT FROM
CONC. BASE REPAIR CONC.
BASE AT CURB CORNERS.

NOTE:
TOP OF PROP. CURB SHALL FOLLOW 6"
ABOVE GUTTER GRADE (TYP.)

PLAN

APPROX. LIMIT OF CONSTRUCTION
STA. 9+ 87 AT WOOD STREET

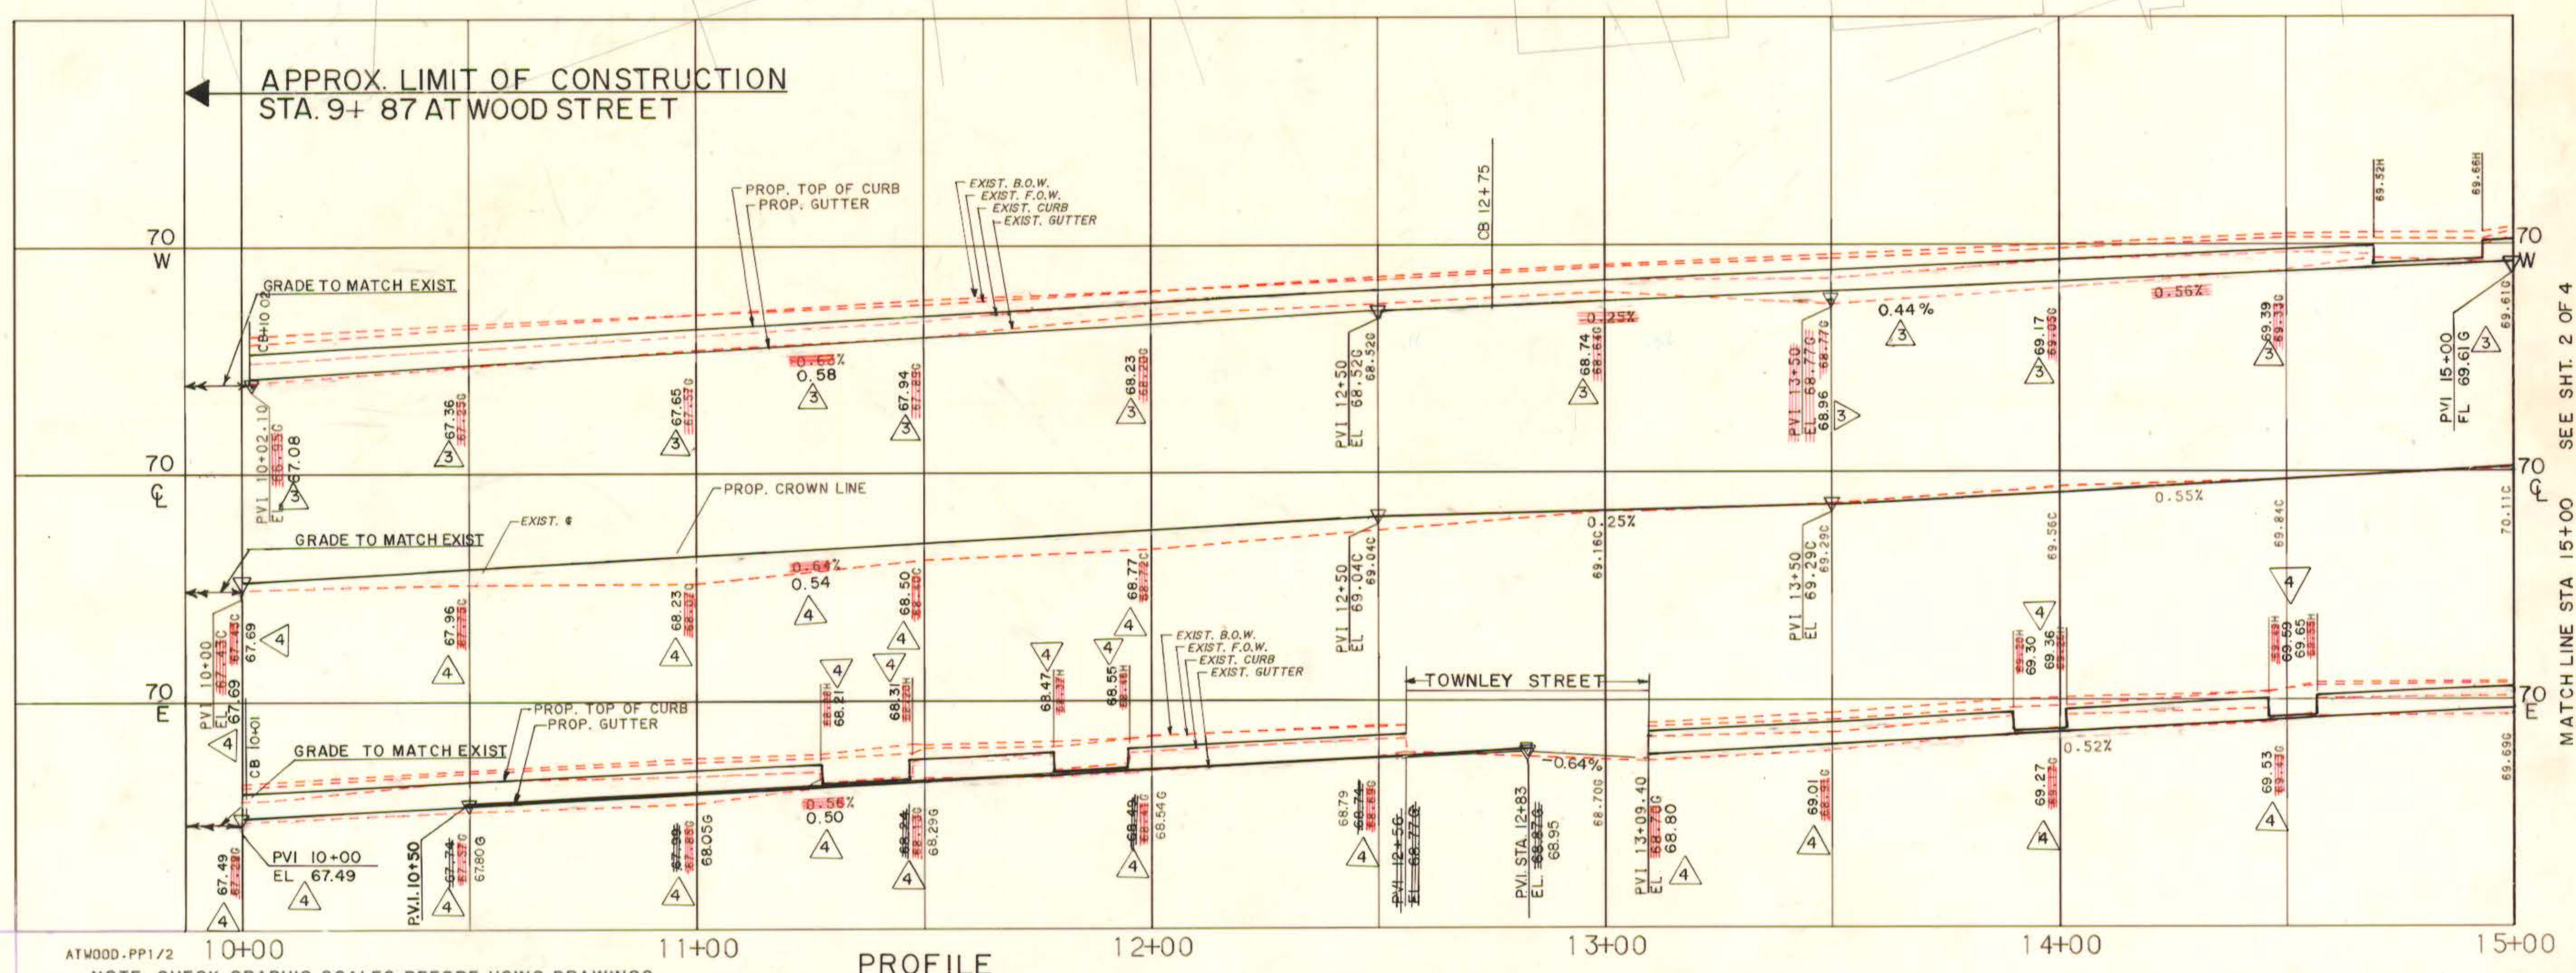

ATWOOD.PP1/2

NOTE: CHECK GRAPHIC SCALES BEFORE USING DRAWINGS

PROFILE

REVISIONS		SUPV. JAC		GRAPHIC SCALES		ROADWAY RECONSTRUCTION HARTFORD, CONNECTICUT		Hayden Wegman Consulting Engineers		CITY OF HARTFORD, CONNECTICUT DEPARTMENT OF PUBLIC WORKS BUREAU OF ENGINEERING SERVICES		ATWOOD STREET STA 9+87 TO STA 15+00		PLAN AND PROFILE		SHEET 1 OF 4	
		DESIGN MDH/AEC		HORIZ. 1"=20'													
		DRAWN RG		VERT. 1"=2'													
		CHECKED AEC															
		DATE 03-05-86															

1-25-88 Add/Change R/F

1-29-88 Profile Change R/F

9-9-87 Redid Contract

2-10-87 ENGINEER CHANGES - DRAFTED BY: HJN

WEST HARTFORD

NEW YORK • BOSTON • BUFFALO

ATLANTA • MEMPHIS

DAYBOOK NO. 011018H

DATE 4-21-87

Contract No. E-87-23R

Job No. - 85253