



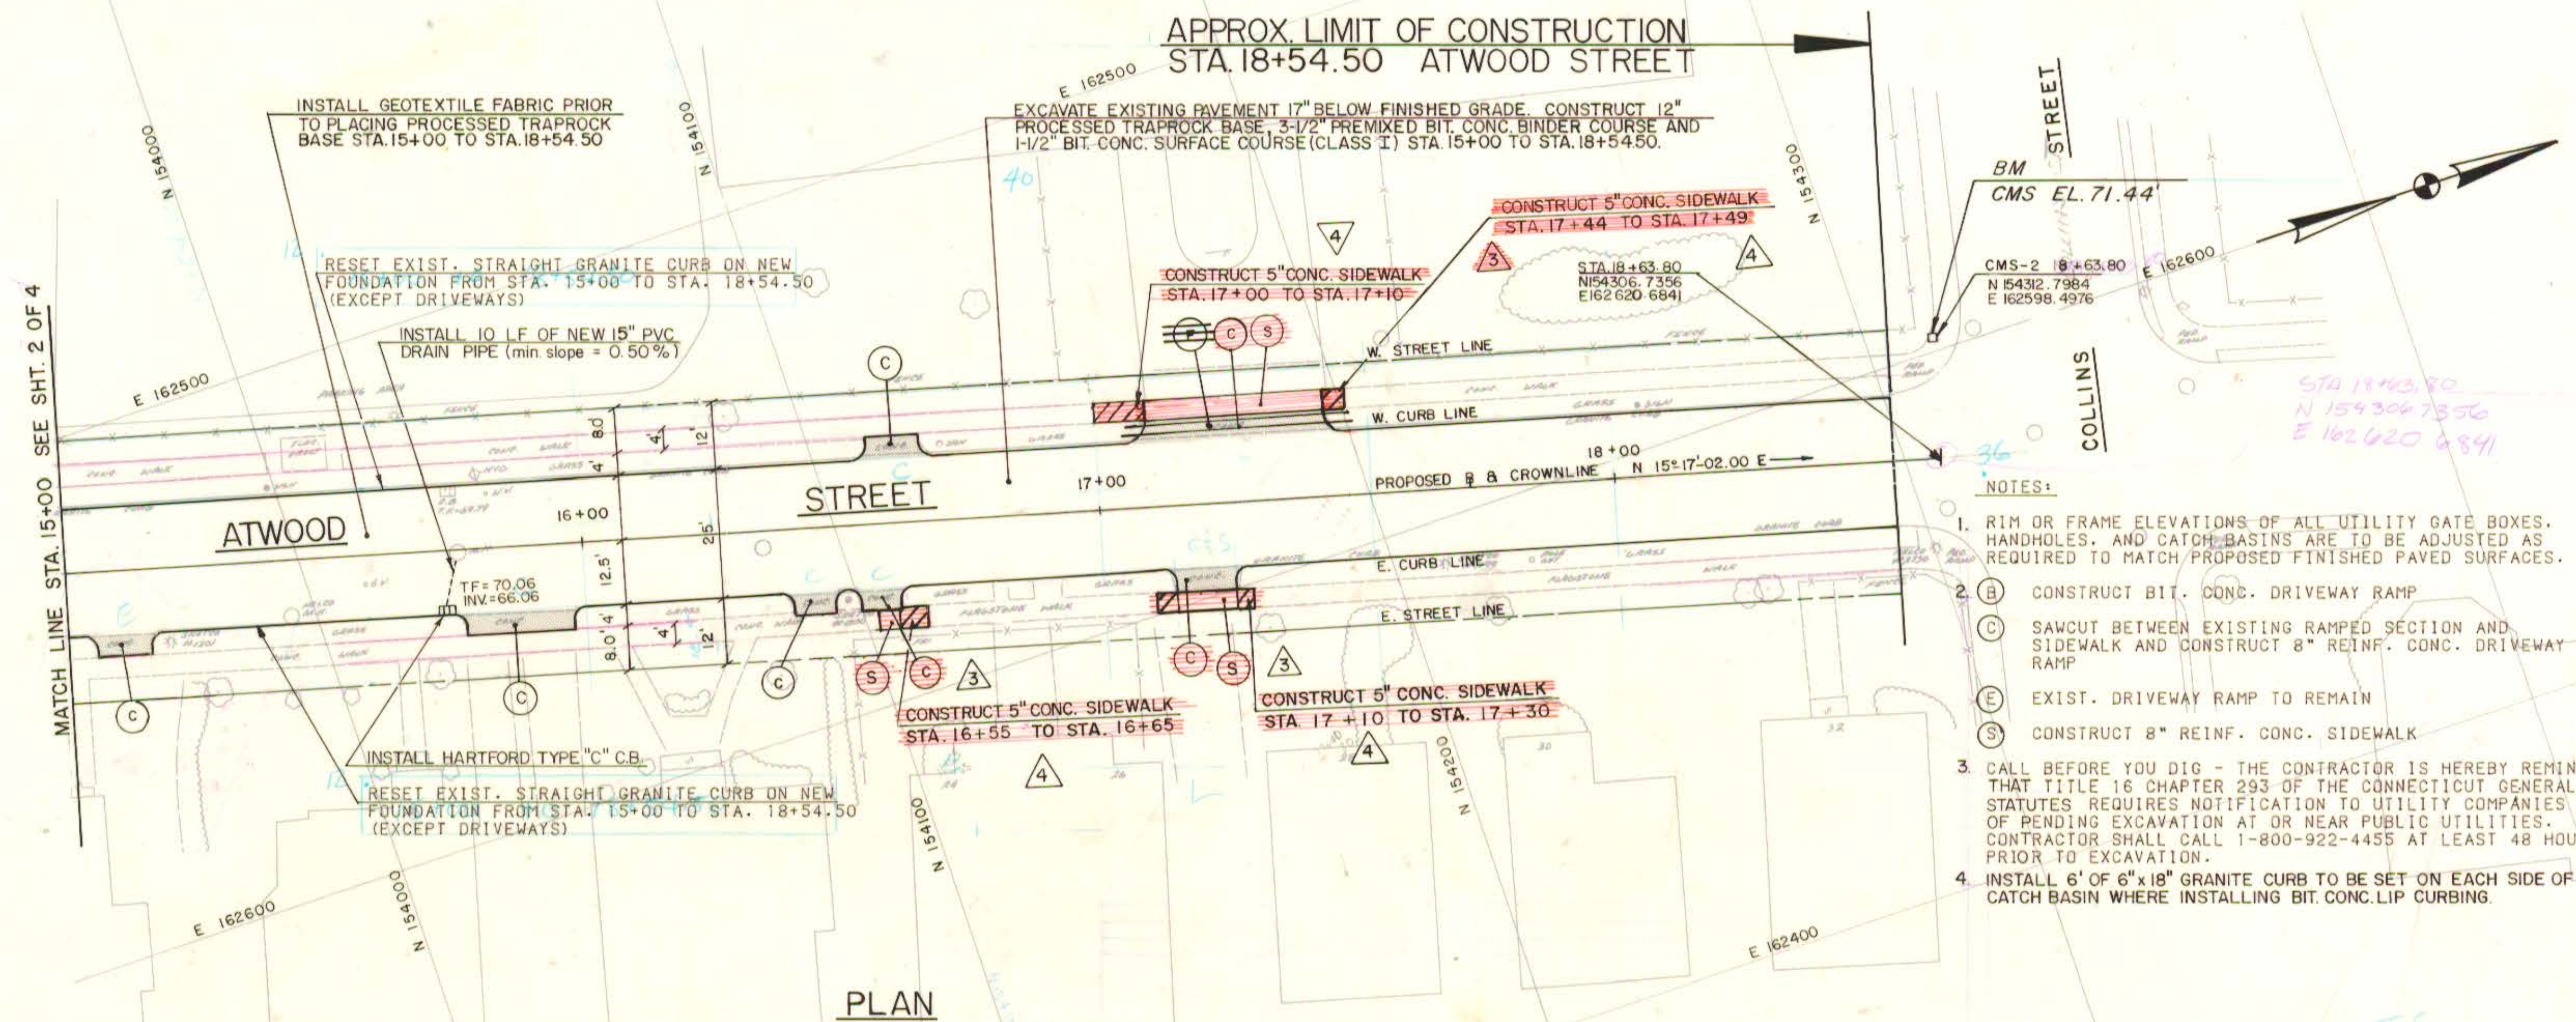

- NOTES:
1. RIM OR FRAME ELEVATIONS OF ALL UTILITY GATE BOXES, HANDHOLES, AND CATCH BASINS ARE TO BE ADJUSTED AS REQUIRED TO MATCH PROPOSED FINISHED PAVED SURFACES.
 2. (B) CONSTRUCT BIT. CONC. DRIVEWAY RAMP
 - (C) SAWCUT BETWEEN EXISTING RAMPED SECTION AND SIDEWALK AND CONSTRUCT 8" REINF. CONC. DRIVEWAY RAMP
 - (E) EXIST. DRIVEWAY RAMP TO REMAIN
 - (S) CONSTRUCT 8" REINF. CONC. SIDEWALK
 3. CALL BEFORE YOU DIG - THE CONTRACTOR IS HEREBY REMINDED THAT TITLE 16 CHAPTER 293 OF THE CONNECTICUT GENERAL STATUTES REQUIRES NOTIFICATION TO UTILITY COMPANIES OF PENDING EXCAVATION AT OR NEAR PUBLIC UTILITIES. THE CONTRACTOR SHALL CALL 1-800-922-4455 AT LEAST 48 HOURS PRIOR TO EXCAVATION.
 4. INSTALL 6' OF 6"x18" GRANITE CURB TO BE SET ON EACH SIDE OF CATCH BASIN WHERE INSTALLING BIT. CONC. LIP CURBING.

NOTE:
TOP OF PROP. CURB SHALL FOLLOW 6"
ABOVE GUTTER GRADE (TYP.)

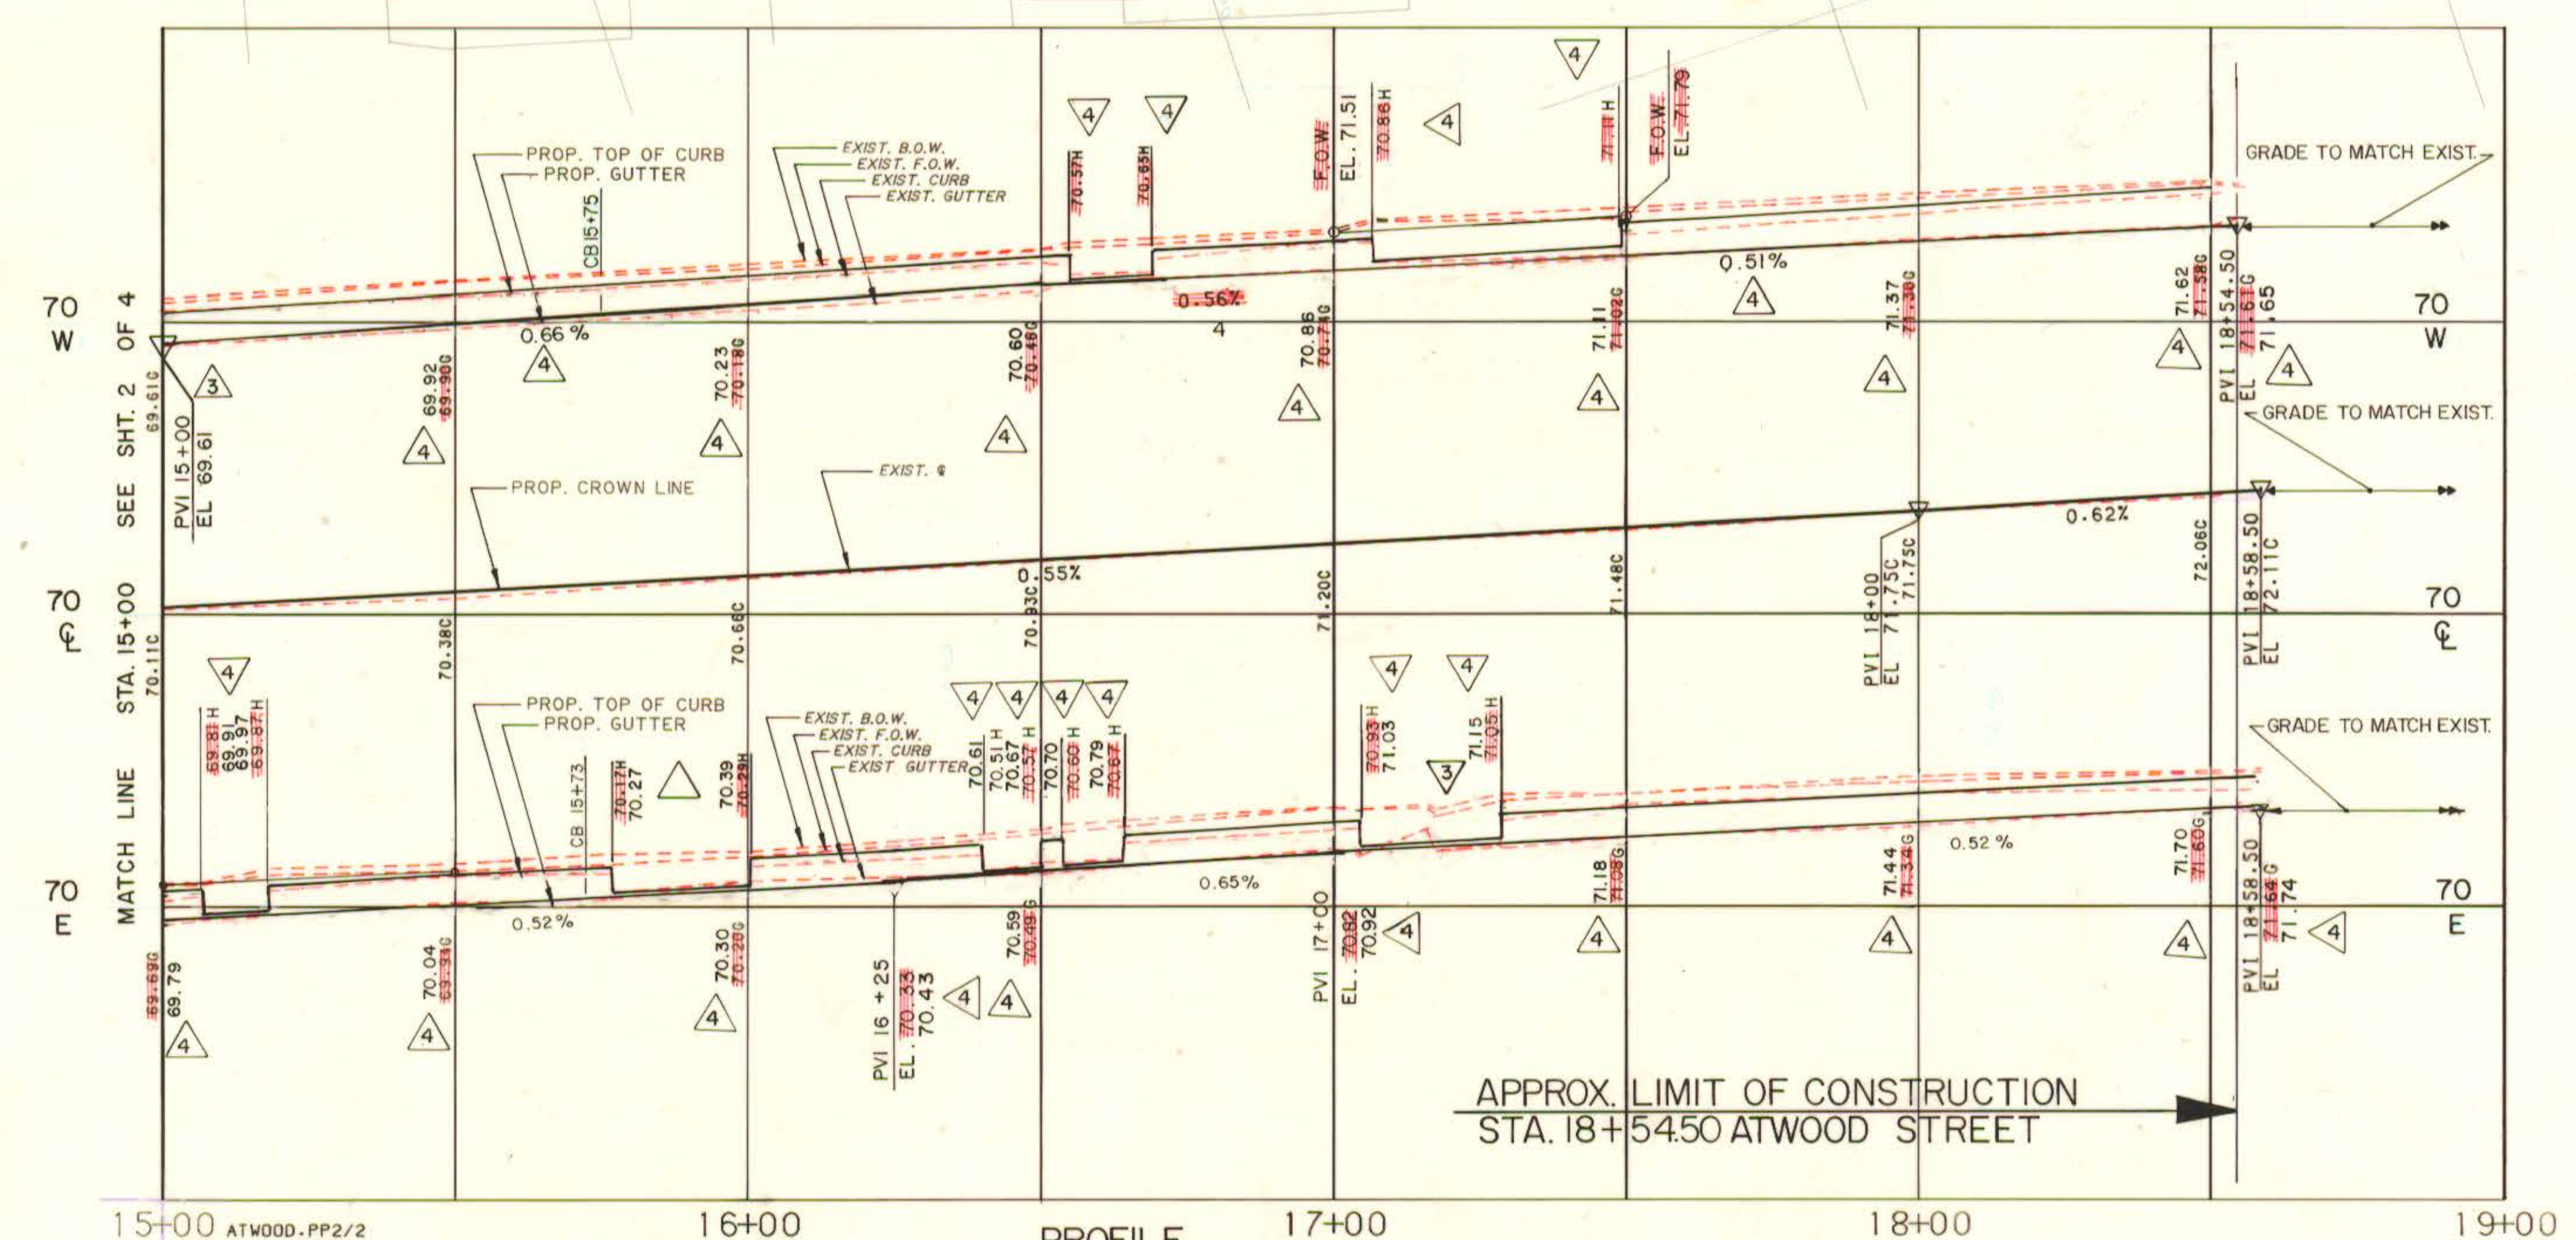

SUPV. JAC DESIGN MDH/AEC DRAWN N. D. FORTIN CHECKED AEC DATE 03-05-86		GRAPHIC SCALES HORIZ. 1" = 20' VERT. 1" = 2'	ROADWAY RECONSTRUCTION HARTFORD, CONNECTICUT		Hayden Wegman Consulting Engineers WEST HARTFORD NEW YORK • BOSTON • BUFFALO ATLANTA • MEMPHIS	CITY OF HARTFORD, CONNECTICUT DEPARTMENT OF PUBLIC WORKS BUREAU OF ENGINEERING SERVICES DAYBOOK NO. 010108 I DATE 4-21-87	ATWOOD STREET STA. 15+00 TO STA. 18+54.50 PLAN AND PROFILE Contract No. E67-23R Job No. 85253	SHEET 2 OF 4
---	--	--	---	--	---	---	---	-----------------