
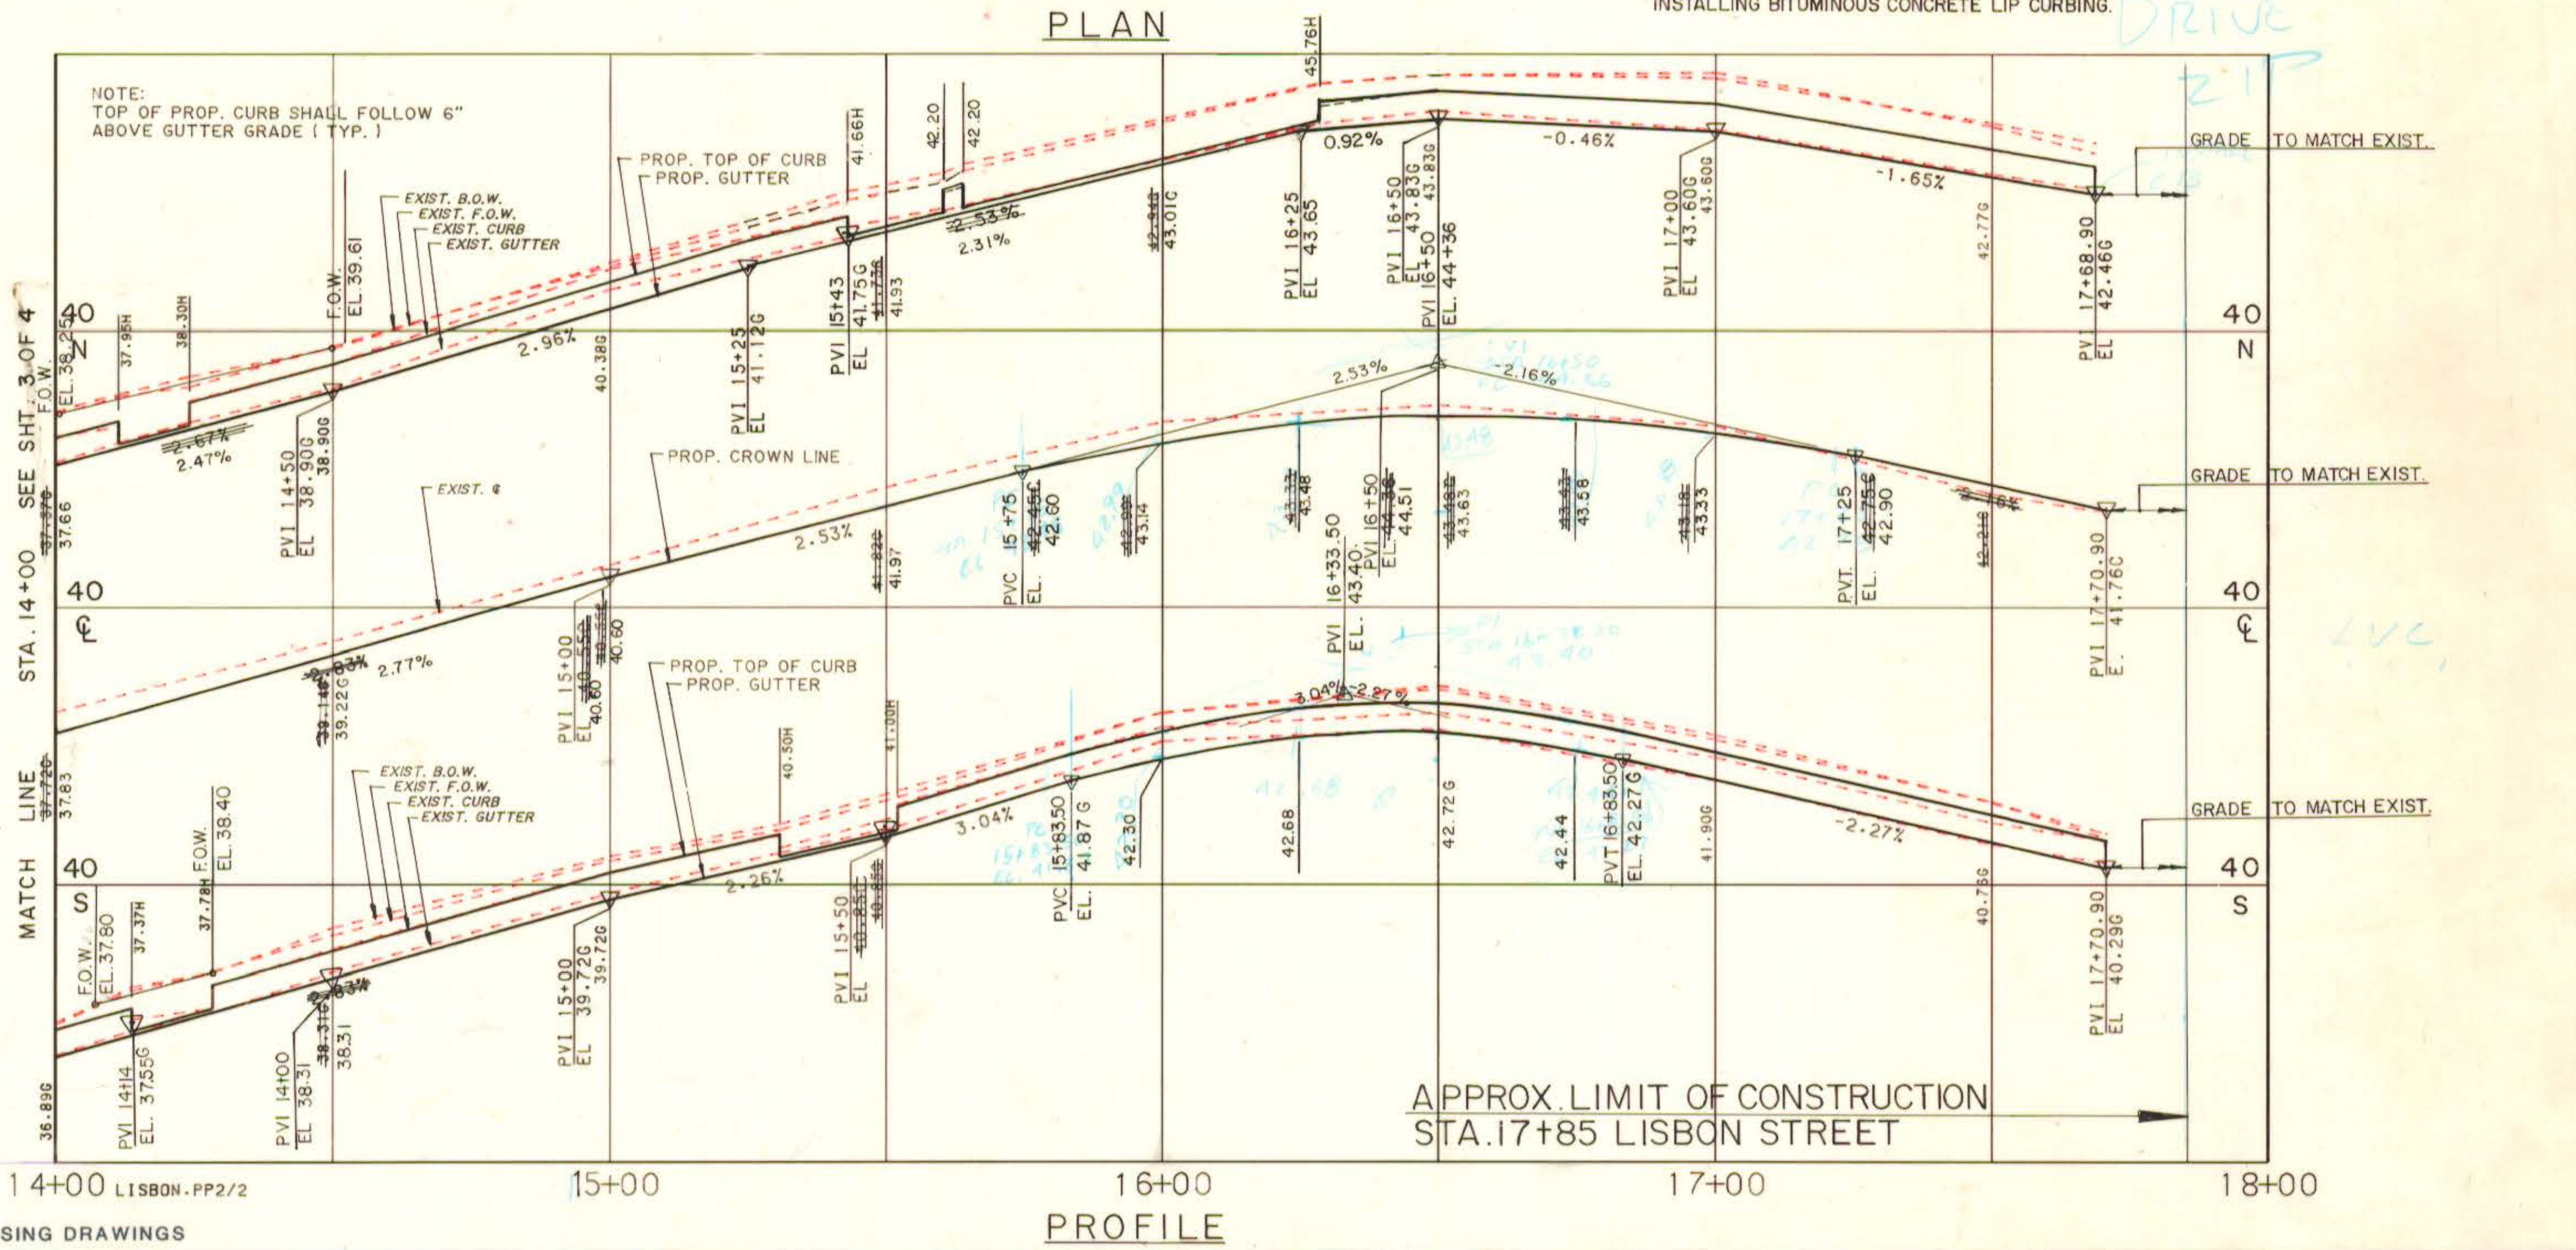


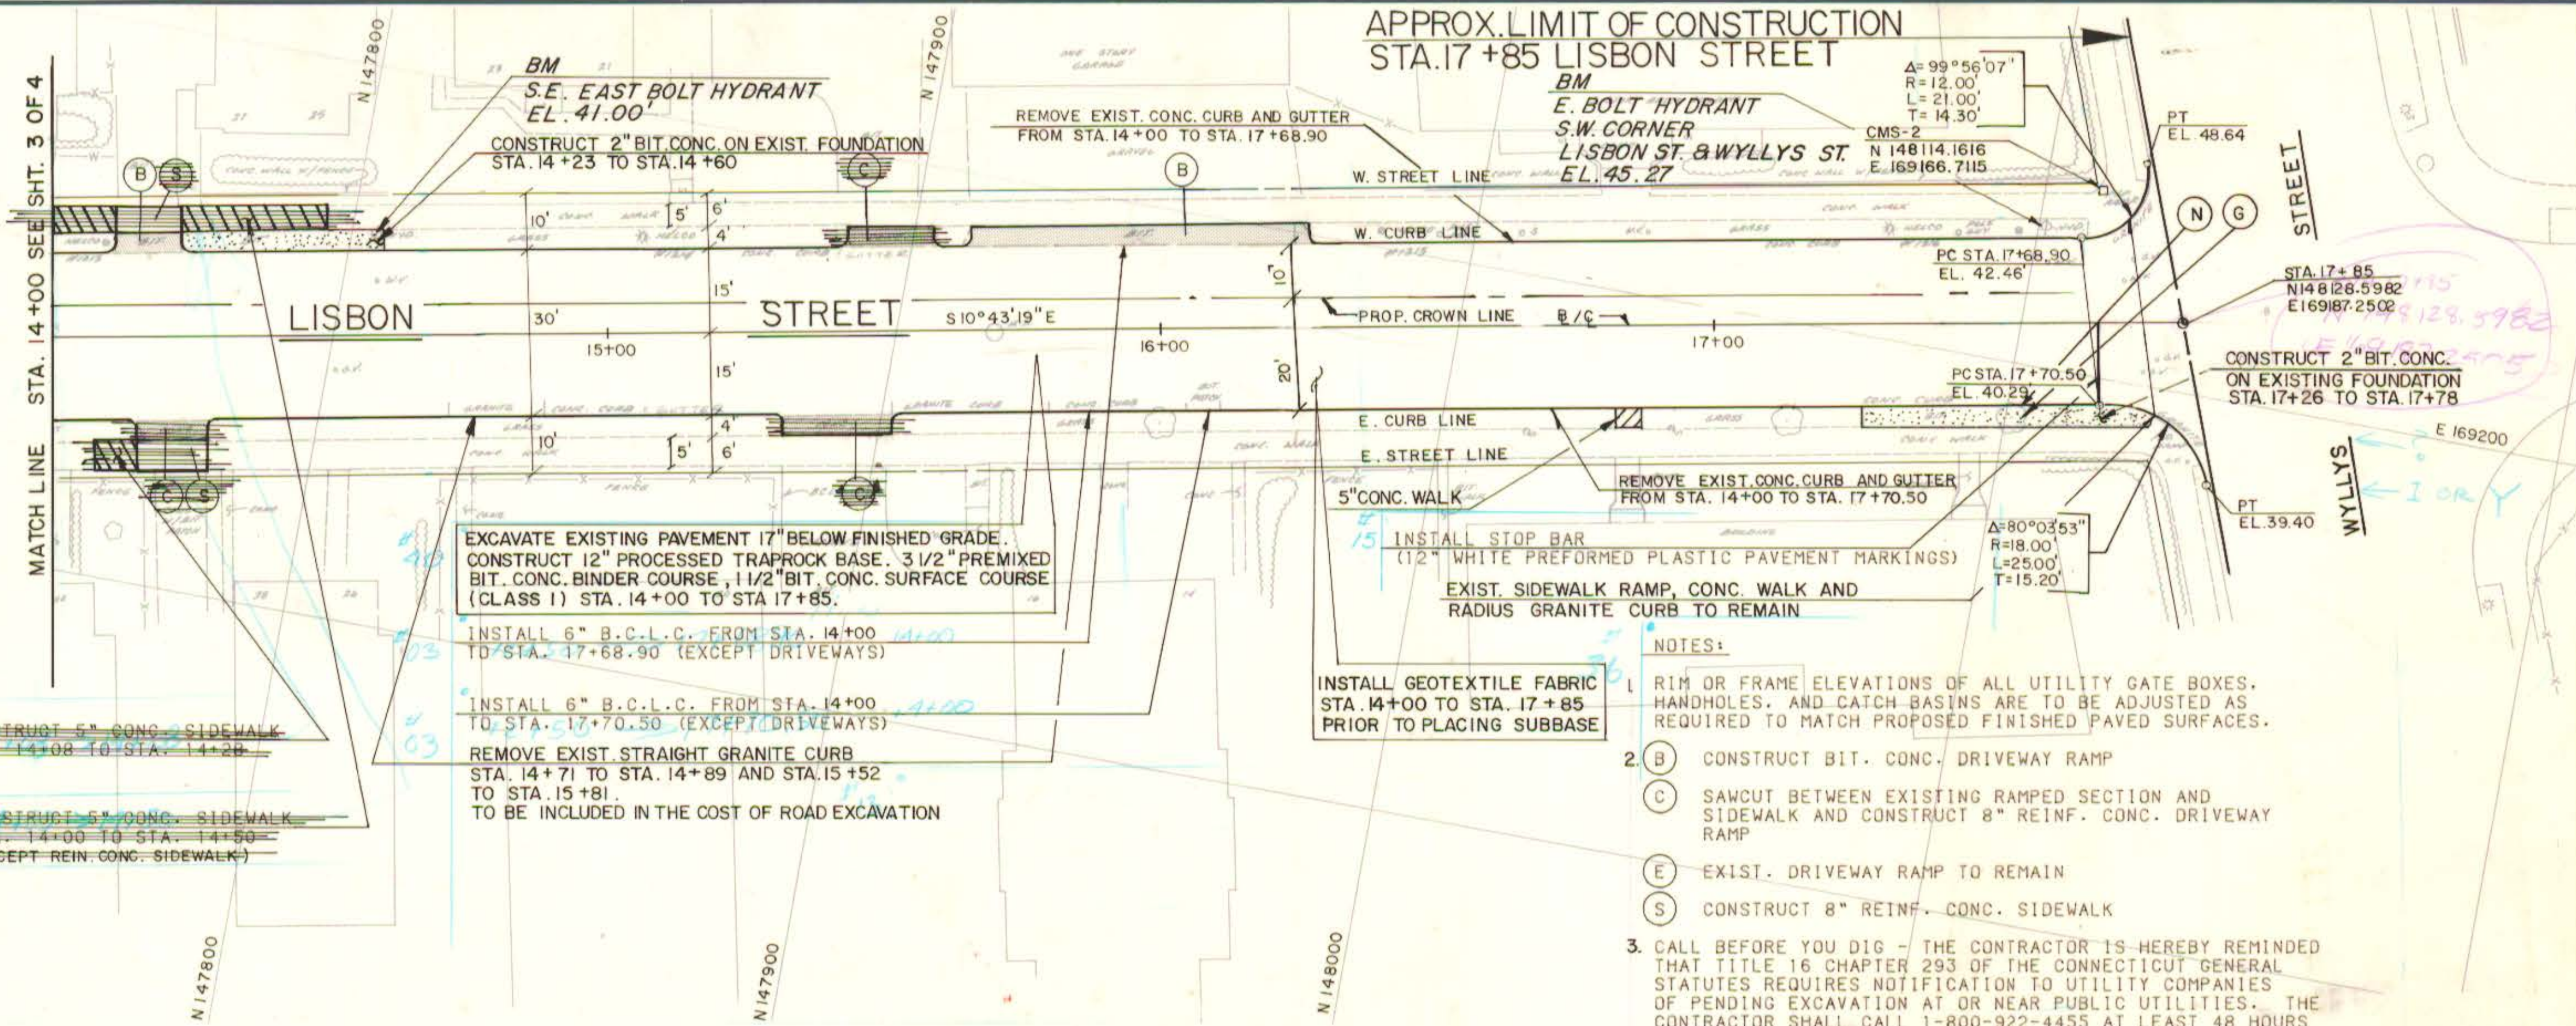

SUPV. JAC		GRAPHIC SCALES		ROADWAY RECONSTRUCTION		CITY OF HARTFORD, CONNECTICUT		LISBON STREET	
DESIGN MDH/AEC		HORIZ. 1"=20'		HARTFORD, CONNECTICUT		DEPARTMENT OF PUBLIC WORKS		STA. 14+00 TO STA. 17+85	
DRAWN MJN		VERT. 1"=2'		REGISTERED PROFESSIONAL ENGINEER		BUREAU OF ENGINEERING SERVICES		PLAN AND PROFILE	
CHECKED AEC		DATE 03-01-86		WEST HARTFORD		DAYBOOK NO. 01018 K		Contract No. E88-26	
REVISIONS				NEW YORK • BOSTON • BUFFALO		DATE 4-21-87		Job No. -85253	
2 9-9-87 Robin Contract				ATLANTA • MEMPHIS				SHEET 4	
01 02/24/87 ENGINEERING CHANGES DRAFTED BY MJN								OF 4	
NO. DATE DESCRIPTION									