


Plan showing location of test holes
made in concrete pavement on Capitol
Avenue to determine wear.

Note book 397 Page 110
Scale: 1 inch equals 20 feet.

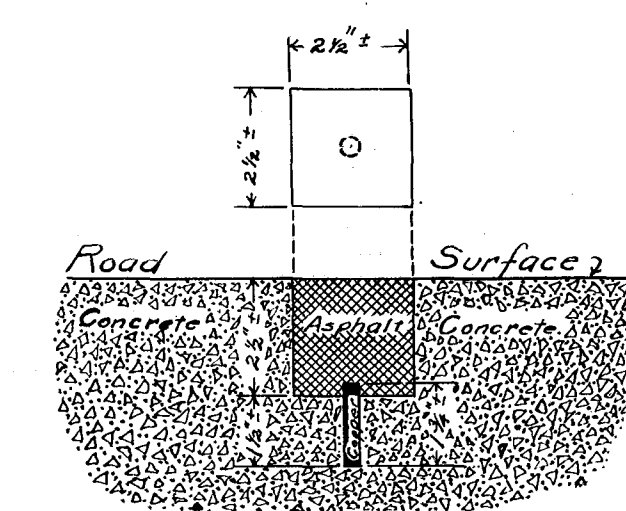

Scale: 1/4 inch equals 1 inch.

Department of Engineering,
Hartford, Conn.
Daybook No. 03792. May 1915.

