


PROFILE
BURLINGTON ST

Curb 12.80' out
5' walk 6.50' out - 7.924'
change aug 1937
up 0.15

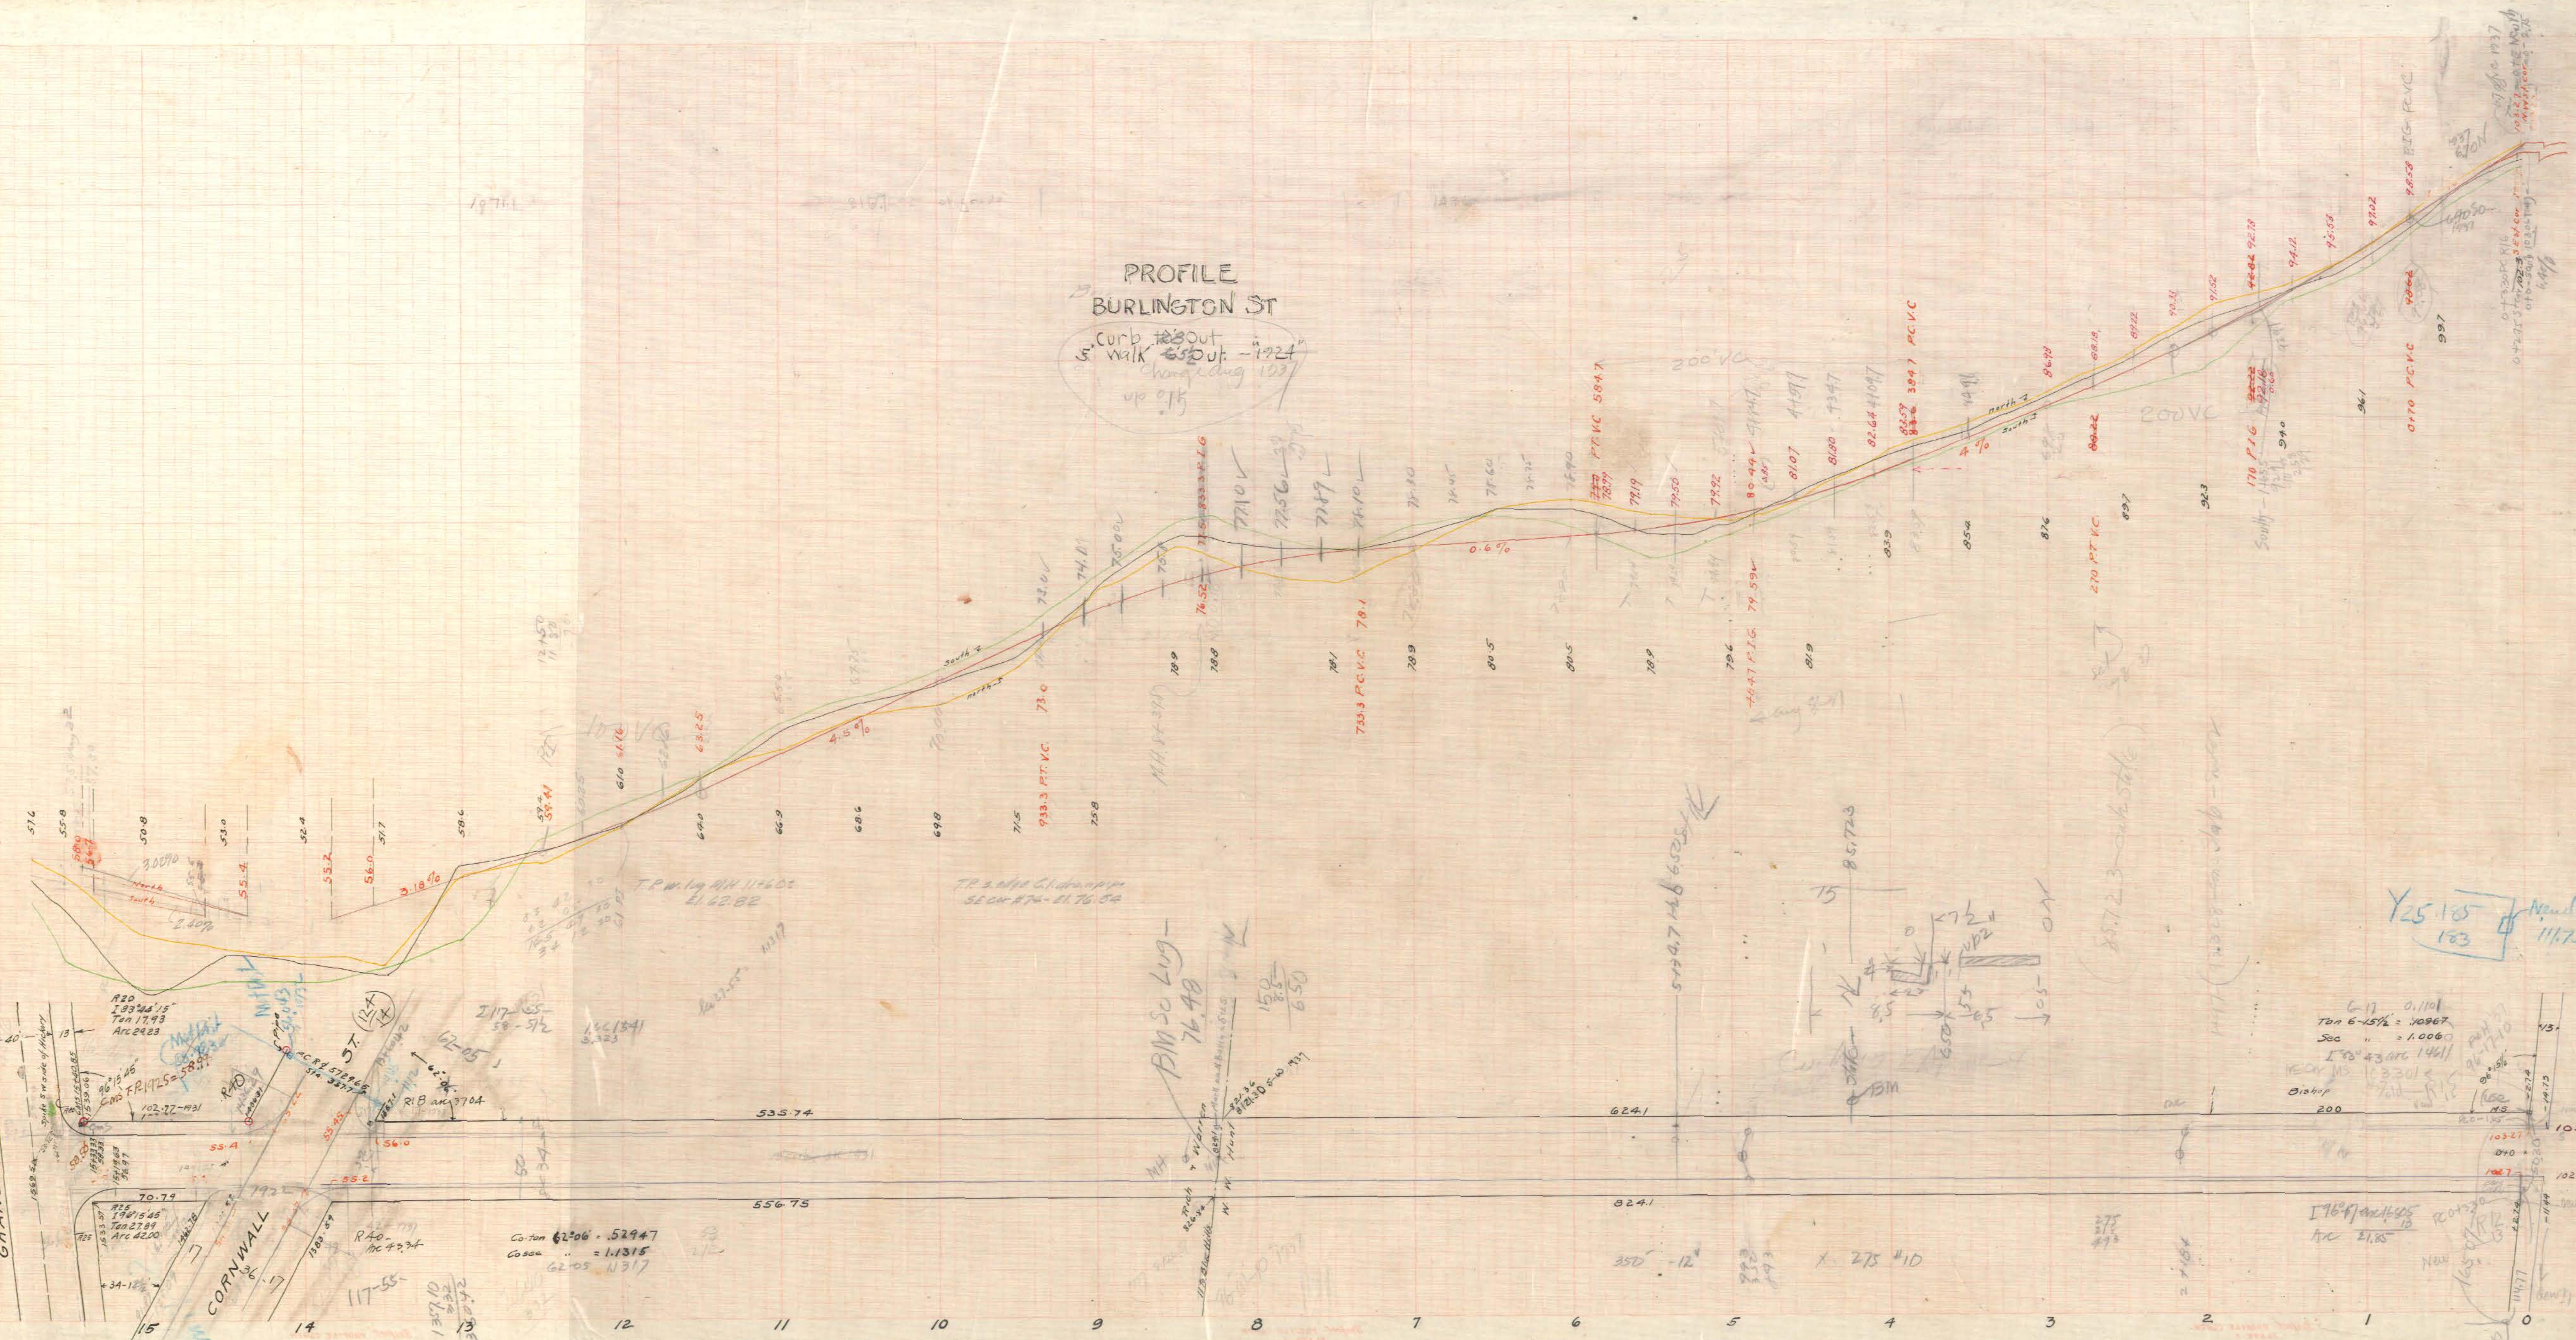

Y25.185
103

BLUE HILLS AVE.

See Profile for Grd. Cont.

1912

303-50

031-46