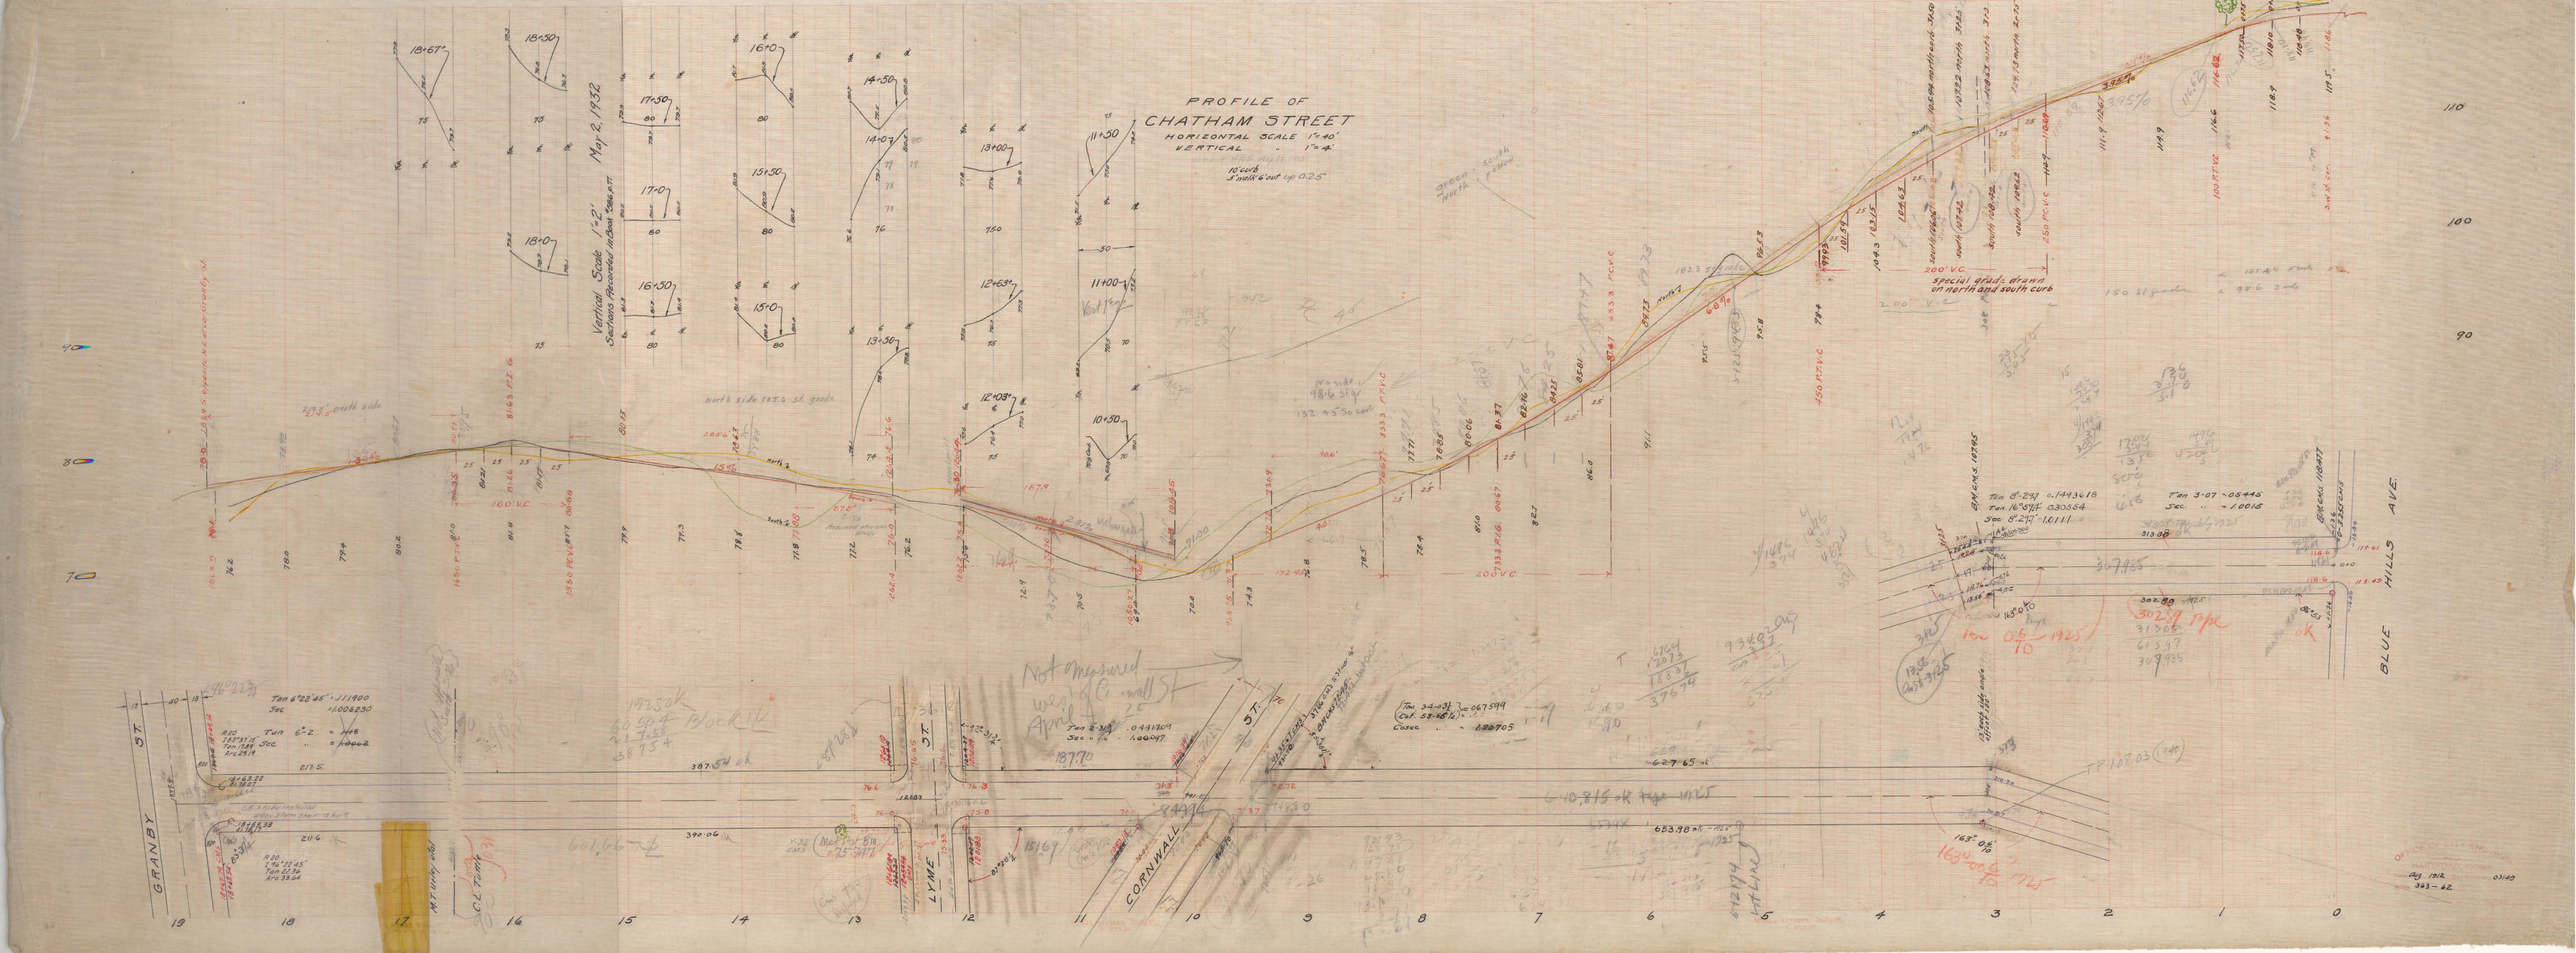
PROFILE OF
CHATHAM STREET
HORIZONTAL SCALE 1" = 40'
VERTICAL - 1" = 4'
Vertical Scale 1" = 2'
Sections Recorded in Book 586, p. 177
May 2, 1932
GRANBY ST.
LYME ST.
CORNWALL ST.
BLUE HILLS AVE.
200' V.C.
100' V.C.
Special Grade, drawn on both curb and south curb