


See New Profile 124  
(1092)

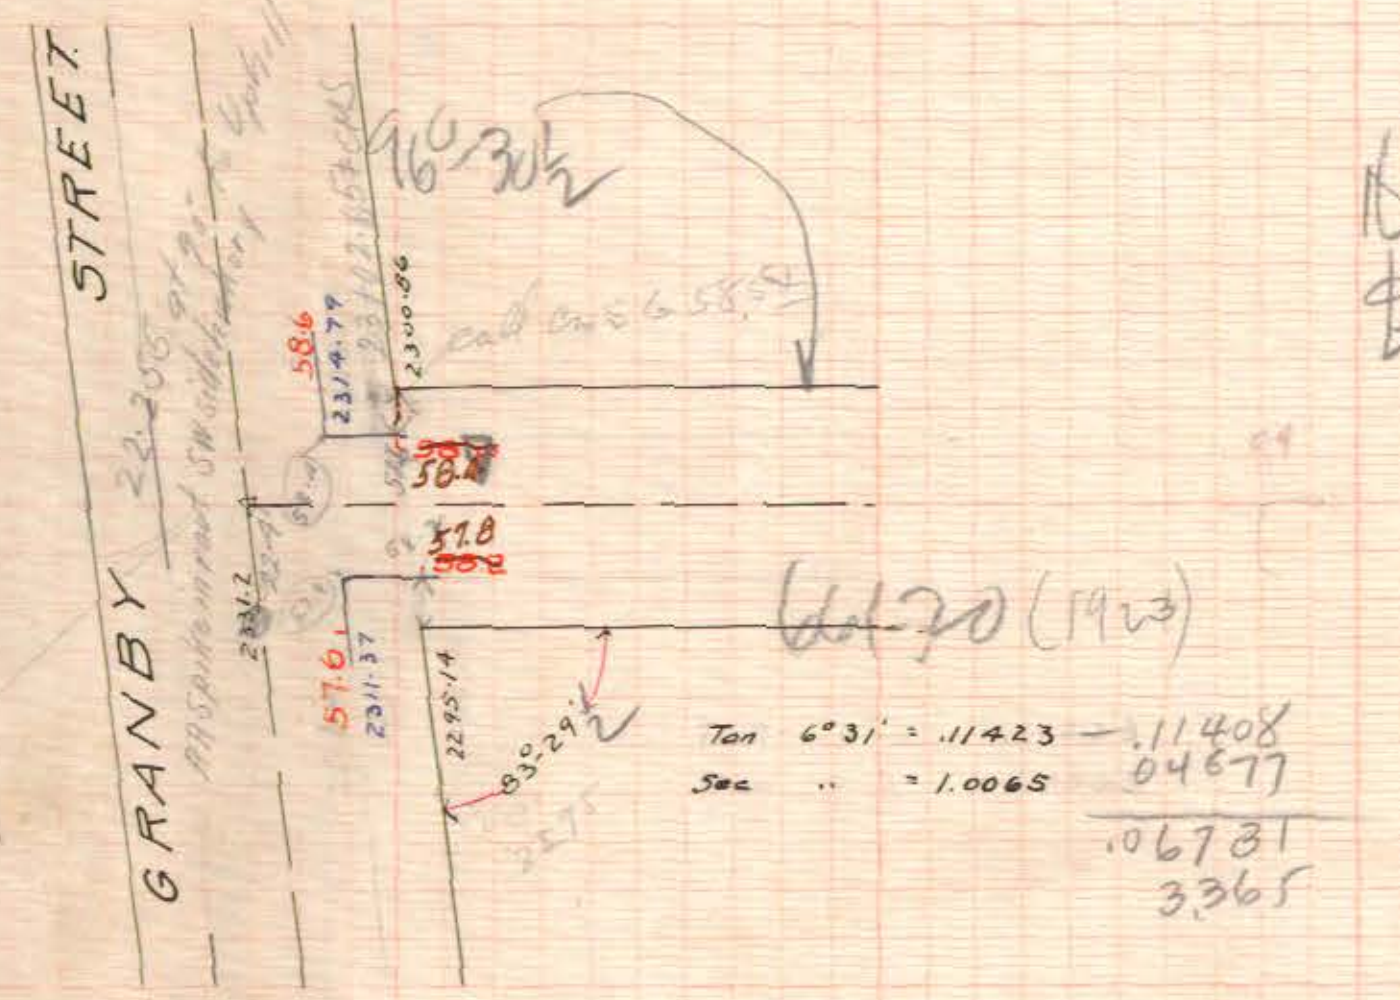

Block Measured - 1923  
 664.57  
 661.20  
 664.57

