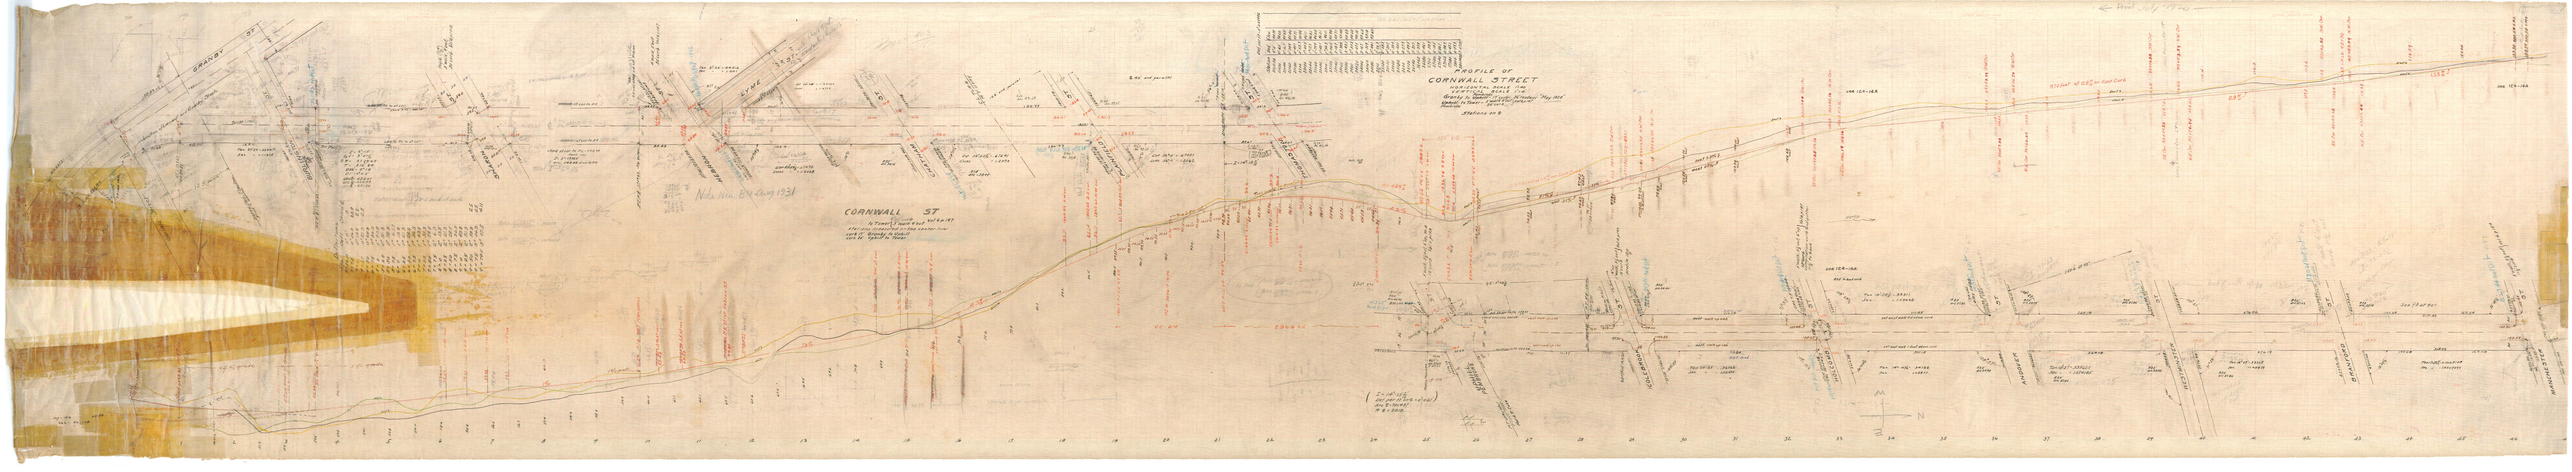
PROFILE OF
CORNWALL STREET
HORIZONTAL SCALE 1"=40'
VERTICAL SCALE 1"=4'
Stations as B
CORNWALL ST.
GRANBY ST.
Note Nov 6th Aug 1931