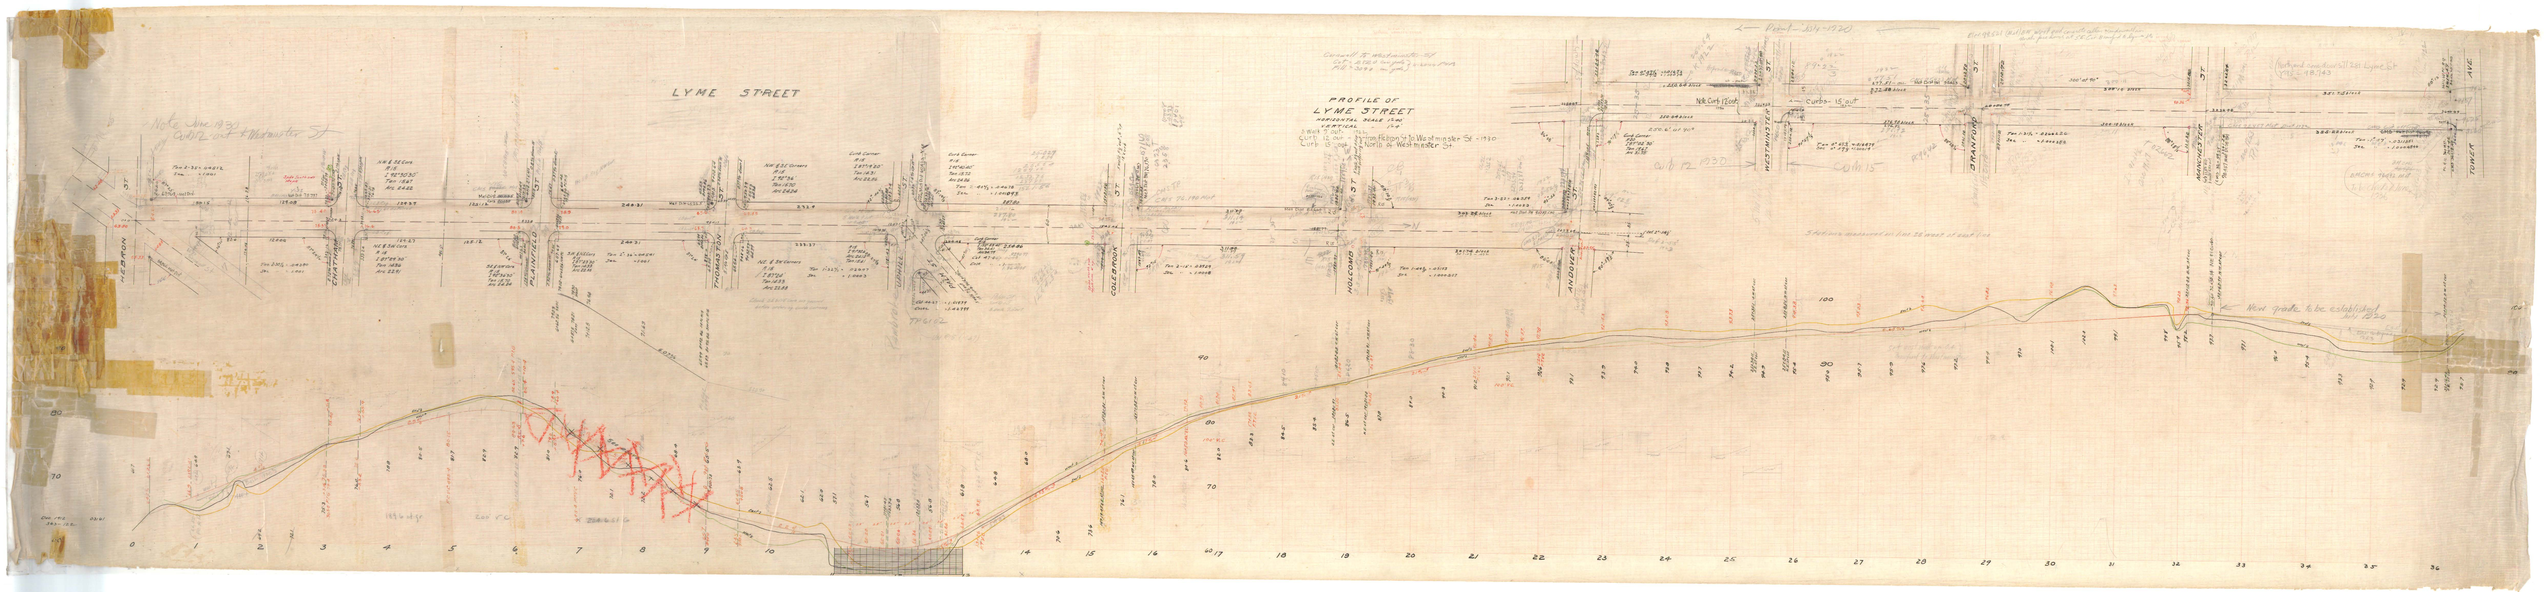
LYME STREET
PROFILE OF
LYME STREET
HOLCOMB ST
WESTMINSTER ST
MANCHESTER ST
TOWER AVE
Curbs 15 out
New grade to be established