


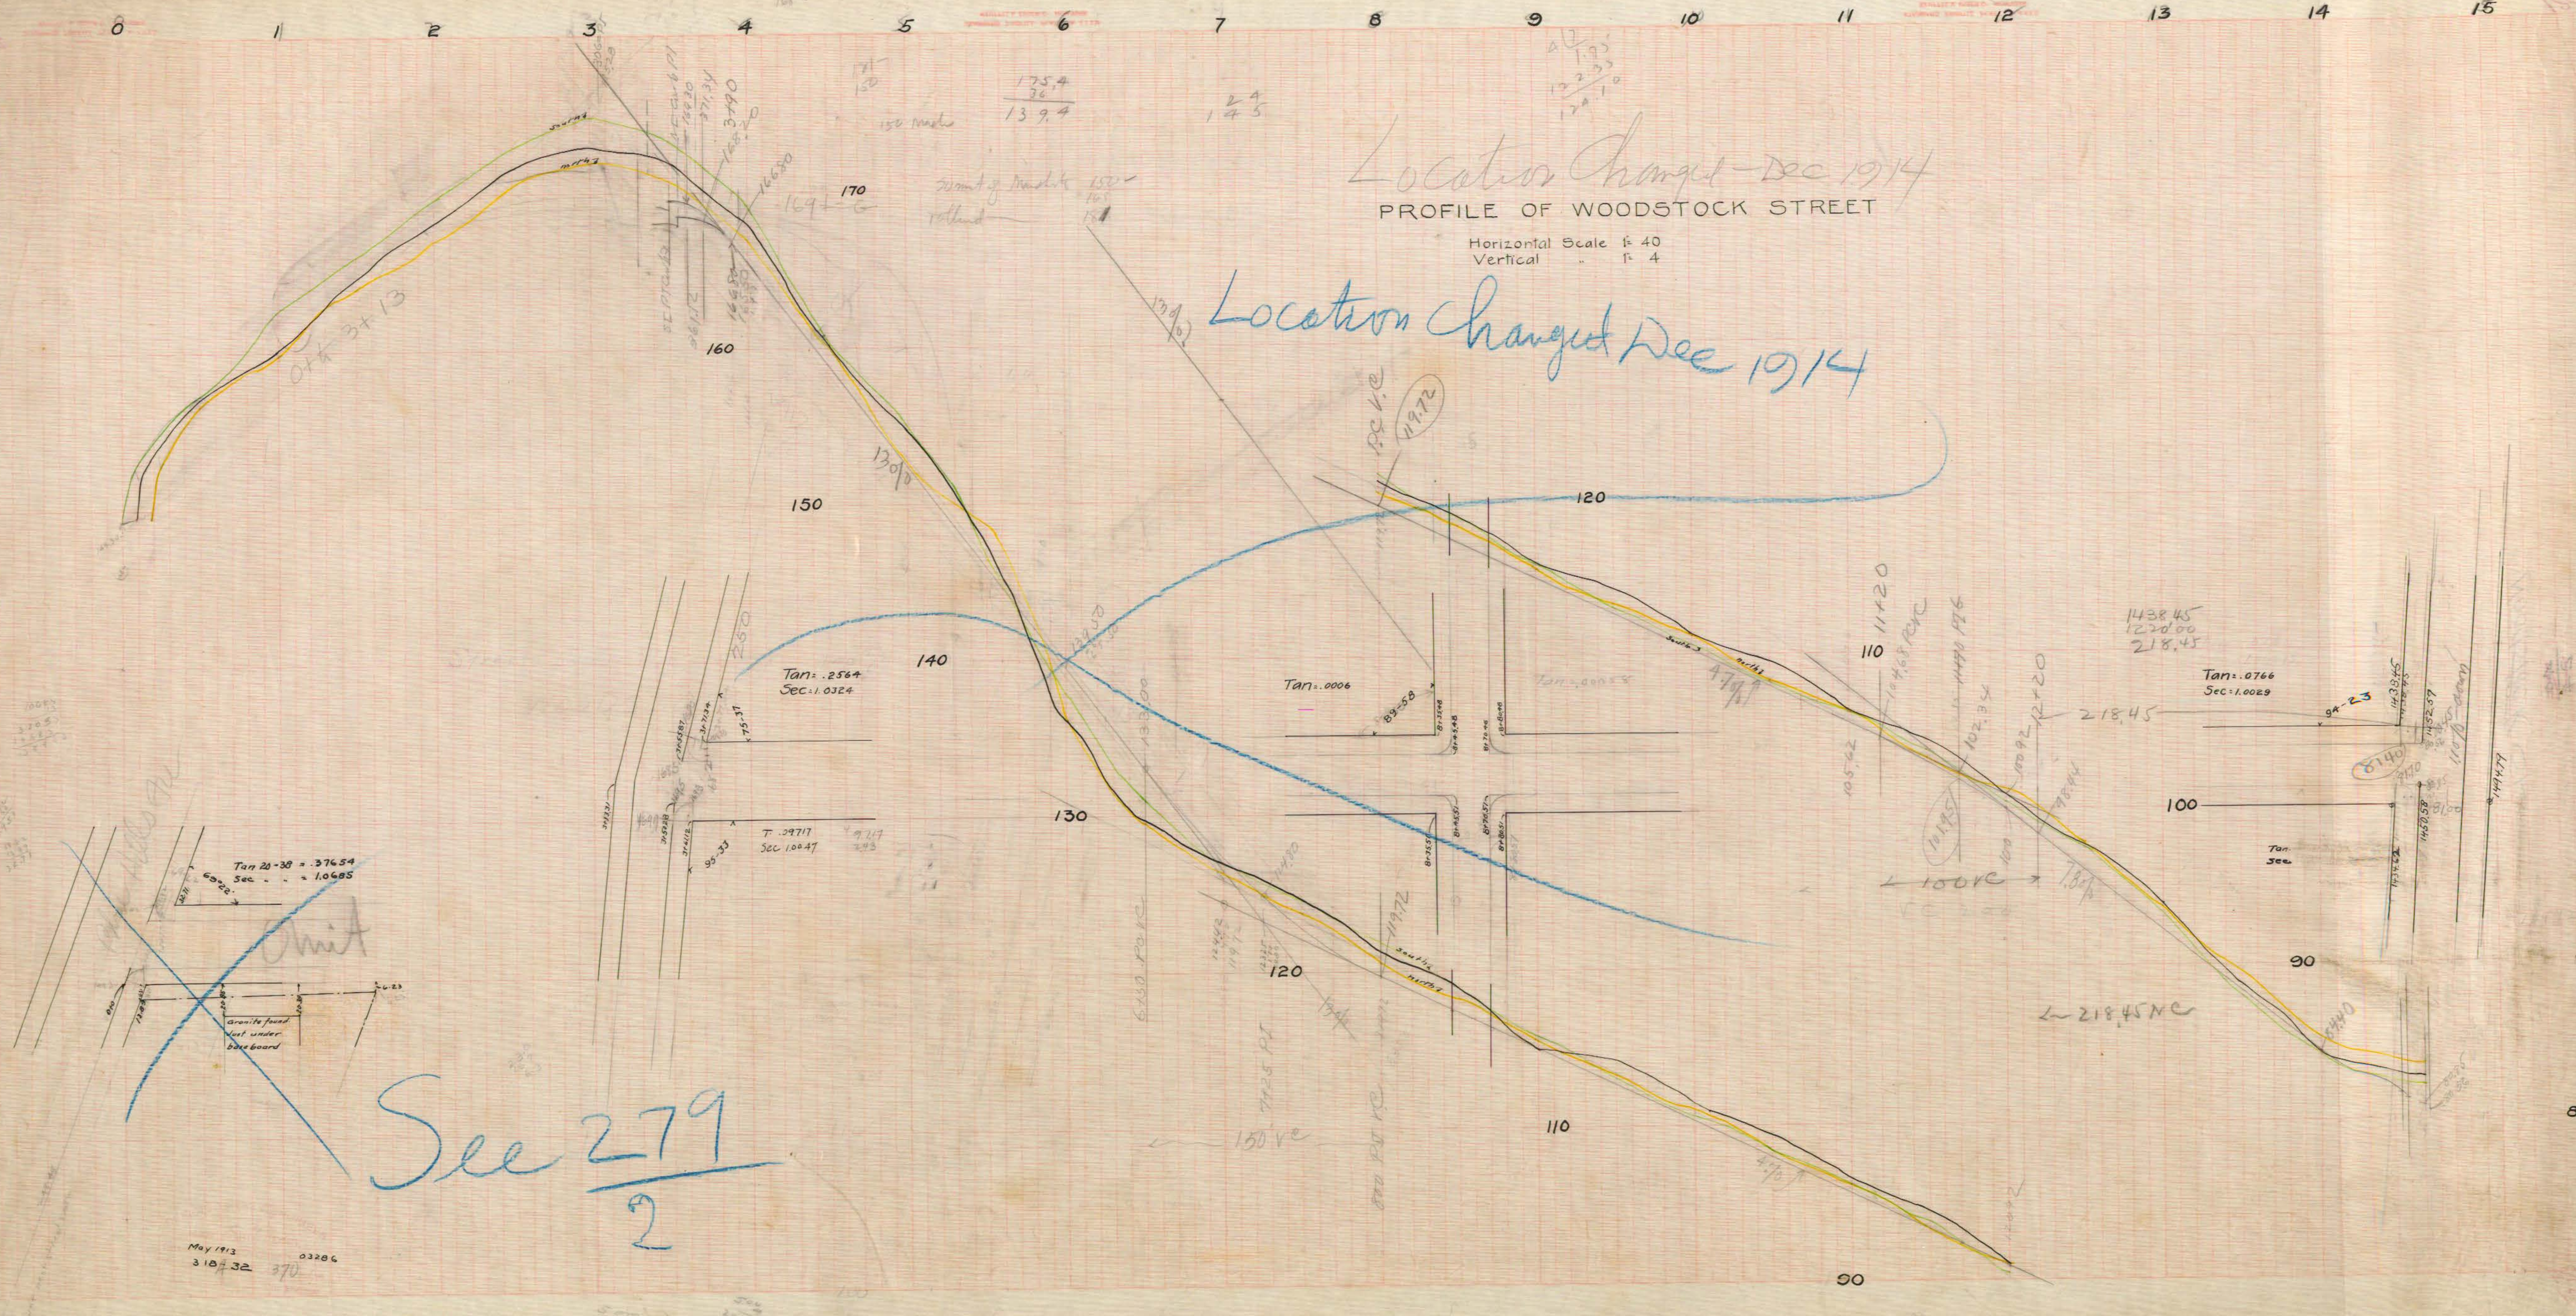

See $\frac{279}{2}$

May 1913
318A32 370 0328