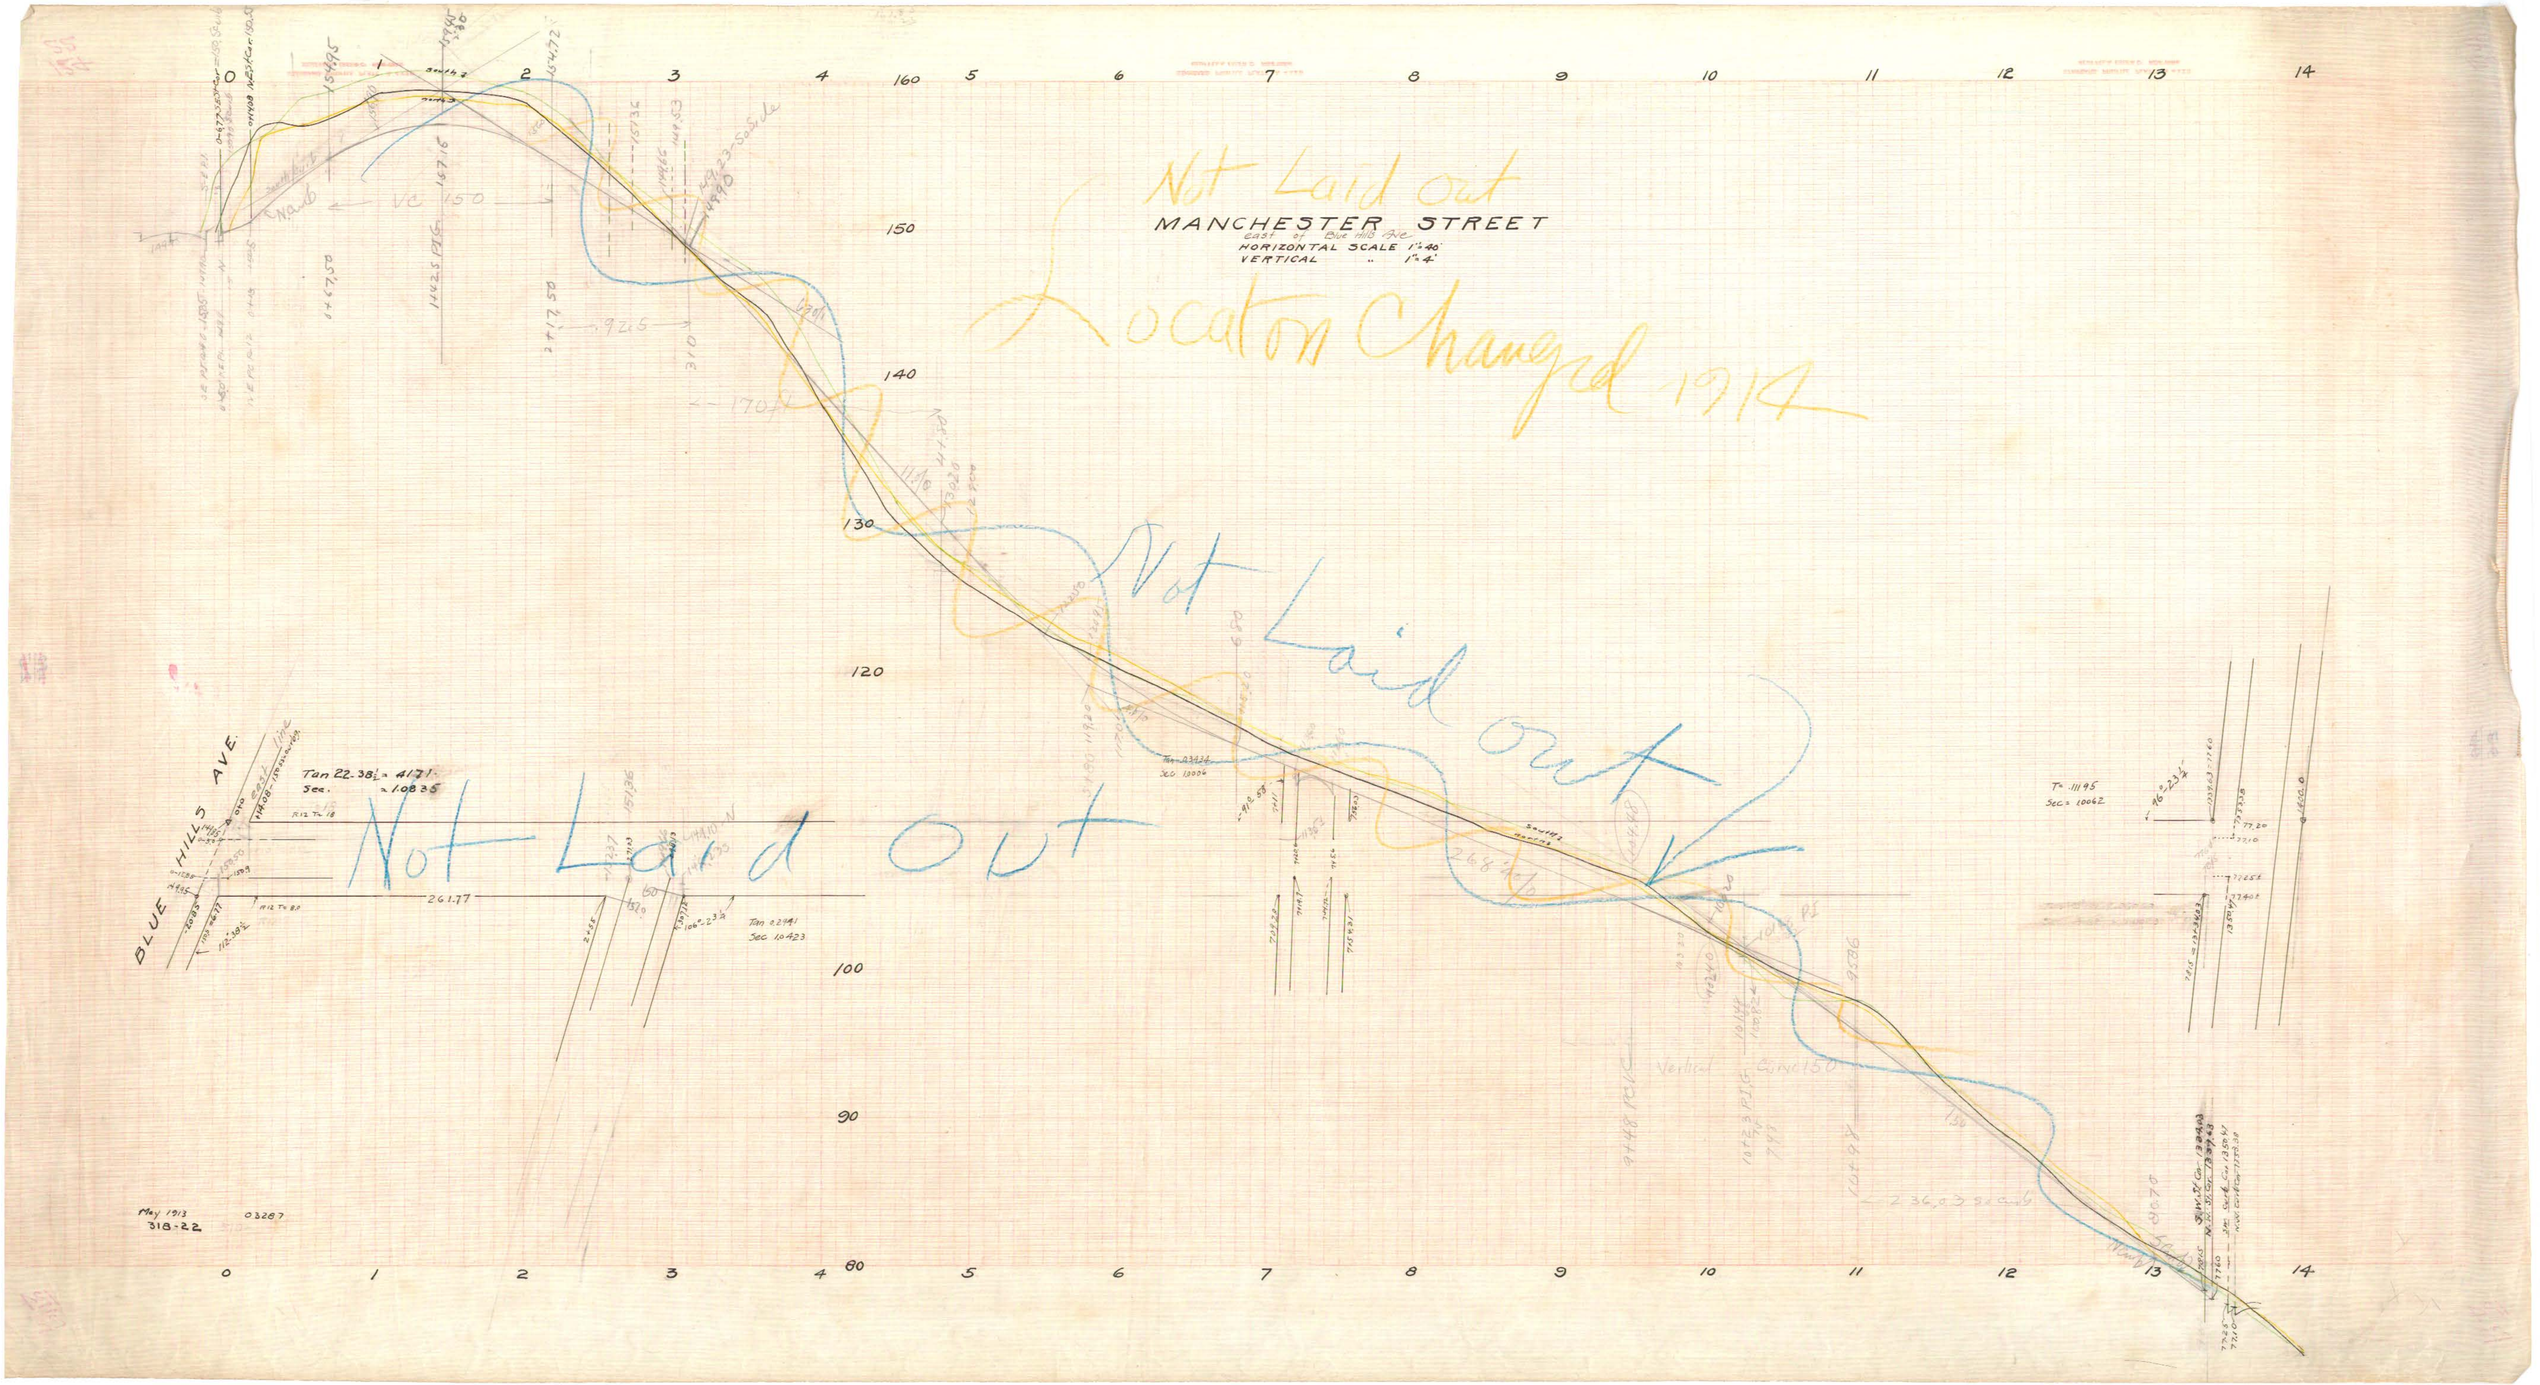
MANCHESTER STREET
East of Blue Hills Ave.
HORIZONTAL SCALE 1" = 40'
VERTICAL " 1" = 4'
Not Laid out
Location Changed 1914
Not Laid out
Not Laid out
BLUE HILLS AVE.
Tan 22-38½ = 41.71
Sec. = 1.0835
261.77
Tan 22-41
Sec 1.0423
Tan 23-26
Sec 1.0006
T = .11195
Sec = 1.0062
May 1913
318-22
03287