


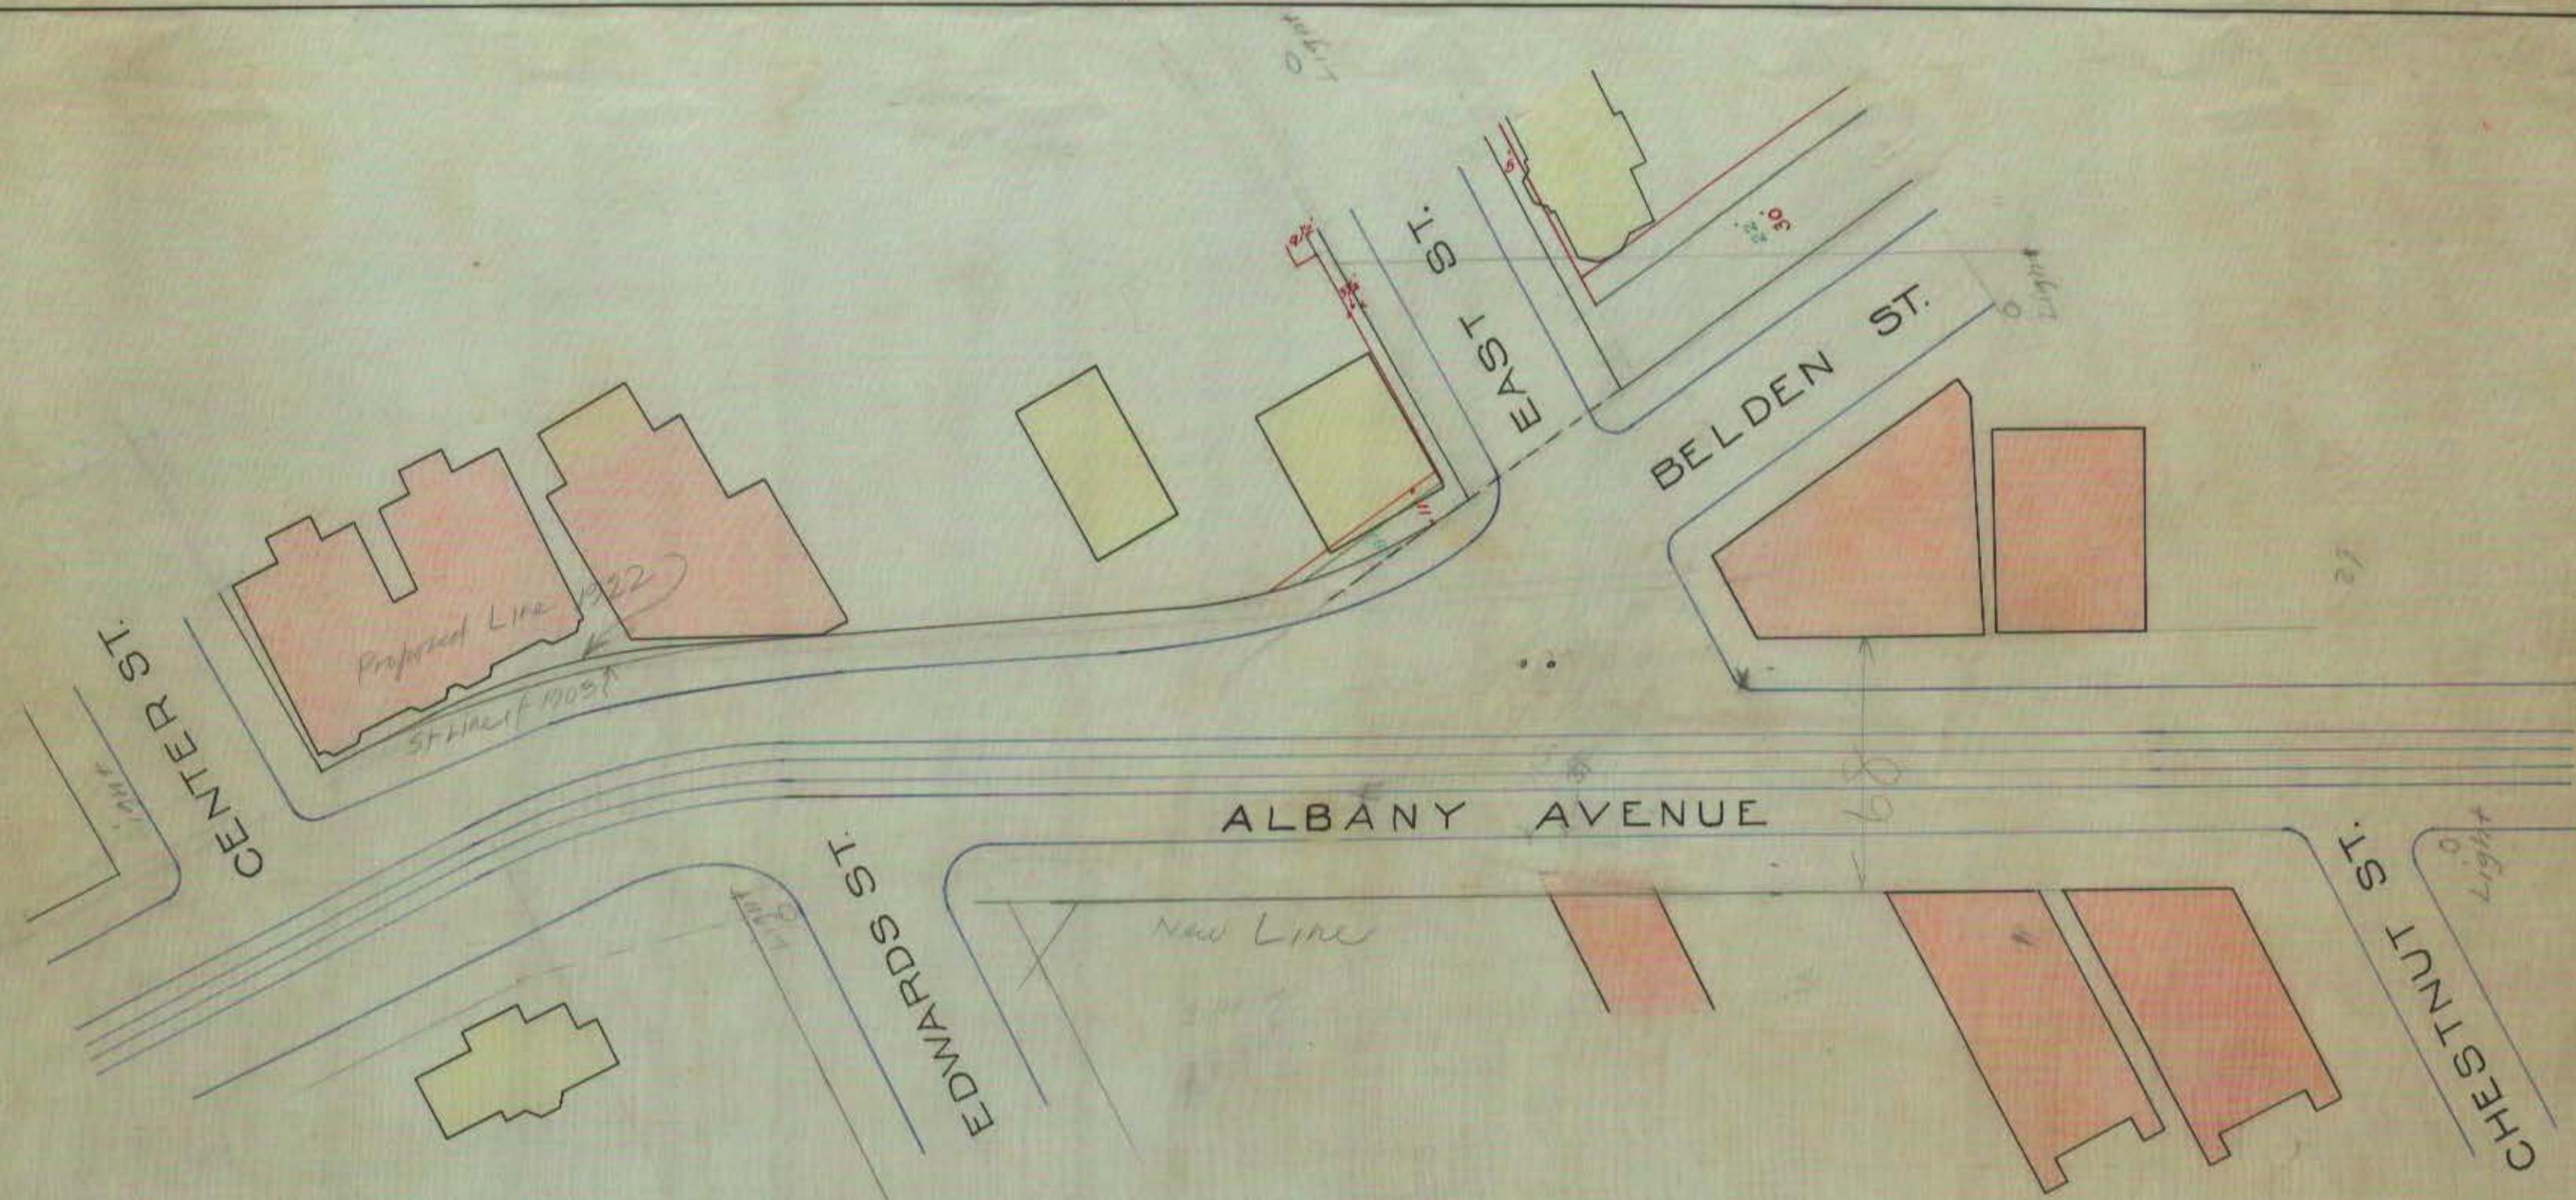

Scale 1"=40'

Jan 1914

3362