


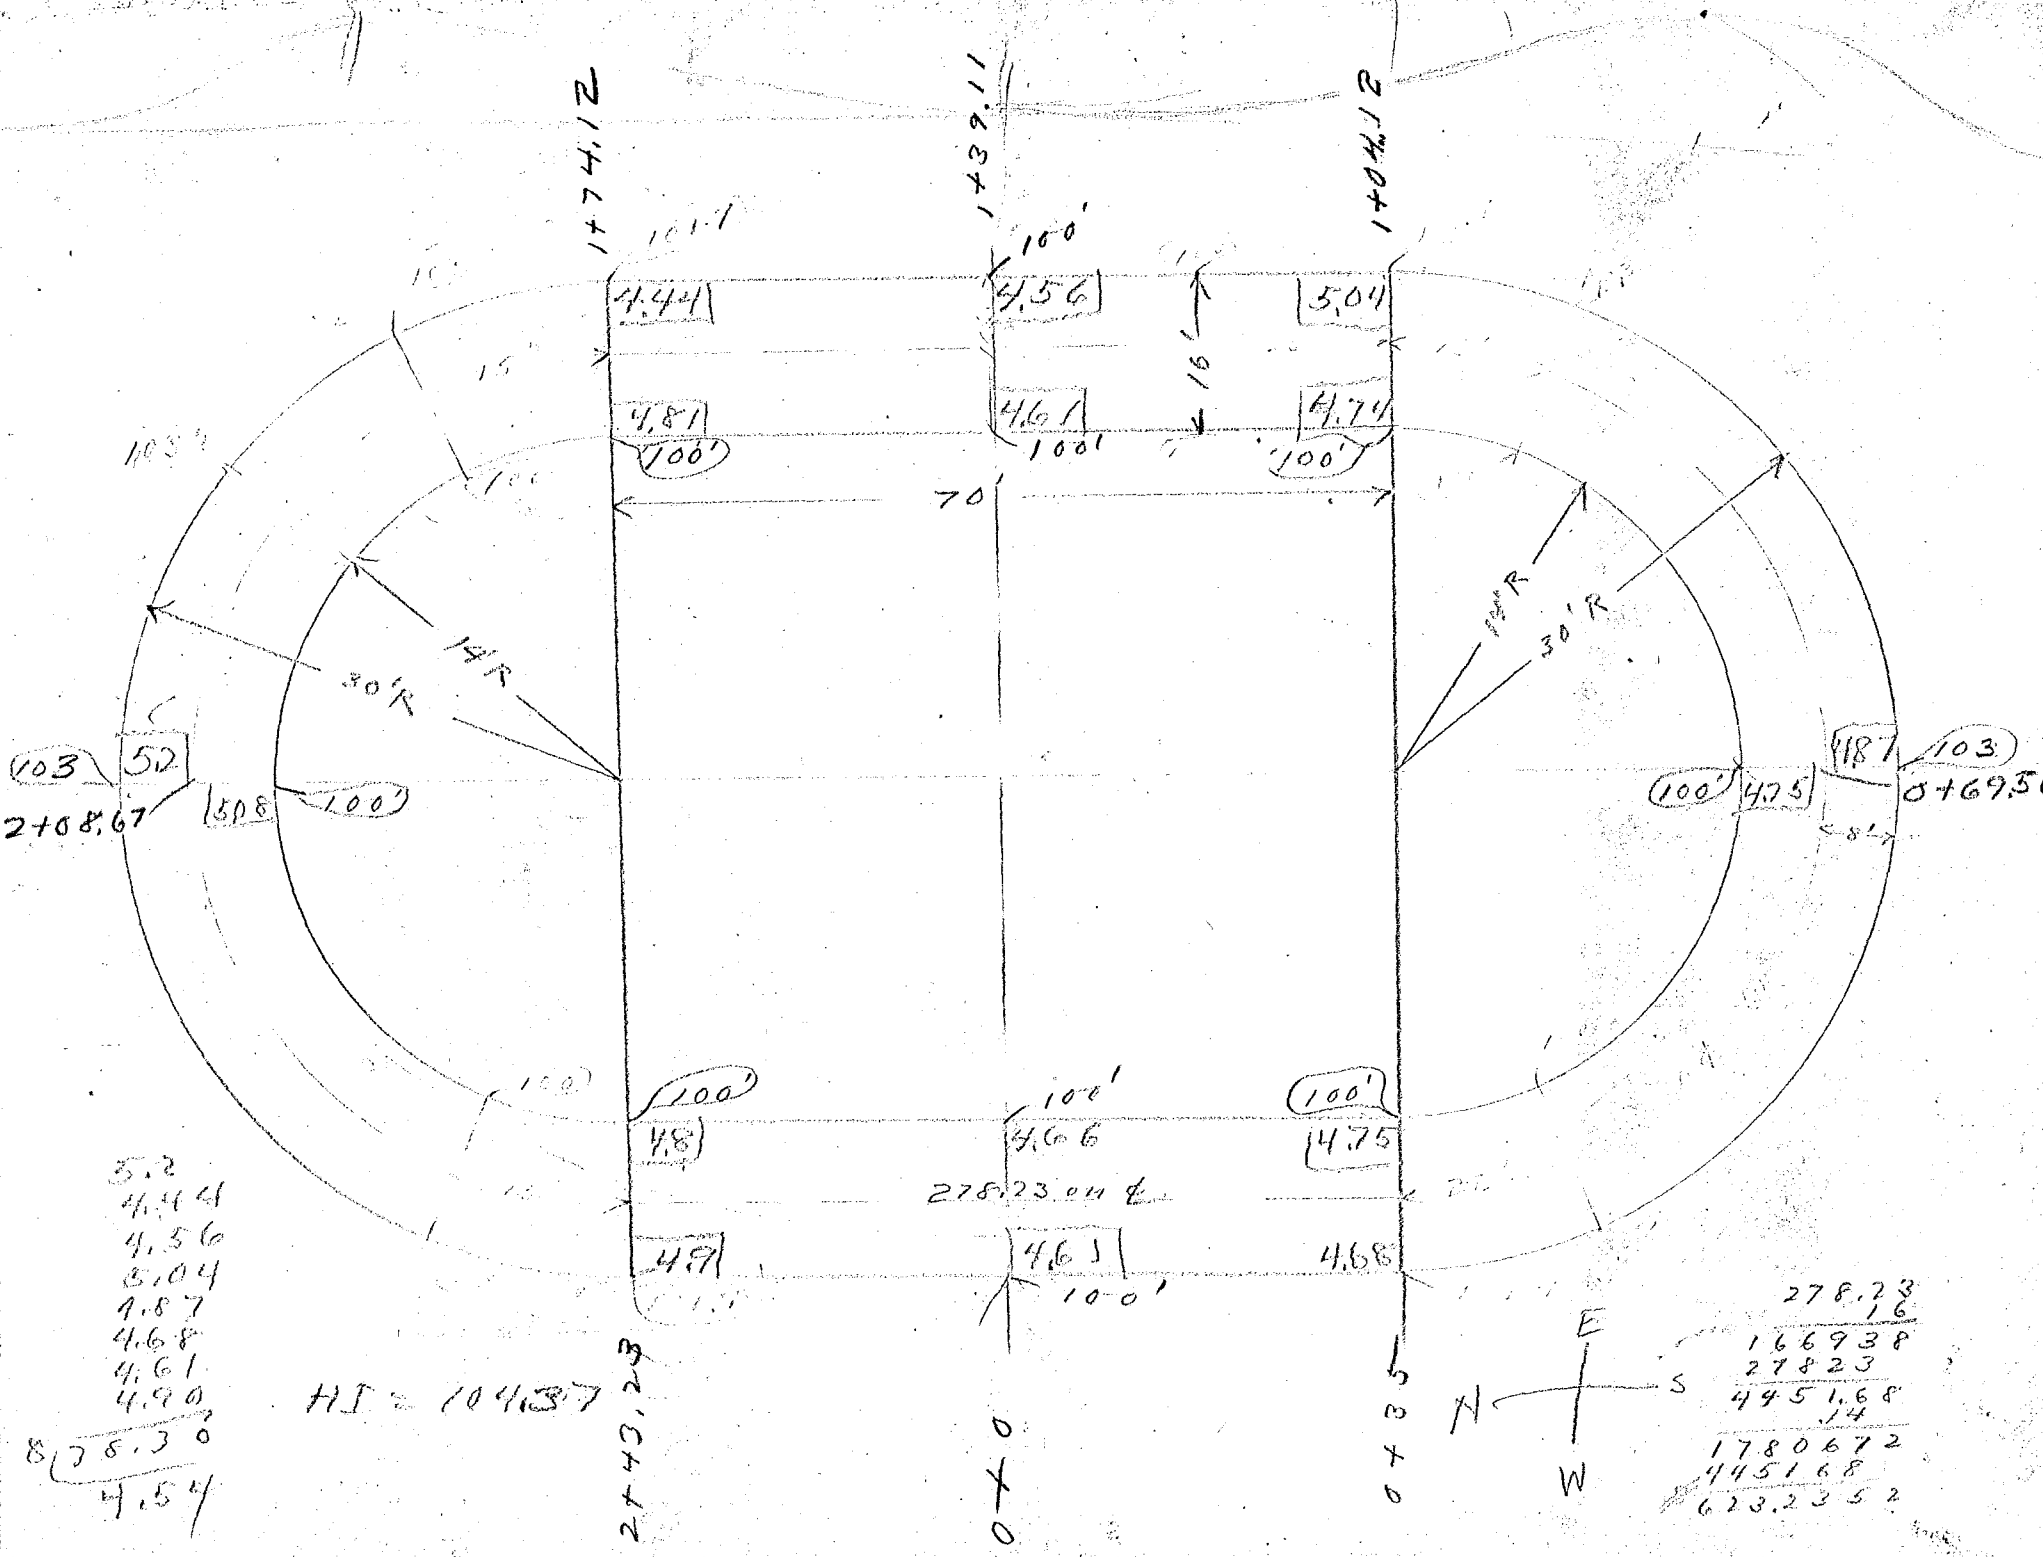

5.2
 4.44
 4.56
 5.04
 4.87
 4.68
 4.61
 4.90
 8 78.30
 4.54

HI = 104.37

2+43.23

278.23.04

0+0

N
 E
 S
 W

278.23
 16
 166938
 27823
 4451.68
 14
 1780672
 445168
 623.2352