


See Sheet 128

See Sheet 203

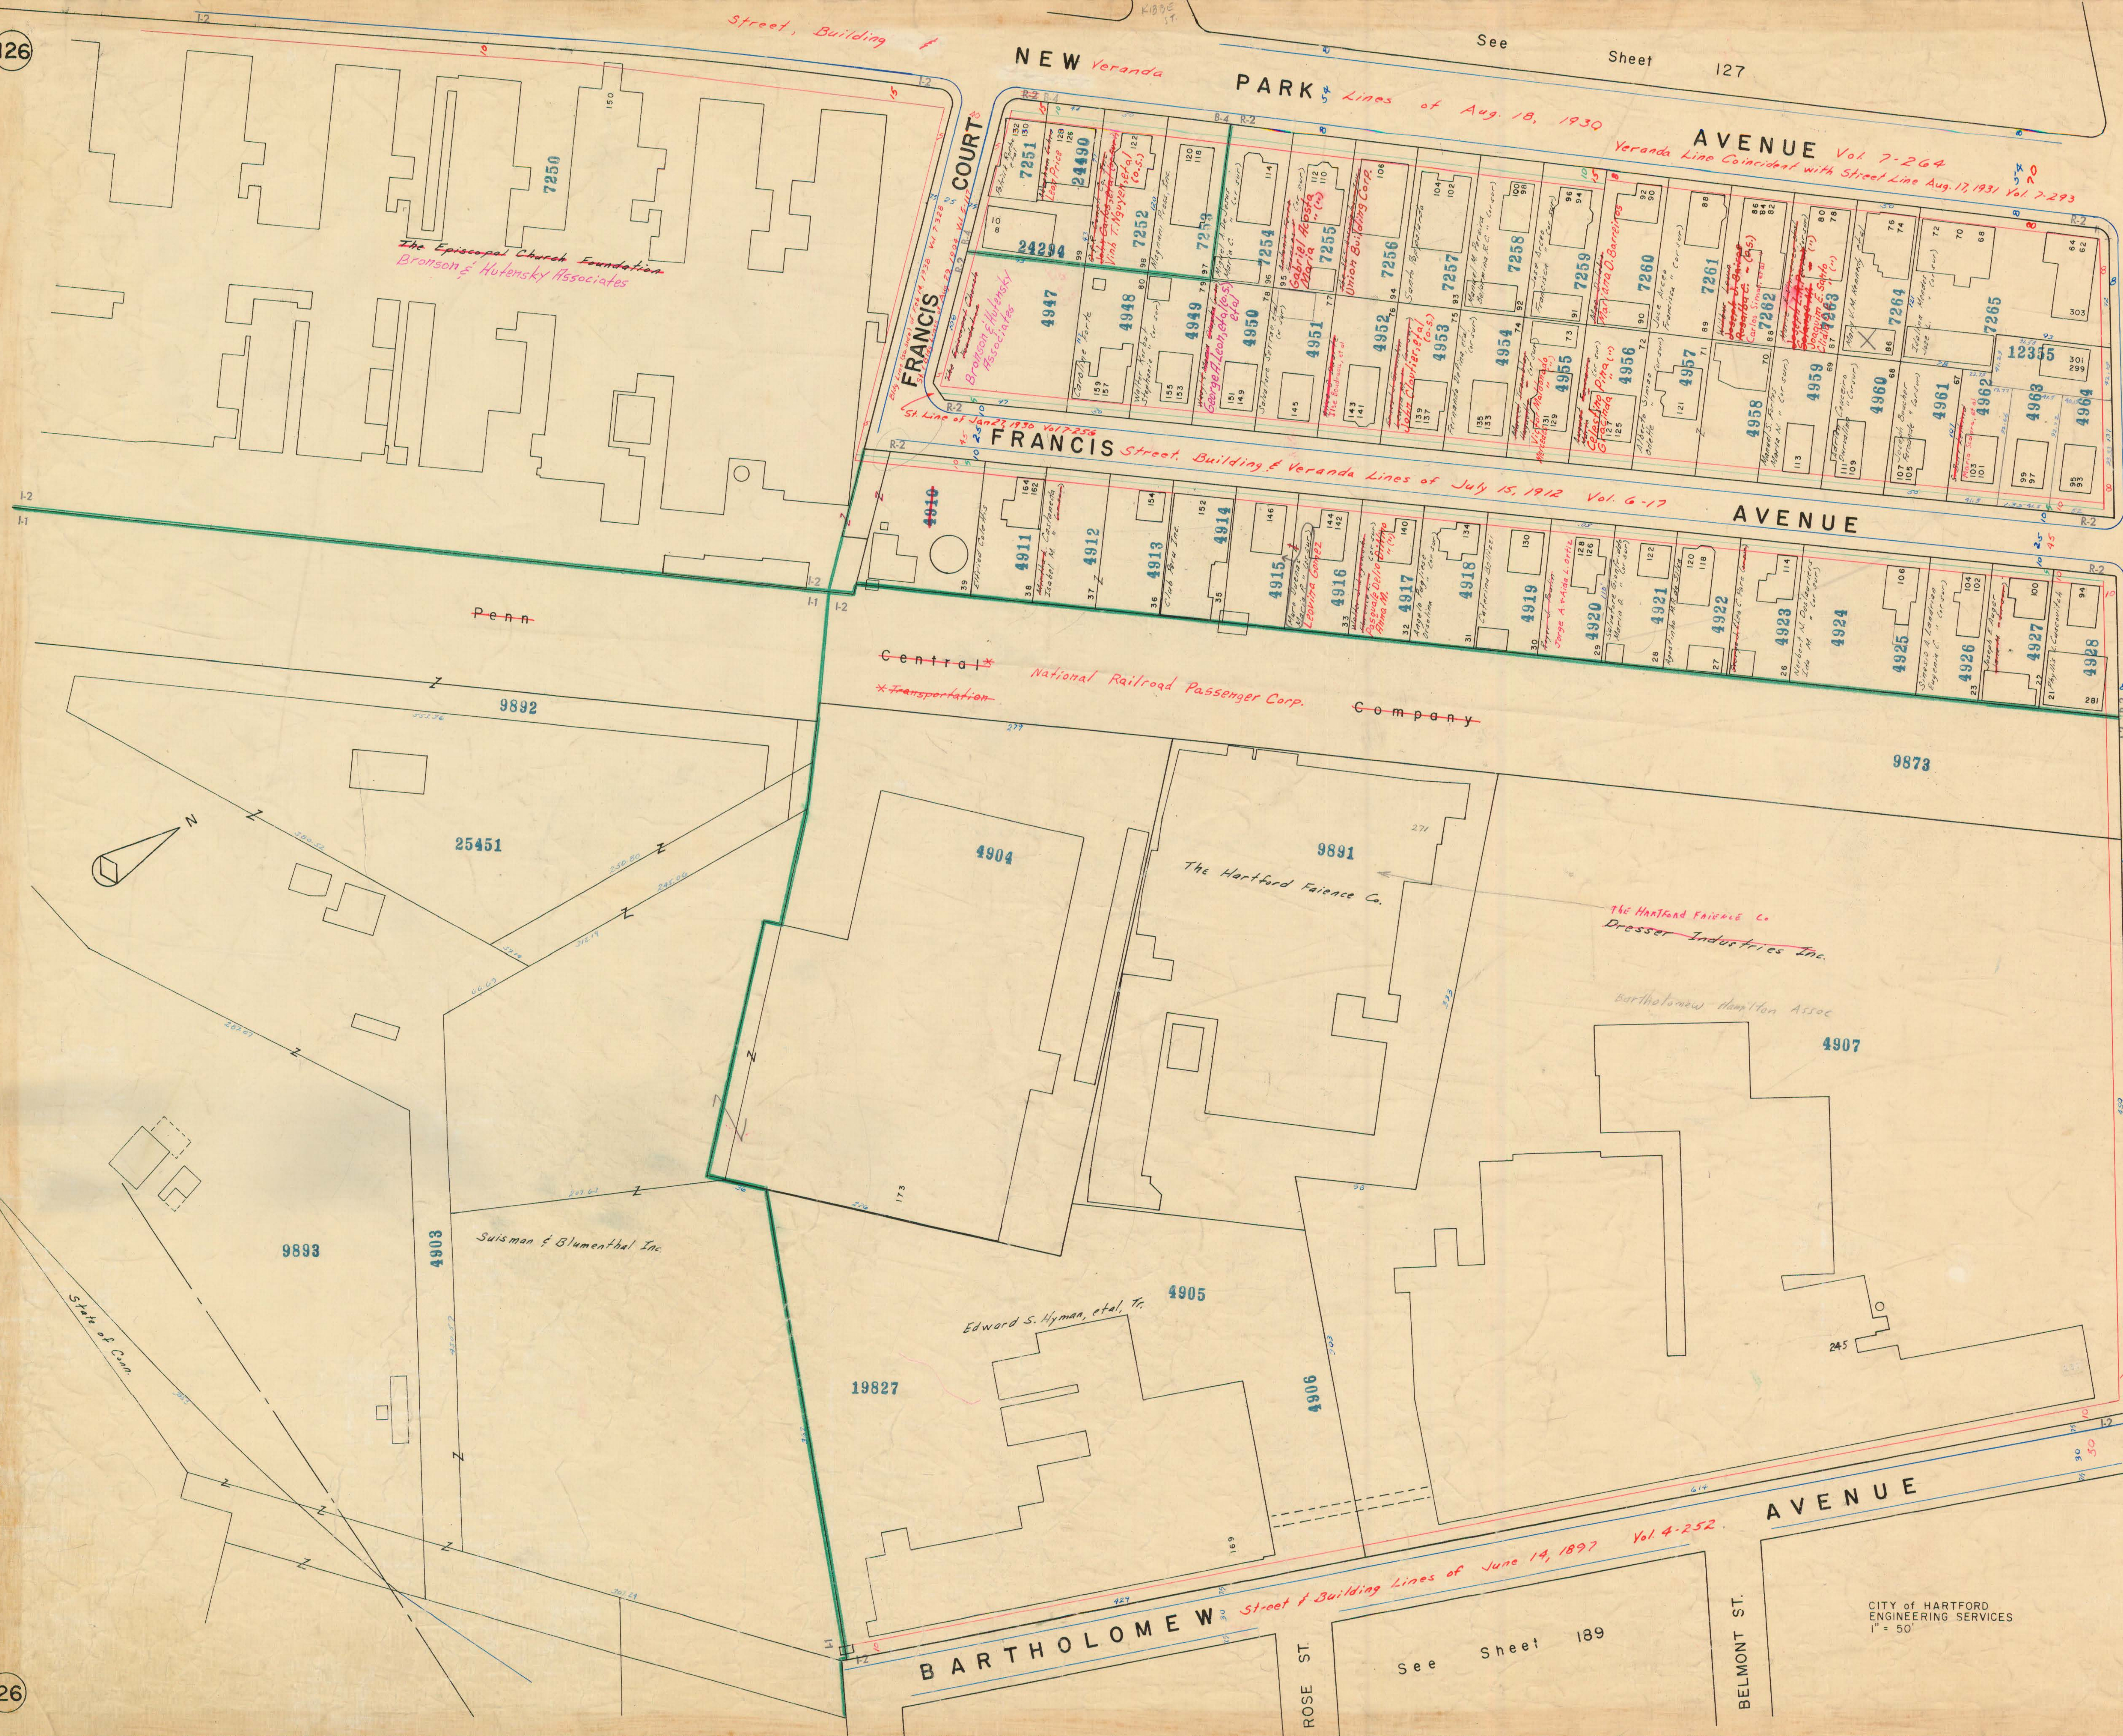

See Sheet 125

HAMILTON ST. Bldg. & Hn. Lines of Dec. 9, 1912 Vol. G-41

See Sheet 125

CITY of HARTFORD
ENGINEERING SERVICES
1" = 50'