


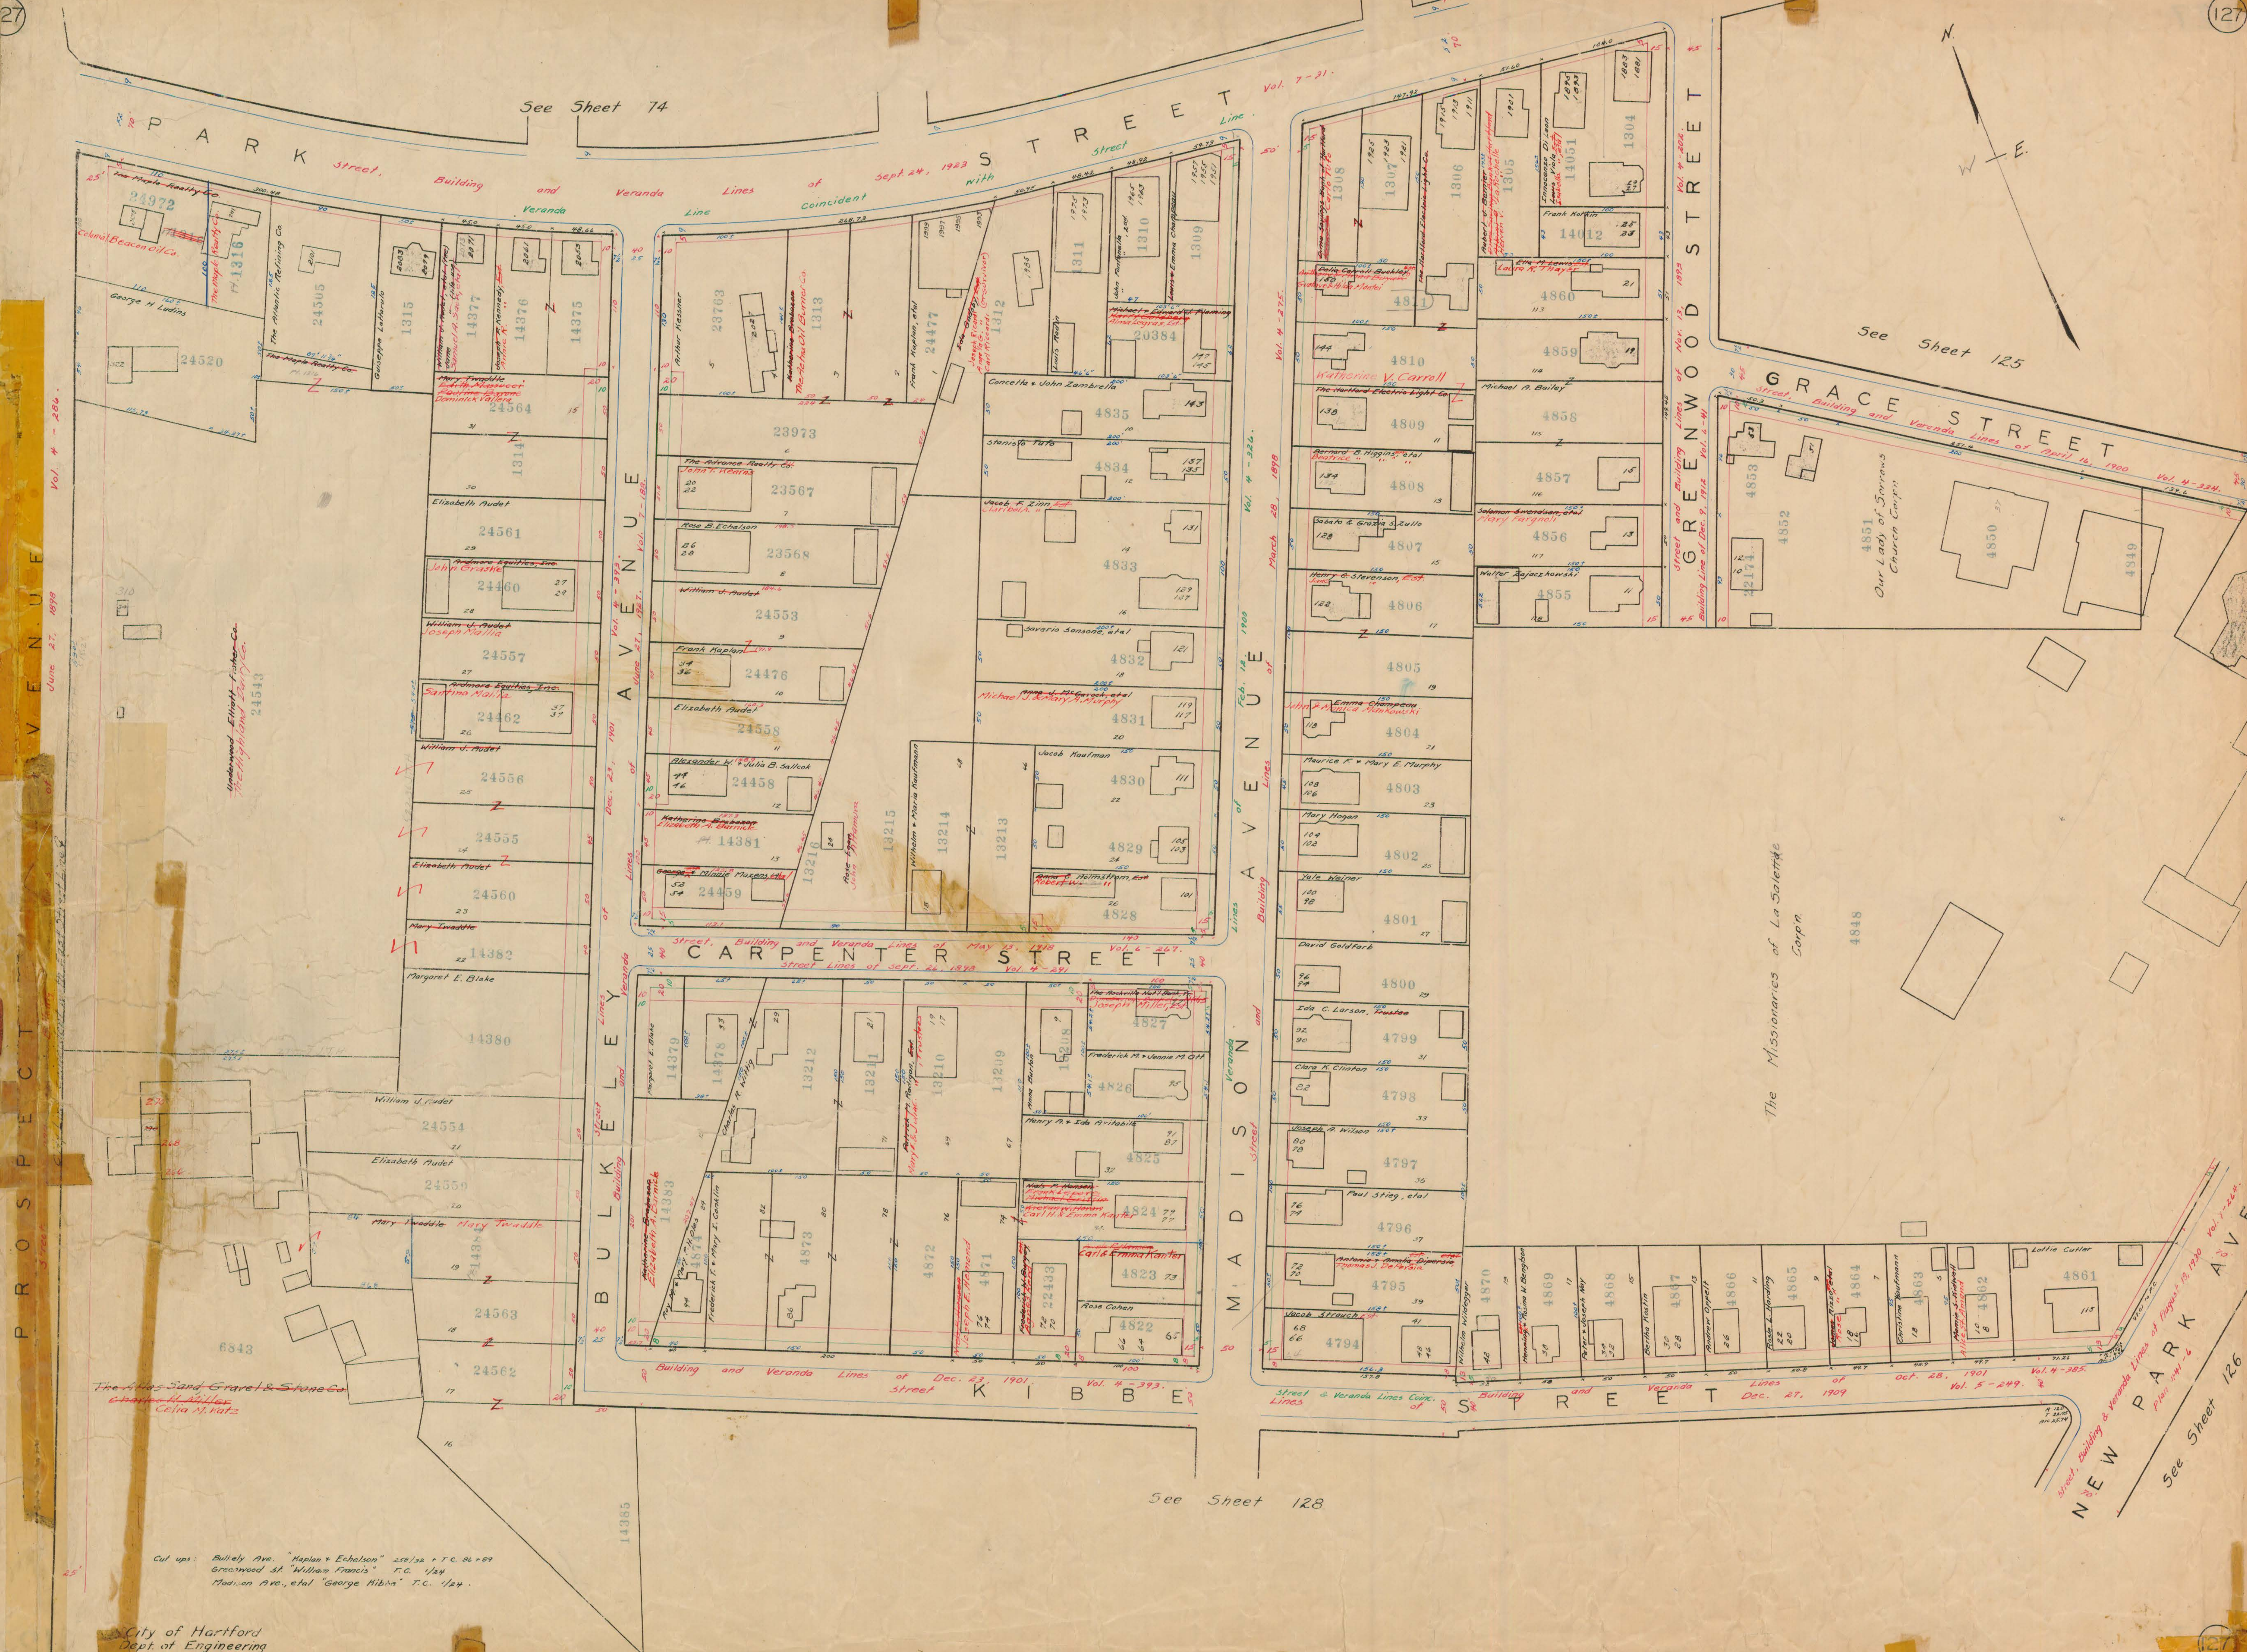

Cut ups: Bulkeley Ave. "Kaplan & Echelson" 250/32 + T.C. 86-89
Greenwood St. "Williams Francis" T.C. 1/24
Madison Ave. et al. "George Hibbs" T.C. 1/24