


PROSPECT STREET
TOWN 20.56
4551 12

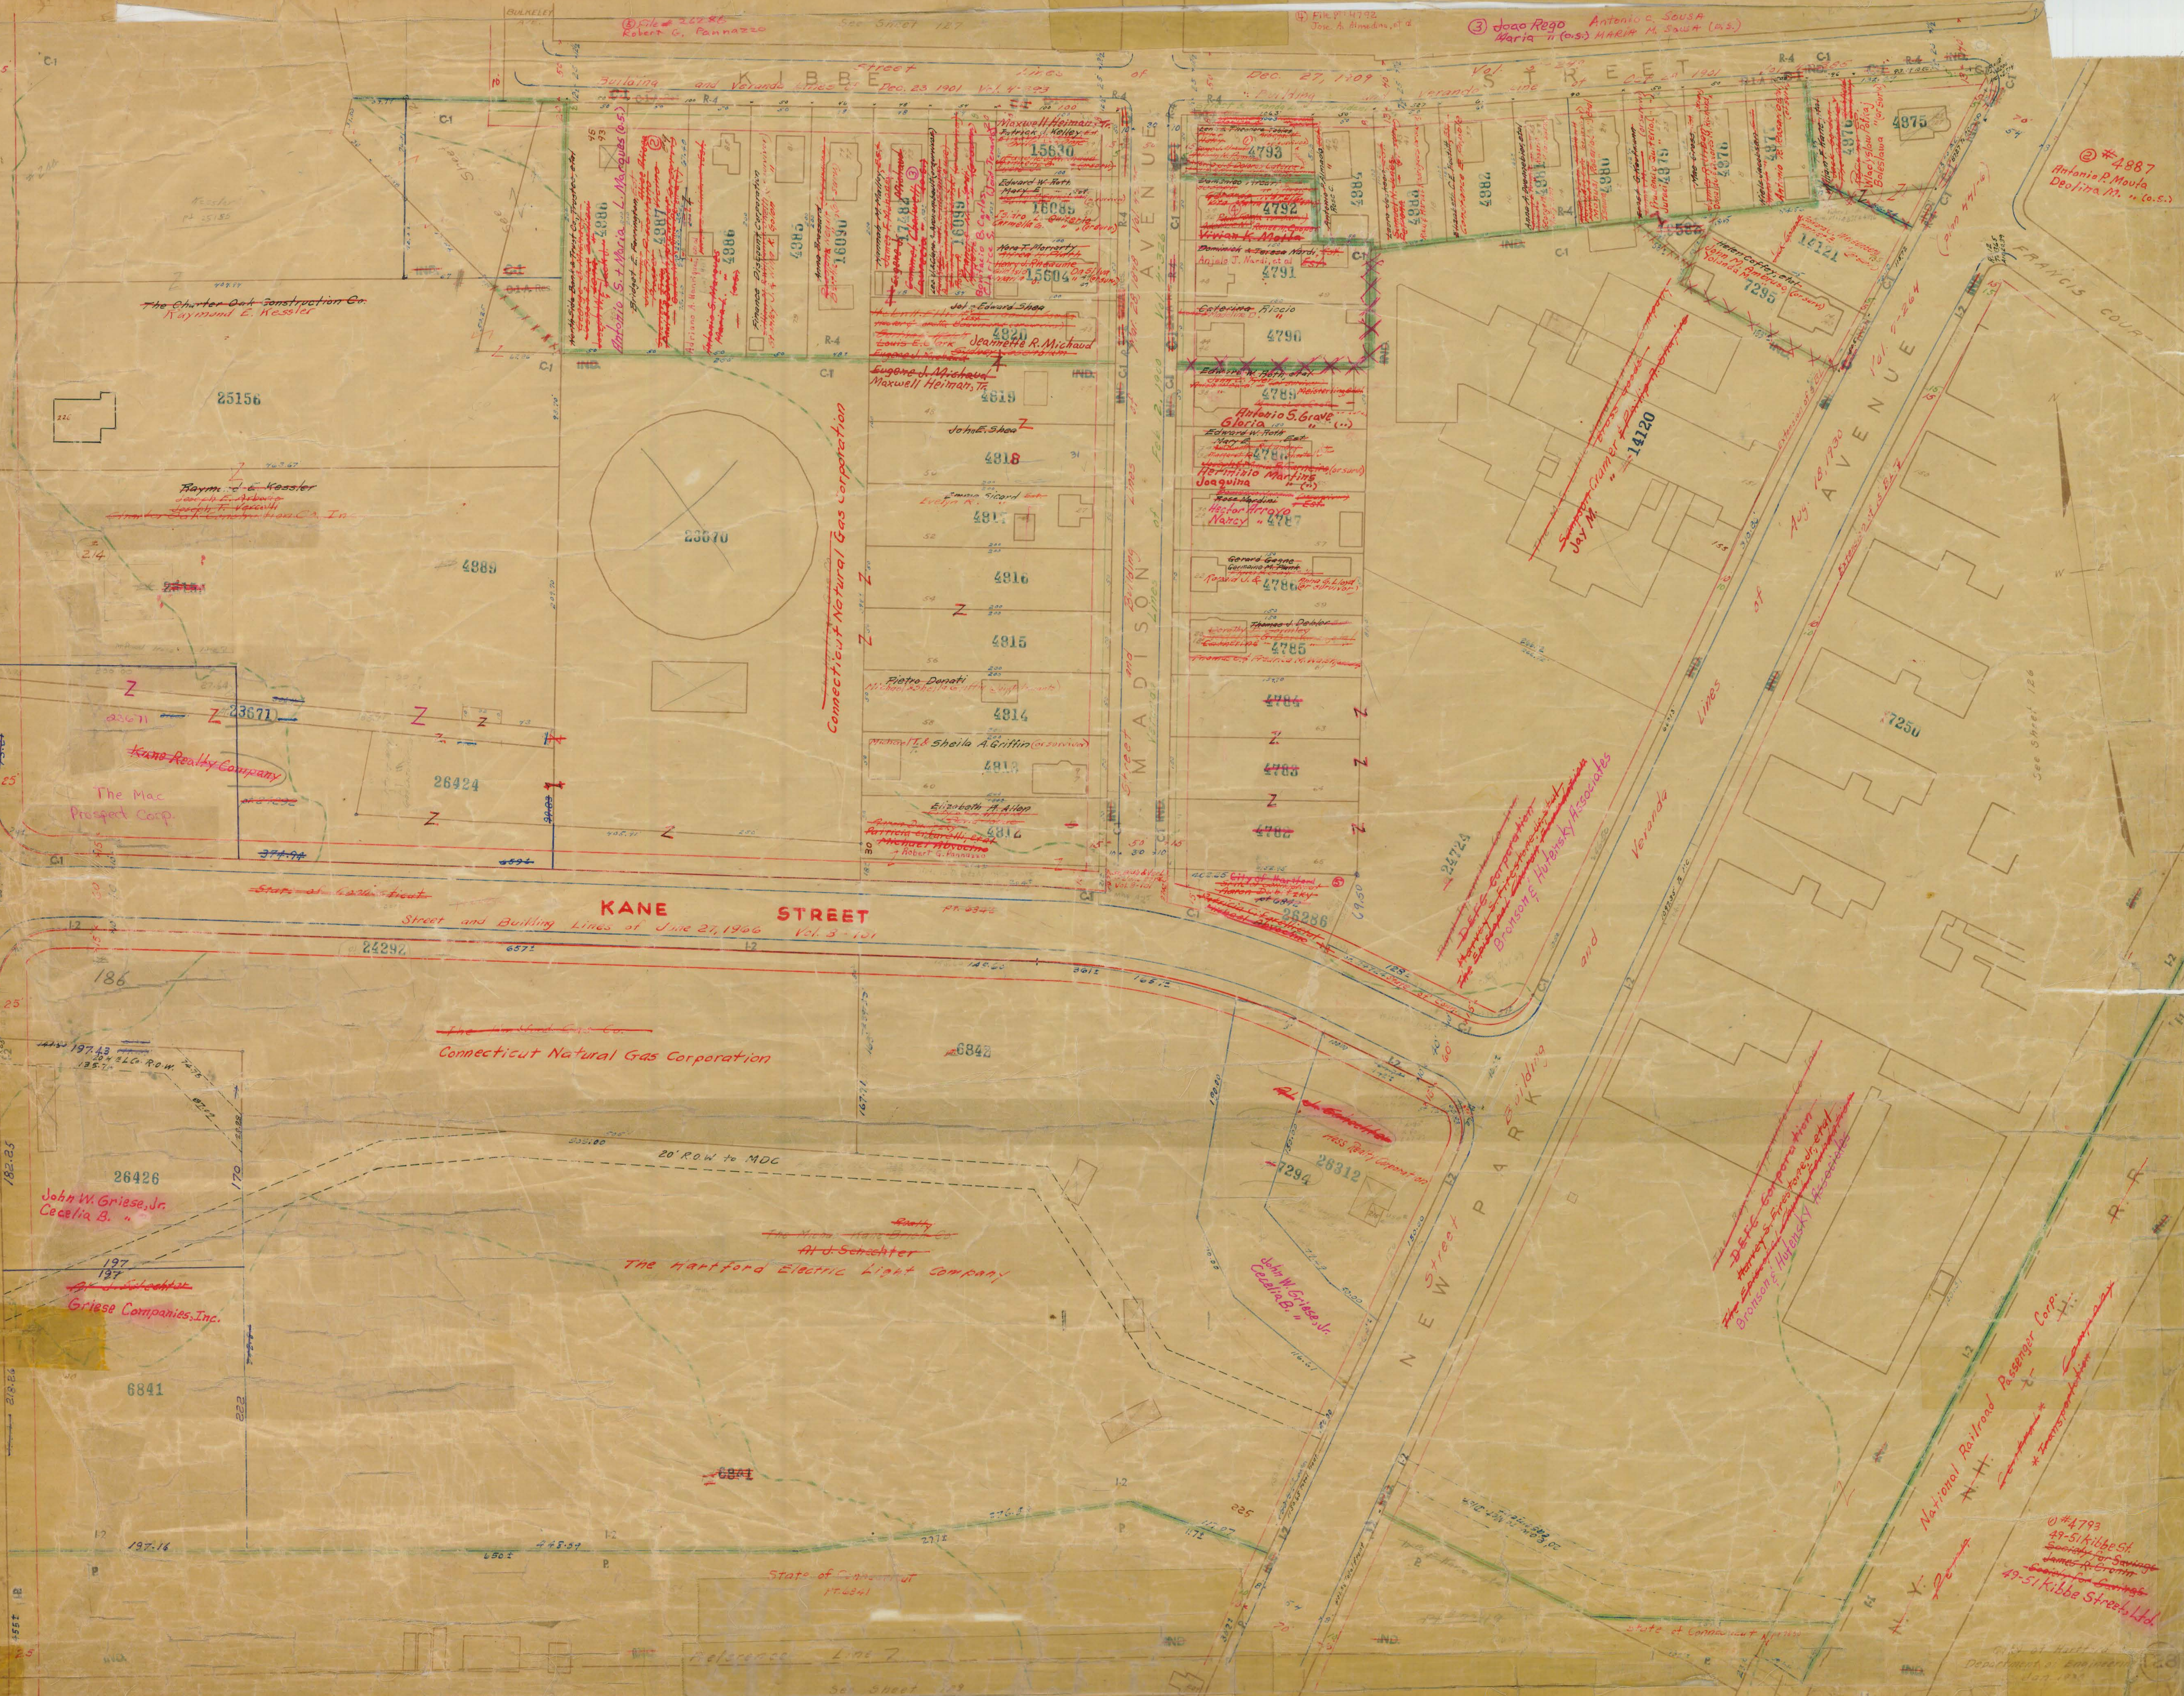

The Charter Oak Construction Co.
Raymond E. Kessler

25156

Raymond E. Kessler
Joseph T. Vascelli
Hartford Electric Light Co., Inc.

Kane Realty Company

The Mac
Prospect Corp.

KANE STREET

Street and Building Lines of June 21, 1966 Vol. 3-101

Connecticut Natural Gas Corporation

John W. Griese, Jr.
Cecelia B. "

Griese Companies, Inc.

The Hartford Electric Light Company

NEW STREET

National Railroad Passenger Corp.
Transportation

49-51 Kibbe St.
James R. Brown
49-51 Kibbe Streets Ltd.

#4887
Antonio P. Mouta
Deolina M. (Co. S.)

See Sheet 126