


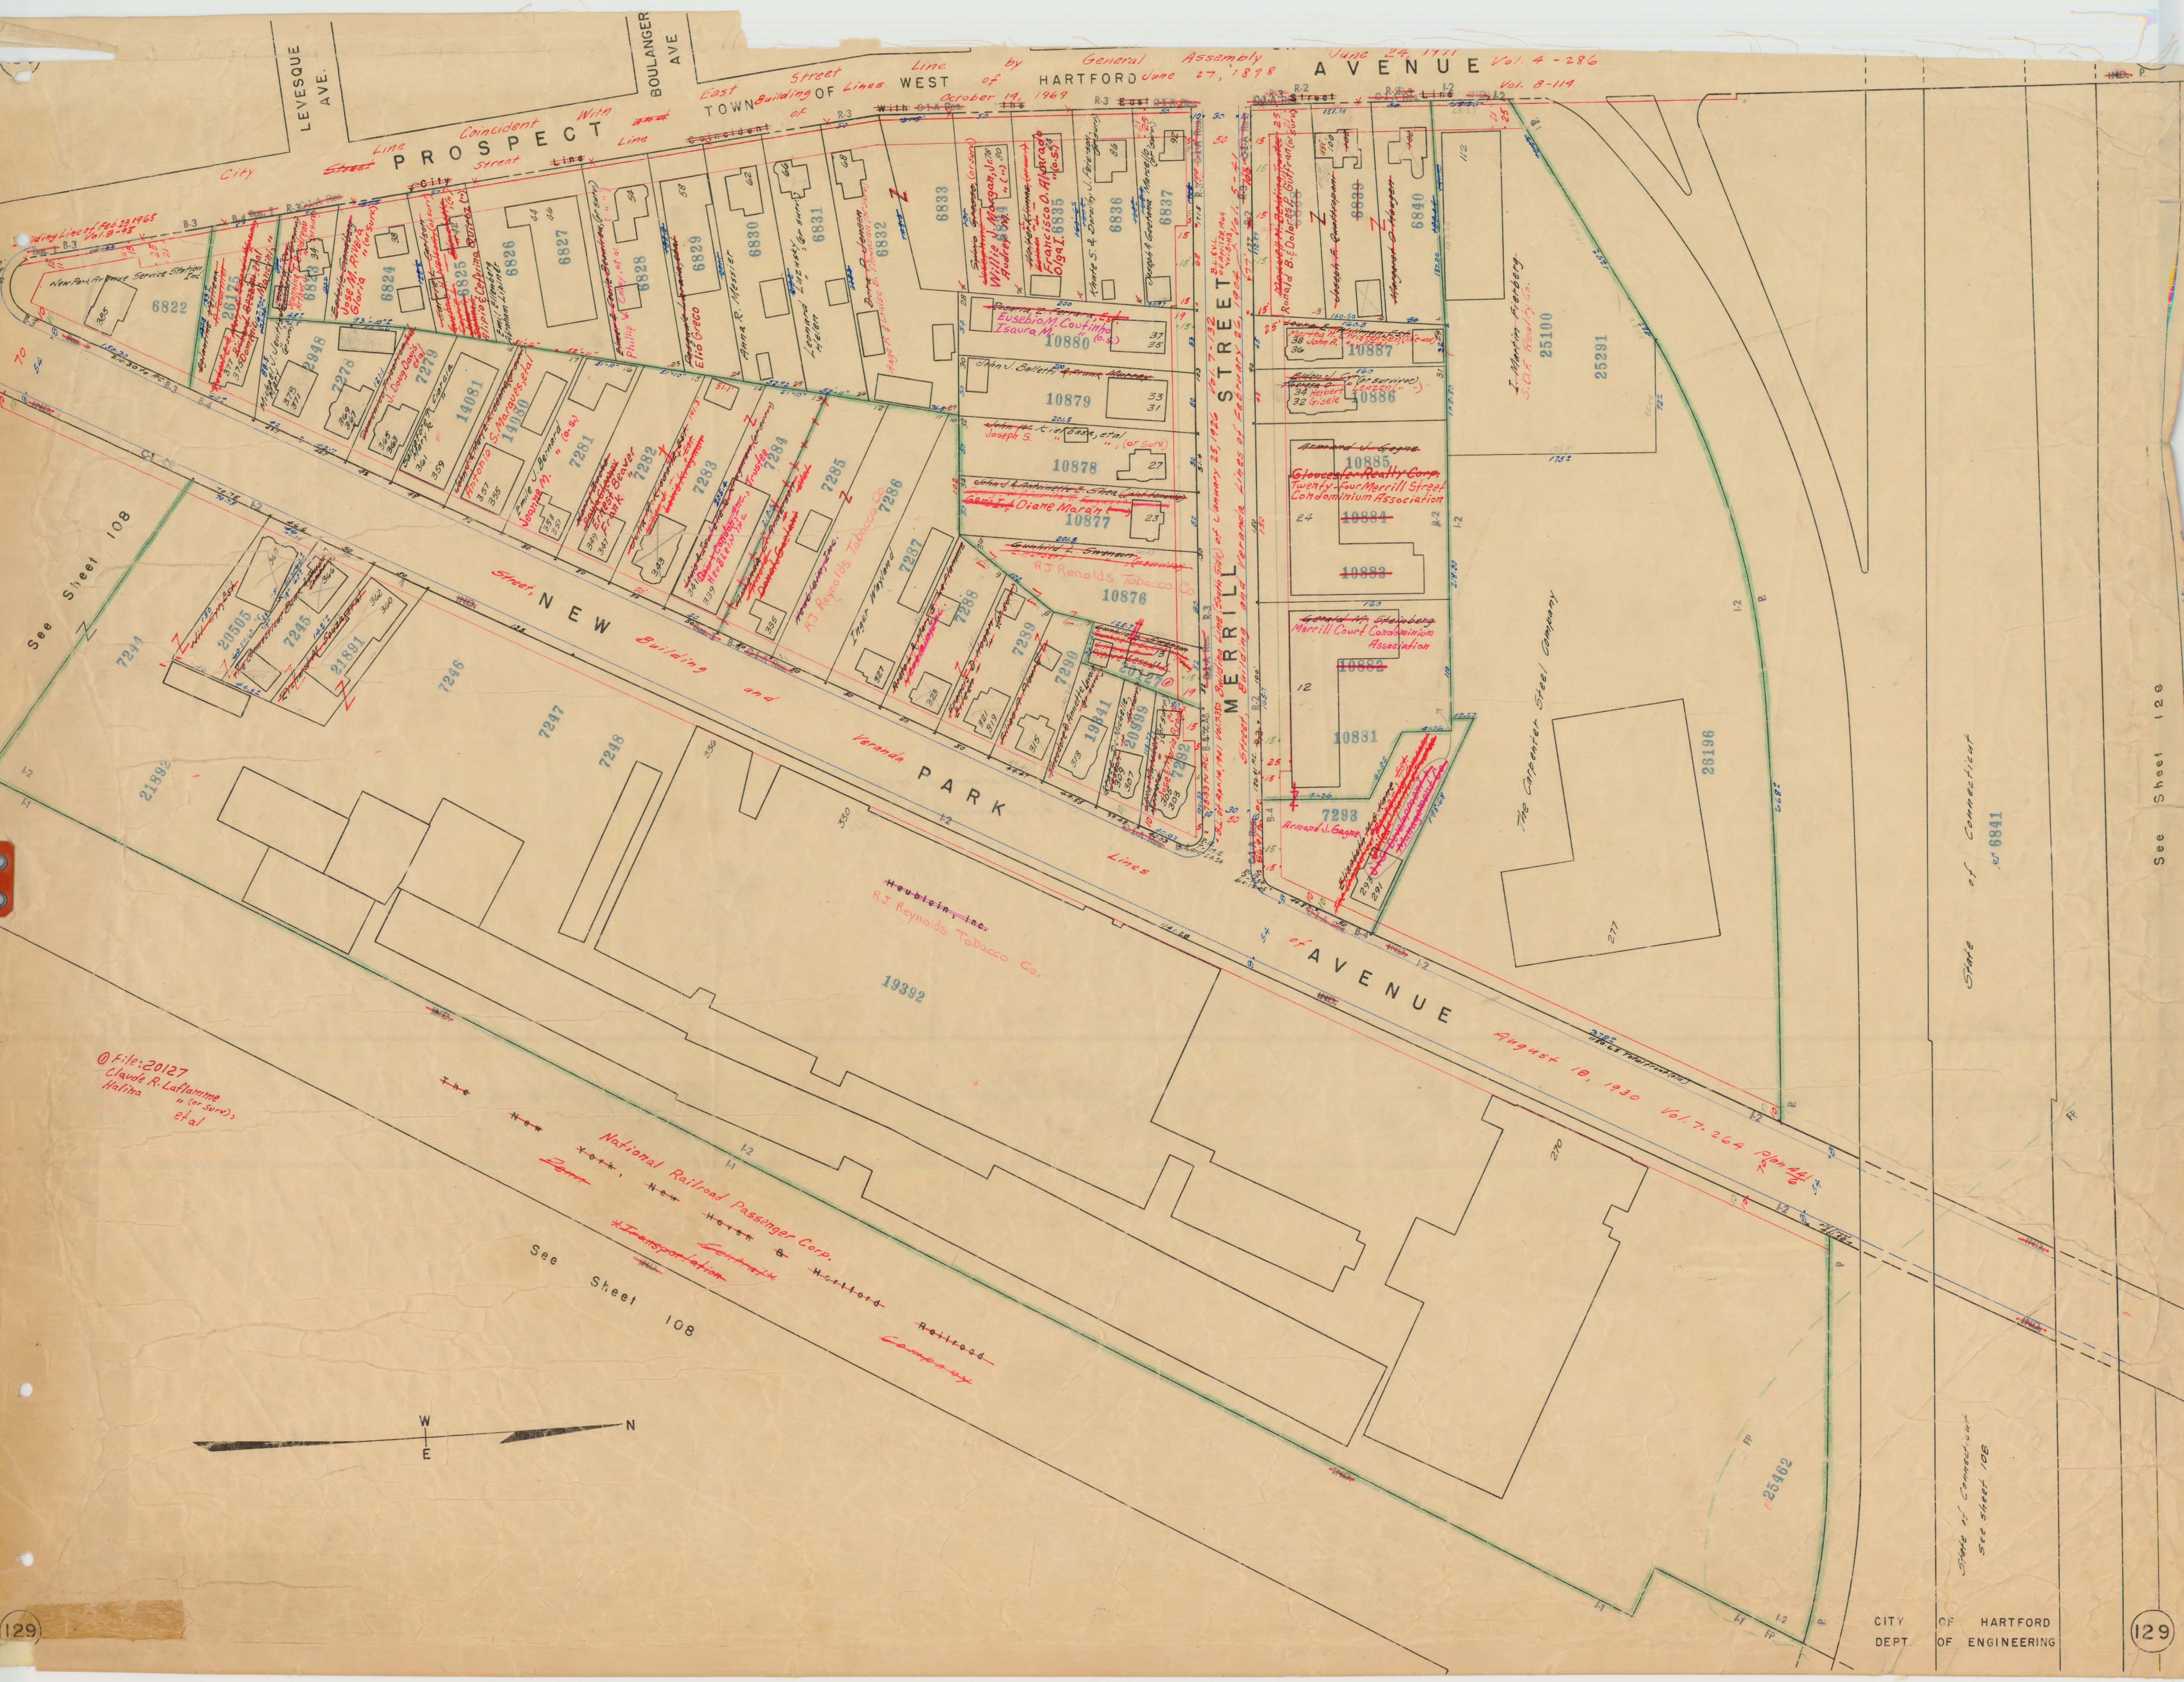

See Sheet 108

See Sheet 108

© File 20127
Claude R. Lafframme
Hafina
etal

See Sheet 108